
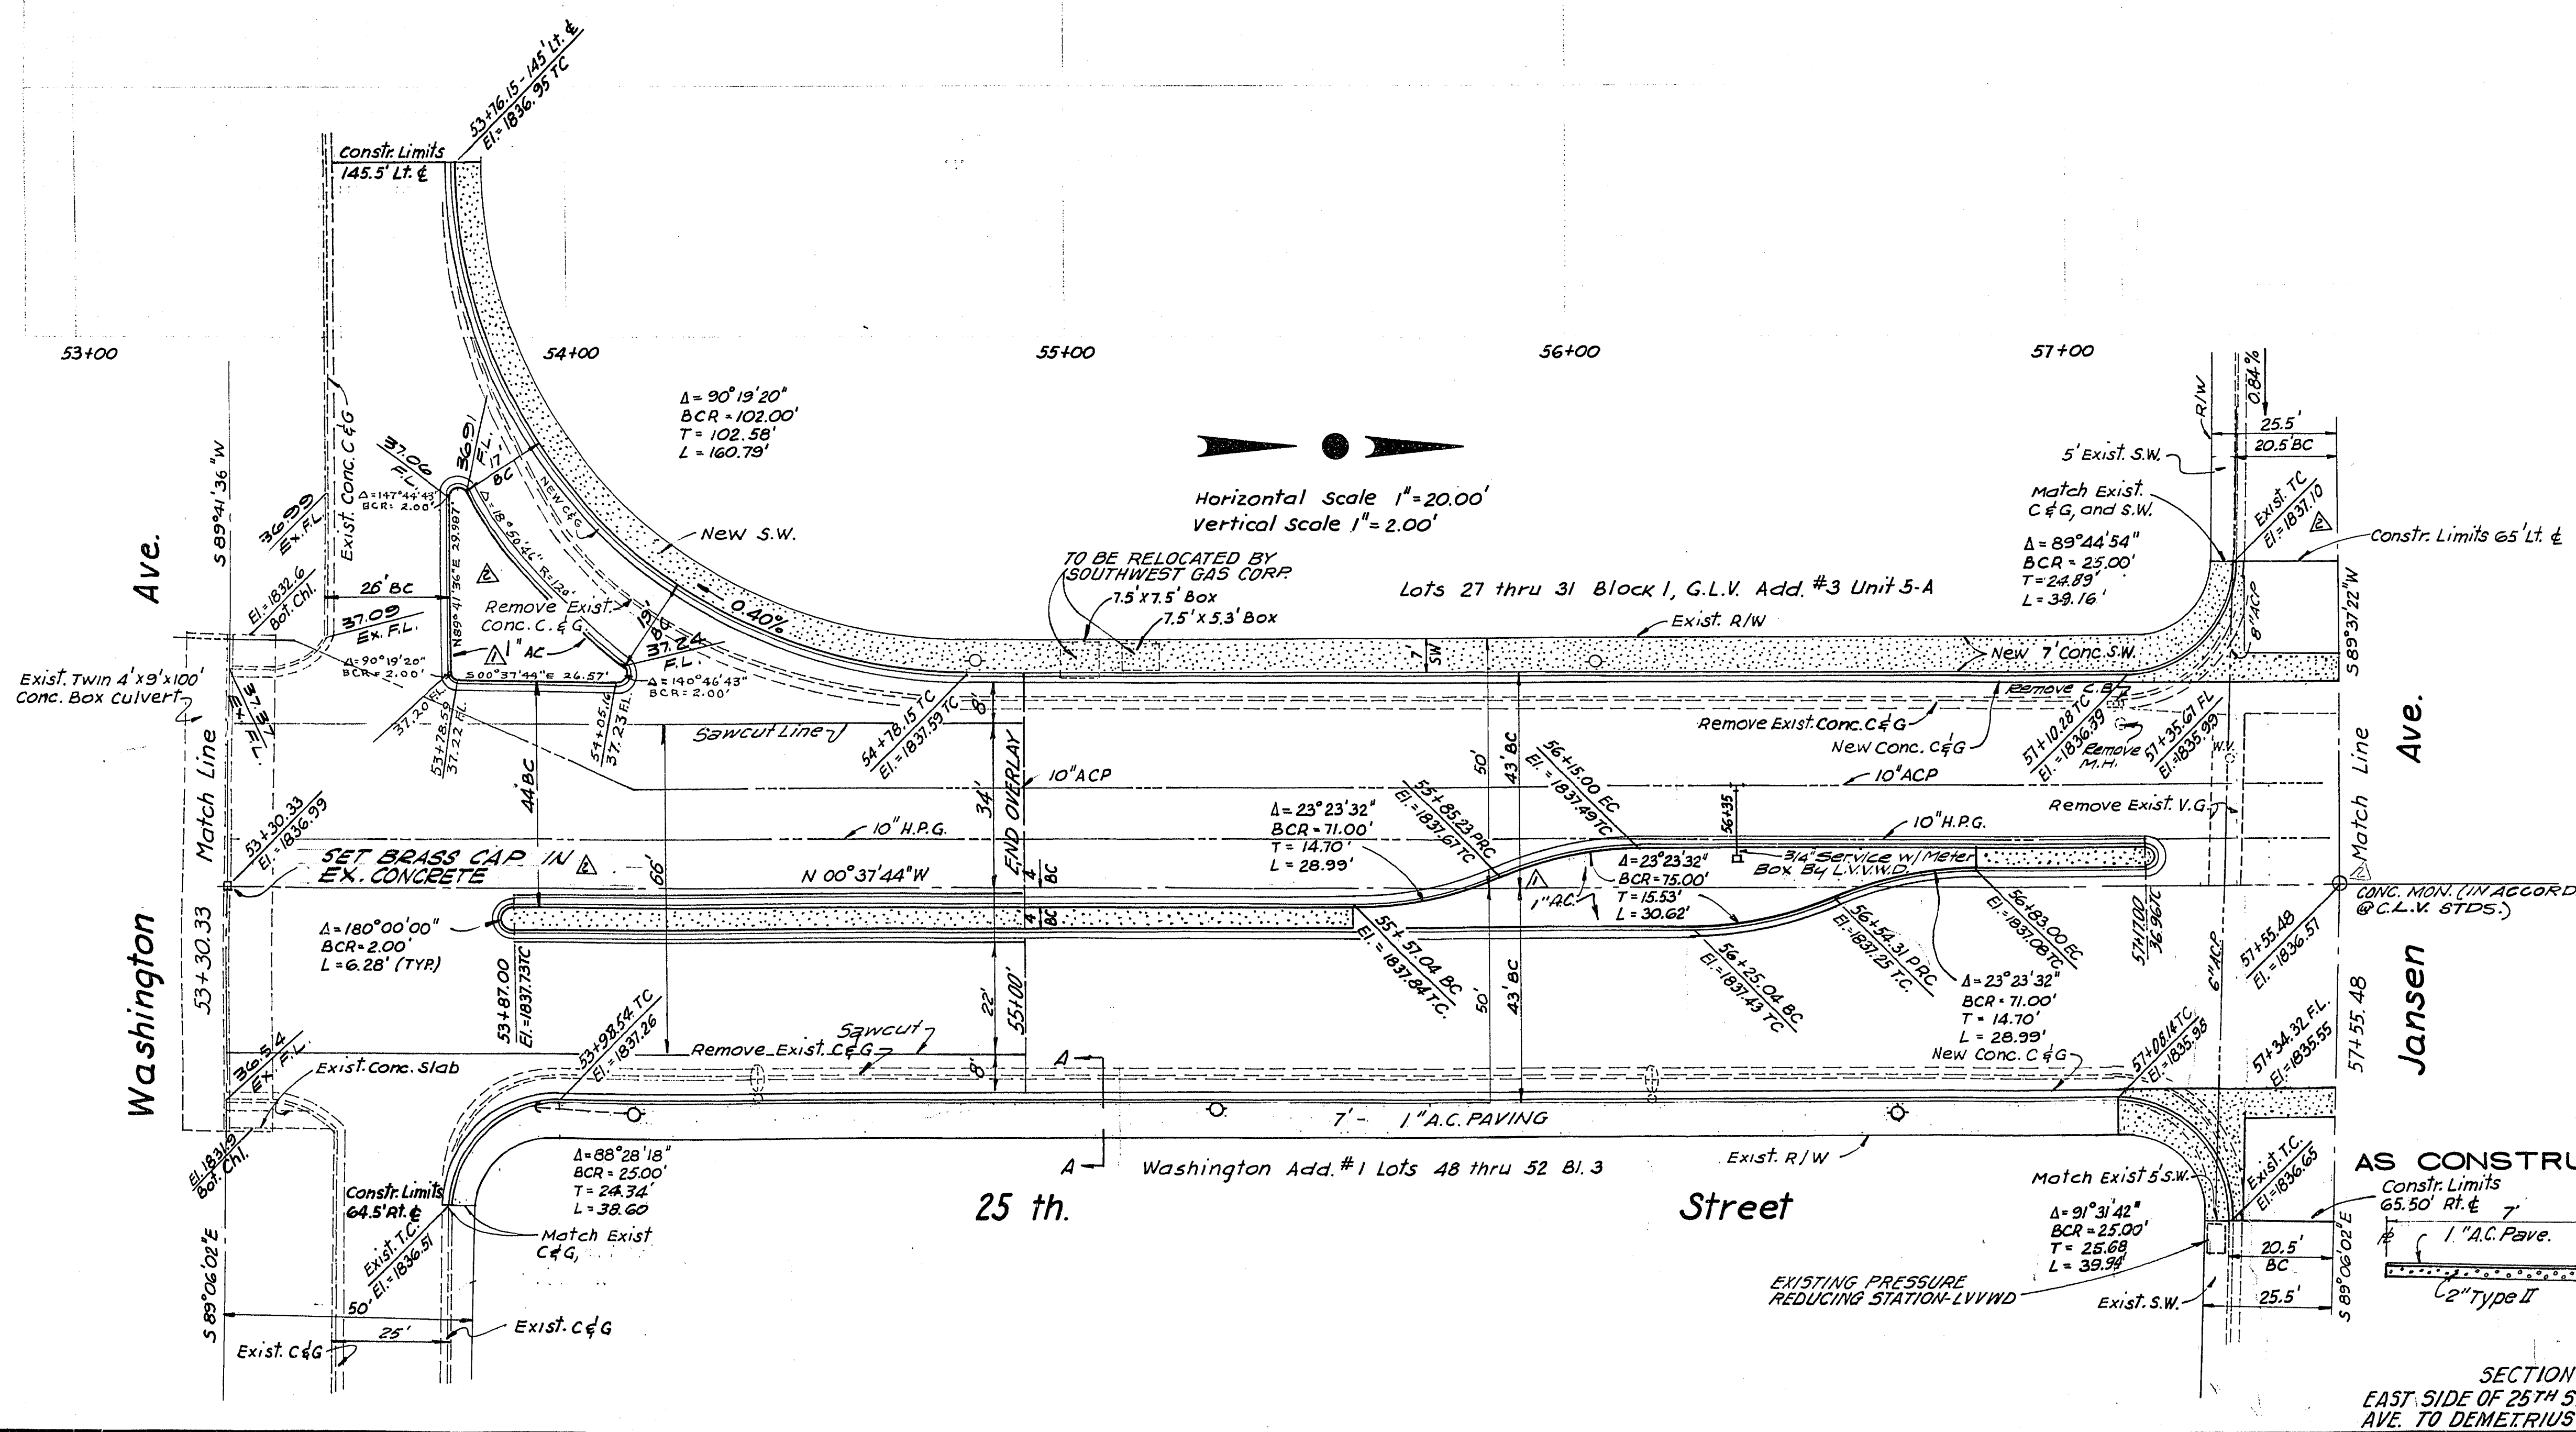


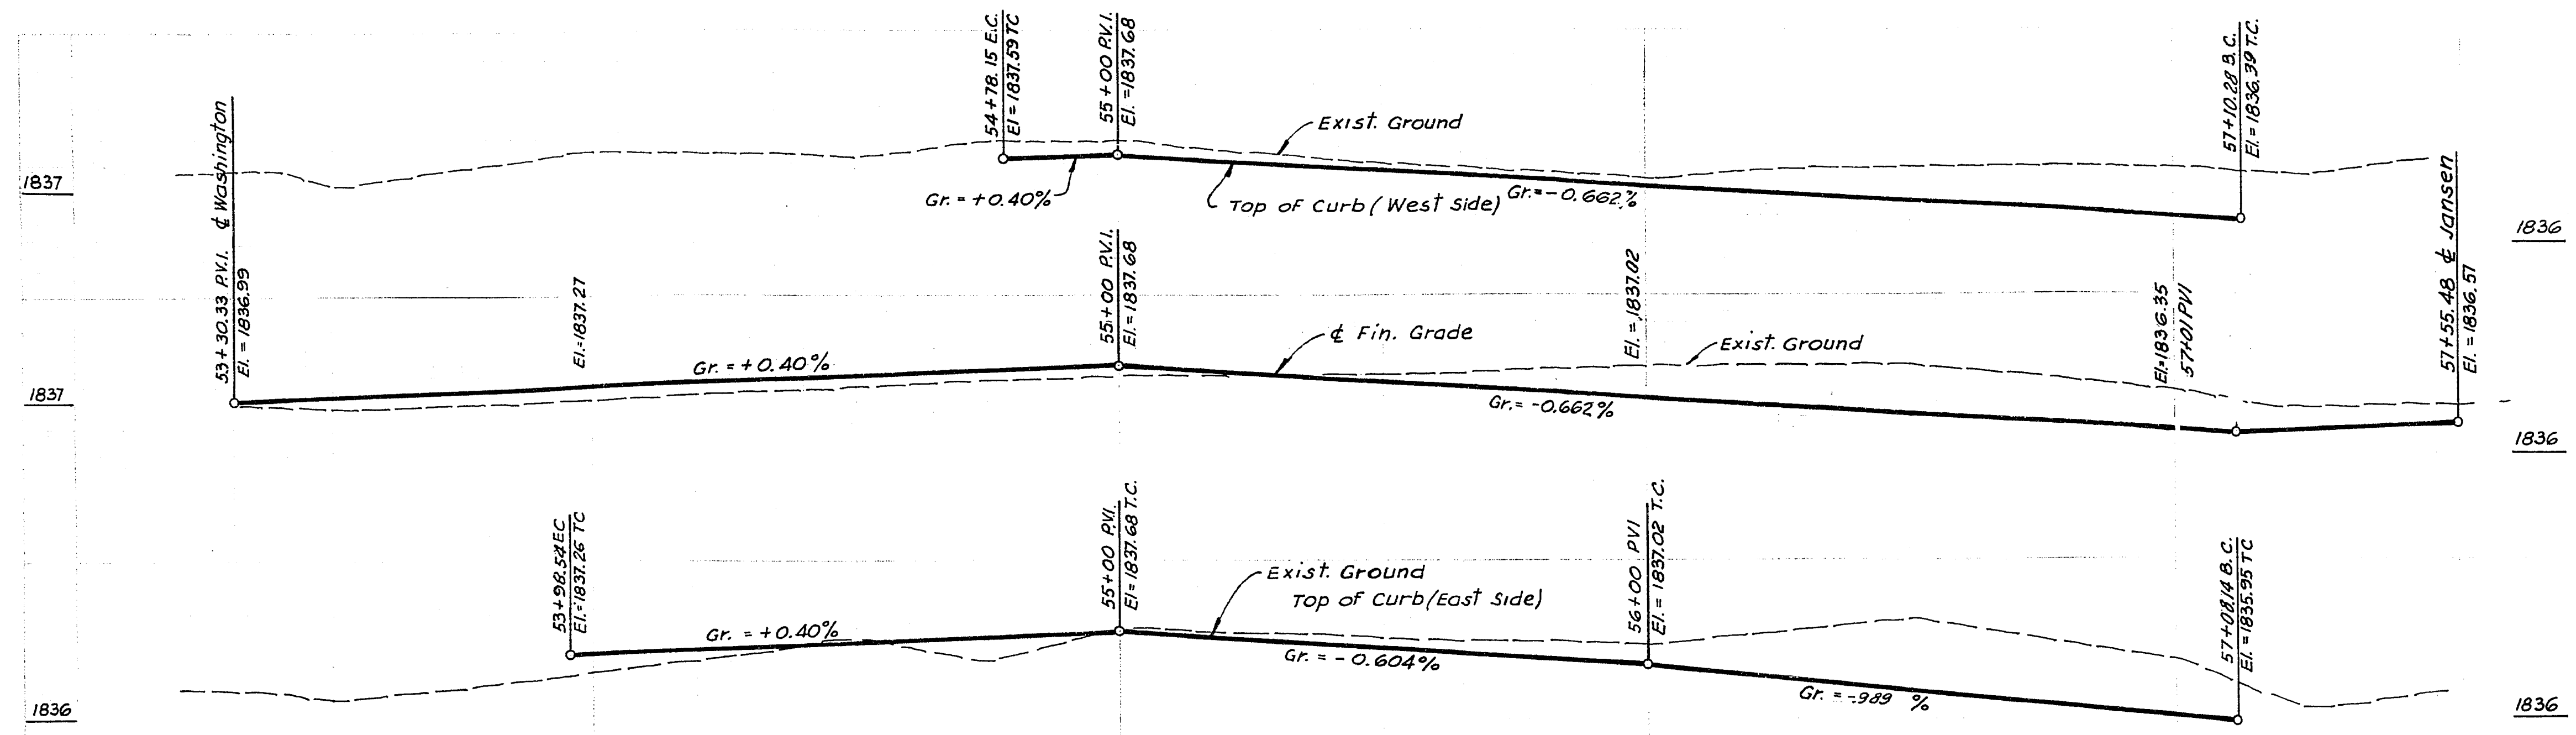

QUANTITIES				
ITEM	SAD	RSH	CLV	UNIT
1 EXCAVATION (UNCLASSIFIED)	34	2029		C.Y.
2 TYPE I BASE AGGREGATE		1050		C.Y.
3 TYPE II BASE AGGREGATE	34	360		C.Y.
4 1" A.C. PAVING (TRAFFIC ISLAND)		662		S.Y.
5 1" OVERLAY		1131		S.Y.
6 1" A.C. PAVING (MEDIAN ISLAND)		130		S.Y.
7 3" ASPHALTIC CONCRETE		2950		S.Y.
8 FOG SEAL		4081		S.Y.
9 BLOW SAND		43		S.Y.
10 CONC. VALLEY GUTTER		470		S.F.
11 CONC. CURB & GUTTER-L" TYPE-18"		833		L.F.
12 CONC. CURB & GUTTER-L" TYPE-24"		815		L.F.
13 CONC. SIDEWALK	2791	180		S.F.
14 CONC. MEDIAN ISLAND		910		S.F.
15				
16				
17				
18				
19 REMOVE & RESET STREET SIGNS				1 LUMP LUMPS
20 ADJUST SANITARY MANHOLES				NONE EA.
21 CONC. MON.				1 EA.
22				
23				
24				
STORM SEWER				SEE SHEET 12SD

Change Order No. 1 Eliminate Items 9, 10 Added Item 35, D-10
 Traffic Island on NW cor. of Washington & 25th, changed T.C. elev.
 @ SW cor. of Jansen & 25th from 1837.75 to 1837.10
 Addendum No. 1 1" A.C. Pave on Island instead of 1/2"

REV.	DESCRIPTION	DATE	APP.
1		5-3-66	
2		6-3-66	
3		8-1-66	

CITY OF LAS VEGAS, NEVADA
 ENGINEERING DEPARTMENT
 PLAN AND PROFILE
 25 TH STREET WIDENING PROJECT

DESIGNED BY R.J.F.	DATE 5-3-66	PROJECT NUMBER 65-54
DRAWN BY C.S.	6-3-66	CONTRACT NUMBER CLV 255
CHECKED BY K.T.B.	8-1-66	DRAWING NUMBER CLV 20030
APPROVED BY		

