
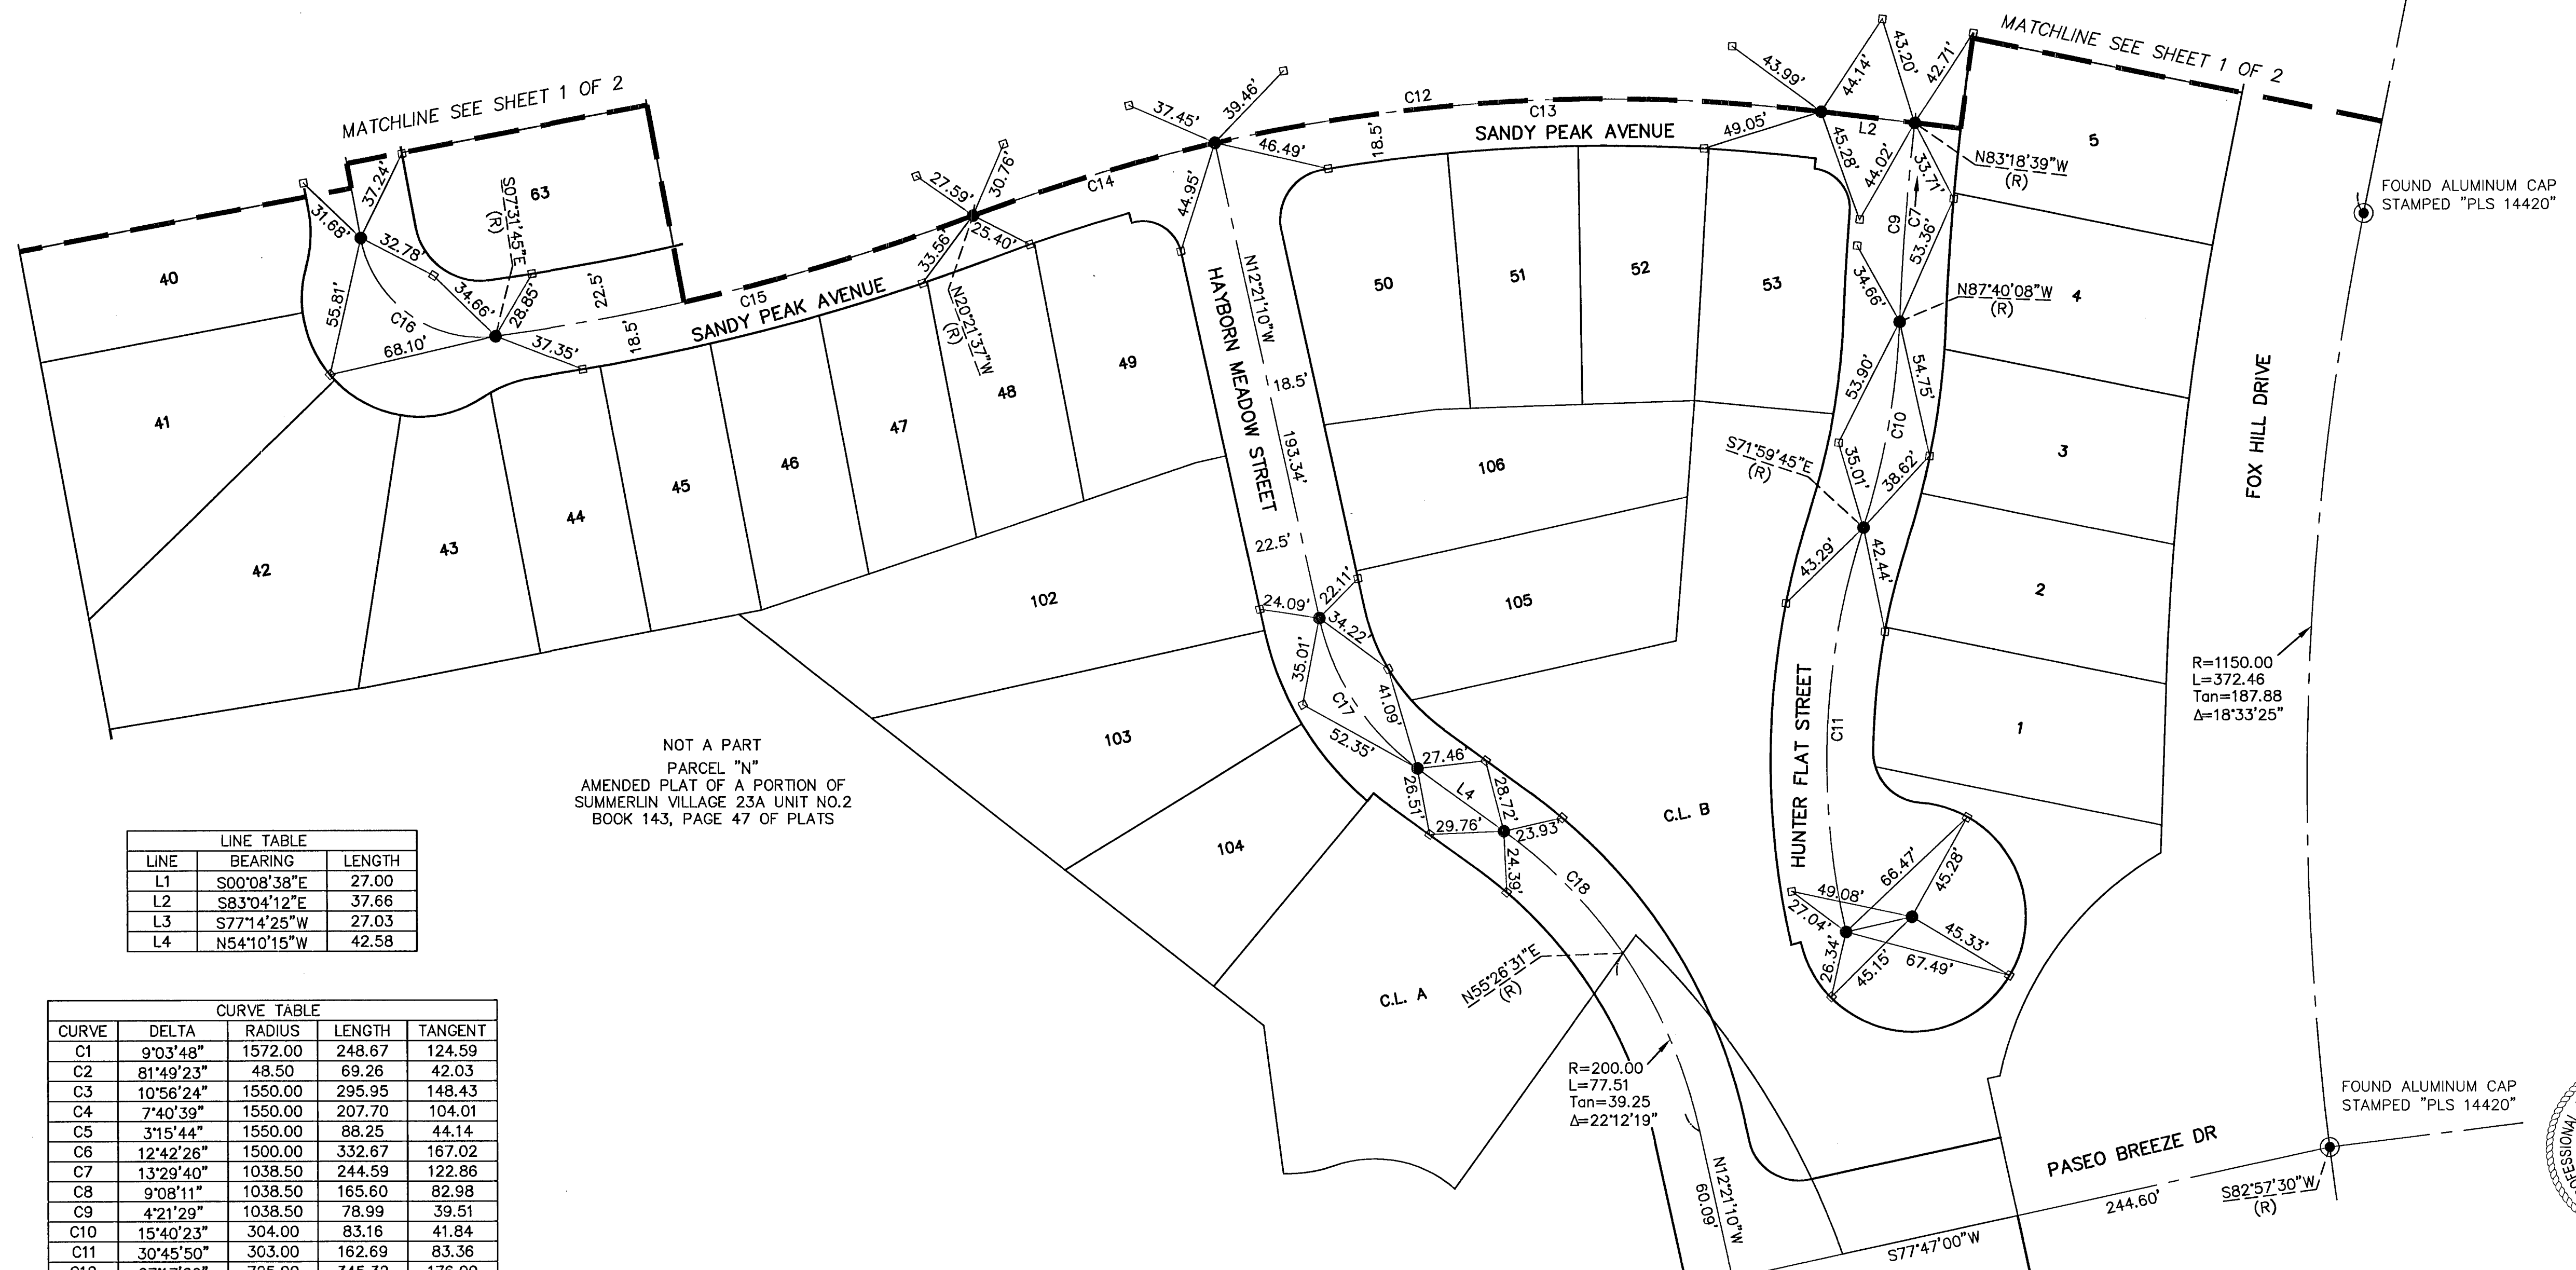


MONUMENT TIE MAP OF ANDORRA & CASTILLE PHASE 1

AS SHOWN BY MAP THEREOF ON FILE IN THE CLARK COUNTY RECORDER'S OFFICE IN BOOK 144, PAGE 94 OF PLATS. SITUATE IN THE NORTHWEST QUARTER (NW 1/4) OF SECTION 34, TOWNSHIP 20 SOUTH, RANGE 59 EAST, M.D.M., CITY OF LAS VEGAS, CLARK COUNTY, NEVADA.

LEGEND

- SUBDIVISION BOUNDARY LINE
- - - ASSESSOR'S PARCEL LINE
- LOT LINE
- RIGHT-OF-WAY LINE/LIMITS OF PRIVATE STREET
- STREET CENTERLINE
- MATCHLINE
- FOUND MONUMENT AS DESCRIBED
- SET TYPE III MONUMENT STAMPED "PLS 17449"
- SET TYPE IV-A REFERENCE MONUMENT STAMPED "PLS 17449"
- 1 LOT NUMBER
- (R) RADIAL BEARING

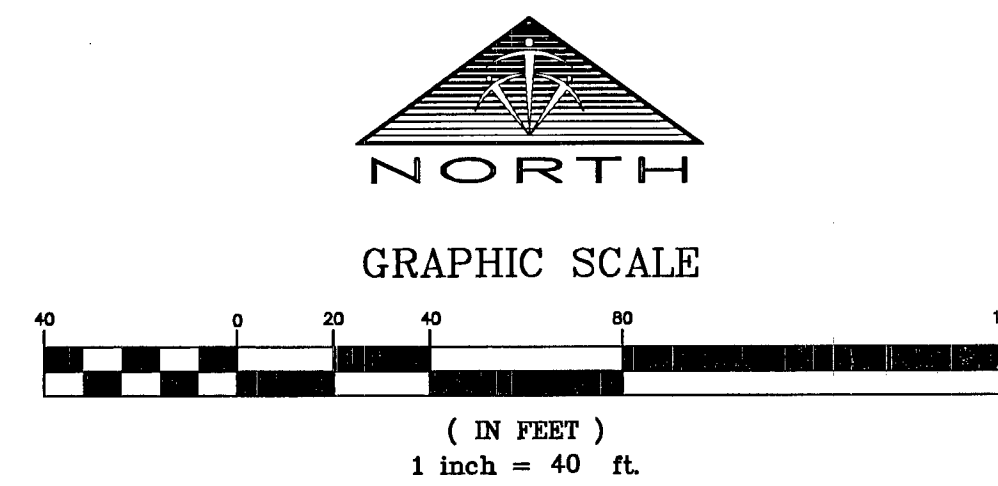

LINE TABLE		
LINE	BEARING	LENGTH
L1	S00°08'38"E	27.00
L2	S83°04'12"E	37.66
L3	S77°14'25"W	27.03
L4	N54°10'15"W	42.58

CURVE TABLE				
CURVE	DELTA	RADIUS	LENGTH	TANGENT
C1	9°03'48"	1572.00	248.67	124.59
C2	81°49'23"	48.50	69.26	42.03
C3	10°56'24"	1550.00	295.95	148.43
C4	7°40'39"	1550.00	207.70	104.01
C5	3°15'44"	1550.00	88.25	44.14
C6	12°42'26"	1500.00	332.67	167.02
C7	13°29'40"	1038.50	244.59	122.86
C8	9°08'11"	1038.50	165.60	82.98
C9	4°21'29"	1038.50	78.99	39.51
C10	15°40'23"	304.00	83.16	41.84
C11	30°45'50"	303.00	162.69	83.36
C12	27°17'26"	725.00	345.32	176.00
C13	19°18'09"	725.00	244.25	123.29
C14	7°59'17"	725.00	101.08	50.62
C15	12°49'52"	882.00	197.52	99.17
C16	86°53'31"	48.50	73.55	45.94
C17	41°49'05"	100.00	72.99	38.20
C18	19°36'47"	200.00	68.46	34.57

BASIS OF BEARINGS

SOUTH 11°30'55" WEST, BEING THE BEARING OF A PORTION OF THE CENTERLINE OF FOX HILL DRIVE AS SHOWN BY MAP THEREOF ON FILE IN THE CLARK COUNTY RECORDER'S OFFICE IN BOOK 144, PAGE 94 OF PLATS.

NO MONUMENT FOUND
LOCATION PER
BOOK 145, PAGE 7
OF PLATS

PERMIT-CLV-44992

FMP-45297


BOOK 144, PAGE 94 OF PLATS

NO MONUMENT FOUND
LOCATION PER
BOOK 121, PAGE 12
OF PLATS

FOUND ALUMINUM CAP
STAMPED "PLS 14420"

FOUND ALUMINUM CAP
STAMPED "PLS 14420"

FOUND ALUMINUM CAP
STAMPED "PLS 14420"

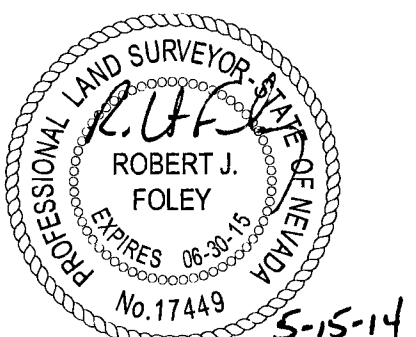

**TRI-CORE
SURVEYING, LLC**

LAND SURVEYING · CONSTRUCTION STAKING
MAPPING & LAND DEVELOPMENT SERVICES
BOUNDARY & TOPOGRAPHIC SURVEYS

6761 WEST CHARLESTON BLVD.
LAS VEGAS, NEVADA 89146
TEL. (702) 821-1554 FAX (702) 870-4378

058 4982-1

SHEET 2 OF 2