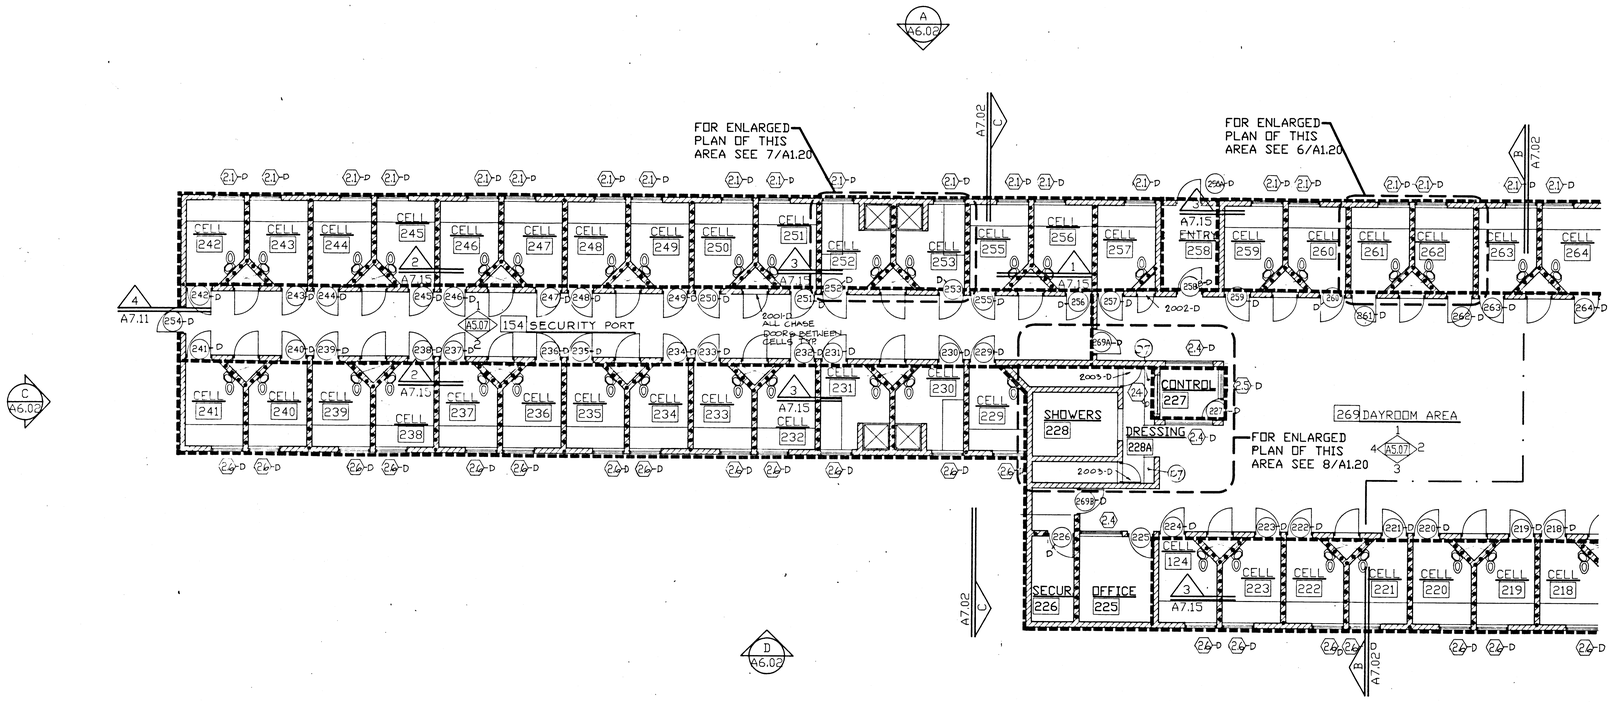

PARTIAL FLOOR PLAN - CLOSE CUSTODY UNIT

SCALE: 1/8"=1'-0"

NORTH

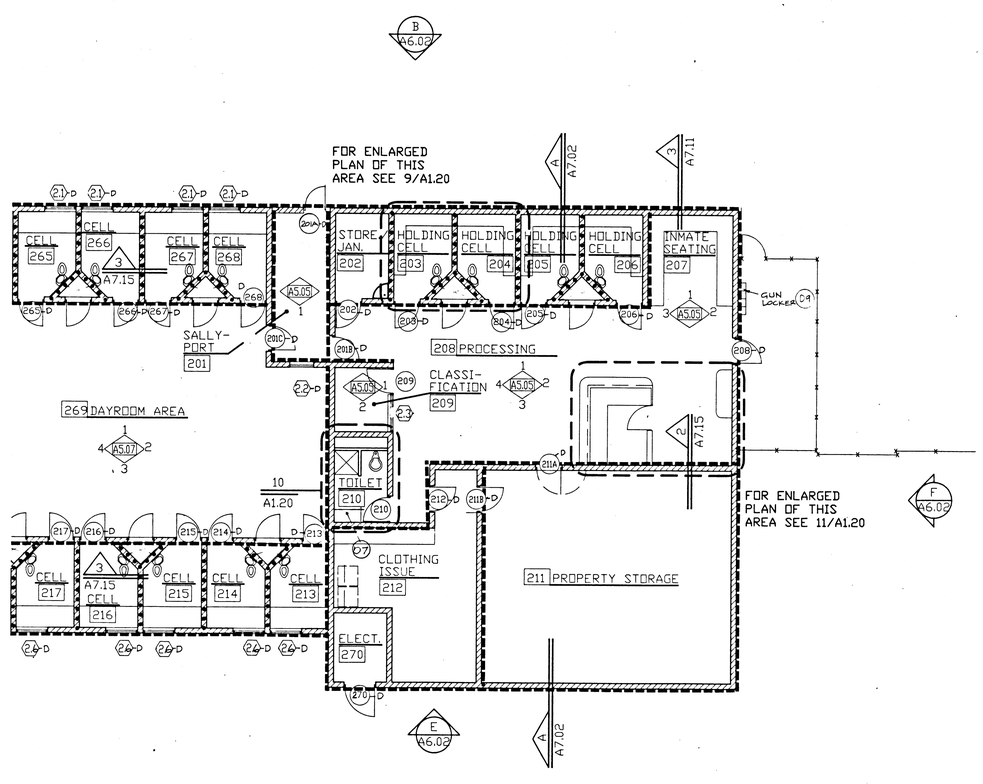

PARTIAL FLOOR PLAN - CLOSE CUSTODY UNIT

SCALE: 1/8"=1'-0"

REVISIONS

REV	DESCRIPTION	DATE	BY

© DOMINGO CAMBEIRO CORPORATION 1990

AS-BUILT RECORD DRAWING
CONSTRUCTION CHANGES SHOWN HEREON ARE BASED ON DATA FURNISHED BY THE CONTRACTOR

© Haldane Harrison Associates, Inc., 1990

Haldane Harrison Associates, Inc.
Detention Consultants and Planners (303) 494-1498
345 MARTIN DRIVE, BOULDER, COLORADO 80303 fax: (303) 449-0906

All ideas, designs, arrangements and plans indicated or presented by this drawing, as instruments of service, are owned by and the property of DOMINGO CAMBEIRO CORPORATION. The use of these plans and/or specifications shall be restricted to the original site for which they were prepared and publication thereof is expressly limited to such use. Reproduction, publication or re-use by any method, in whole or in part, is prohibited. None of such ideas, designs, arrangements or plans shall be used by or disclosed to any person, firm agency, or corporation without the written permission of DOMINGO CAMBEIRO CORPORATION. Visual contact with these plans and specifications shall constitute prima facie evidence of acceptance of these restrictions.

SEAL

DRAWN BY

CHECKED BY

ISSUED DATE 11-15-90

FLOOR PLAN
CLOSE CUSTODY

DO NOT SCALE DRAWINGS

CITY OF LAS VEGAS
DETENTION FACILITY EXPANSION
3100 EAST STEWART AVENUE
LAS VEGAS, NEVADA

Domingo Cambeiro Corporation
ARCHITECTURE · ENGINEERING · PLANNING · INTERIORS
3555 PECOS-McLEOD LC. LAS VEGAS, NEVADA 89121 (702) 792-0084

15-290

SHEET NO.

DS2

513-55X

FILE NO. 90M82.DWG
JOB NO. 913

 

PARTIAL FLOOR PLAN – CLOSE CUSTODY UNIT

 

PARTIAL FLOOR PLAN – CLOSE CUSTODY UNIT



FLOOR PLAN
CLOSE CUSTODY

CITY OF LAS VEGAS
DETENTION FACILITY EXPANSION
300 EAST STEWART AVENUE
LAS VEGAS, NEVADA


D02
184 of 163