DETENTION OPENING SCHEDULE - LAS VEGAS DETENTION CENTER

DOOR/ OPEN'G #	FROM	TO	DOOR OR RELITE								FRAME								Hd we Set	FR Mins	Remarks
			W	H	T	Matl	Ga	G	Elev	GL	Matl	Ga	G	Elev	GL	Sill	Jamb	Head			
222-D	CELL	DAYROOM	3	7	2"	SHM	14		D6A	-	SHM	12		A			10/ DS10	9/DS10	2		CB,OHS
223-D	CELL	DAYROOM	3	7	2"	SHM	14		D6A	-	SHM	12		A			10/ DS10	9/DS10	2		CB,OHS
224-D	CELL	DAYROOM	3	7	2"	SHM	14		D6A	-	SHM	12		A			10/ DS10	9/DS10	2		CB,OHS
226-D	SECURE	VESTIBULE	3	7	2"	SHM	14		D1	-	SHM	14		A			10/ DS10	9/DS10	10		
227-D	HOUSING CONTROL	DAYROOM	3	7	2"	SHM	14		D4	GL1	SHM	12		B2.5-D			10/ DS10	9/DS10	4		
229-D	CELL	SEC. PORT	3	7	2"	SHM	14		D6A	-	SHM	12		B			10/ DS10	9/DS10	7		CB,OHS
230-D	CELL	SEC. PORT	3	7	2"	SHM	14		D6A	-	SHM	12		B			10/ DS10	9/DS10	7		CB,OHS
231-D	CELL	SEC. PORT	3	7	2"	SHM	14		D6A	-	SHM	12		B			10/ DS10	9/DS10	7		CB,OHS
232-D	CELL	SEC. PORT	3	7	2"	SHM	14		D6A	-	SHM	12		B			10/ DS10	9/DS10	7		CB,OHS
233-D	CELL	SEC. PORT	3	7	2"	SHM	14		D6A	-	SHM	12		B			10/ DS10	9/DS10	7		CB,OHS
234-D	CELL	SEC. PORT	3	7	2"	SHM	14		D6A	-	SHM	12		B			10/ DS10	9/DS10	7		CB,OHS
235-D	CELL	SEC. PORT	3	7	2"	SHM	14		D6A	-	SHM	12		B			10/ DS10	9/DS10	7		CB,OHS
236-D	CELL	SEC. PORT	3	7	2"	SHM	14		D6A	-	SHM	12		B			10/ DS10	9/DS10	7		CB,OHS
237-D	CELL	SEC. PORT	3	7	2"	SHM	14		D6A	-	SHM	12		B			10/ DS10	9/DS10	7		CB,OHS
238-D	CELL	SEC. PORT	3	7	2"	SHM	14		D6A	-	SHM	12		B			10/ DS10	9/DS10	7		CB,OHS
239-D	CELL	SEC. PORT	3	7	2"	SHM	14		D6A	-	SHM	12		B			10/ DS10	9/DS10	7		CB,OHS
240-D	CELL	SEC. PORT	3	7	2"	SHM	14		D6A	-	SHM	12		B			10/ DS10	9/DS10	7		CB,OHS
241-D	CELL	SEC. PORT	3	7	2"	SHM	14		D6A	-	SHM	12		B			10/ DS10	9/DS10	7		CB,OHS
242-D	CELL	SEC. PORT	3	7	2"	SHM	14		D6A	-	SHM	12		B			10/ DS10	9/DS10	7		CB,OHS
243-D	CELL	SEC. PORT	3	7	2"	SHM	14		D6A	-	SHM	12		B			10/ DS10	9/DS10	7		CB,OHS
244-D	CELL	SEC. PORT	3	7	2"	SHM	14		D6A	-	SHM	12		B			10/ DS10	9/DS10	7		CB,OHS
245-D	CELL	SEC. PORT	3	7	2"	SHM	14		D6A	-	SHM	12		B			10/ DS10	9/DS10	7		CB,OHS
246-D	CELL	SEC. PORT	3	7	2"	SHM	14		D6A	-	SHM	12		B			10/ DS10	9/DS10	7		CB,OHS
247-D	CELL	SEC. PORT	3	7	2"	SHM	14		D6A	-	SHM	12		B			10/ DS10	9/DS10	7		CB,OHS
248-D	CELL	SEC. PORT	3	7	2"	SHM	14		D6A	-	SHM	12		B			10/ DS10	9/DS10	7		CB,OHS
249-D	CELL	SEC. PORT	3	7	2"	SHM	14		D6A	-	SHM	12		B			10/ DS10	9/DS10	7		CB,OHS
250-D	CELL	SEC. PORT	3	7	2"	SHM	14		D6A	-	SHM	12		B			10/ DS10	9/DS10	7		CB,OHS
251-D	CELL	SEC. PORT	3	7	2"	SHM	14		D6A	-	SHM	12		B			10/ DS10	9/DS10	7		CB,OHS
252-D	CELL	SEC. PORT	3	7	2"	SHM	14		D6A	-	SHM	12		B			10/ DS10	9/DS10	7		CB,OHS
253-D	CELL	SEC. PORT	3	7	2"	SHM	14		D6A	-	SHM	12		B			10/ DS10	9/DS10	7		CB,OHS
254-D	EXTERIOR	SEC. PORT	3	7	2"	SHM	14	X	D2	GL2	SHM	12	X	B		8/DS10	6/DS10	5/DS10	8	45	
255-D	CELL	SEC. PORT	3	7	2"	SHM	14		D6A	-	SHM	12		B			10/ DS10	9/DS10	7		CB,OHS
256-D	CELL	SEC. PORT	3	7	2"	SHM	14		D6A	-	SHM	12		A			10/ DS10	9/DS10	7		CB,OHS
257-D	CELL	SEC. PORT	3	7	2"	SHM	14		D6A	-	SHM	12		A			10/ DS10	9/DS10	2		CB,OHS
258A-D	EXTERIOR	ENTRY	3	7	2"	SHM	14	X	D2	GL2	SHM	12	X	B		8/DS10	6/DS10	5/DS10	6	45	
258B-D	ENTRY	DAYROOM	3	7	2"	SHM	14		D2	GL2	SHM	12		B			10/ DS10	9/DS10	8	90	
259-D	CELL	DAYROOM	3	7	2"	SHM	14		D6A	-	SHM	12		A			10/ DS10	9/DS10	2		CB,OHS
260-D	CELL	DAYROOM	3	7	2"	SHM	14		D6A	-	SHM	12		A			10/ DS10	9/DS10	2		CB,OHS
261-D	CELL	DAYROOM	3	7	2"	SHM	14		D6A	-	SHM	12		A			10/ DS10	9/DS10	2		CB,OHS
262-D	CELL	DAYROOM	3	7	2"	SHM	14		D6A	-	SHM	12		A			10/ DS10	9/DS10	2		CB,OHS
263-D	CELL	DAYROOM	3	7	2"	SHM	14		D6A	-	SHM	12		A			10/ DS10	9/DS10	2		CB,OHS
264-D	CELL	DAYROOM	3	7	2"	SHM	14		D6A	-	SHM	12		A			10/ DS10	9/DS10	2		CB,OHS
265-D	CELL	DAYROOM	3	7	2"	SHM	14		D6A	-	SHM	12		A			10/ DS10	9/DS10	2		CB,OHS
266-D	CELL	DAYROOM	3	7	2"	SHM	14		D6A	-	SHM	12		A			10/ DS10	9/DS10	2		CB,OHS
267-D	CELL	DAYROOM	3	7	2"	SHM	14		D6A	-	SHM	12		A			10/ DS10	9/DS10	2		CB,OHS
268-D	CELL	DAYROOM	3	7	2"	SHM	14		D6A	-	SHM	12		A			10/ DS10	9/DS10	2		CB,OHS
269A-D	CORRIDOR	DAYROOM	3	7	2"	SHM	14		D4	GL1	SHM	12		B			10/ DS10	9/DS10	3		
269B-D	DAYROOM	VESTIBULE	3	7	2"	SHM	14		D1	-	SHM	14		A			10/ DS10	9/DS10	9		
270-D	EXTERIOR	ELECTRICAL	3[8]	7	2"	SHM	14	X	D5	-	SHM	12	X	A		8/DS10	6/DS10	5/DS10	13		w/24"x24" SEC. GRILLES
2001-D	CHASE		2[4]	6[4]	2"	SHM	16		D1	-	SHM	16		A		10/ DS12	10/ DS10	9/DS10	19		
2002-D	CHASE		2	6[4]	2"	SHM	16		D1	-	SHM	16		A		10/ DS12	10/ DS10	9/DS10	19		
2003-D	CHASE		2[2]	6[4]	2"	SHM	16	X	D1		SHM	16	X	A		10/ DS12	10/ DS10	9/DS10	19		

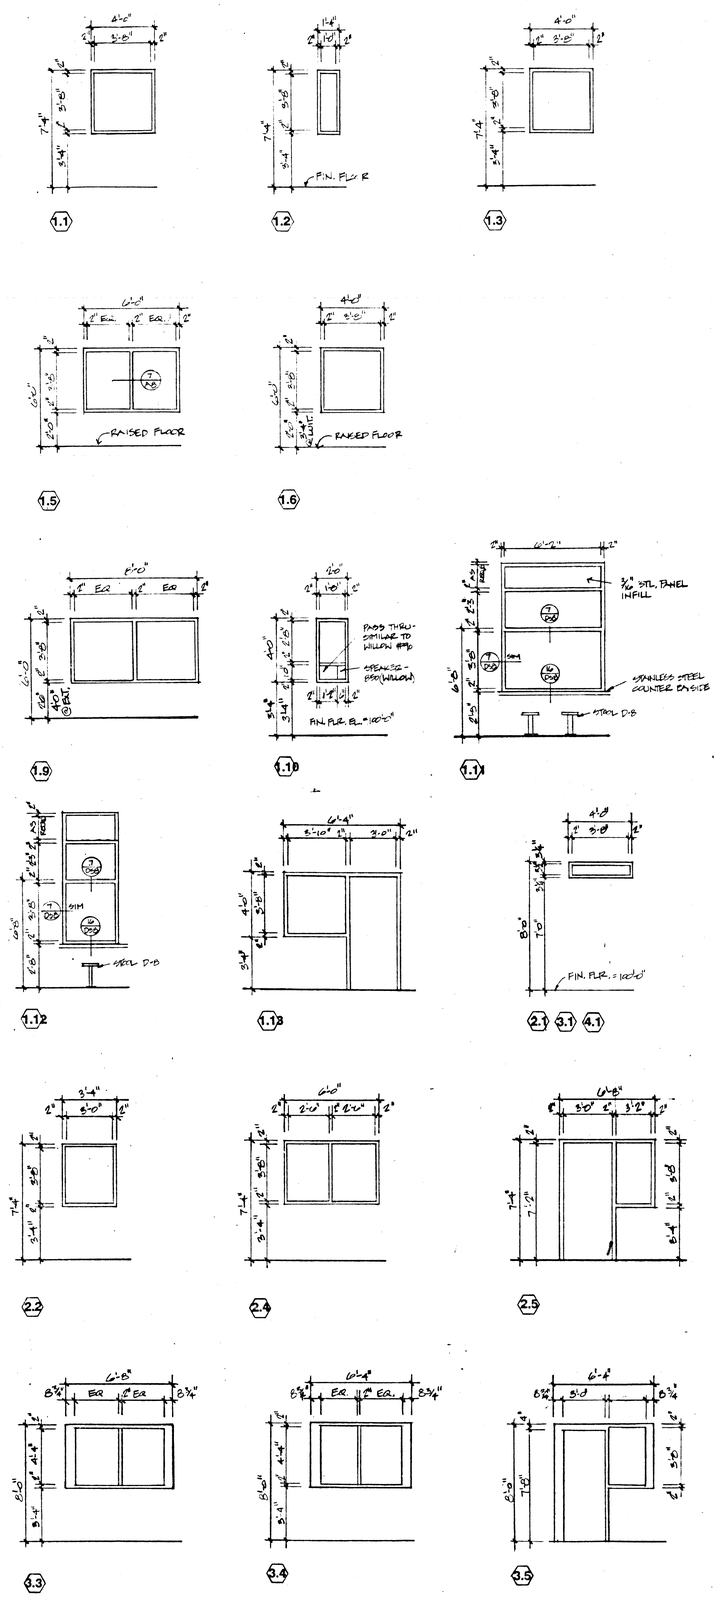

RELITE TYPES

REVISIONS

REV	DESCRIPTION	DATE	BY

AS-BUILT RECORD DRAWING
CONSTRUCTION CHANGES SHOWN HEREON ARE BASED ON DATA FURNISHED BY THE CONTRACTOR

© Haldane Harrison Associates, Inc., 1990

Haldane Harrison Associates, Inc.
Detention Consultants and Planners (303) 494-1496
345 MARTIN DRIVE, BOULDER, COLORADO 80303 fax: (303) 449-0906

All designs, arrangements and plans indicated or presented by this drawing, as instruments of service, are owned by and the property of DOMINGO CAMBEIRO CORPORATION. The use of these plans and/or specifications shall be restricted to the original site for which they were prepared and publication thereof is expressly limited to such use. Reproduction, publication or re-use by any method, in whole or in part, is prohibited. None of such designs, arrangements or plans shall be used by or disclosed to any person, firm, agency, or corporation without the written permission of DOMINGO CAMBEIRO CORPORATION. Visual contact with these plans and specifications shall constitute prima facie evidence of acceptance of these restrictions.

SEAL

DRAWN BY

CHECKED BY

ISSUED DATE 11-15-90

DETENTION SCHEDULES

DO NOT SCALE DRAWINGS

CITY OF LAS VEGAS
DETENTION FACILITY EXPANSION
3100 EAST STEWART AVENUE
LAS VEGAS, NEVADA

Domingo Cambeiro Corporation
ARCHITECTURE · ENGINEERING · PLANNING · INTERIORS
3555 PECOS-McLEOD IC. LAS VEGAS, NEVADA 89121 (702) 732-0084

SHEET NO. 9113-11.15.90

DS7

DETENTION SPECIFIC SCHEDULE - LAS VEGAS DETENTION CENTER

			DOOR OR FRAME																				