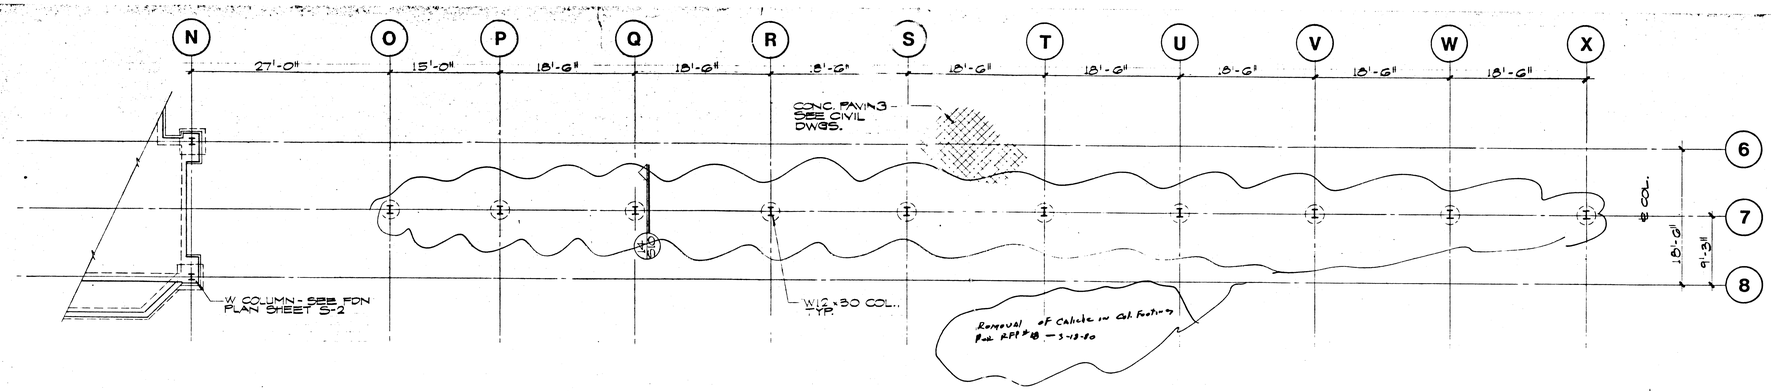

FOUNDATION PLAN - EAST CANOPY

1/8" = 1'-0"

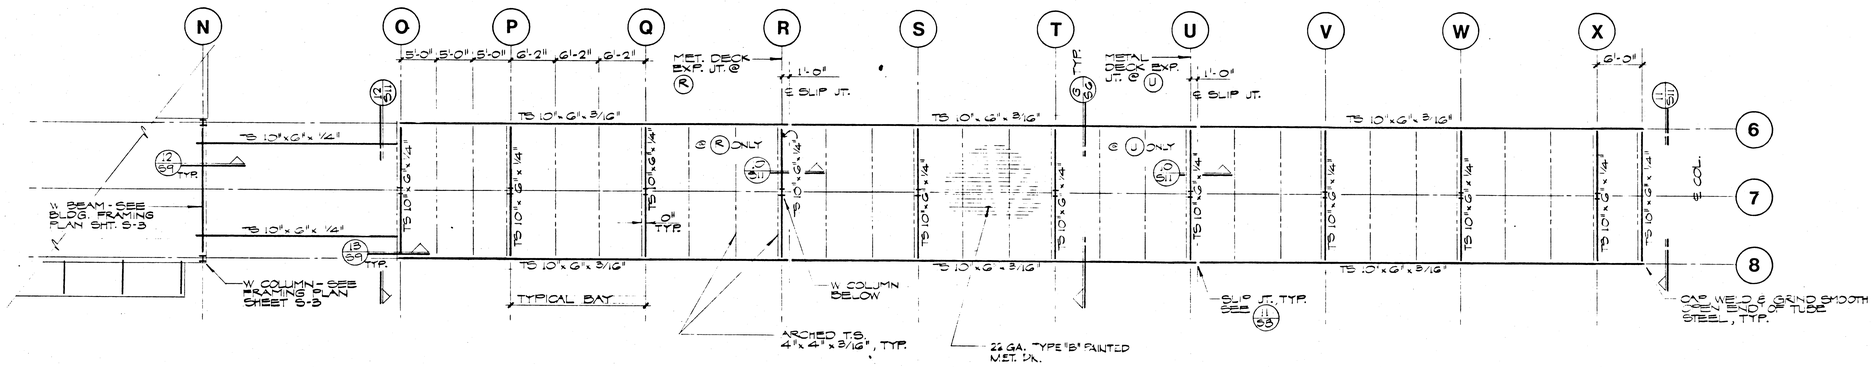

FRAMING PLAN - EAST CANOPY

1/8" = 1'-0"

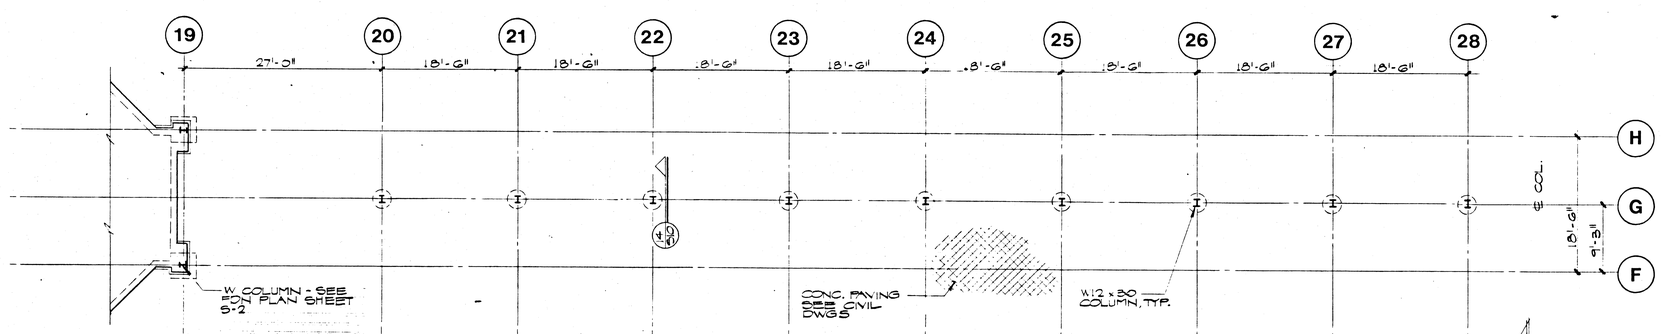

FOUNDATION PLAN - SOUTH CANOPY

1/8" = 1'-0"

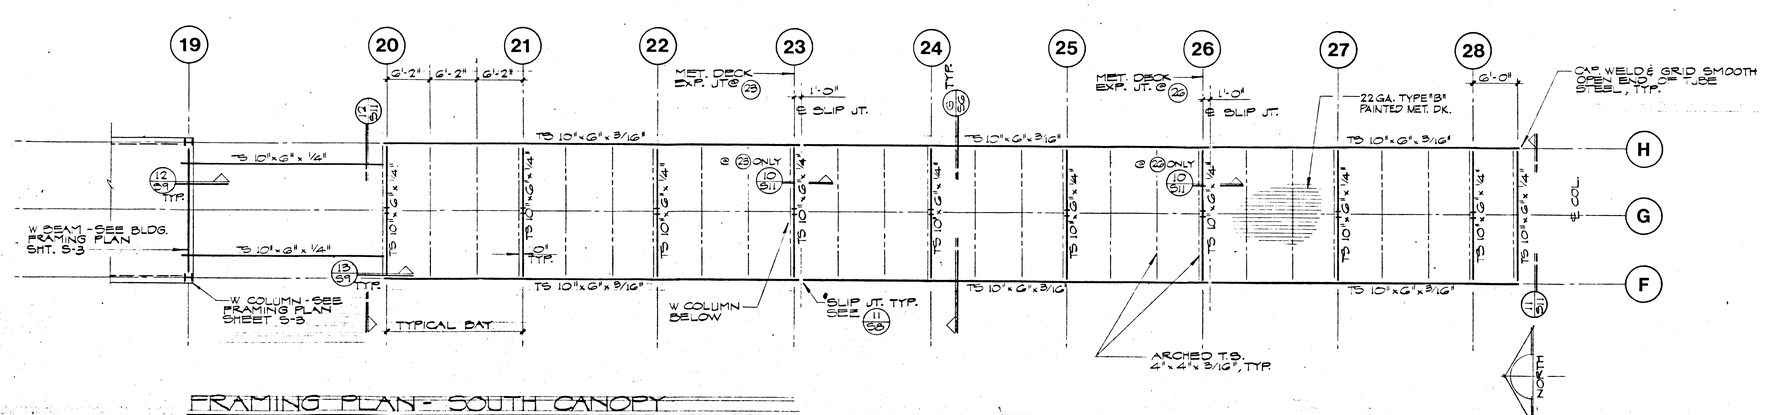

FRAMING PLAN - SOUTH CANOPY

1/8" = 1'-0"

GUNNY, BRIZENDINE & POGGEMEYER
ENGINEERS PLANNERS
1000 SOUTH VALLEY VIEW BLVD. • LAS VEGAS • NEVADA 89107 • (702) 878-6337
851 MARGRAVE DRIVE • ELKO • NEVADA 89801 • (702) 738-7101
8433

DATE 12-17-05
DRAWN
CHECKED RG
JOB NO. 05-164

DOBRUSKY KITTRELL GARLOCK aia Architects
8555 CAMBRIDGE ST. LAS VEGAS, NEVADA 89119 (702) 735-0455

City of Las Vegas
Downtown Transportation Center
Las Vegas, Nevada

SHEET S-5
OF 47 OF 65

FILE NUMBER 590-21