

Avoid cutting underground utility lines. It's costly.

**Call before you Dig.**


**1-800-227-2600**

UNDERGROUND SERVICE ALERT USA

PLATE NO.	TITLE
2	SERVICE INSTALLATION
3	ANCHOR BLOCK DETAILS
4	BLOW-OFF ASSEMBLY
5	TRUST BLOCK INSTALLATION
6	TYPICAL TRENCH SECTION BACKFILL SPECIFICATION
7 (2 SHTS)	FIRE HYDRANT INSTALLATION
8	VALVE BOX INSTALLATION & ADJUSTMENT
17	DETECTOR METER INSTALL.
22	DETECTOR CHECK INSTALL.

DRAWING No.	TITLE
D-19	TYPE "L" CURB
R-2.1.B (604)	SLOTTED C.M.P. DRAIN
D-52	STD. ECCENTRIC MANHOLE
D-53	GRADE RING SEQUENCE
D-55	STD. MANHOLE BASES
D-56	STD. MANHOLE COVER & RING
D-57	STD. MANHOLE STEPS
D-22, D-22A	WHEELCHAIR RAMP
D-40	TYPE "D" DROP INLET
D-62	SEWER CLEANOUT CONN. (W/ BRASS CAP)
D-67B, D-67C	TRENCH DETAIL

- NOTES:**
1. BENCHMARK # 0612701-CLV BC IN TC ELEV. = 2011.99
  2. SEE DETAIL (1) FOR MODIFIED TYPE "A" CURB
  3. SEE SHEET FOR GENERAL CIVIL SLOTTED C.M.P. DRAIN INFORMATION. SLOTTED C.M.P. DRAIN SHOULD BE Laid LONGITUDINAL BOTH SIDED W/ C.M.P. DRAIN @ CENTER.
  4. CURB & GUTTER TO CLEAR EXIST. TELEPHONE MANHOLE BOX LOCATED @ MESQUITE AVE.

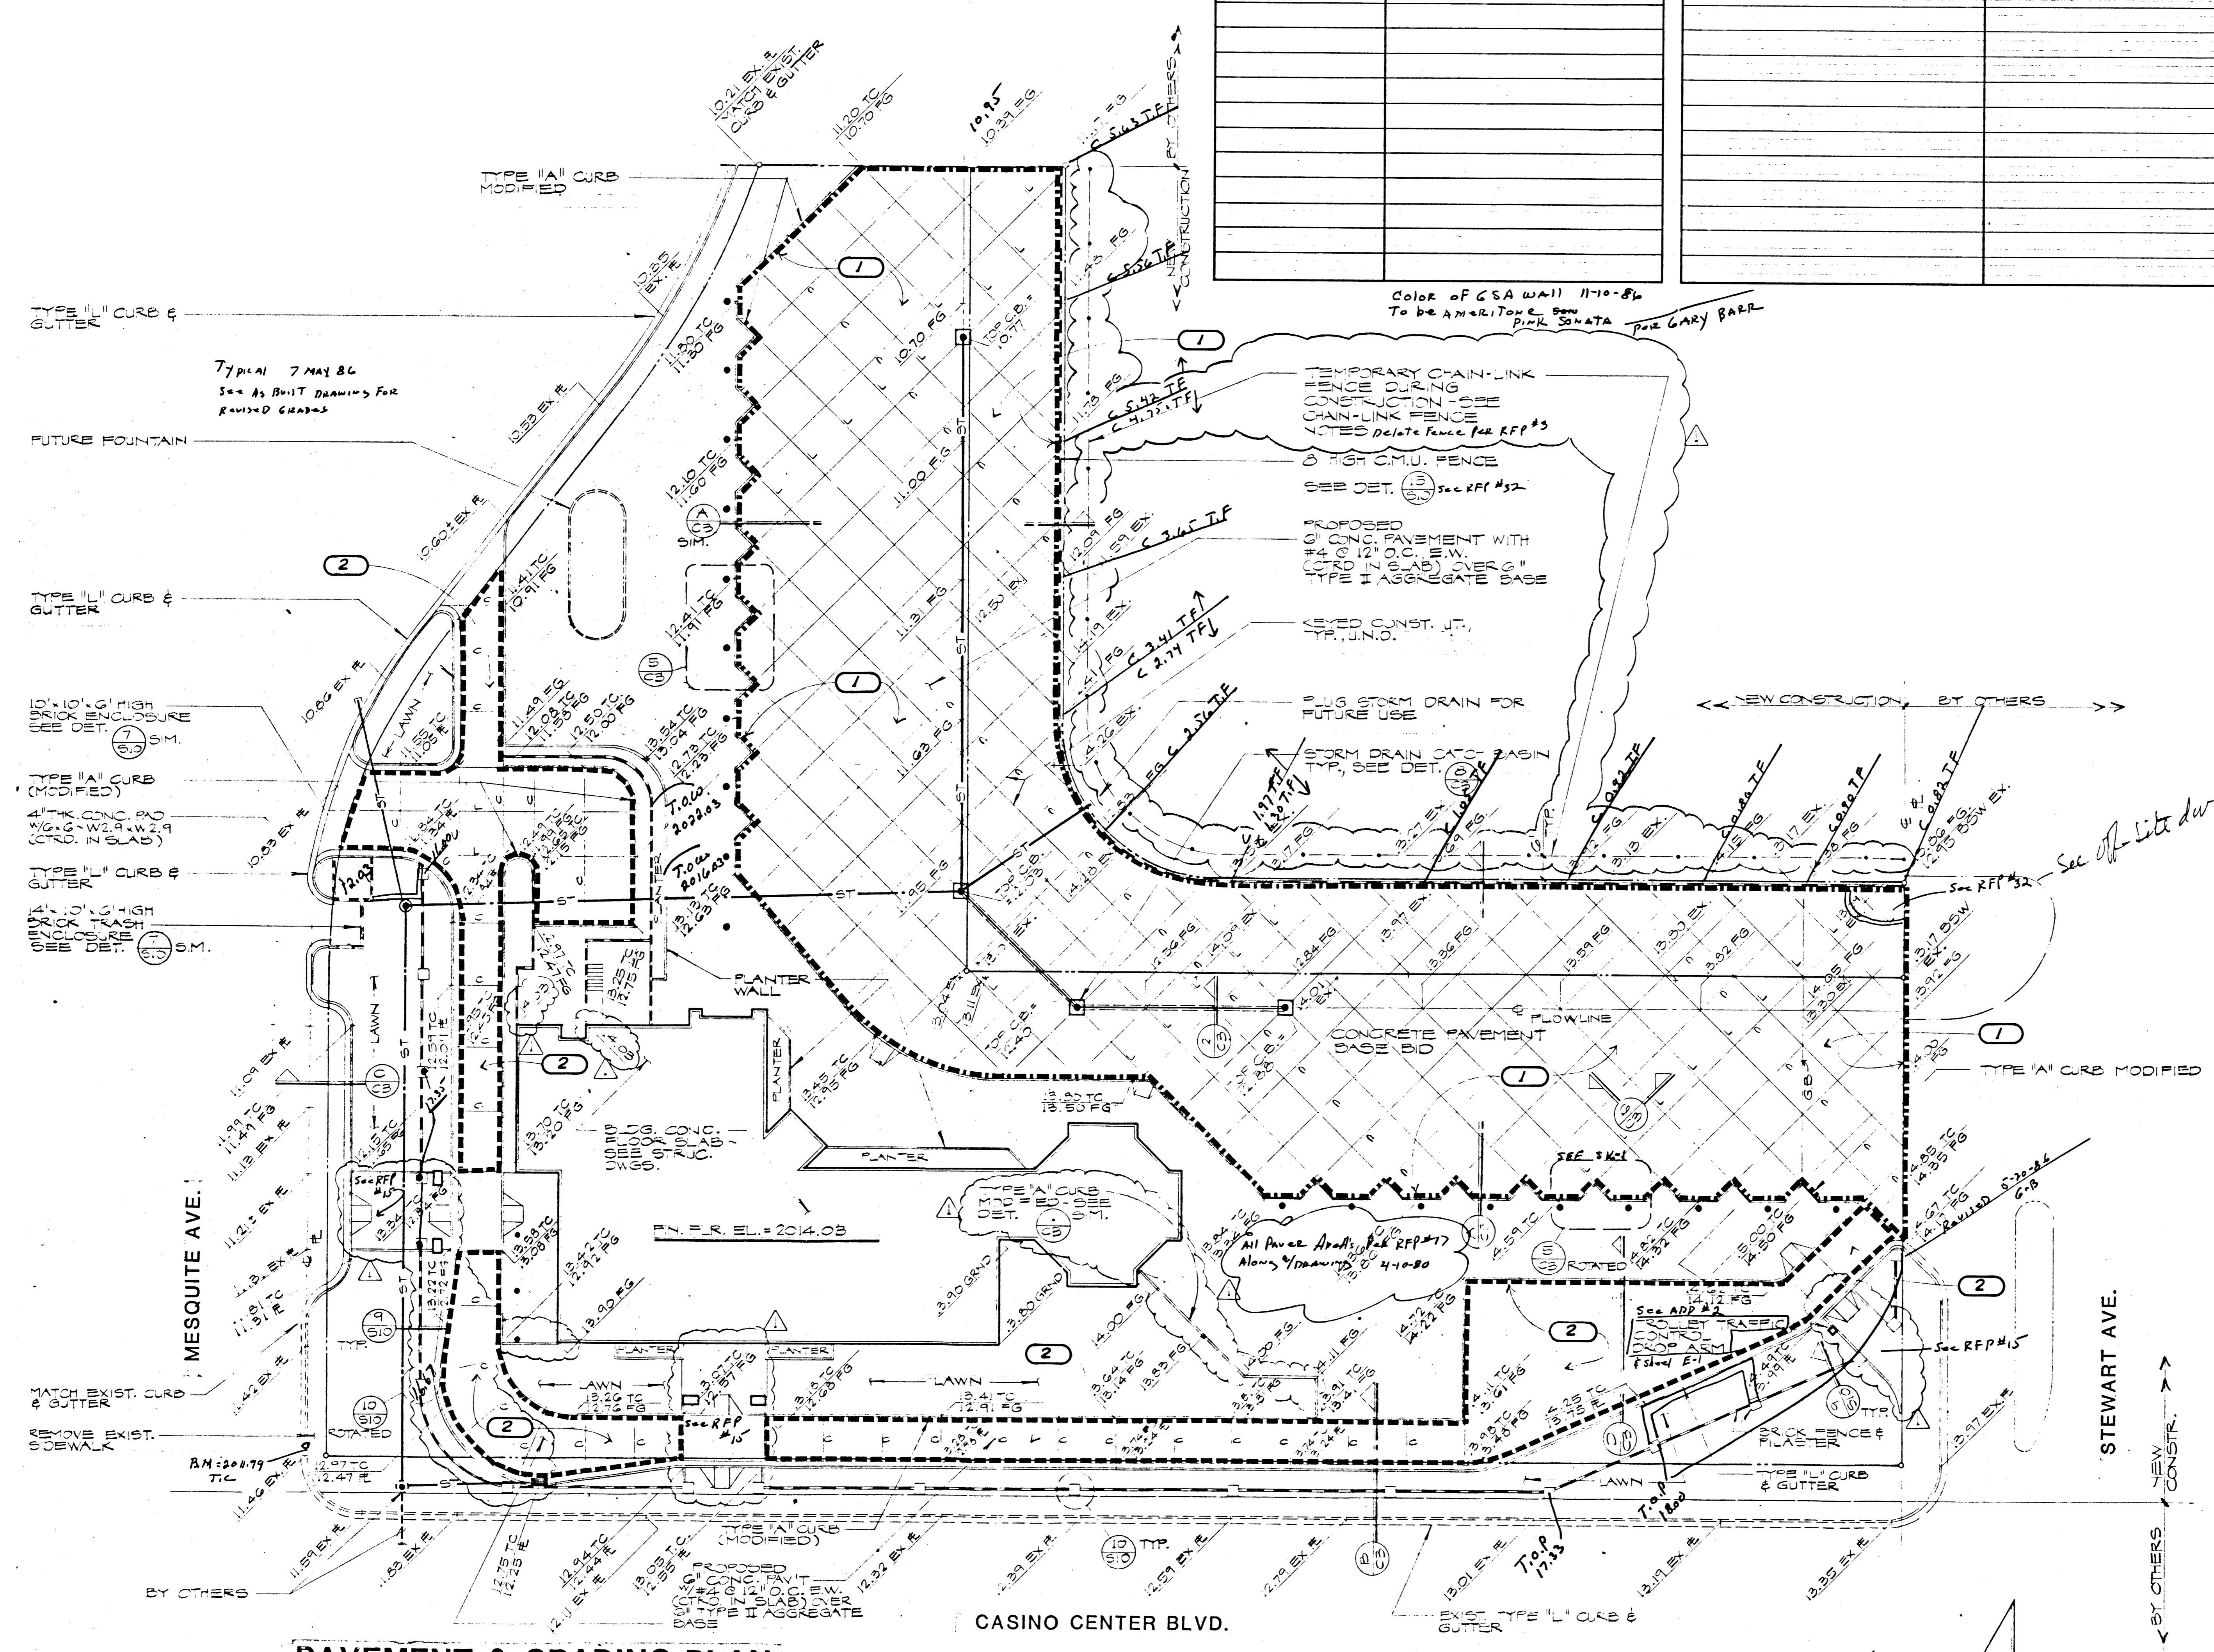

- CHAIN-LINK FENCE NOTES:**
1. HEIGHT SHALL BE 6'-0" HIGH.
  2. WIRE FENCE MESH SHALL BE 9 GA. SIZE 2x2.
  3. POST: CORNER POSTS SHALL BE 3" INTERMEDIATE POSTS SHALL BE 2 1/2" MAXIMUM SPACING 10'-0" O.C.
  4. RAILS - TOP BOTTOM & INTERMEDIATE RAIL SHALL BE 1/8" ROUND.

- 1 DEDUCTIVE BID ITEM #1 (I)**  
IN LIEU OF CONC. PAVEMENT  
SEE DETAIL (24)
- 2 DEDUCTIVE BID ITEM #2 (II)**  
IN LIEU OF CONC. PAVEMENT  
SEE DETAIL (24)

**LEGEND**

	BRICK FENCE
	NEW
	EXISTING
	BY OTHERS
	PROPERTY LINE
	BUILDING PERIMETER OUTLINE
	ELEVATIONS
	CONSTRUCTION BOUNDARY
	STORM DRAIN
	SLOTTED C.M.P.
	INTERLOCKING CONC. PAVERS OVER GEOTEXT. OVER COMPACTED SAND BASE
	EXIST. SANITARY SEWER
	NEW SANITARY SEWER
	NEW MANHOLE
	CATCH BASIN
	TYPE "D" DROP INLET
	CONSTRUCTION JOINT
	UNDERGROUND TELEPHONE CONDUIT
	LONGITUDINAL CONCRETE (CURB)

**PAVEMENT & GRADING PLAN**  
1" = 20'

ALL INFORMATION ISSUED FOR ACCESS ONLY  
**GUNNY, BRIZENDINE & POGGEMEYER**  
ENGINEERS  
PLANNERS  
1400 W. MARYLAND DRIVE  
LAS VEGAS, NEVADA 89102  
(702) 733-0433

**DOBRSKY KITTRELL GARLOCK**  
Architects  
1000 CALLE DEL ARCO  
LAS VEGAS, NEVADA 89101  
(702) 733-0433

Center  
City of Las Vegas  
Transportation  
Las Vegas, Nevada  
DownTown

Sheet  
**C-2**  
4 of 6  
310-53