


Avoid cutting underground utility lines. It's costly.

Call
before you
Dig.


1-800-227-2600

UNDERGROUND SERVICE ALERT (USA)

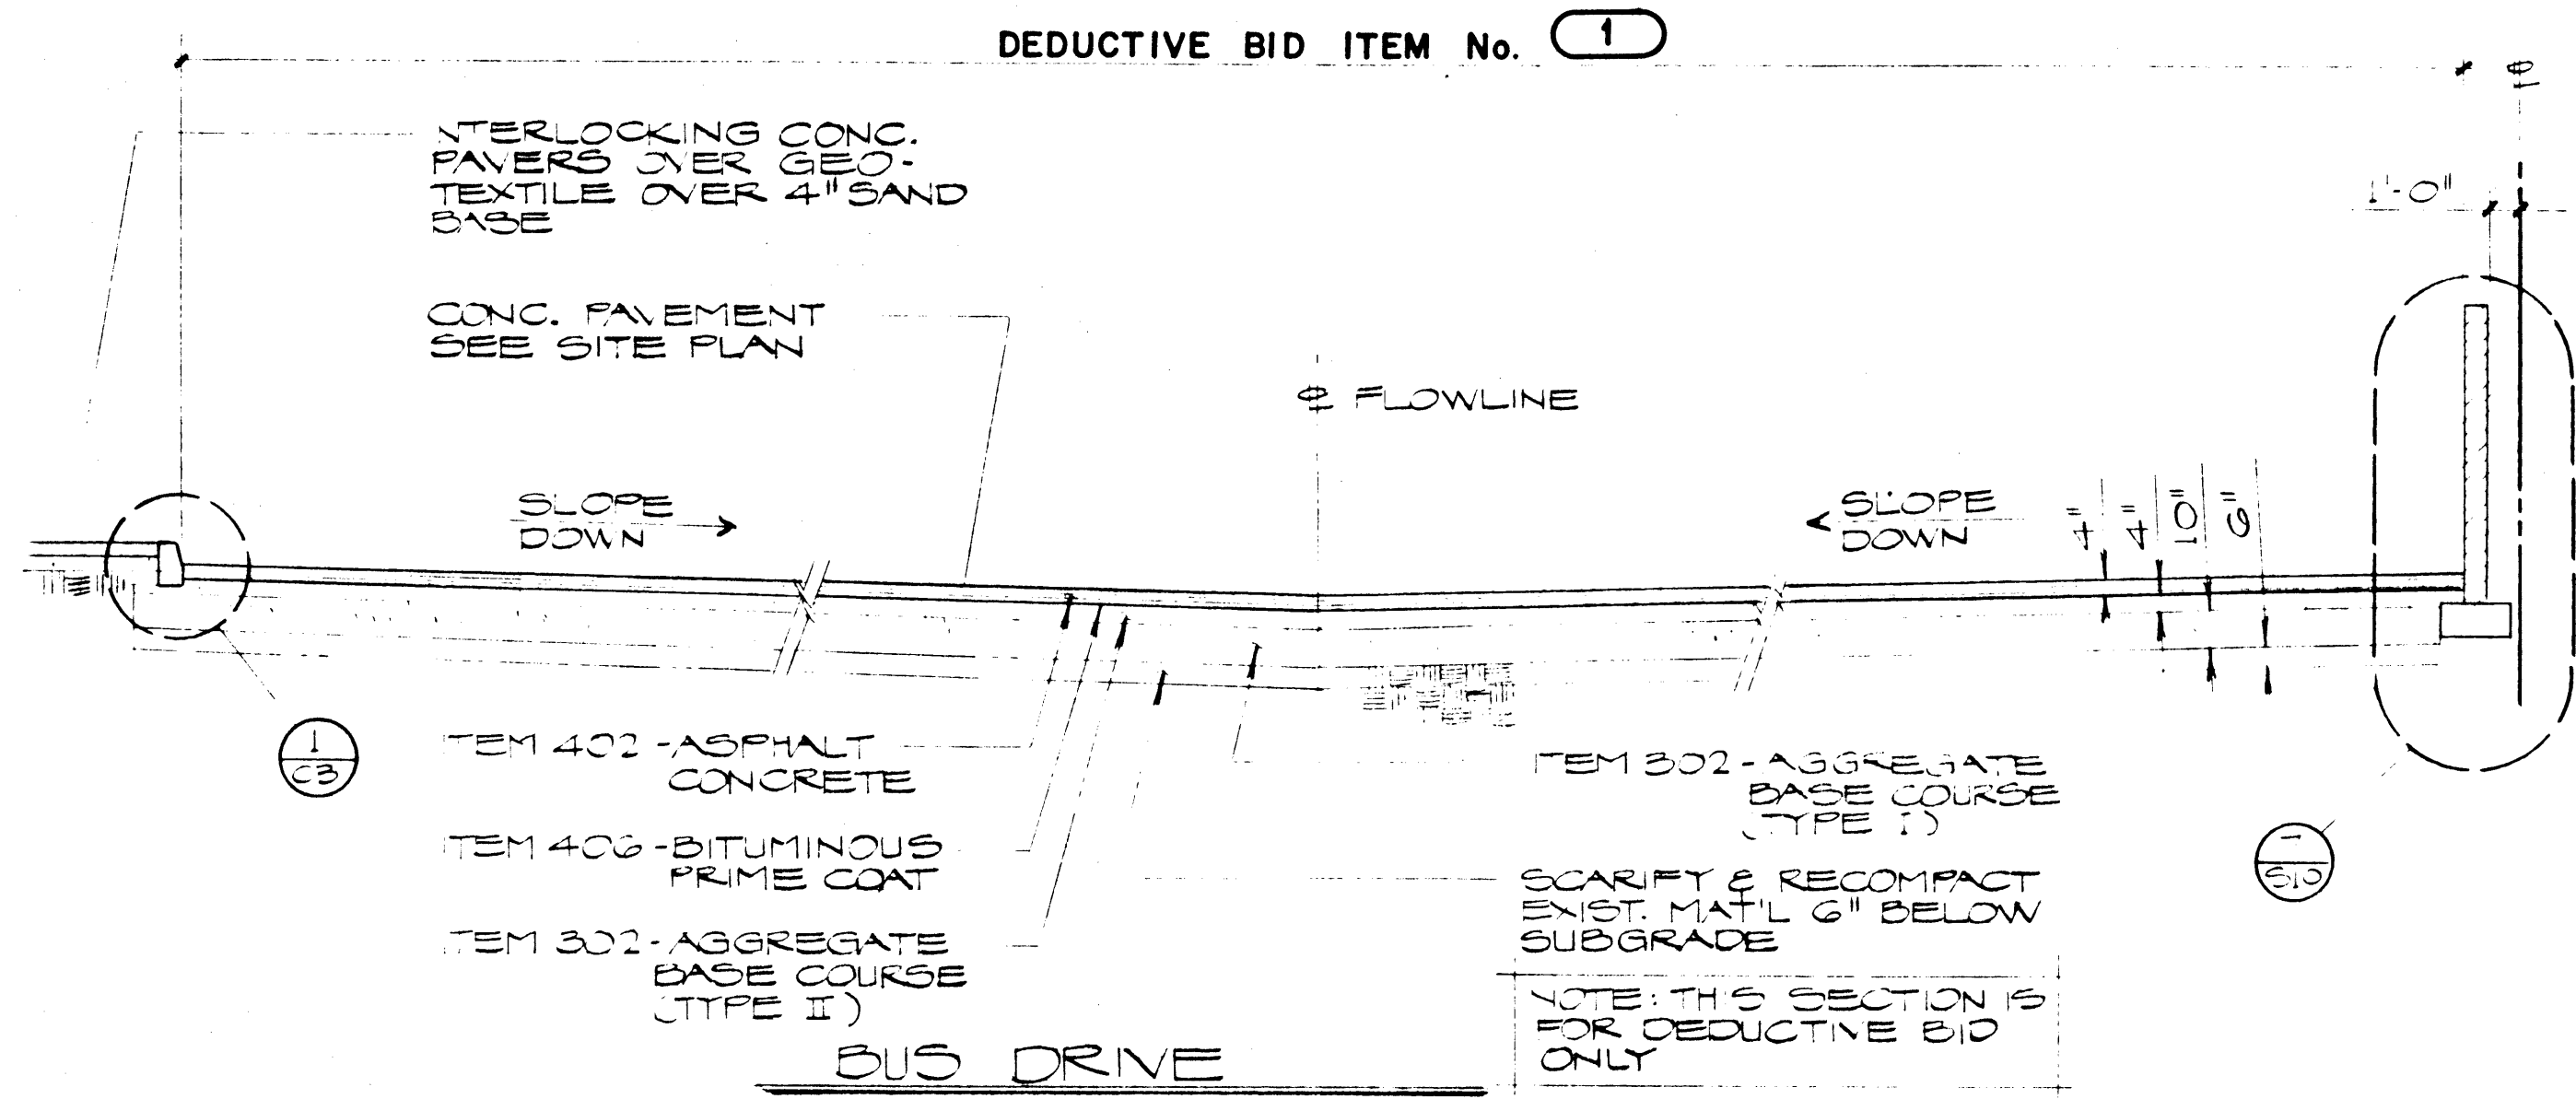


SECTION

1/4" = 1'-0"

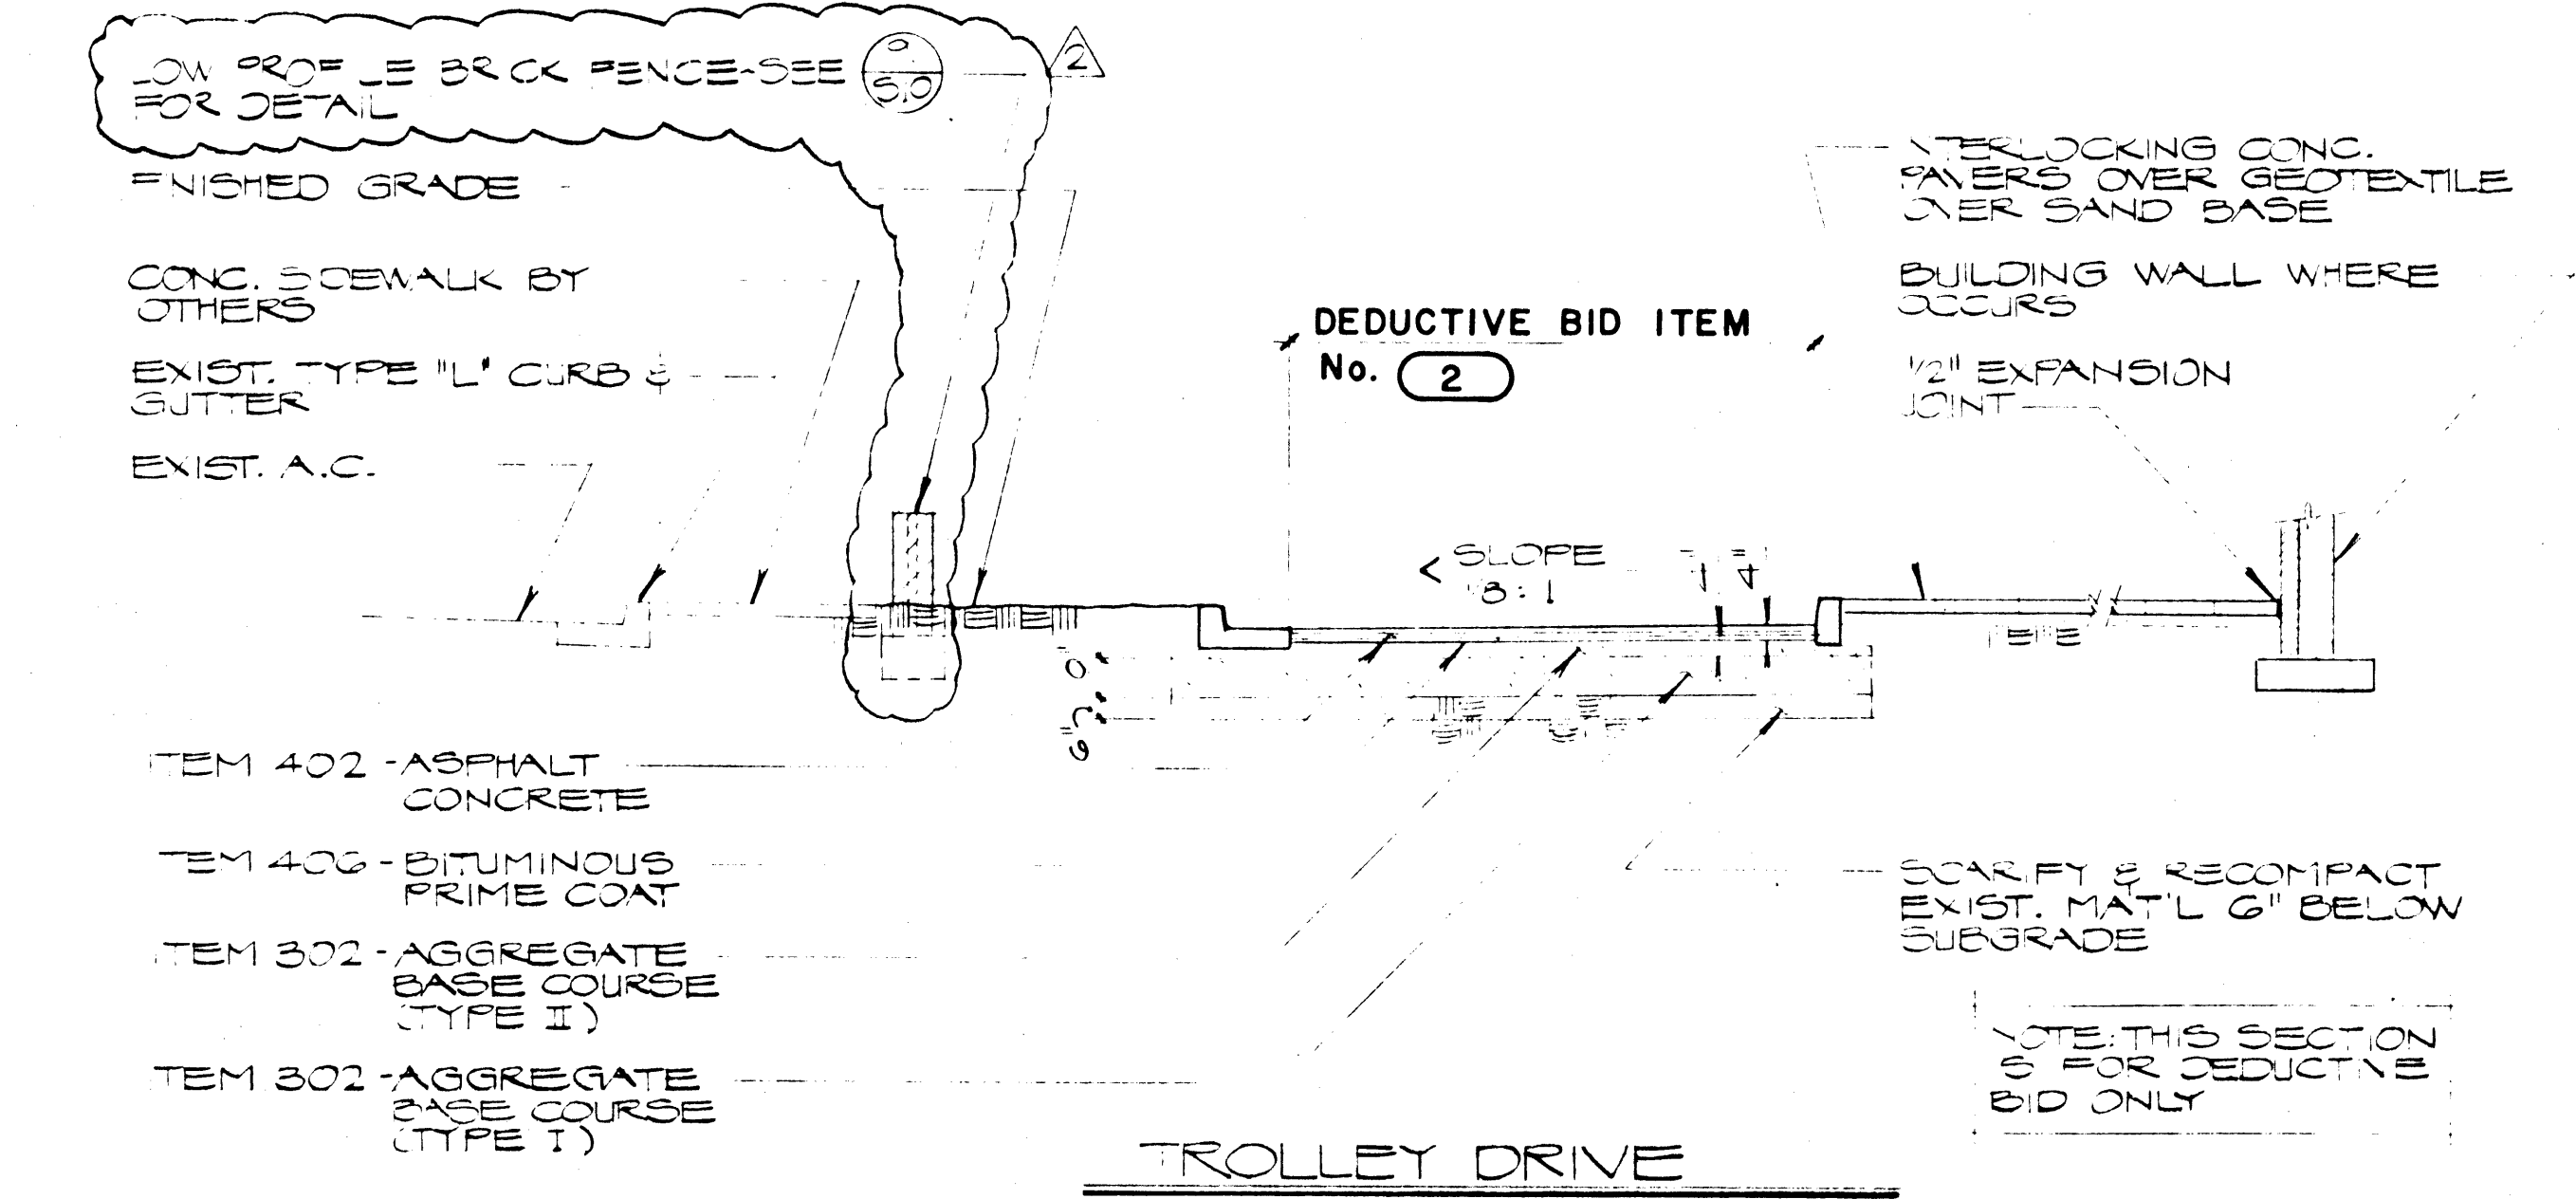


SECTION

1/4" = 1'-0"

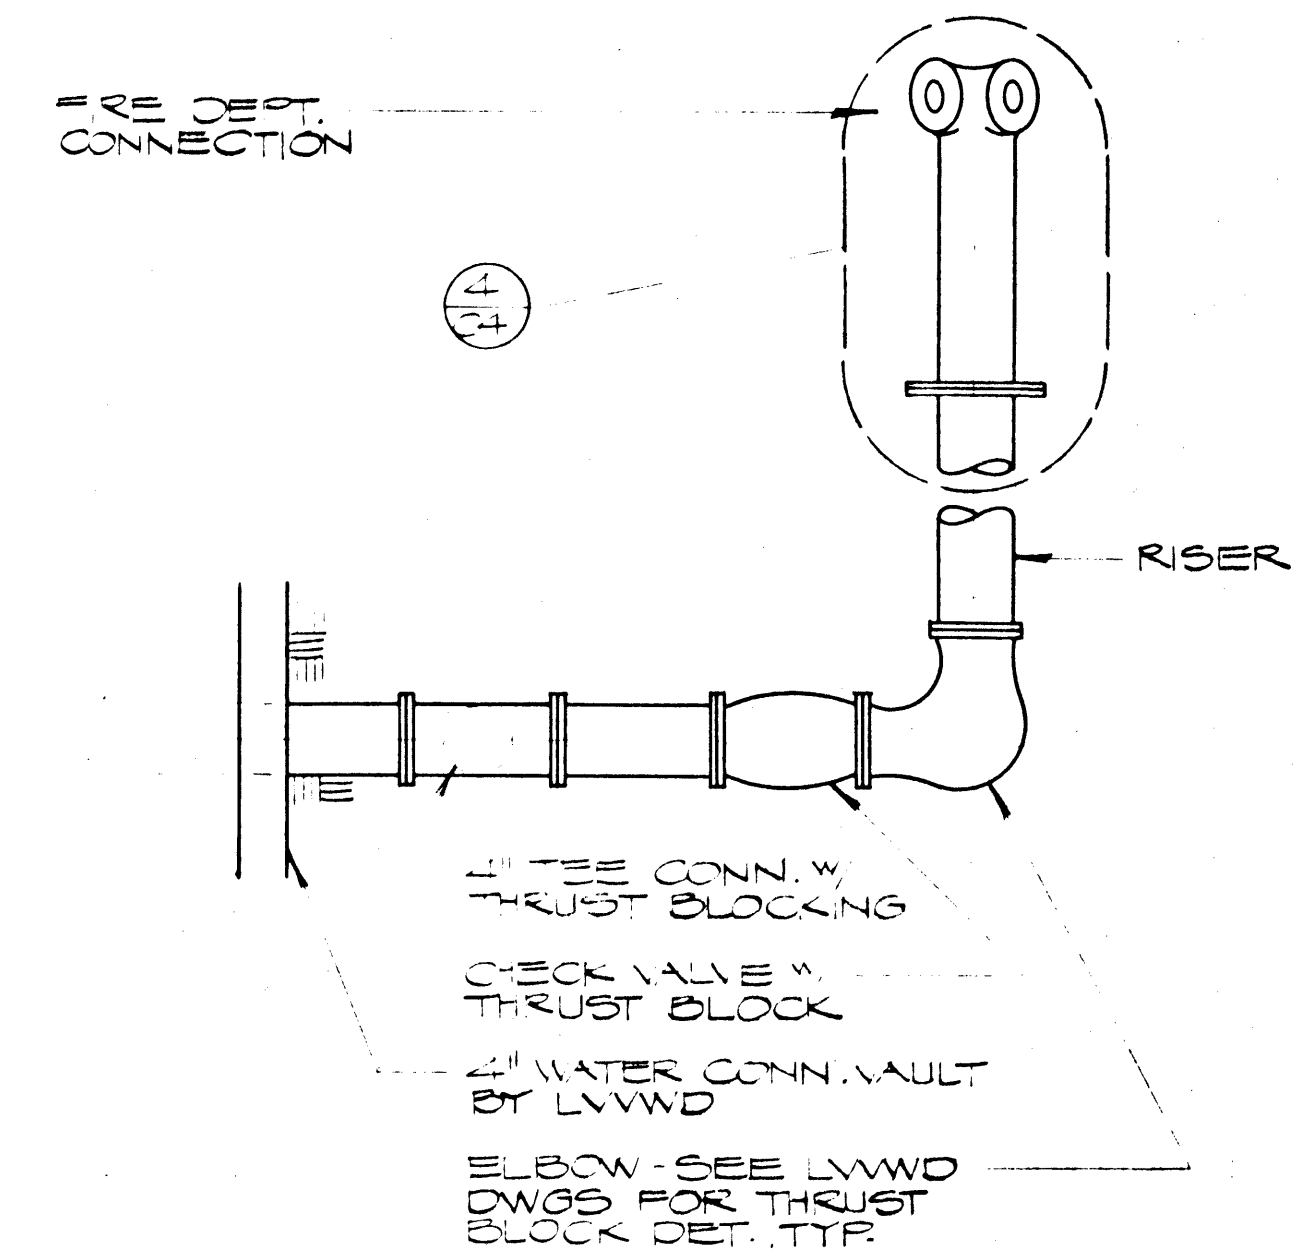


DETAIL

NO SCALE

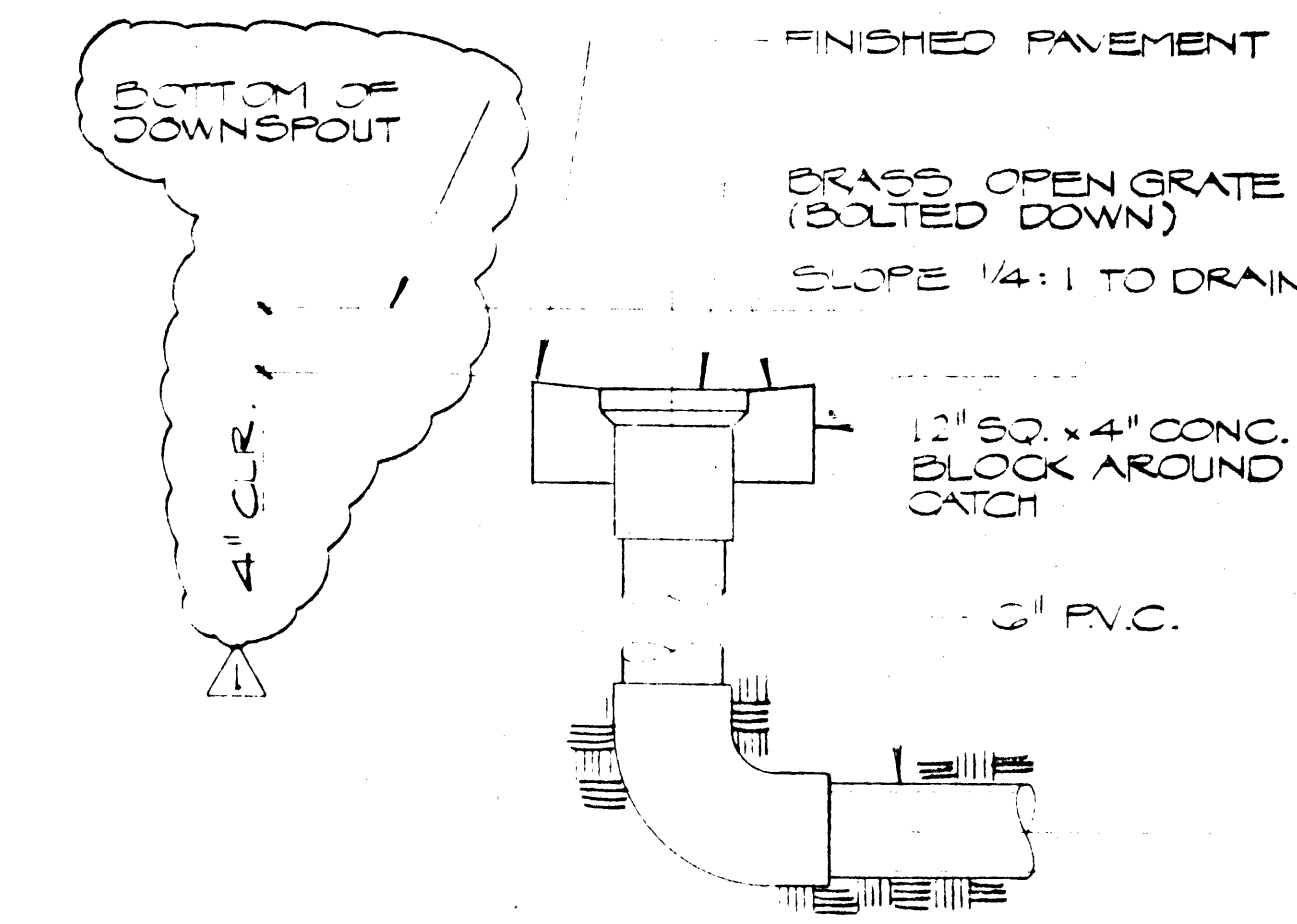

DETAIL

NO SCALE

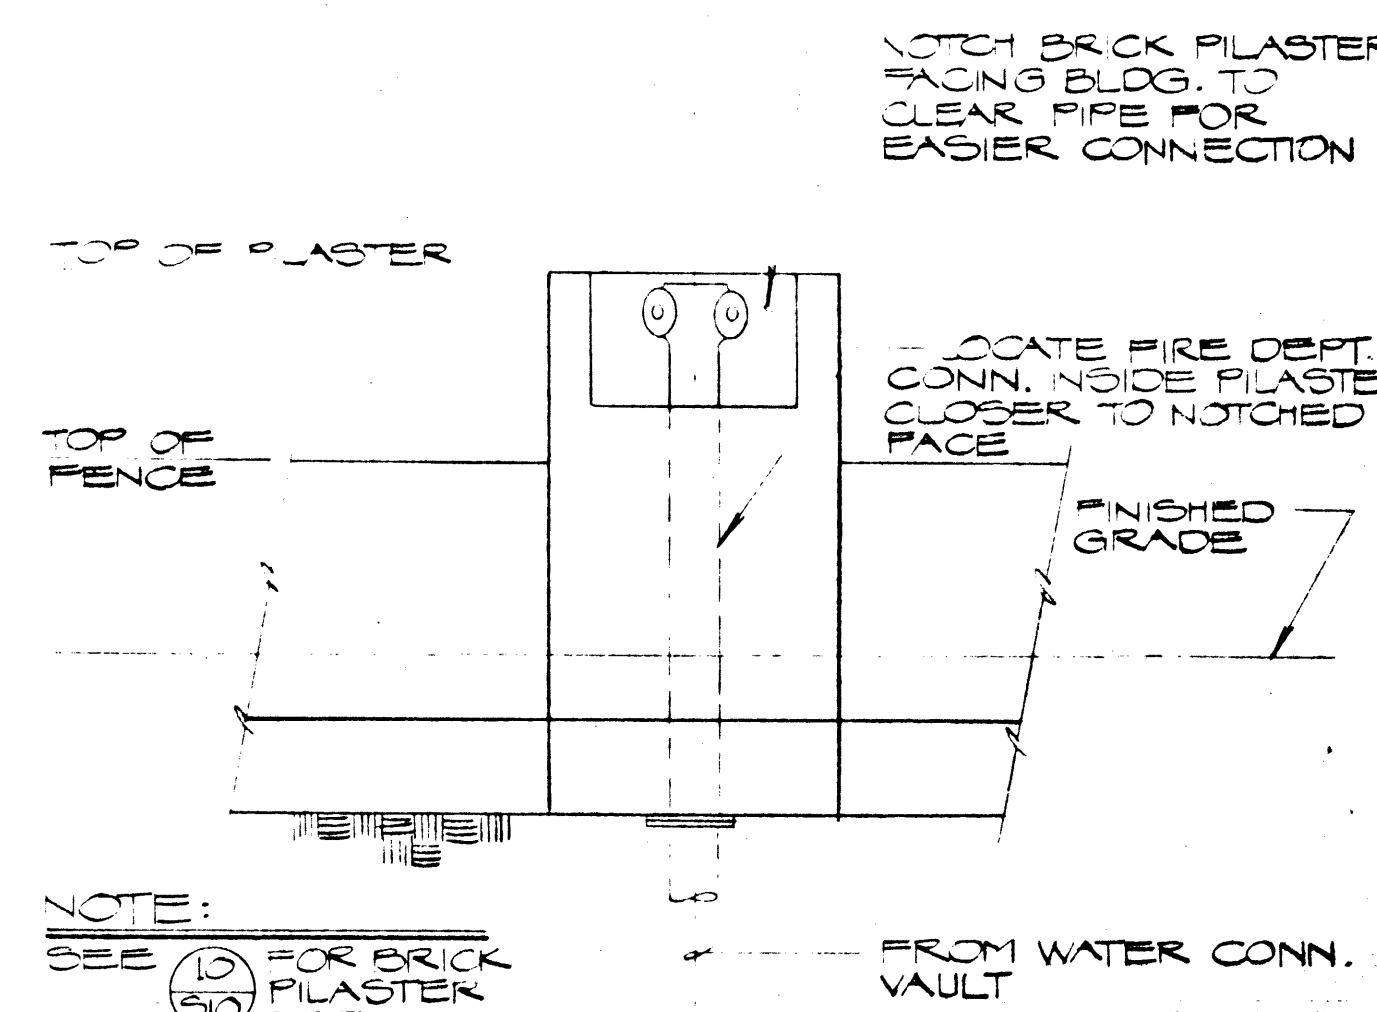

DETAIL

NO SCALE

3-17-86 LOCATE BRICK FENCE & SECTION
11-15-95 ADD DOWNSPOUT CLEARANCE DIMENSION

GUNNY, BRIZENDINE & POGGEMEYER
ENGINEERS
PLANNERS
1111 W. WASHINGTON AVE. SUITE 100
LAS VEGAS, NEVADA 89106
(702) 735-0458

DOBROUSKY KITTRELL GARLOCK
Architects
ala
200 CAMDEN ST. LAS VEGAS, NEVADA 89106
(702) 735-0458

City of Las Vegas
Center
Transportation
Downloaded
Las Vegas, Nevada

SHEET
C-4
OF 6 OF 65
FILE NAME: 590-2J

REPRODUCED BY MICROFILM