


# LEGEND

NO	SIZE	BOTANICAL NAME	COMMON NAME
1	BULB	AGAPANTHUS	
2	"	CANNA	
3	"	CRISPEUS	
4	5GAL	EUONYMUS JAPONICA	EVERGREEN EUONYMUS
5	24"BX	FRAXINUS VELUTINA	ARIZONA ASH
6	BULB	GLADIOLUS	
7	5GAL	HEDERA HELIX	ENGLISH IVY
8	FLAT	"	"
9	1GAL	LANTANA MONTEVIDENSIS	
10	24"BX	LIGUSTRUM TEXANUM (THREE TIERED)	TEXAS PRIVET
11	5GAL	MATONIA AQUIFOLIUM	OREGON GRAPE HOLLY
12	"	M. A. NANA	DWARF OREGON GRAPE HOLLY
13	"	NANDINA DOMESTICA	HEAVENLY BAMBOO
14	"	NERIUM OLEANDER	'PETITE PINK'
15	"	PHOTINIA FRAZERI	FRAZER'S PHOTINIA
16	24"BX	PINUS HALEPENSIS	ALEPPO PINE
17	30"BX	"	"
18	36"BX	"	"
19	30"BX	QUERCUS ILEX	HOLLY OAK
20	24"BX	RUFUS LANCIA	AFRICAN QUINAC
21	1GAL	TRACHELOSPERMIUM JASMINOIDES	STAR JASMINE

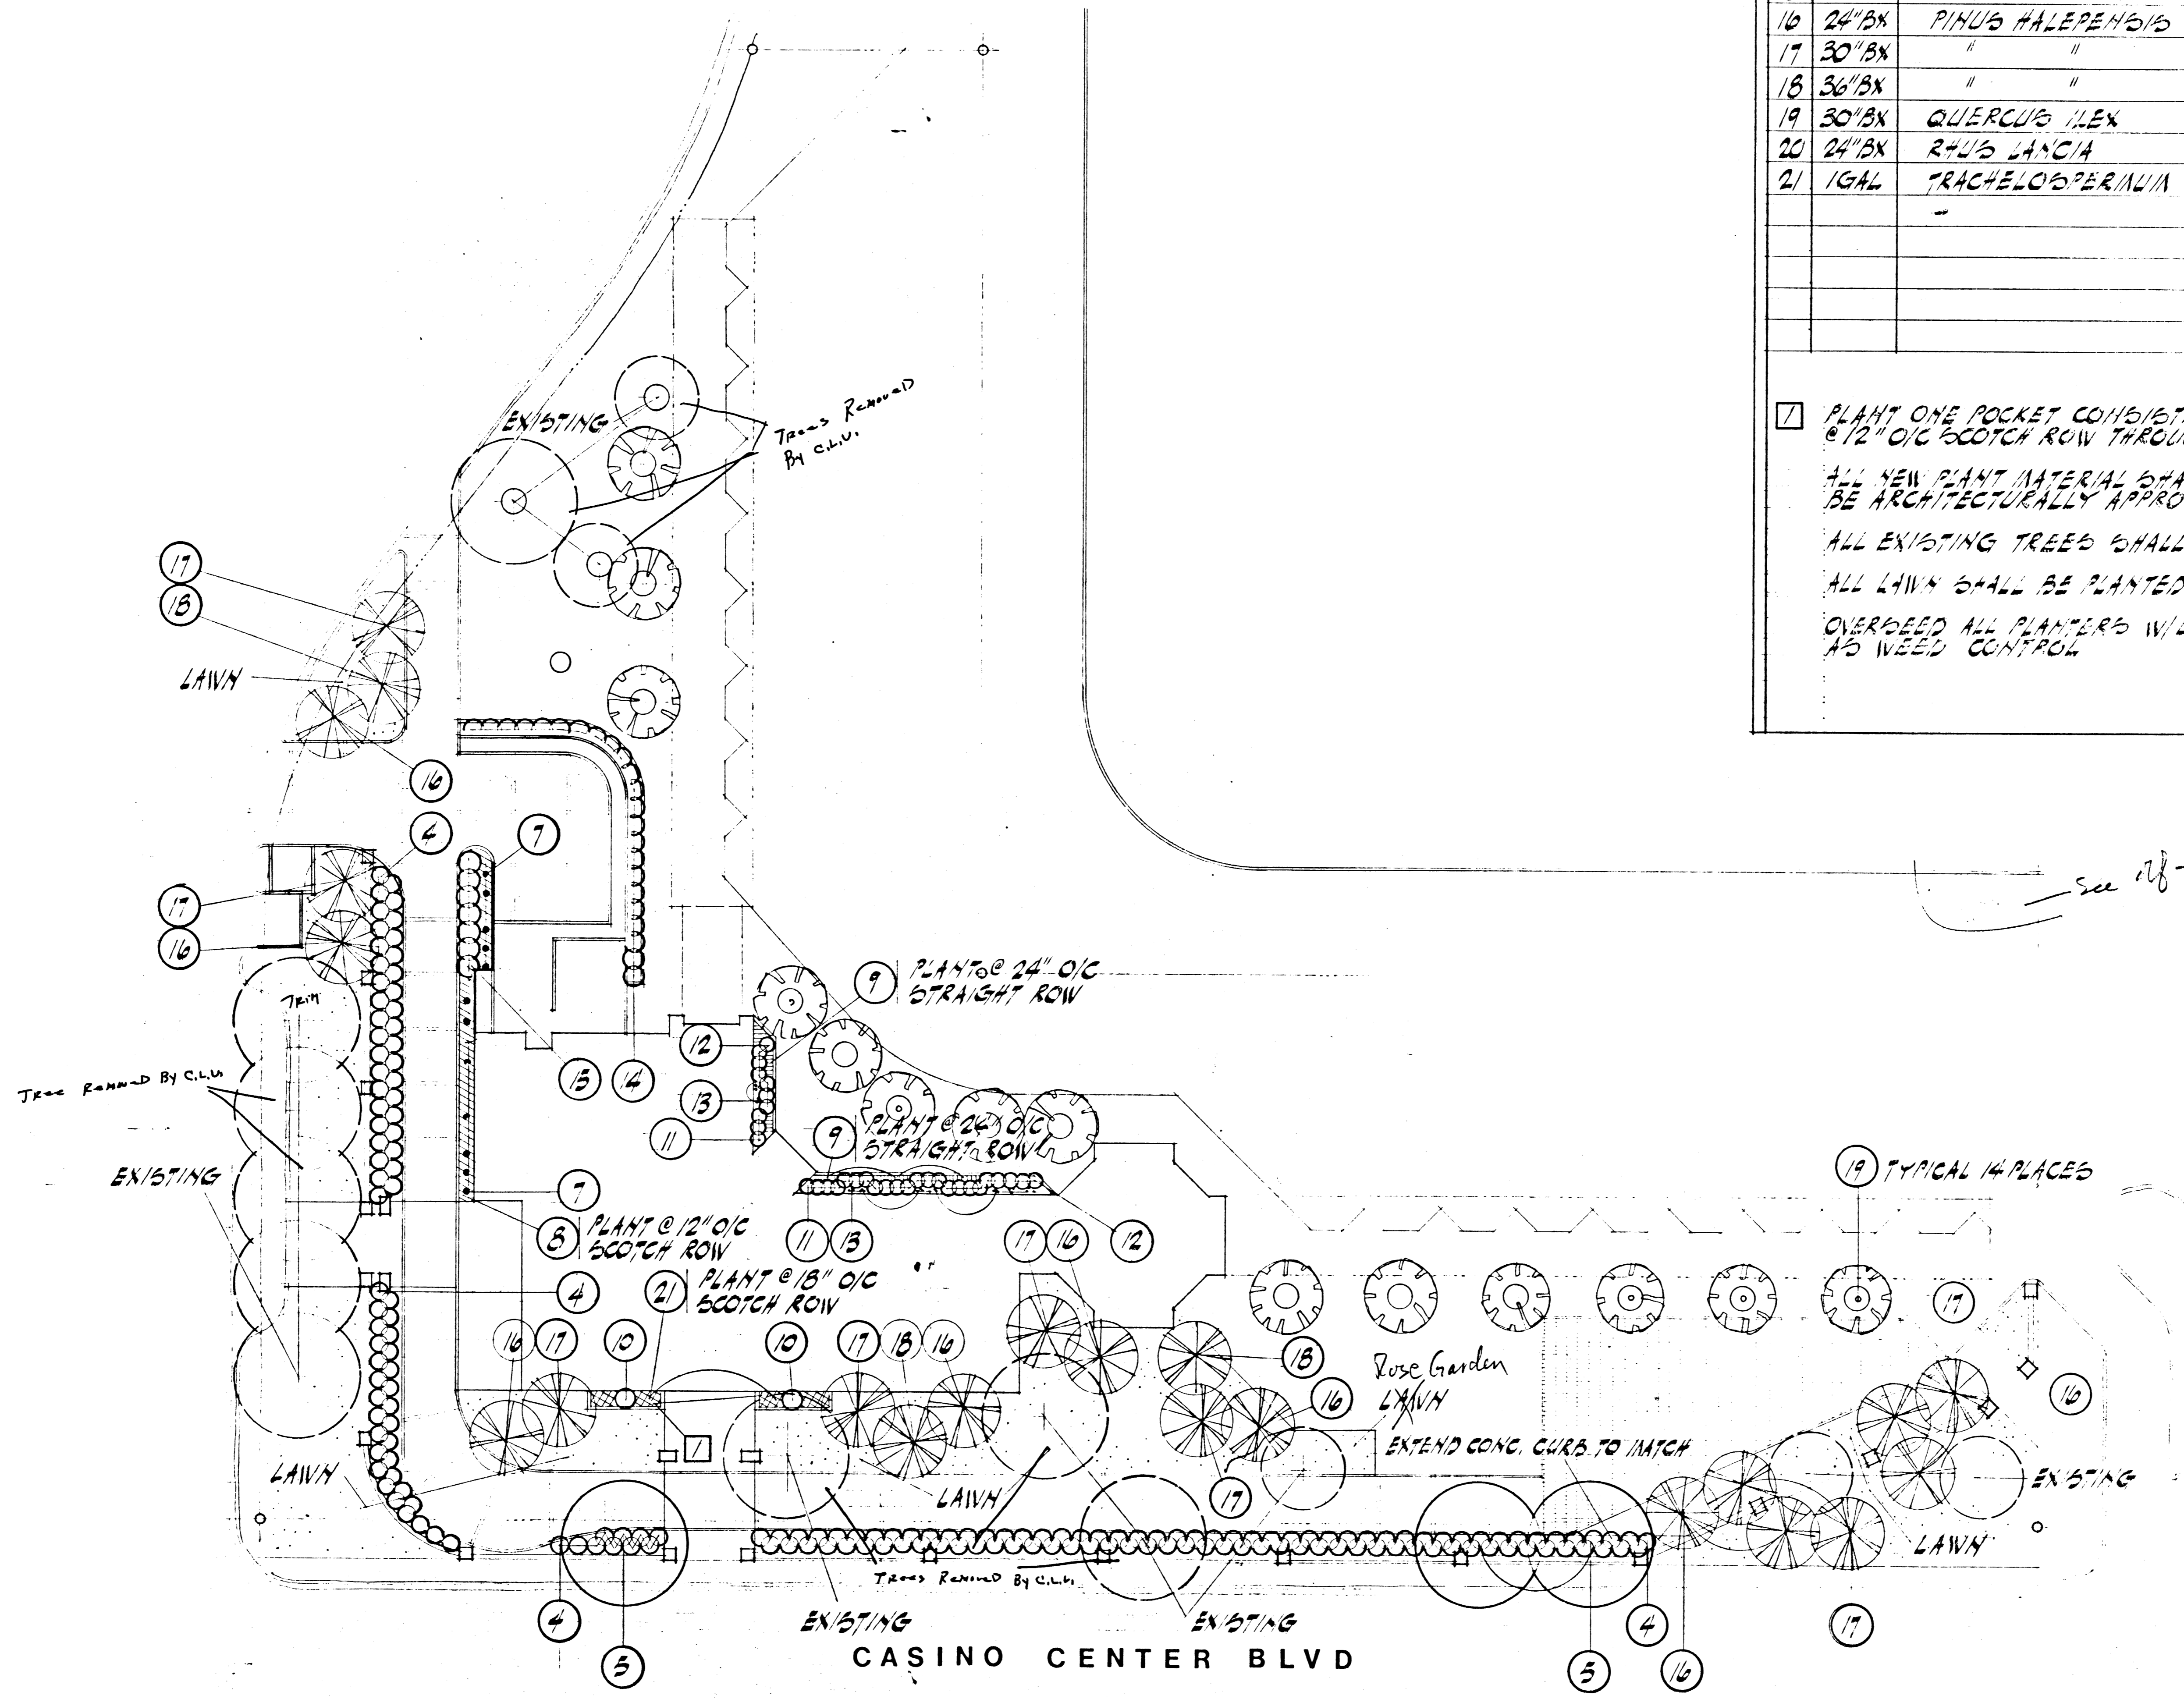

PLANT ONE POCKET CONSISTING OF ONE EACH OF 1 2 3 6 @ 12" O/C SCOTCH ROW THROUGH OUT AREA INDICATED  
 ALL NEW PLANT MATERIAL SHALL BE OF HIGHEST QUALITY & SHALL BE ARCHITECTUALLY APPROVED PRIOR TO PLANTING  
 ALL EXISTING TREES SHALL BE PRUNED AS DIRECTED  
 ALL LAWN SHALL BE PLANTED TO KENTUCKY BLUE FESCUE SOG - SOD Per Gary 12-5-86  
 OVERSEED ALL PLANTERS W/LOBULARIA MARITIMA 'CARPET OF SNOW' AS WEED CONTROL

**LANDSCAPE**  
 SCALE 1" = 20'

STEWART AVE.

DOBRUSKY KITTRELL CARLOCK  
 Architects  
 888 CAMERON ST. LAS VEGAS, NEVADA 89101 (702) 788-0488



Downtown City of Las Vegas Transportation Center  
 Las Vegas, Nevada

SHEET  
**L-1**  
 7/2/85  
 NUMBER  
 110-21