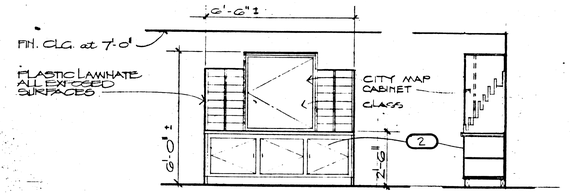

LITERATURE RACK (BY OWNER) 6
SCALE : 3/8" : 1'-0"

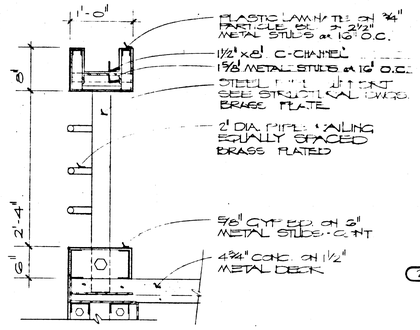

PLANTER DETAIL 7 A-4
SCALE: 1" = 1'-0"

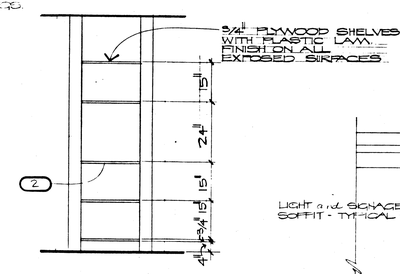

EQUIP. SHELVES 11 A-4

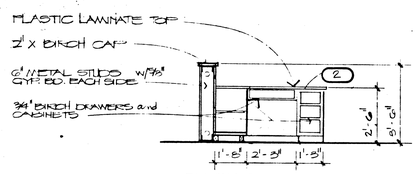

D.T.C. MANAGER 130 5
SCALE : 3/8" : 1'-0"

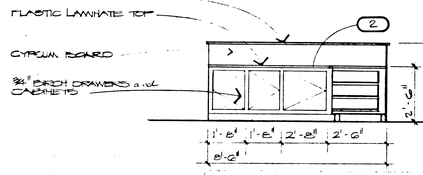

D.T.C.MANAGER 130 4
SCALE : 3/8" : 1'-0"

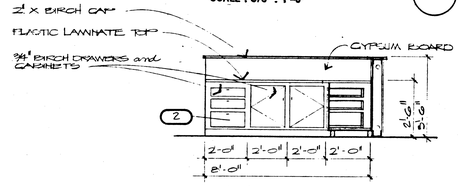

SECURITY 129 3
SCALE : 3/8" : 1'-0"

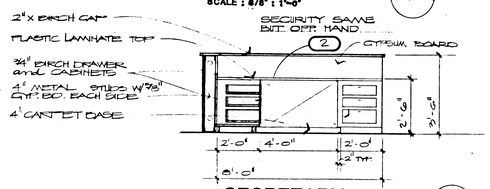

SECRETARY 131 2
SCALE : 3/8" : 1'-0"

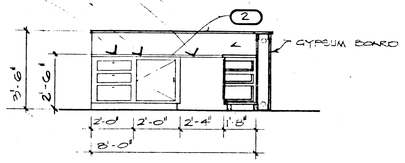

SECRETARY 131 1
SCALE : 3/8" : 1'-0"

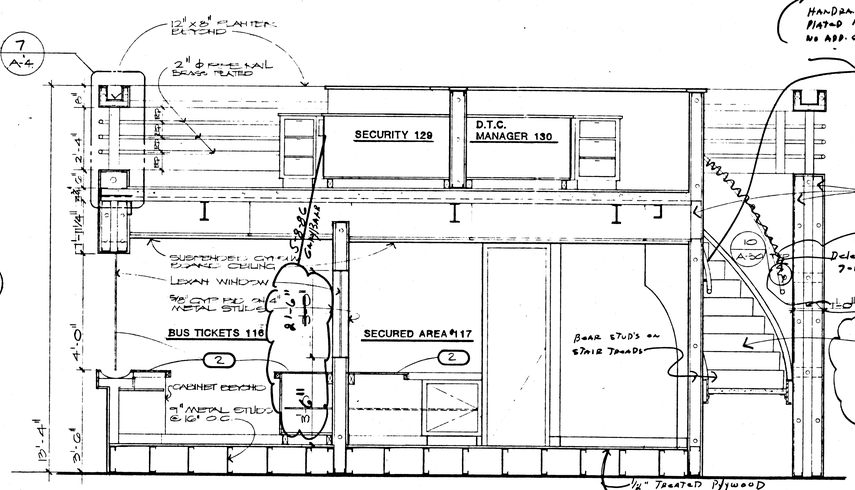

HANDRAIL changed TO BRASS PLATED METAL TO MATCH upper RAIL NO ADD. COST. REVISION 7-14-86 GARY BARR

Delete HANDRAIL THIS SIDE 7-14-86 GARY BARR

STEEL STAIRS WITH CONCRETE FILLED PAN TREADS SEE STRUCTURAL DRAWINGS FOR DETAILS SHEET S-11

SECTION THRU CENTRAL CORE AREA 8 A-4
SCALE 1/2" = 1'-0"

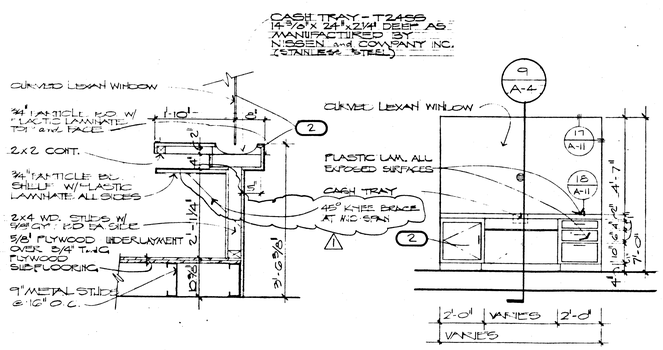

SECTION 9 A-4
SCALE : 3/8" : 1'-0"

ELEVATION SCALE : 3/8" : 1'-0" 10
TYPICAL at BUS and TROLLEY TICKET COUNTERS - FIELD VERIFY DIMENSIONS

(2) DEDUCTIVE BID ITEM #2 (I)

DELETE MILL WORK AS INDICATED, and LEXAN WINDOWS TYPE-Q

FOR DETAIL DESCRIPTION SEE SPECIFICATIONS

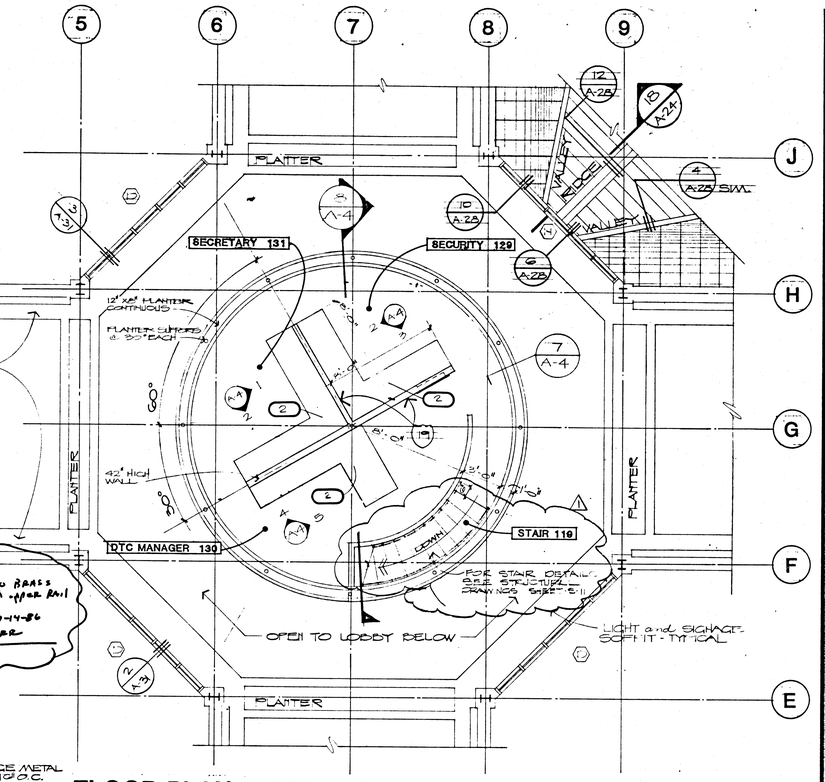

FLOOR PLAN-MEZZANINE LEVEL B
SCALE 1/4" = 1'-0"

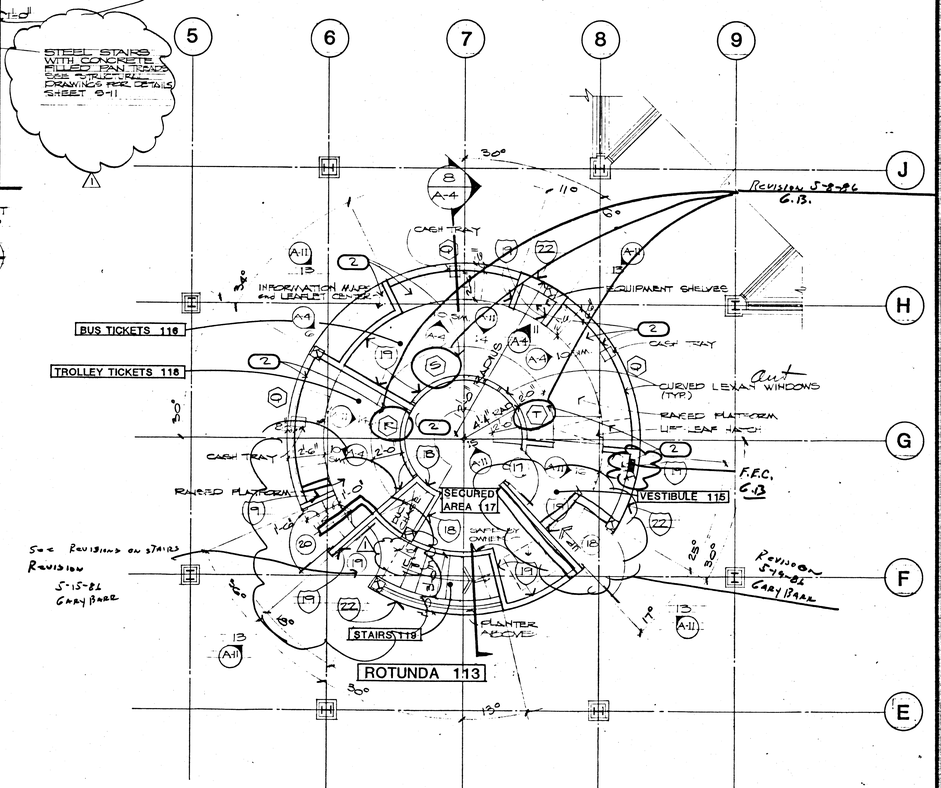

PARTIAL FLOOR PLAN-FIRST LEVEL A
SCALE 1/4" = 1'-0"

△ 11-15-85 - ISSUED FOR ADDENDUM #1

DATE	
10-7-85	DRAWN:
	CHECKED:
	ORDERED:
	JOB NO. 590-23

DOBRUSKY KITTRELL GARLOCK Architects aia
5555 CAMPBELLTON ST. LAS VEGAS, NEVADA 89109 (702) 733-0433

City of Las Vegas Downtown Transportation Center
Las Vegas, Nevada

SHEET A-4
OF 13 OF 65

FILE NUMBER 590-23

© COPYRIGHT 1985 DOBRUSKY KITTRELL GARLOCK ARCHITECTS