



**WEST ELEVATION**

SCALE: 1/8" = 1'-0"

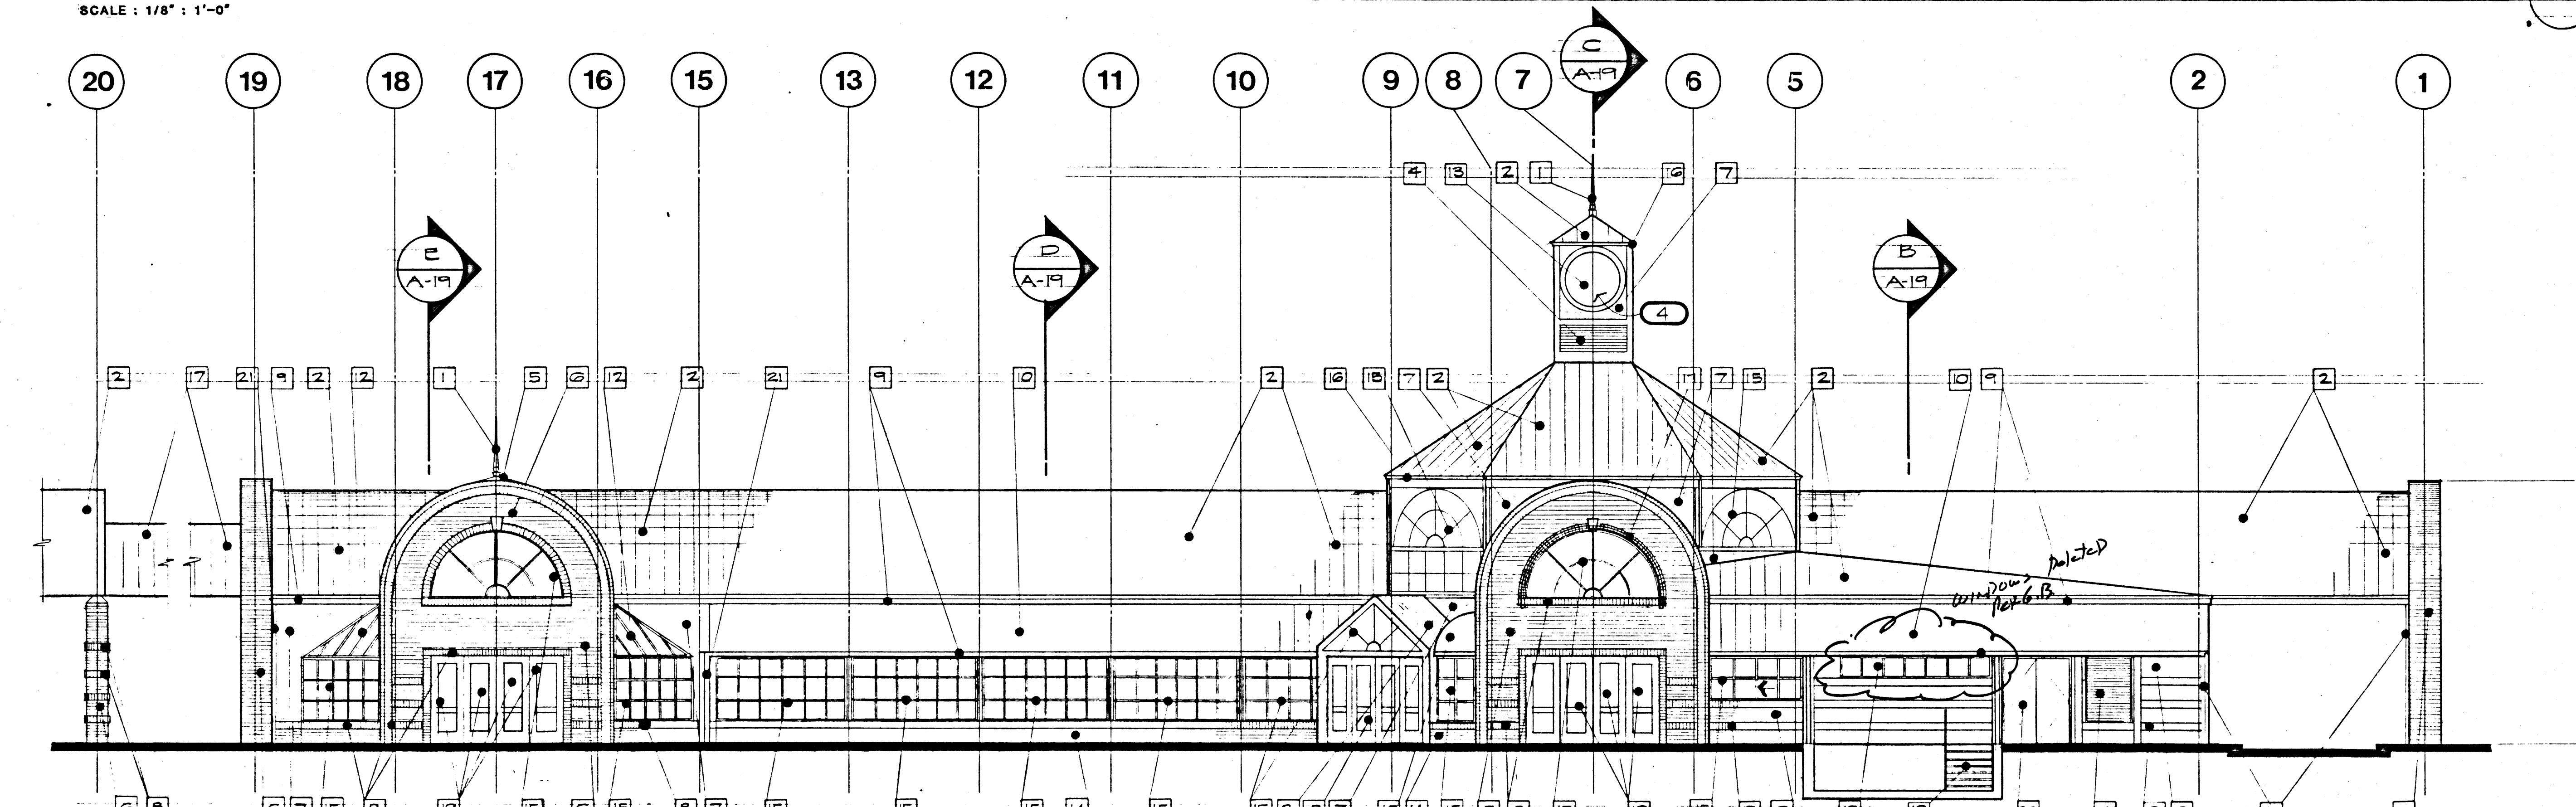


**EAST ELEVATION**

SCALE: 1/8" = 1'-0"

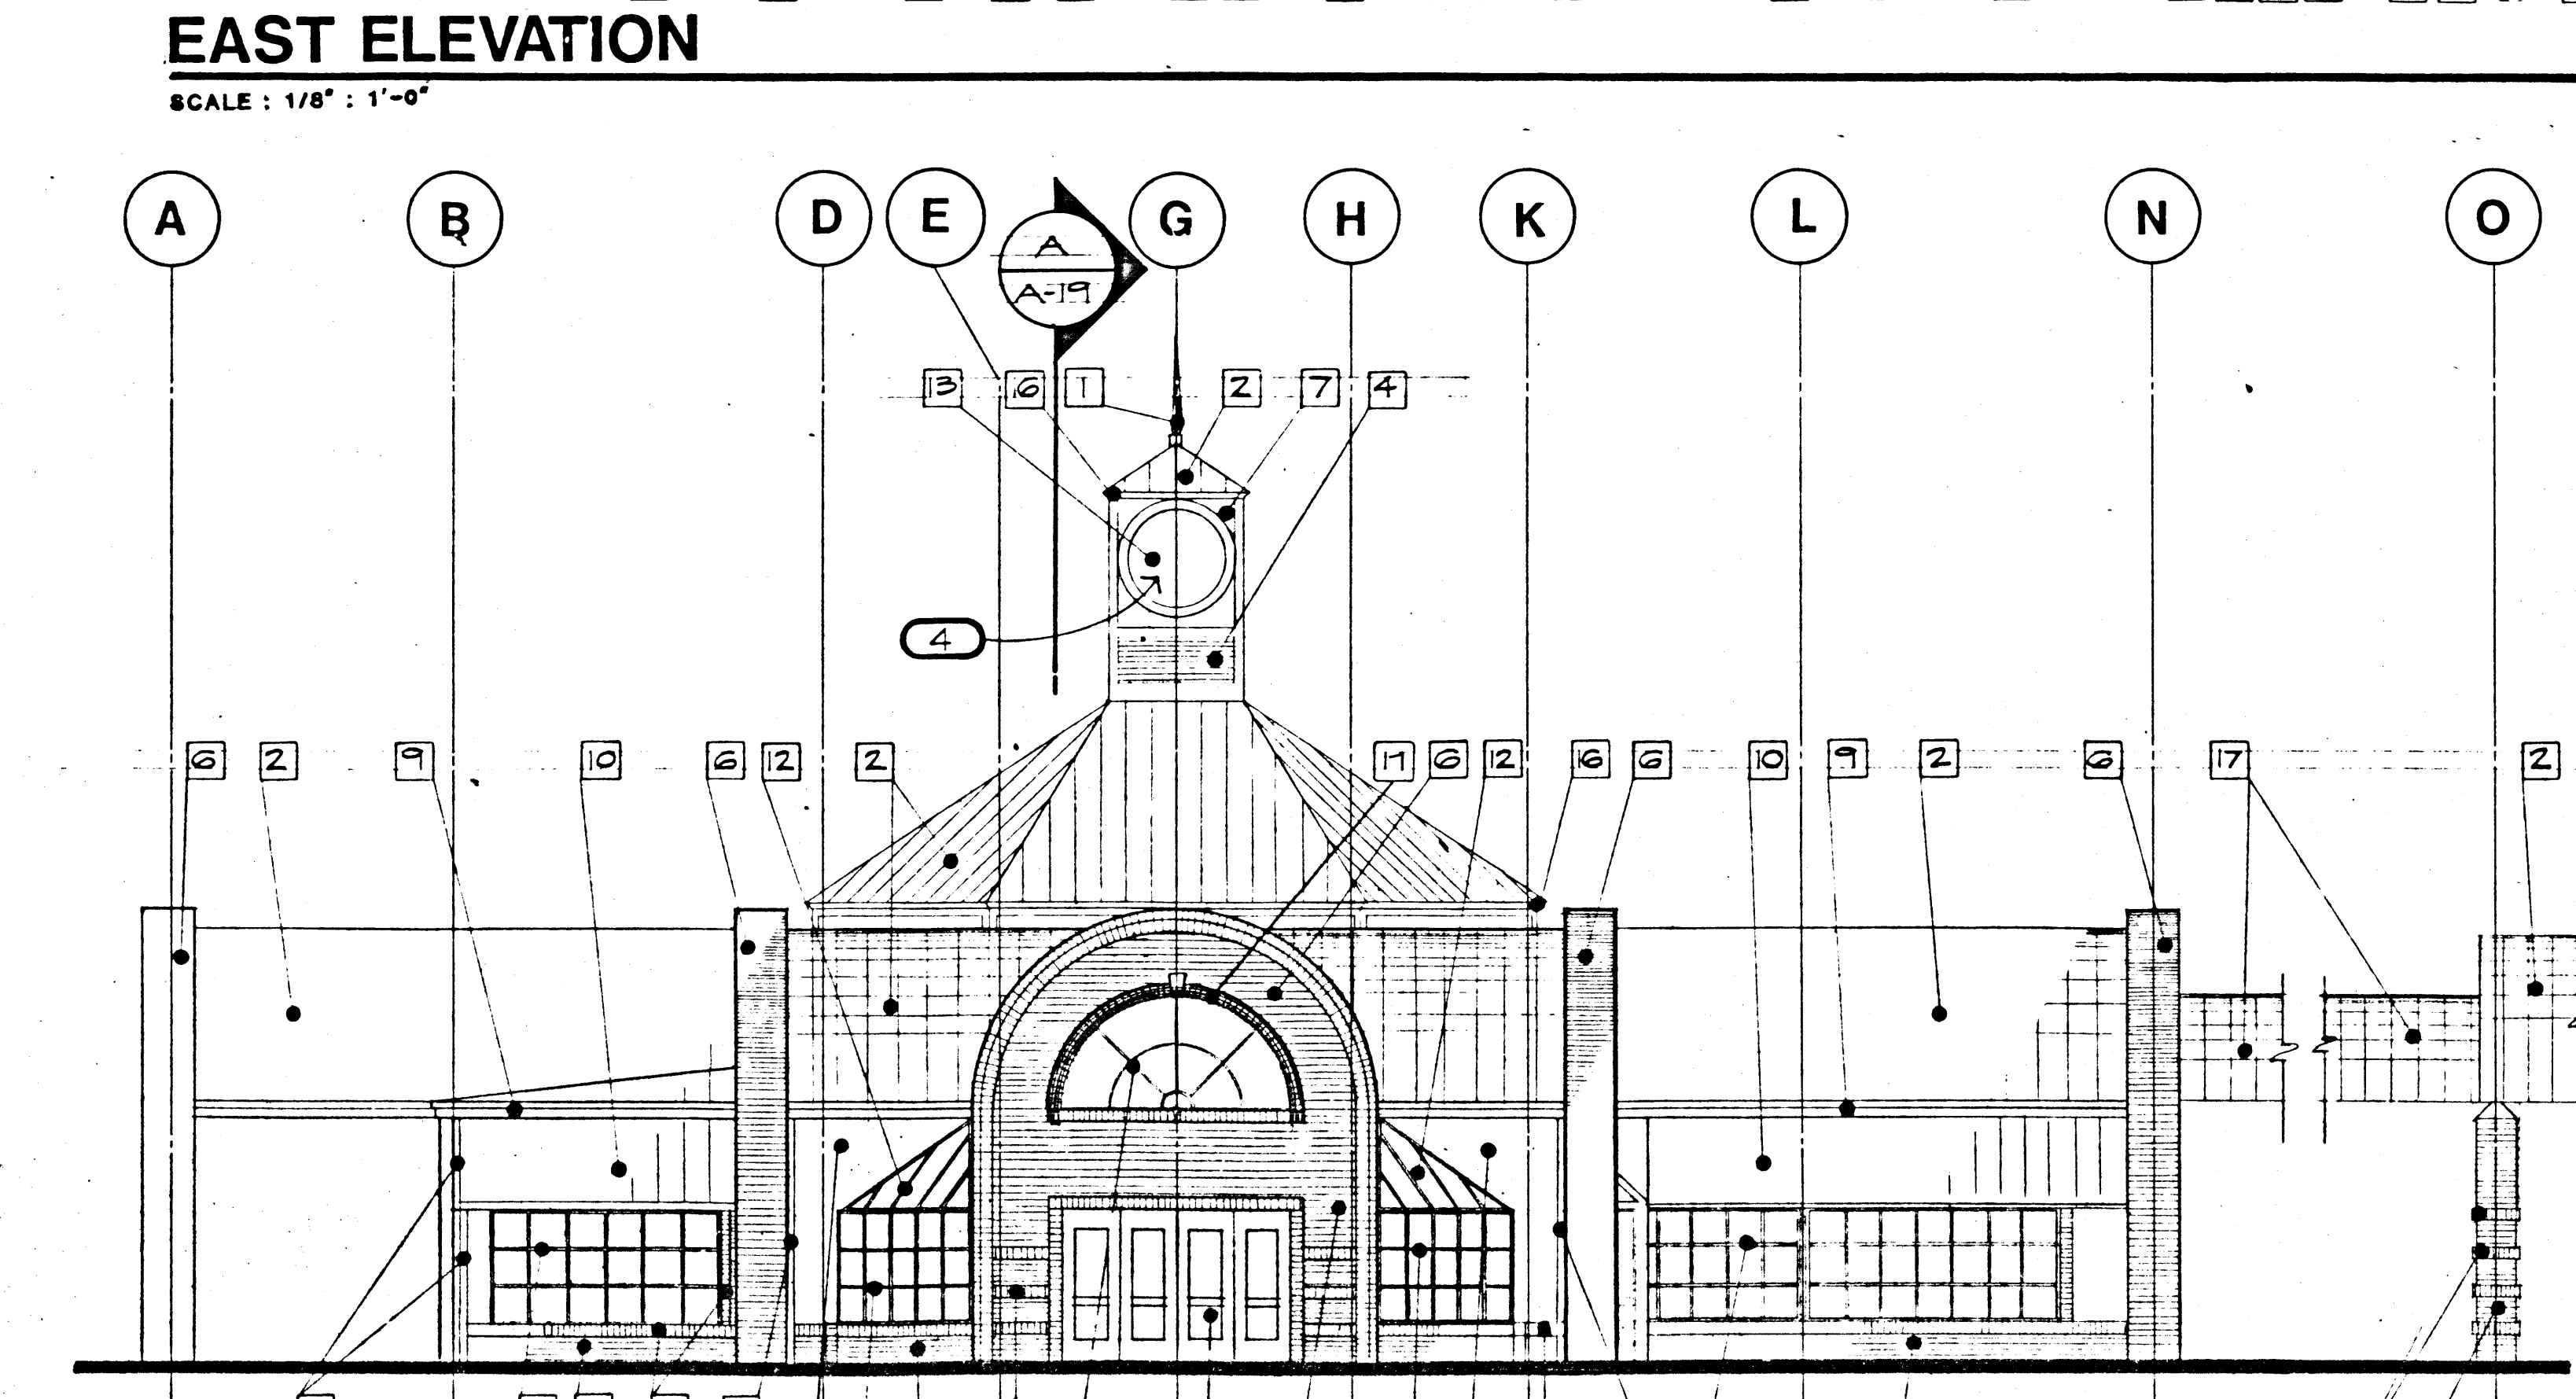

**SOUTH ELEVATION**

SCALE: 1/8" = 1'-0"

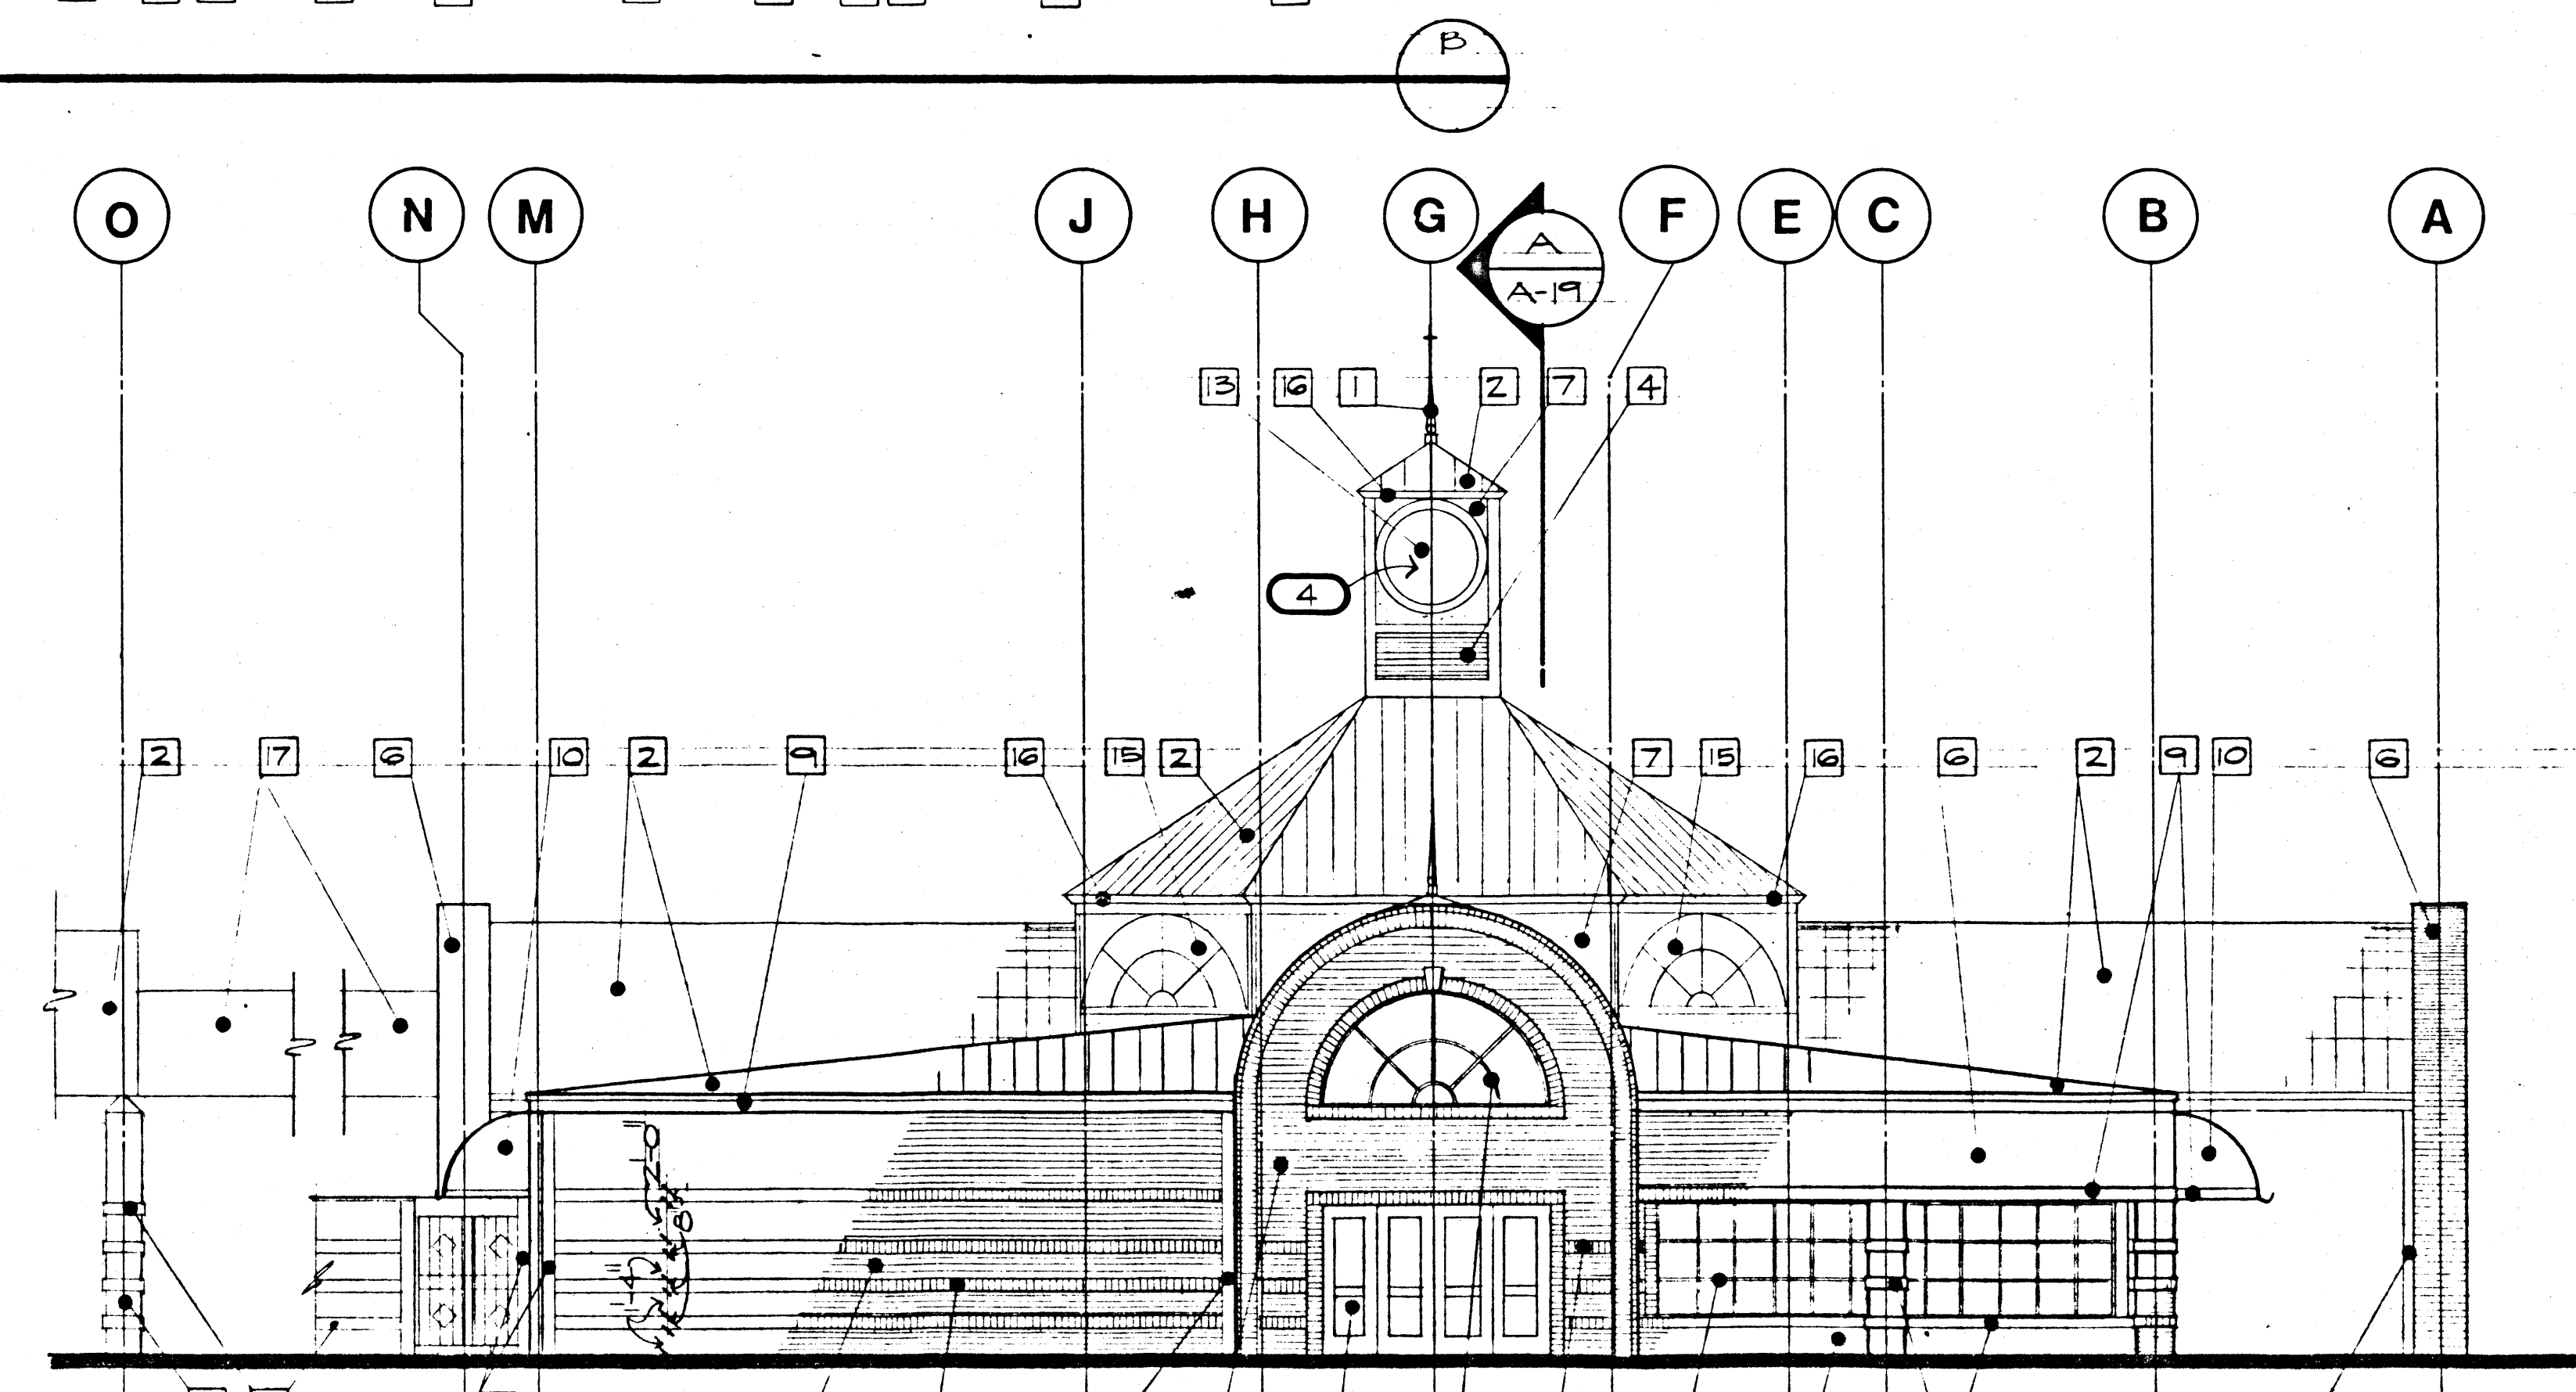

**NORTH ELEVATION**

SCALE: 1/8" = 1'-0"

**EXTERIOR FINISH LEGEND**

- 1 METAL PANEL
- 2 STANDING SEAM METAL ROOF
- 3 PREFINISHED METAL FRAME
- 4 PREFINISHED METAL VENT
- 5 SKYLIGHT
- 6 BRICK VENEER
- 7 STUCCO
- 8 BRICK SOLDIER COURSE
- 9 PREFINISHED SHEET METAL GUTTER
- 10 METAL AWNING
- 11 METAL INTAKE LOUVER
- 12 GLAZED ROOF
- 13 CLOCK (4)
- 14 BRICK PLANTER
- 15 PREFINISHED METAL WINDOWS
- 16 SHEET METAL CORNICE
- 17 TRANSLUCENT ACRYLIC ROOF
- 18 STEEL STAIR
- 19 METAL FRAME WITH GLASS DOORS
- 20 METAL DOOR
- 21 DOWN SPOUTS

**(4) DEDUCTIVE BID ITEM #4 (I)**

DELETE THE FOUR (4) CLOCKS SHOWN ON THE DRAWINGS AND ADD METAL FRAMING AND STUCCO REQUIRED TO FILL VOID FOR DETAILED DESCRIPTION SEE SPECIFICATIONS.

*clocks approved per RFP #A-3-14-86 & RFP #30-4-11-86*

DATE: \_\_\_\_\_  
 DRAWN BY: \_\_\_\_\_  
 CHECKED BY: \_\_\_\_\_  
 FILE NO.: \_\_\_\_\_  
 SHEET NO.: \_\_\_\_\_

**DOBROUSKY KITTRELL GARLOCK**  
 Architects  
 818  
 3833 CARLETON ST. LAS VEGAS, NEVADA 89103  
 (702) 765-0488

City of Las Vegas  
 Downtown Transportation  
 Center  
 Las Vegas, Nevada

SHEET  
**A-18**  
 27/065  
 FILE NUMBER  
 570-21