




WALL SECTION
SCALE: 3/4" = 1'-0"
5
A-21

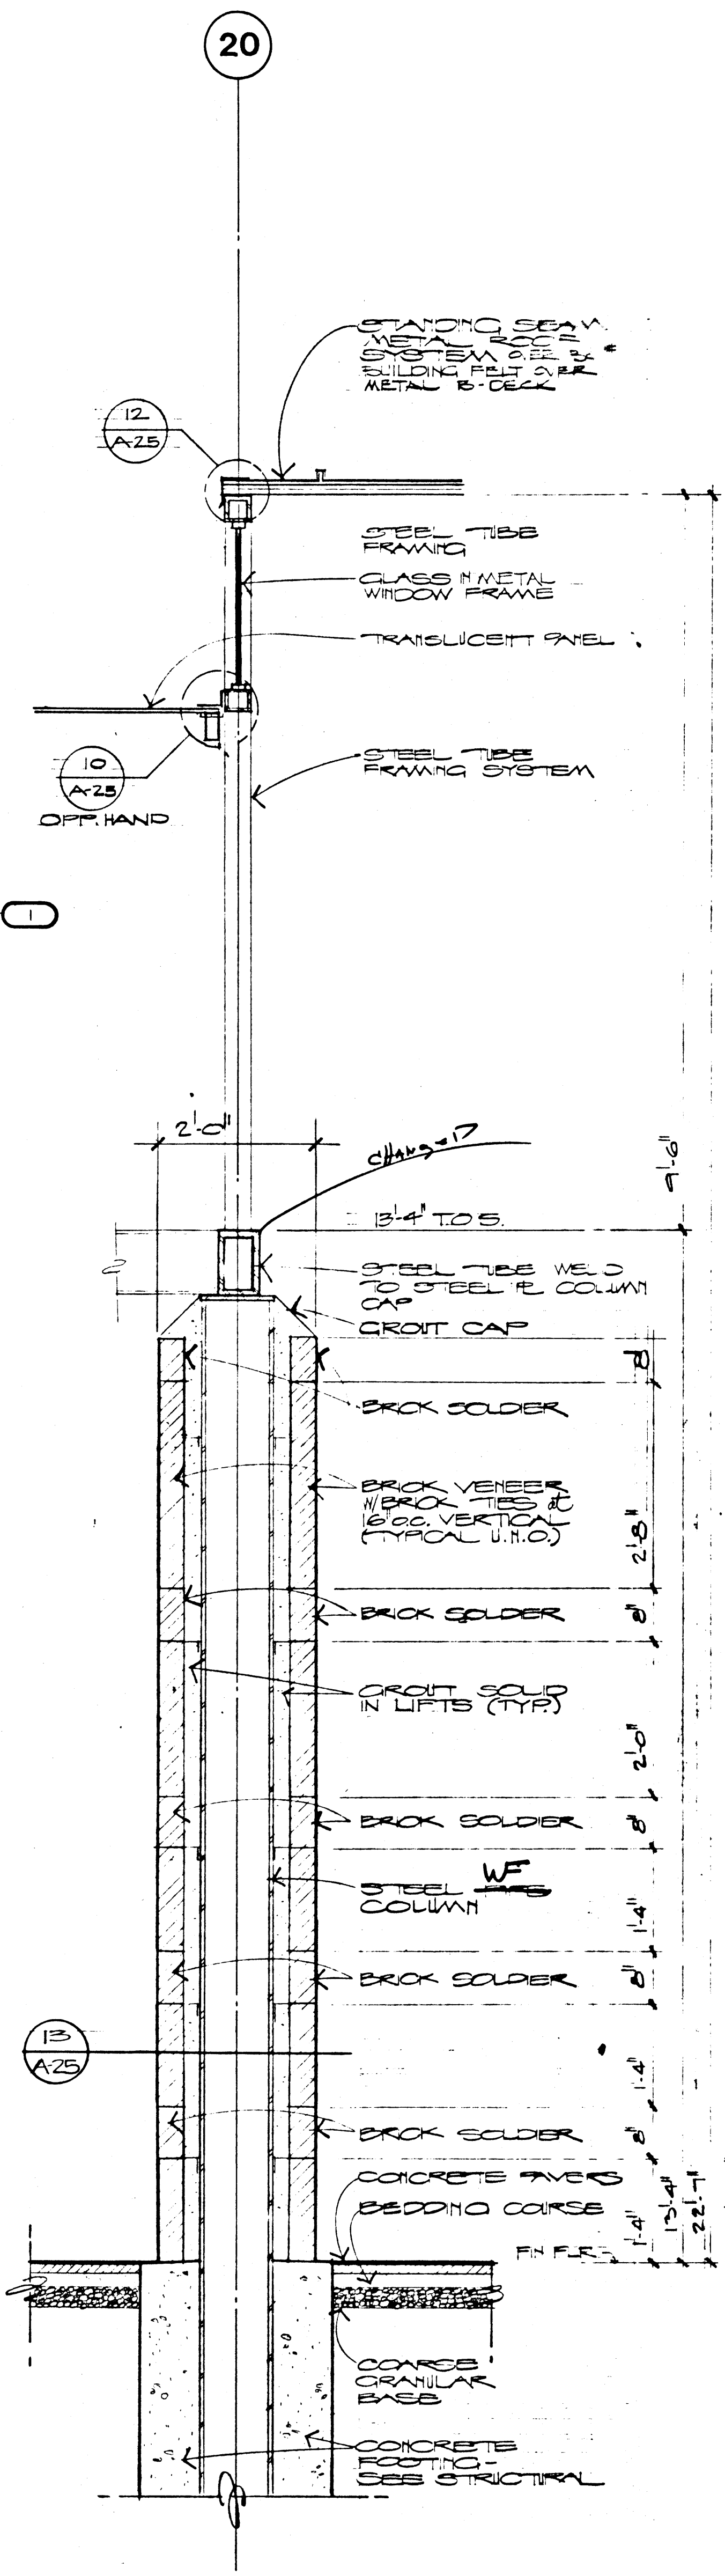

WALL SECTION
SCALE: 3/4" = 1'-0"
6
A-21

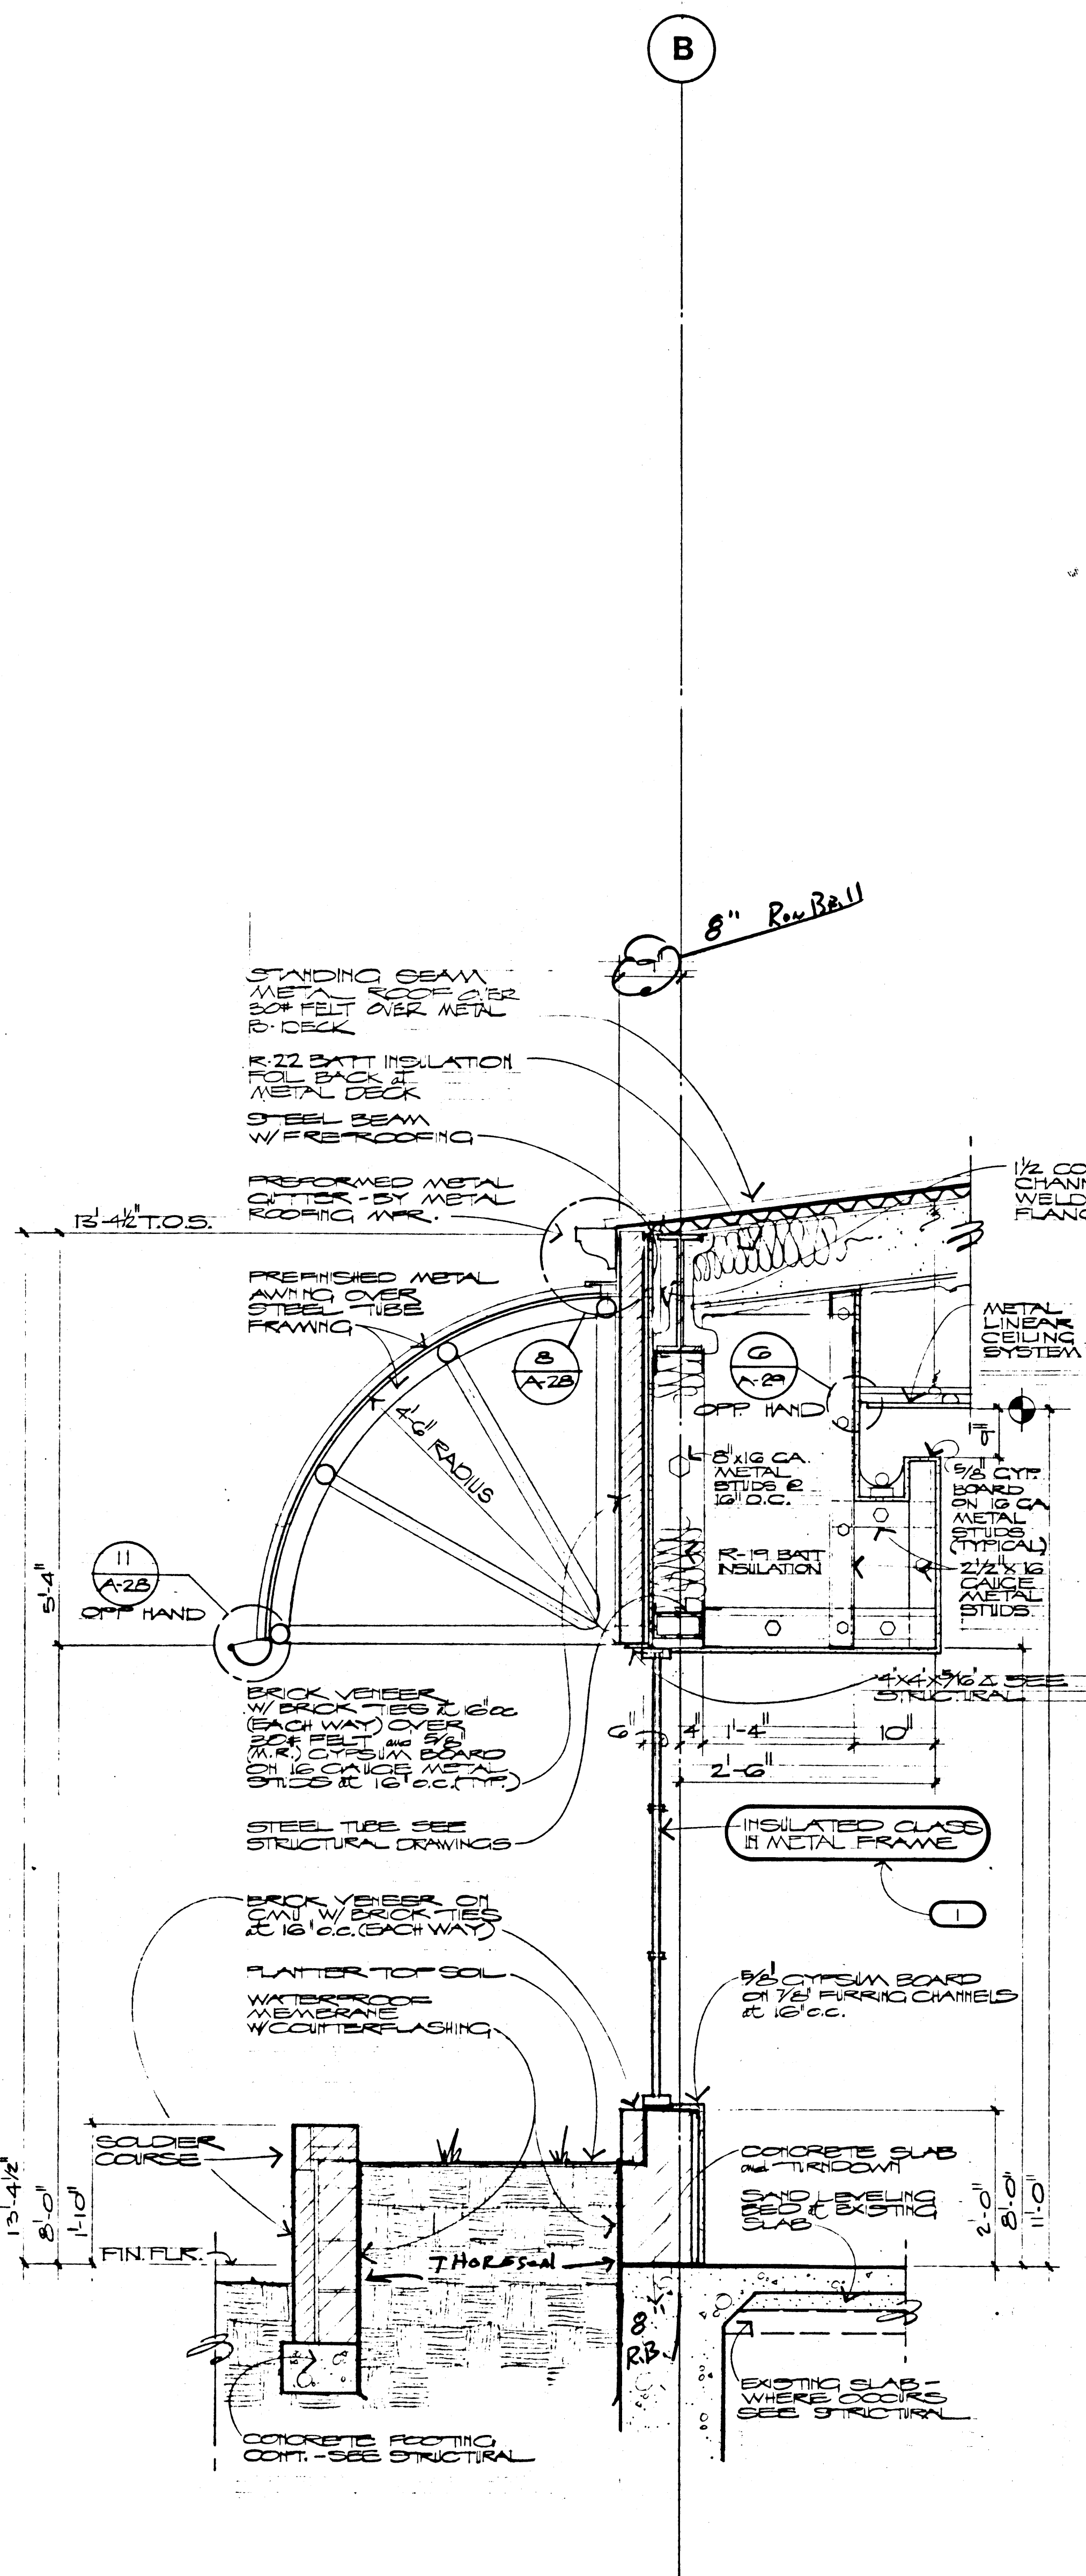

WALL SECTION
SCALE: 3/4" = 1'-0"
7
A-21

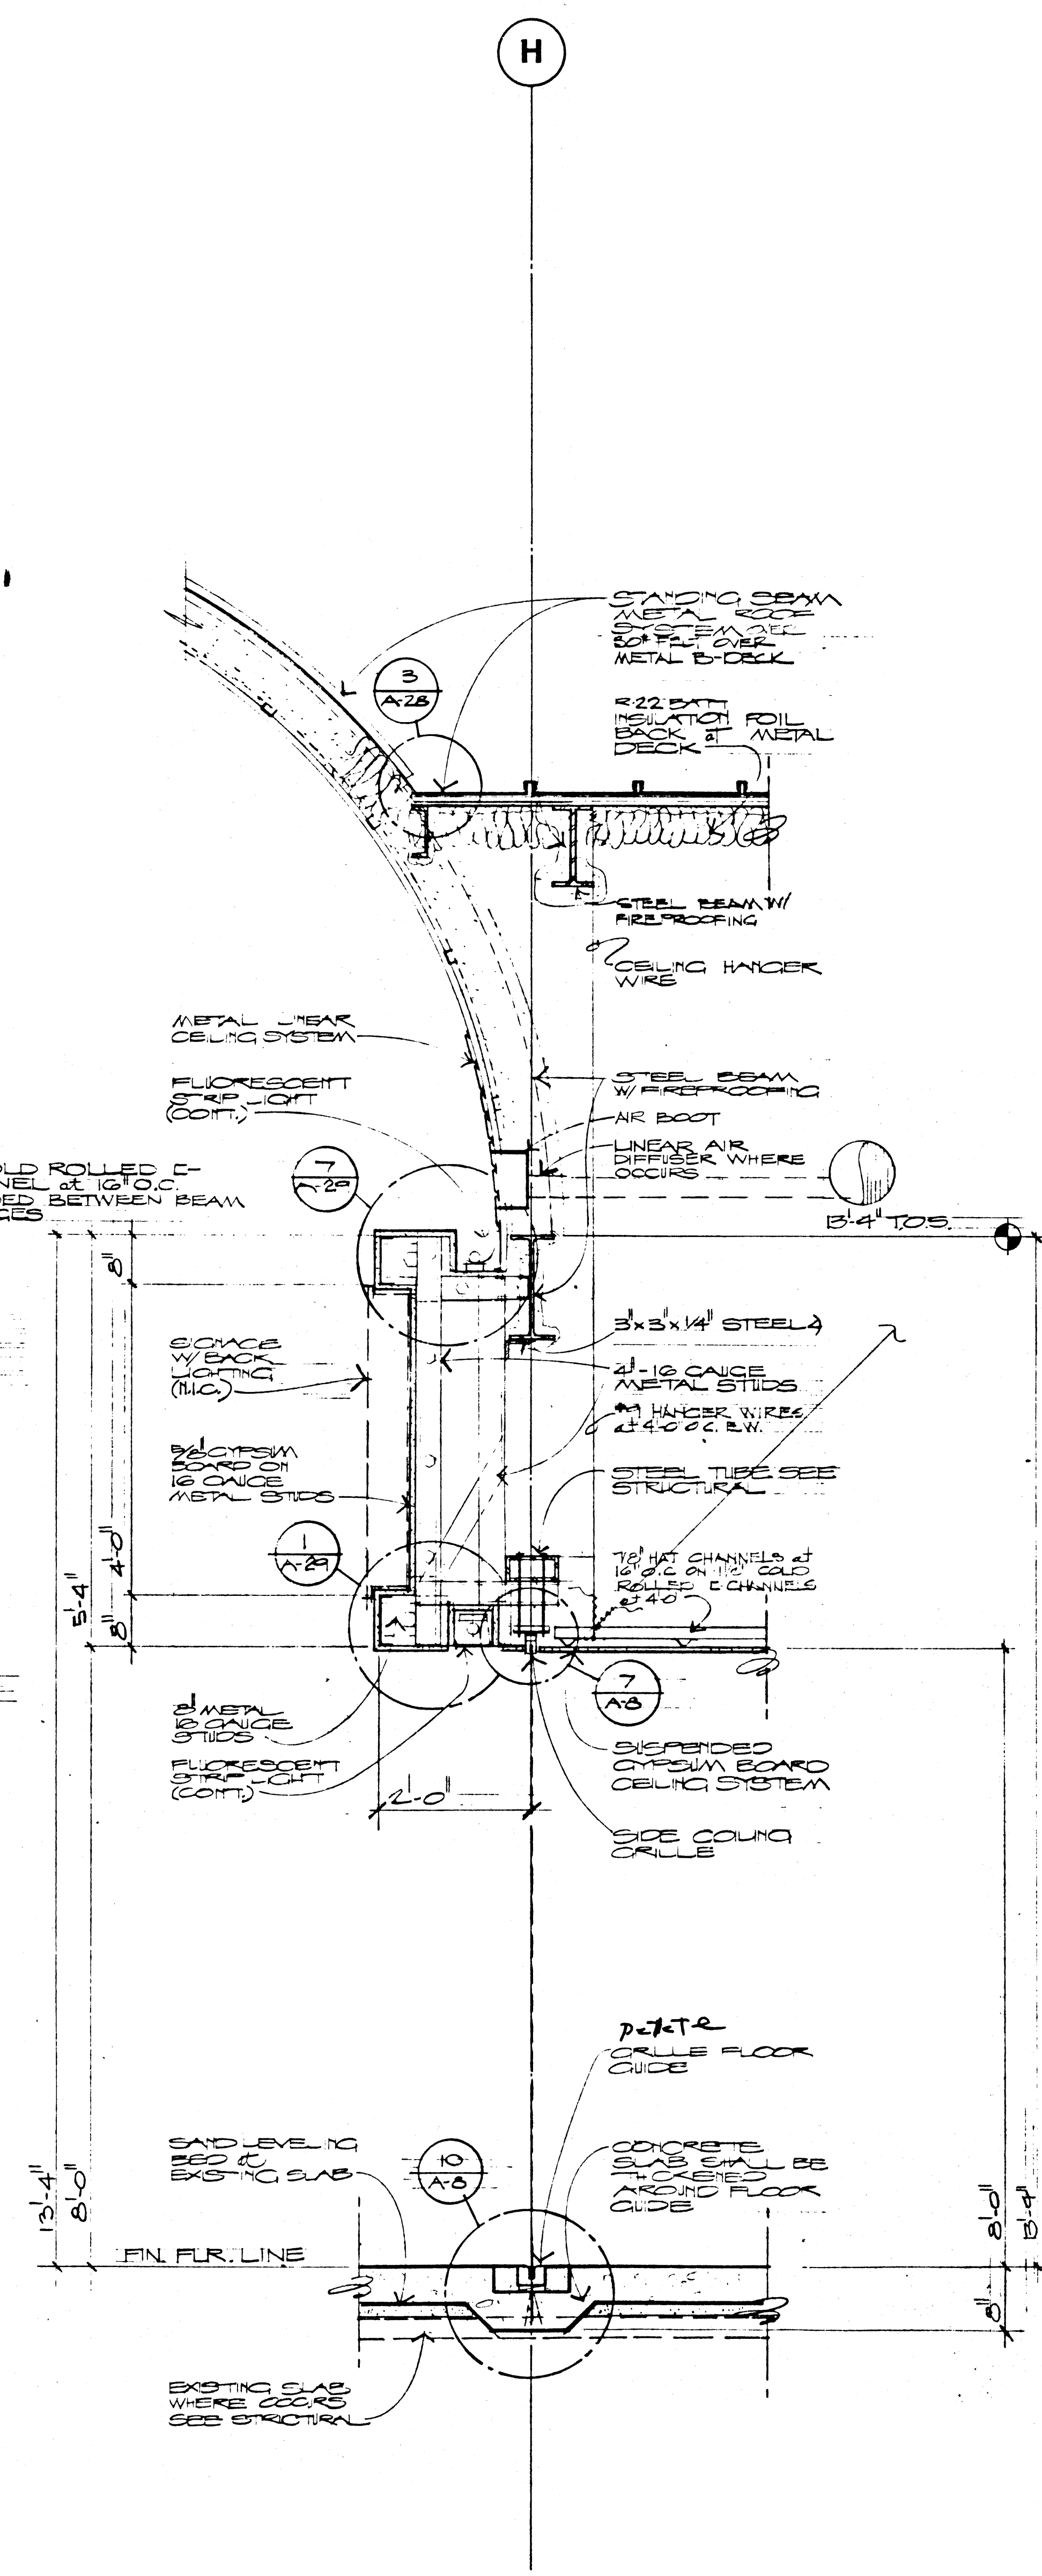

WALL SECTION
SCALE: 3/4" = 1'-0"
8
A-21

- 1 DEDUCTIVE BID ITEM #1 (1)**
IN LIEU OF METAL WINDOW FRAMES AS SHOWN, SUBSTITUTE ALUMINUM WINDOW FRAMES
- 5 DEDUCTIVE BID ITEM #5 (1)**
IN LIEU OF CERAMIC (GLAZED) TILE FLOOR AND BASE AS SHOWN, SUBSTITUTE VINYL TILE FLOOR AND BASE.
FOR DETAILED DESCRIPTION SEE SPECIFICATIONS.

NOTES:
ALL METAL STUDS WILL BE 16 GAUGE UNLESS OTHERWISE NOTED.
ALL STUD CONNECTIONS SHALL BE WELDED.
SEE SHEET A-26 FOR WALL TYPES AND CONSTRUCTION NOTES.

City of Las Vegas
Transportation Center
Las Vegas, Nevada

DOBUSKY KITTRELL GARLOCK
Architects
550 CHARLES ST. LAS VEGAS, NEVADA 89101
(702) 735-0408

A-21
30 OF 65
FILE NUMBER 590-21