




DETAIL 1
SCALE: 1 1/2" = 1'-0"

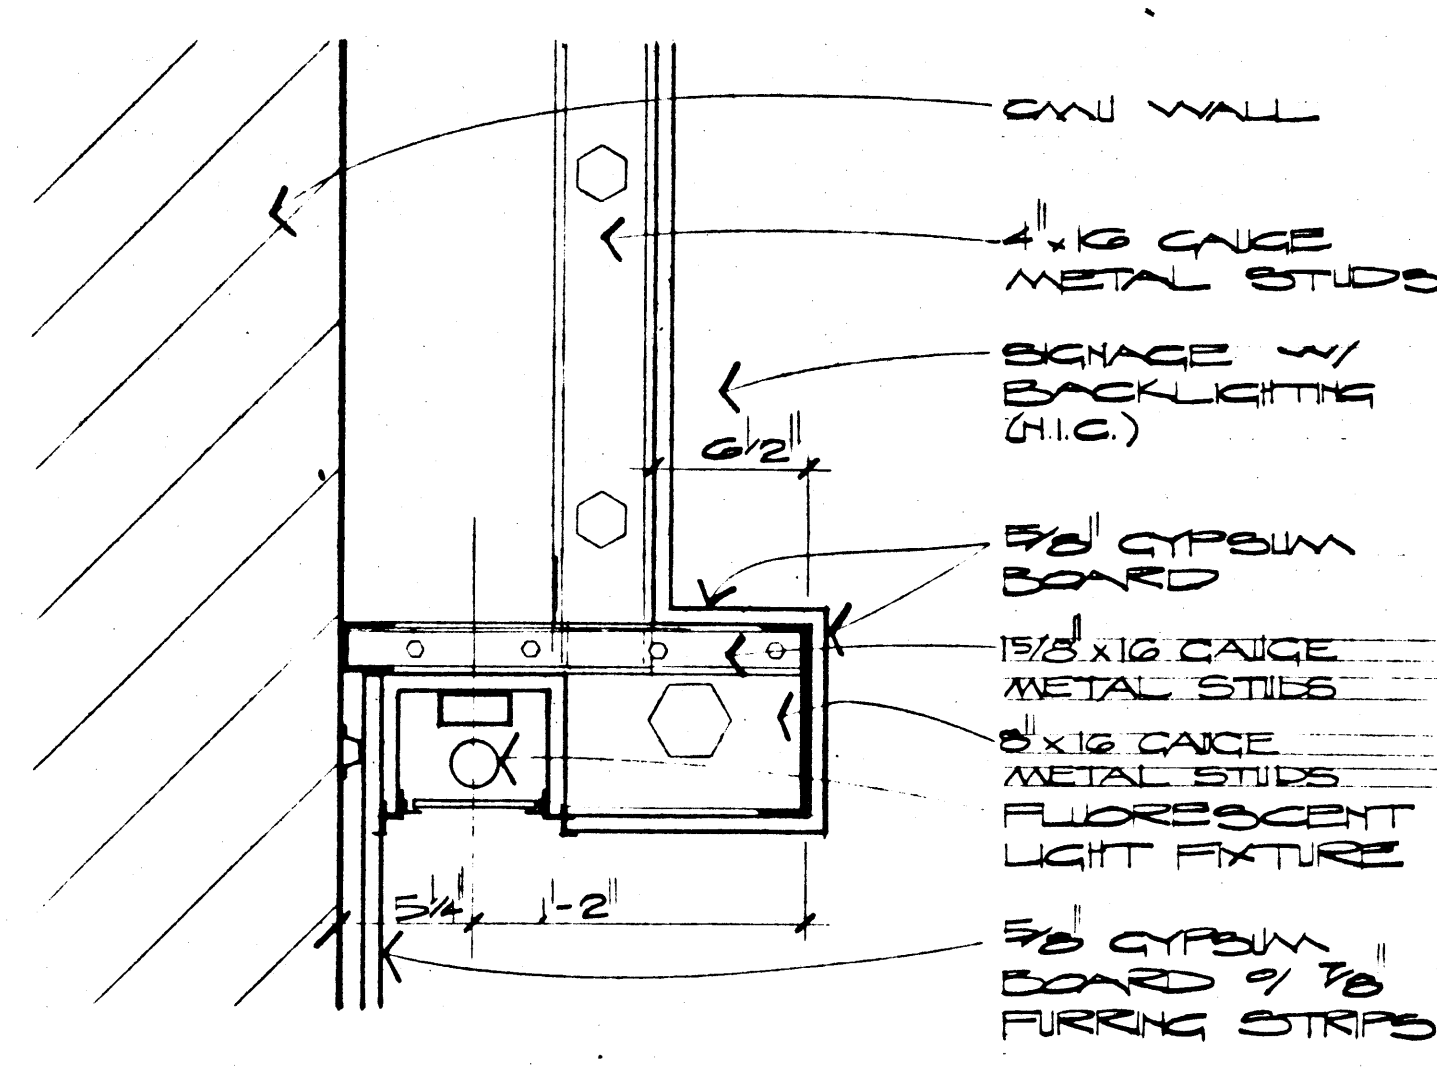


DETAIL 2
SCALE: 1 1/2" = 1'-0"

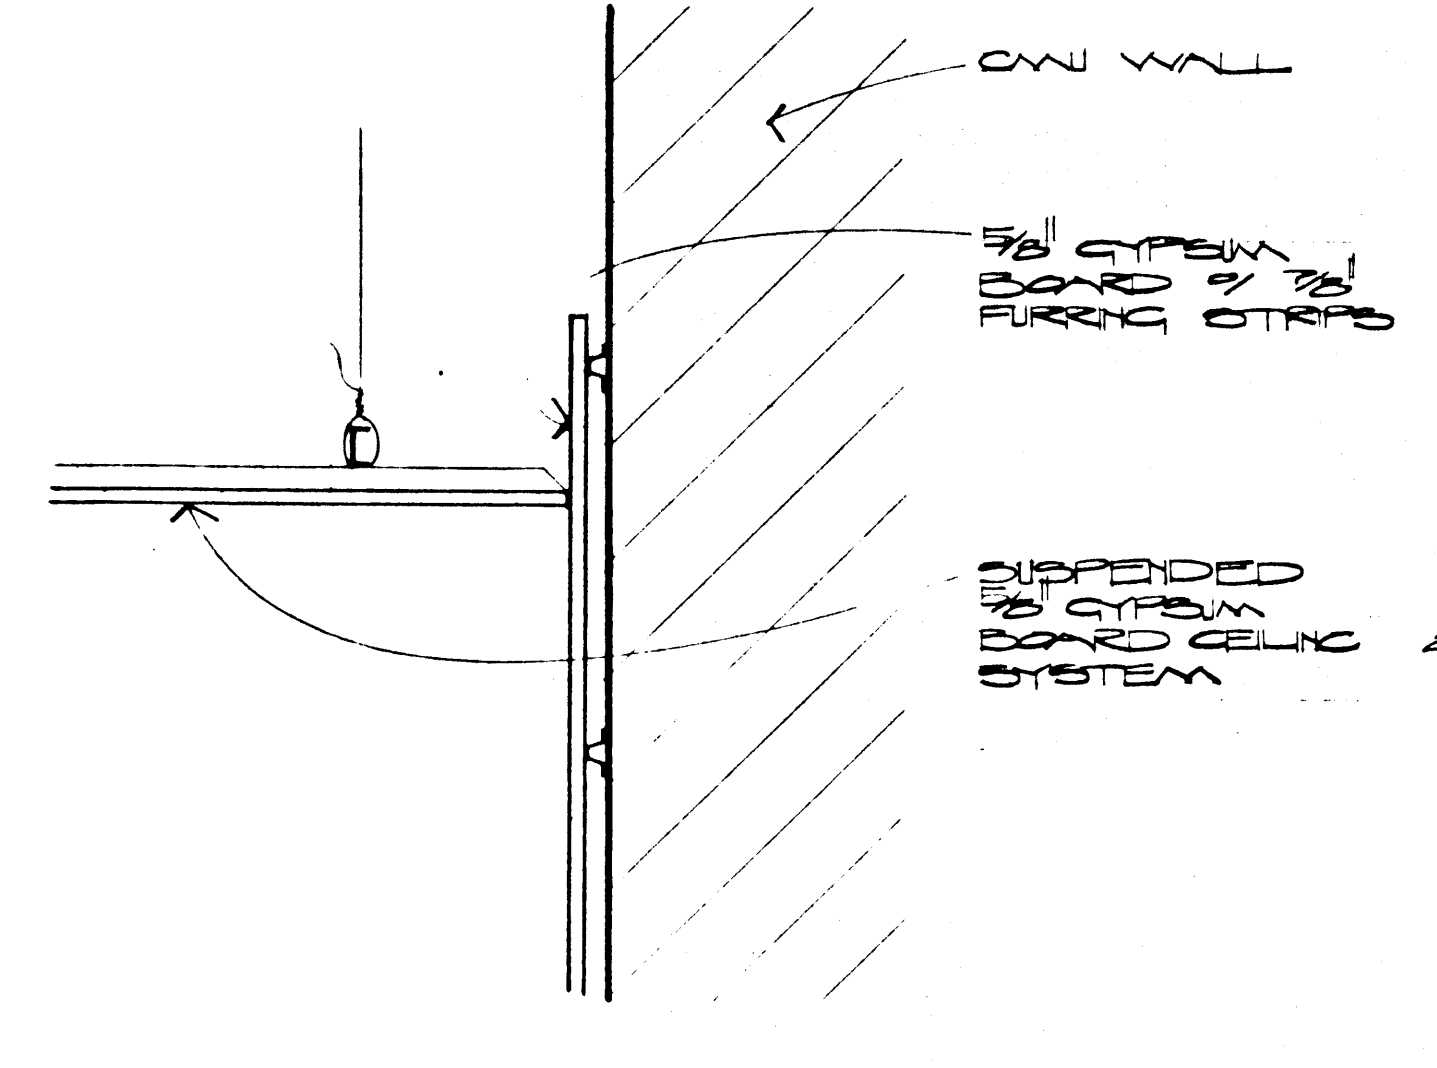


DETAIL 3
SCALE: 1 1/2" = 1'-0"

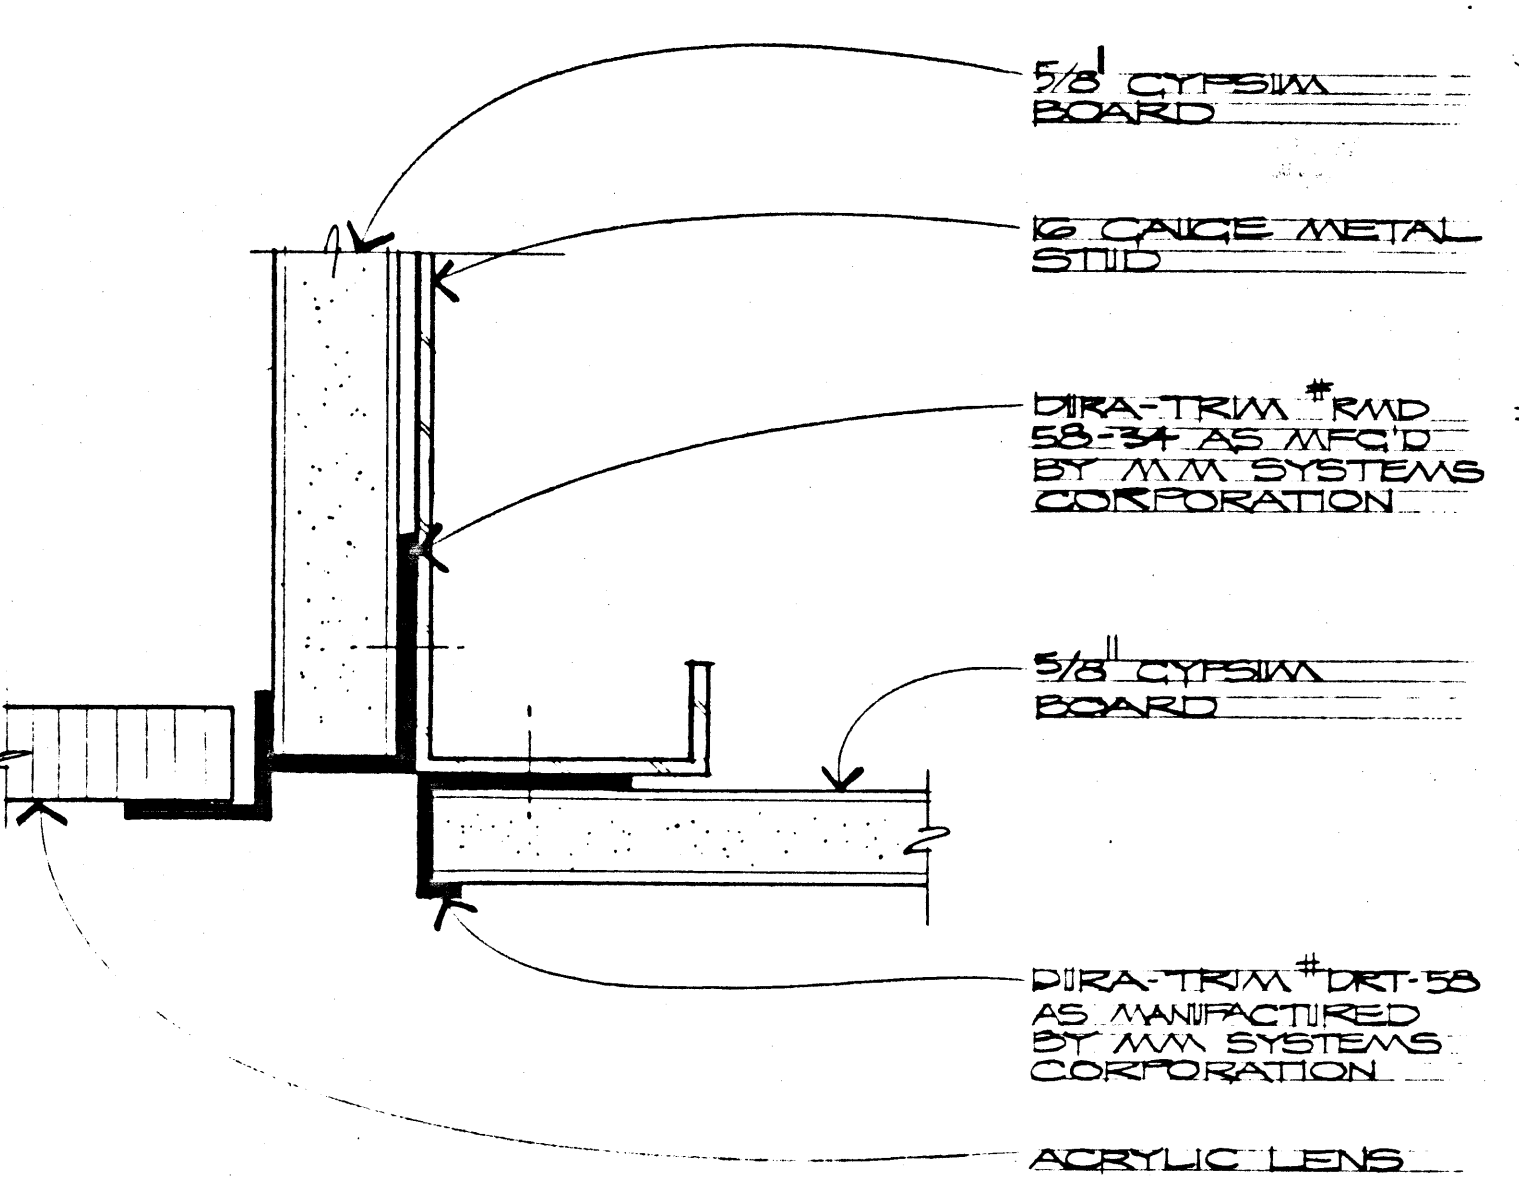


DETAIL 4
SCALE: 3" = 1'-0"

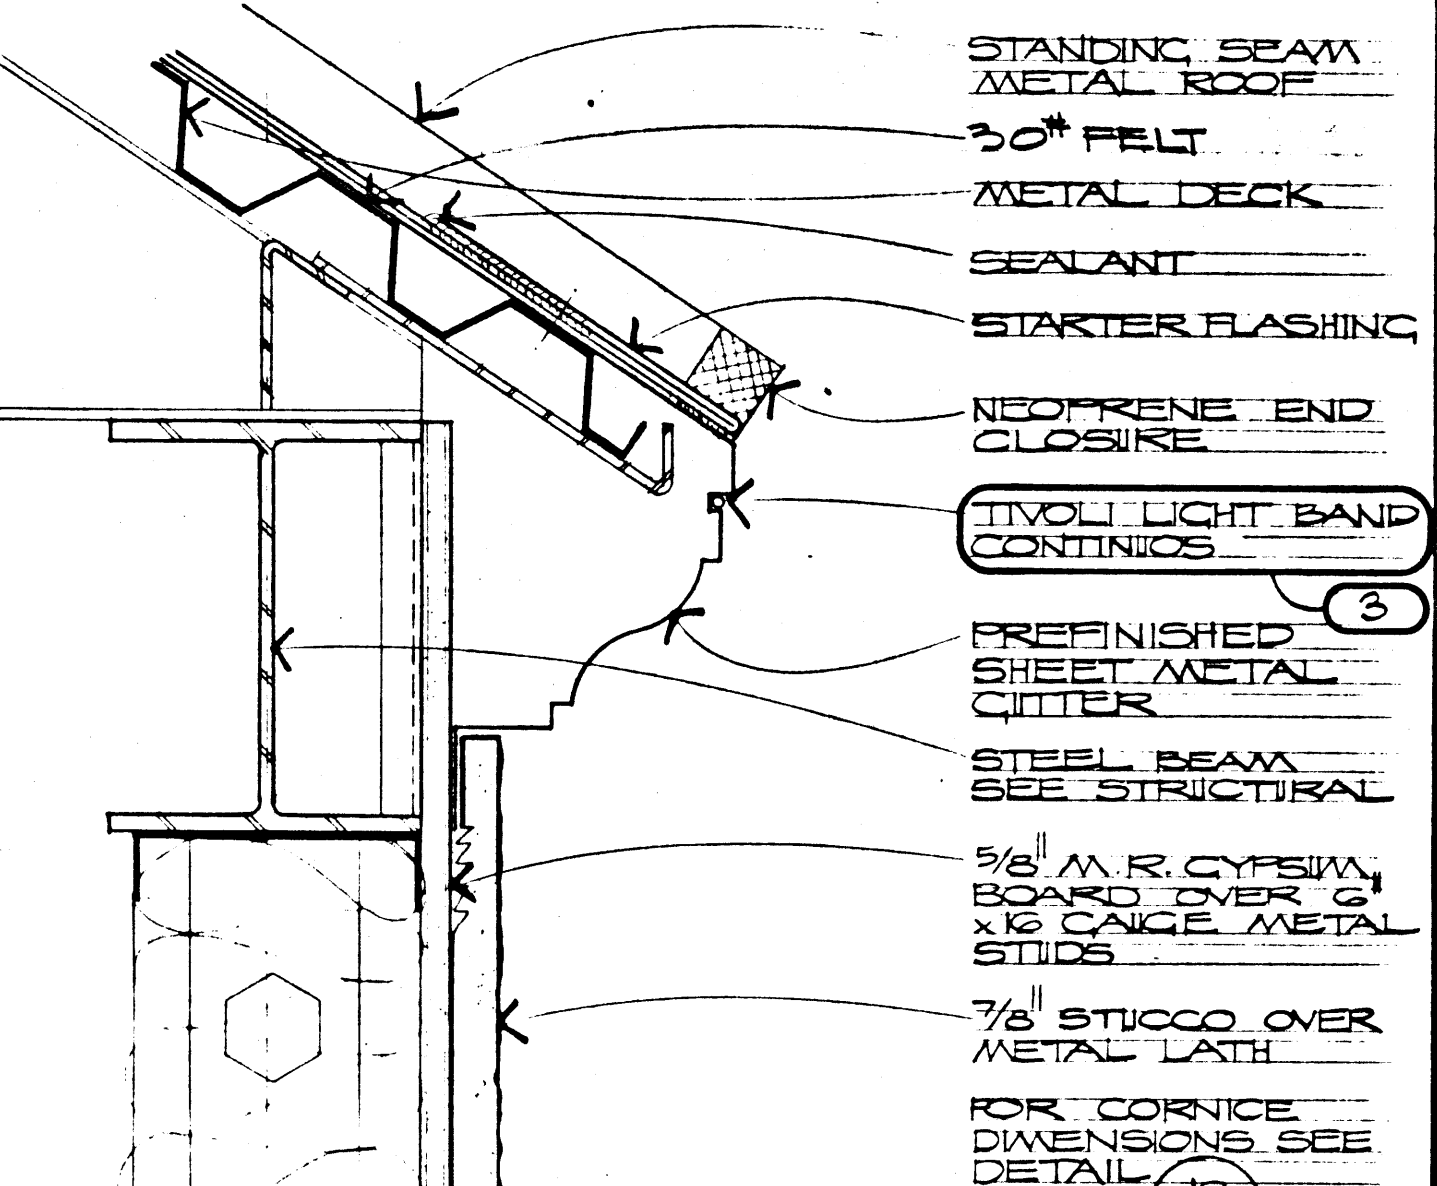


DETAIL 5
SCALE: 3" = 1'-0"

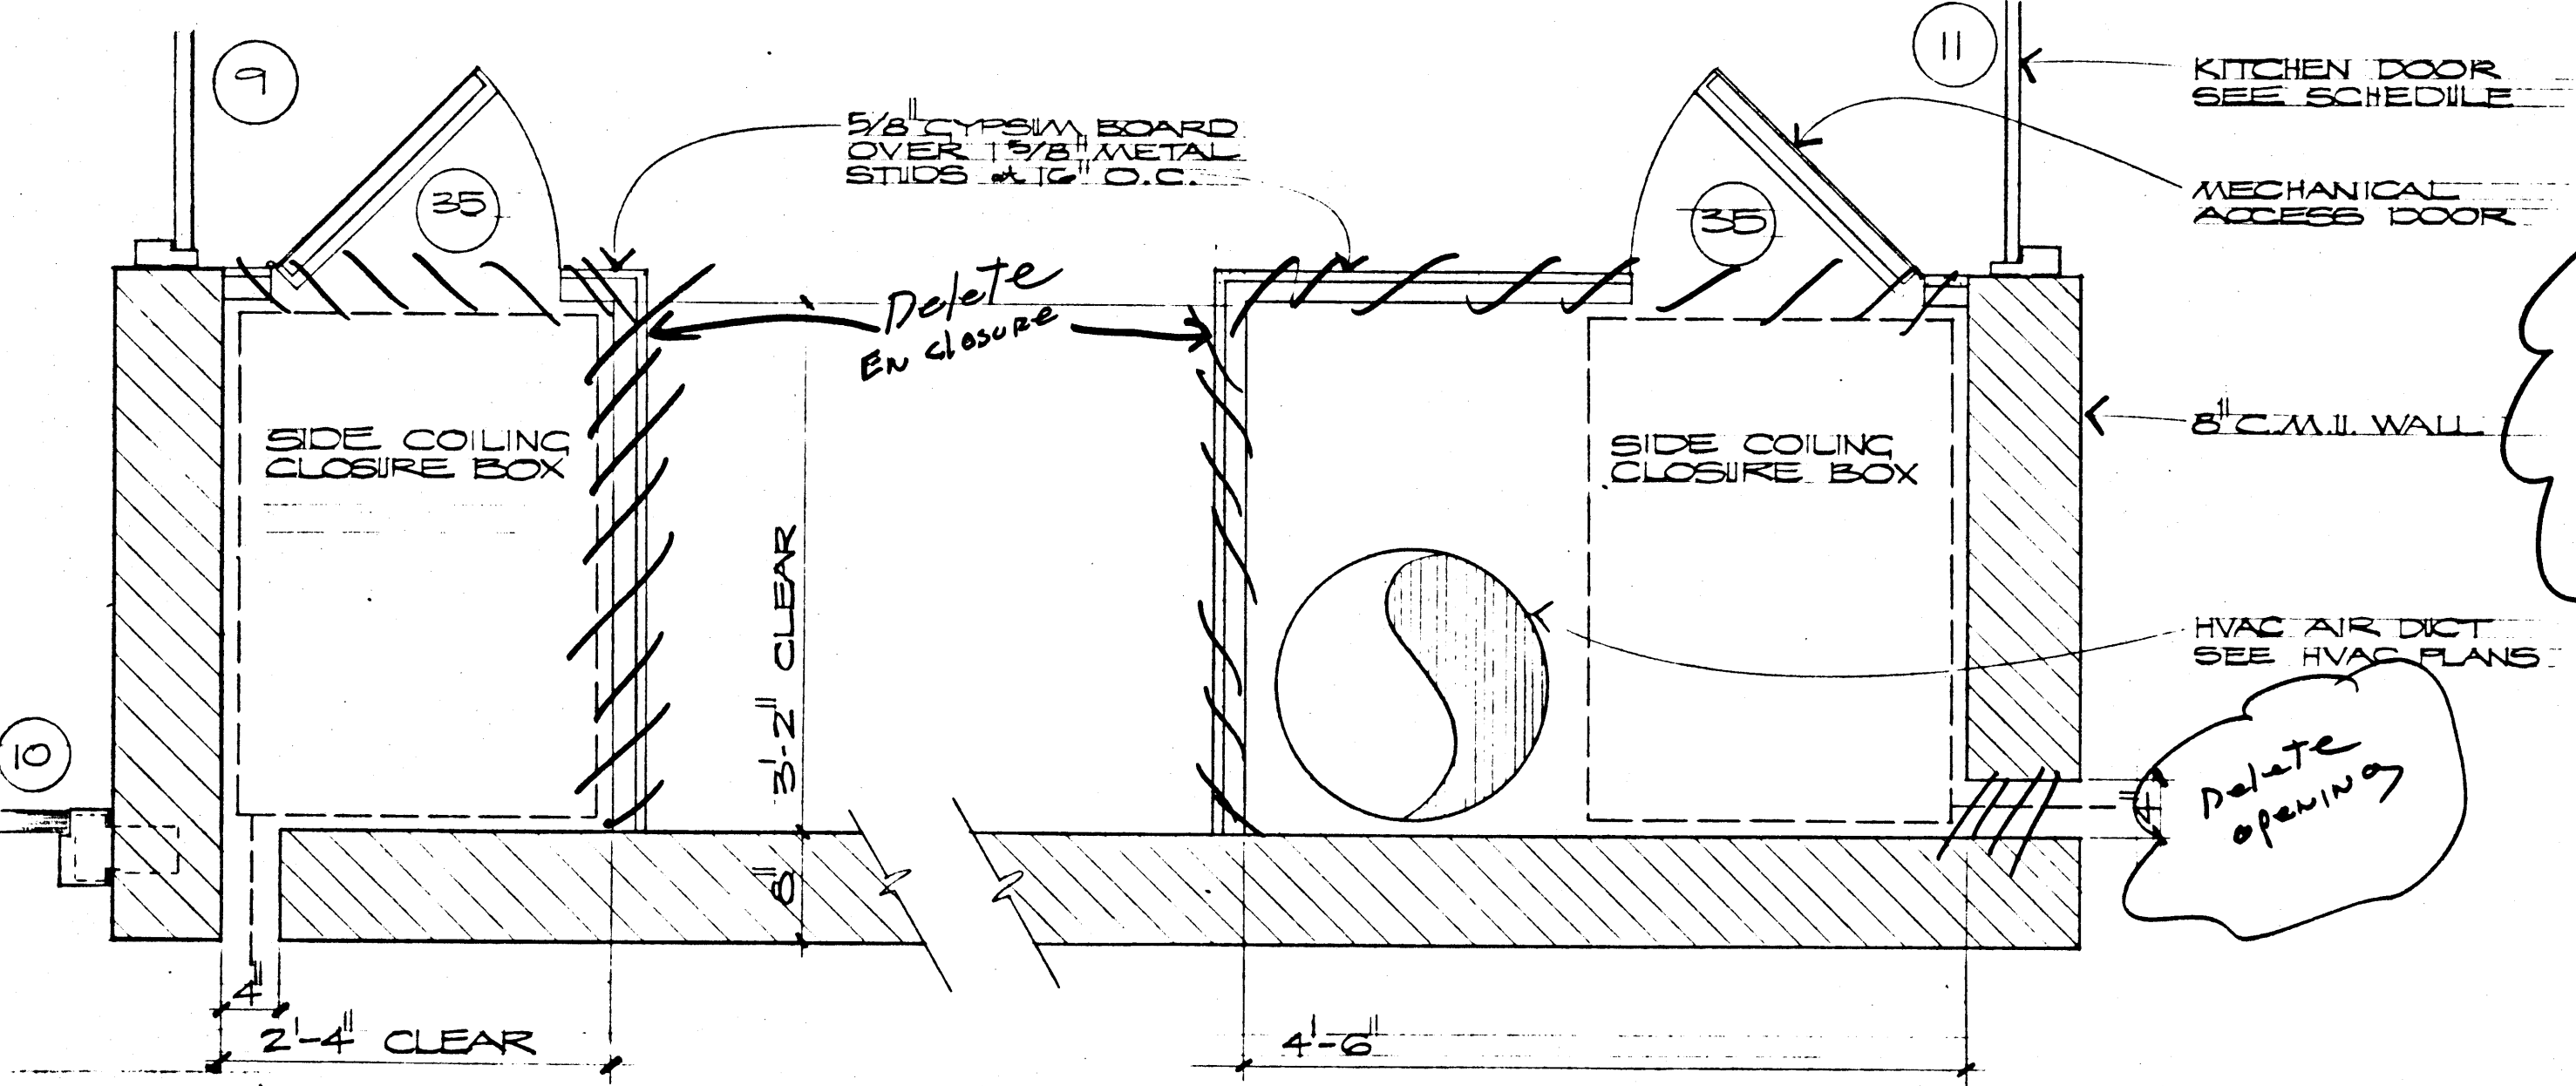


DETAIL 6
SCALE: 1" = 1'-0"

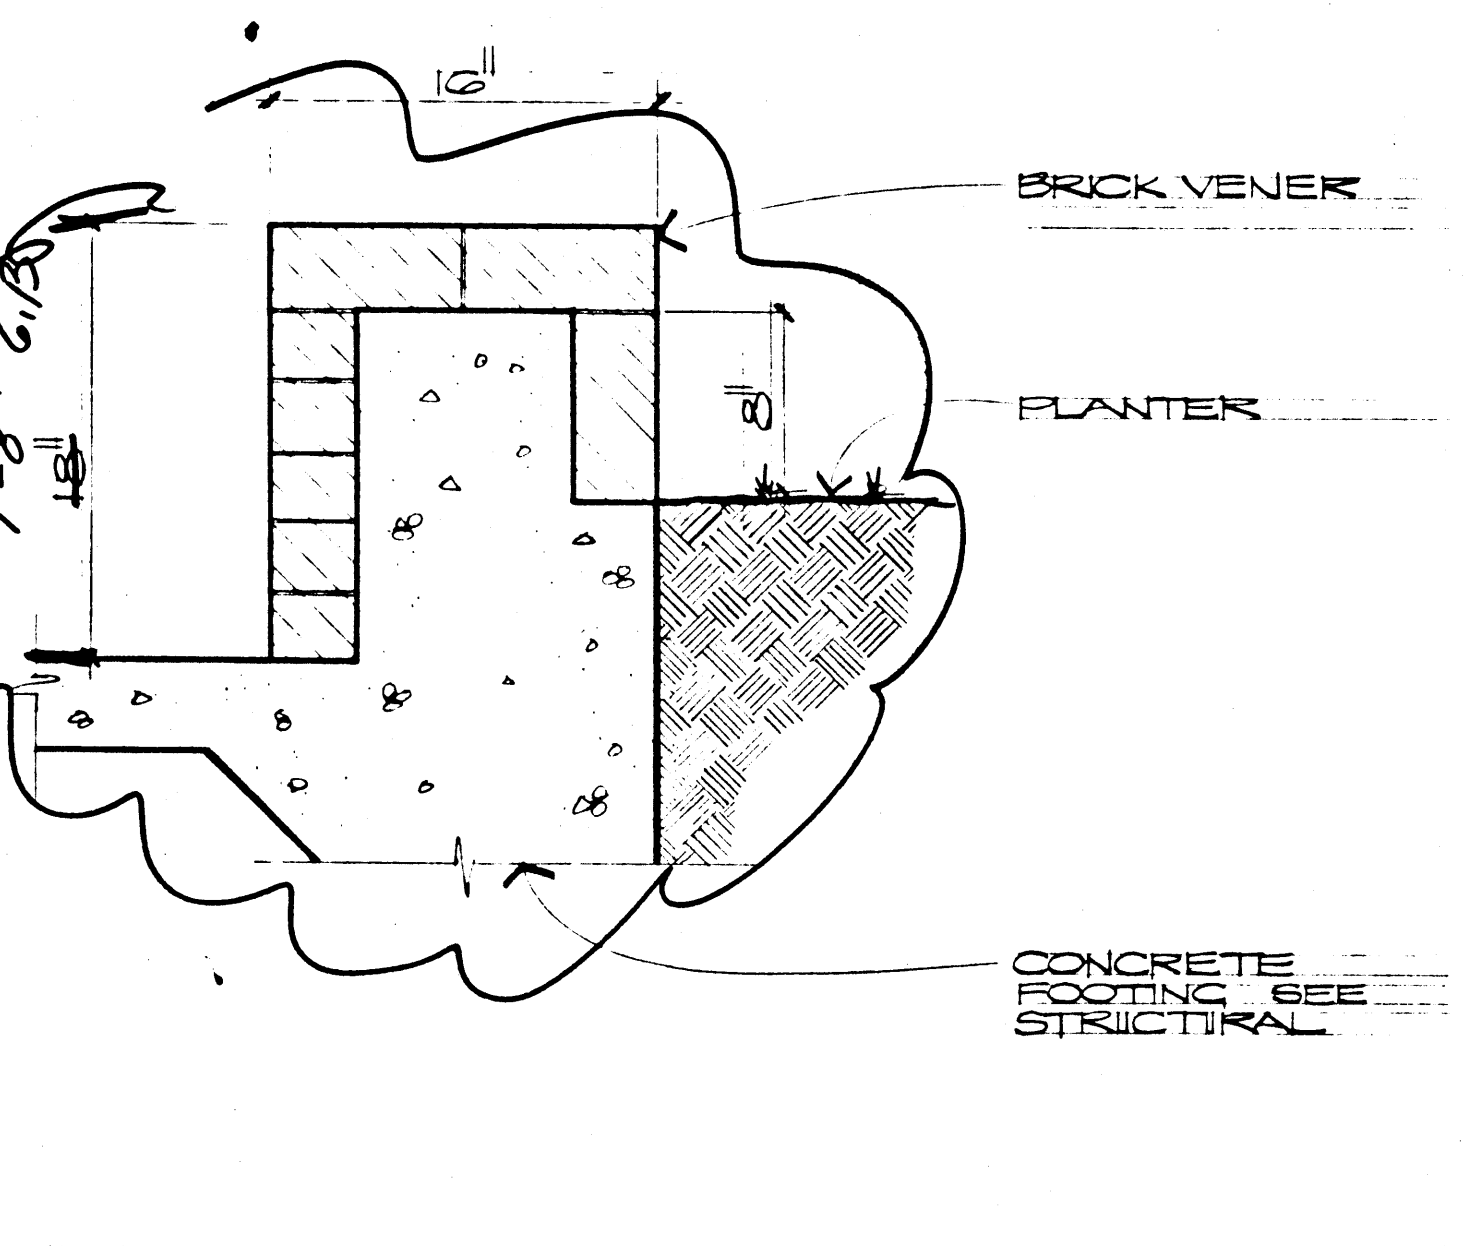


DETAIL 7
SCALE: 1 1/2" = 1'-0"

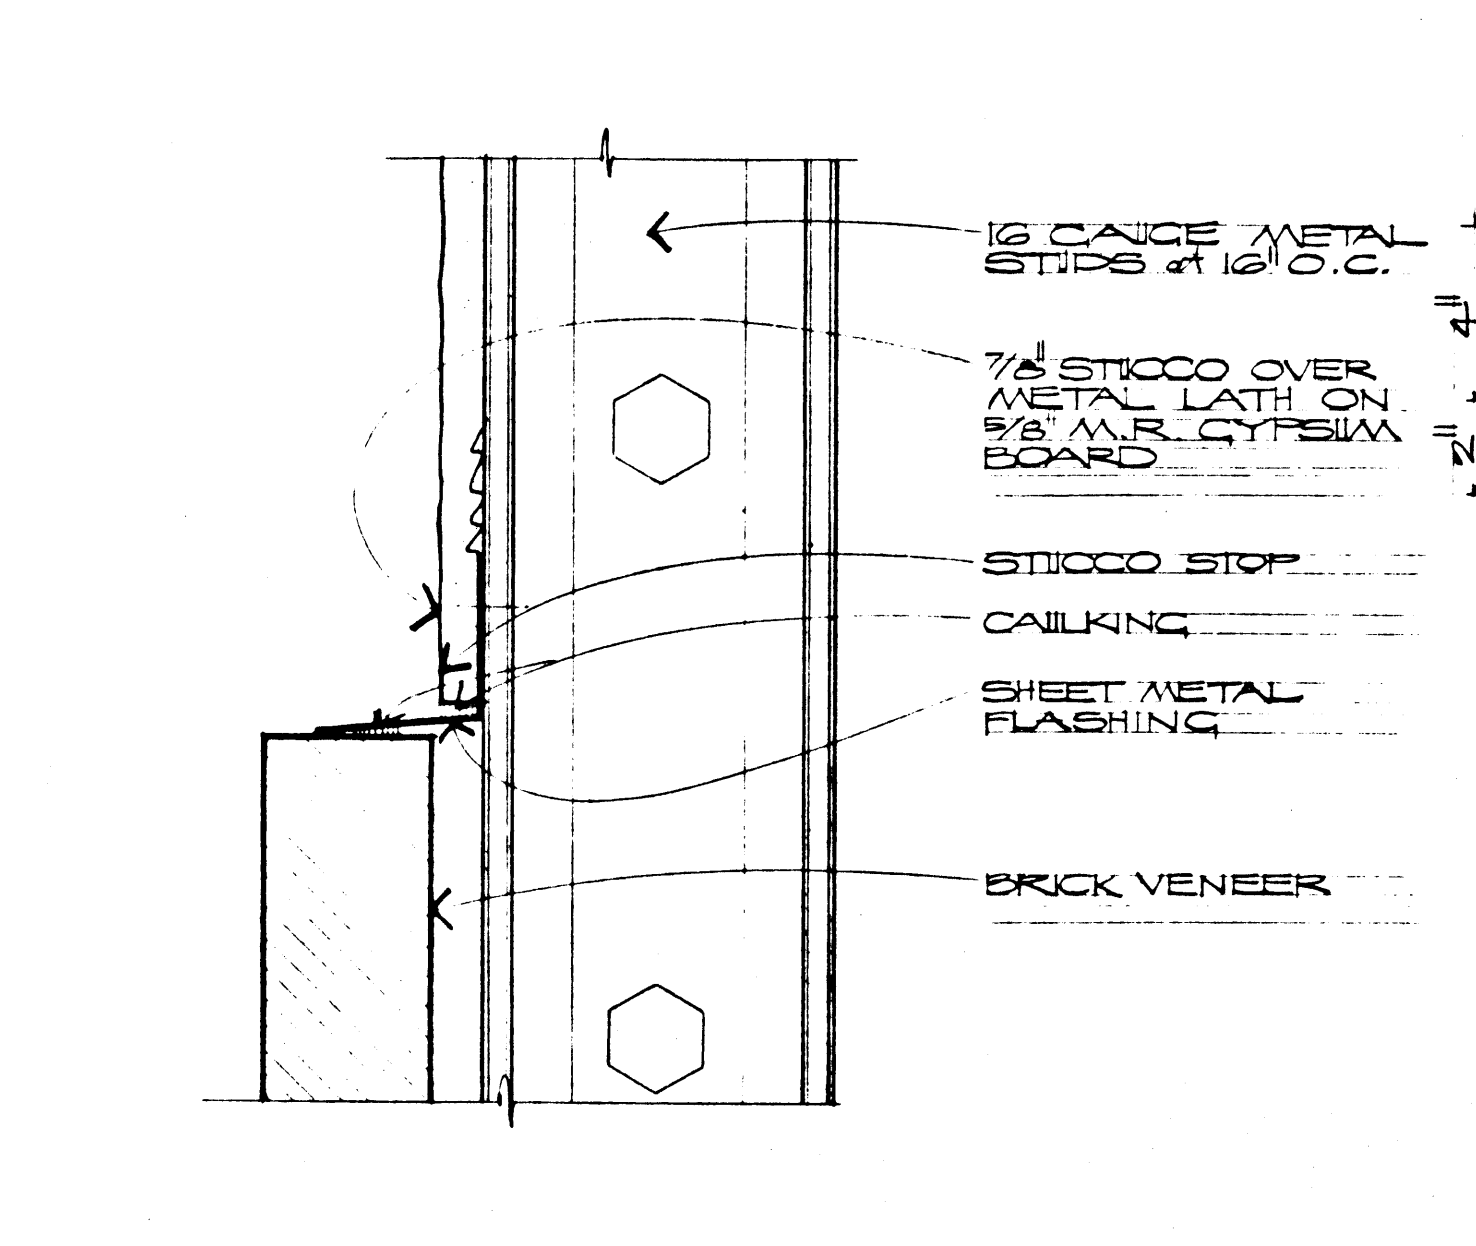


DETAIL 8
SCALE: 3" = 1'-0"

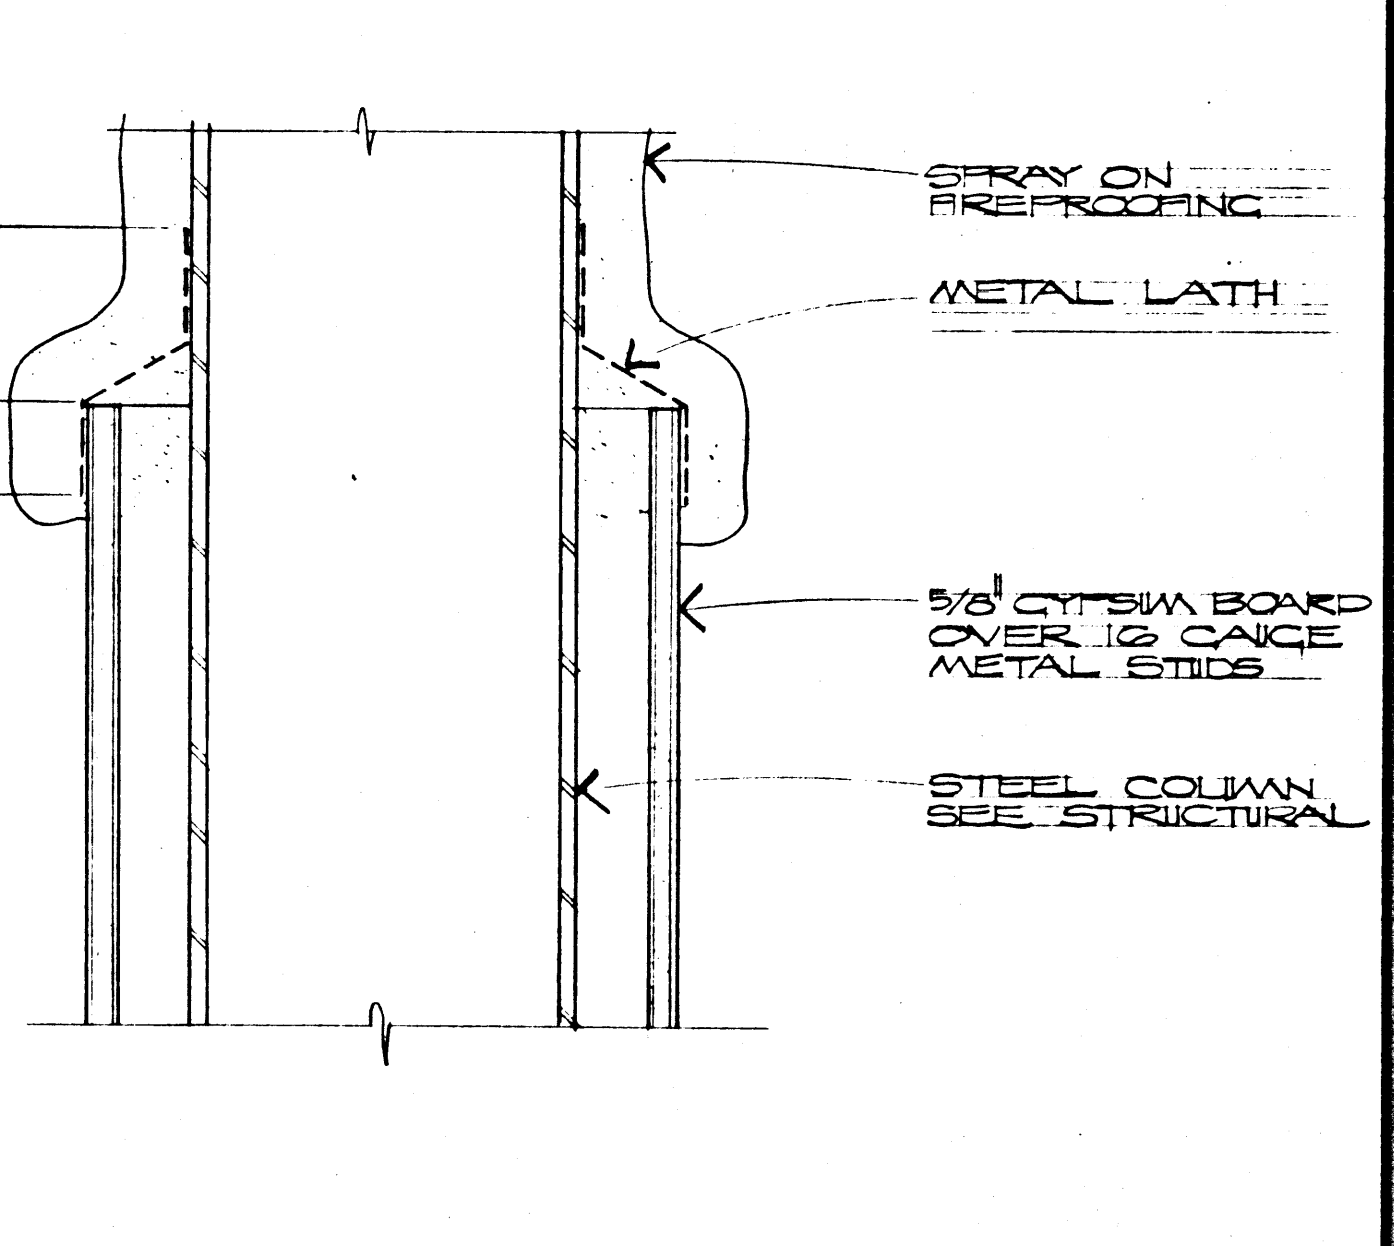


DETAIL 9
SCALE: 3" = 1'-0"

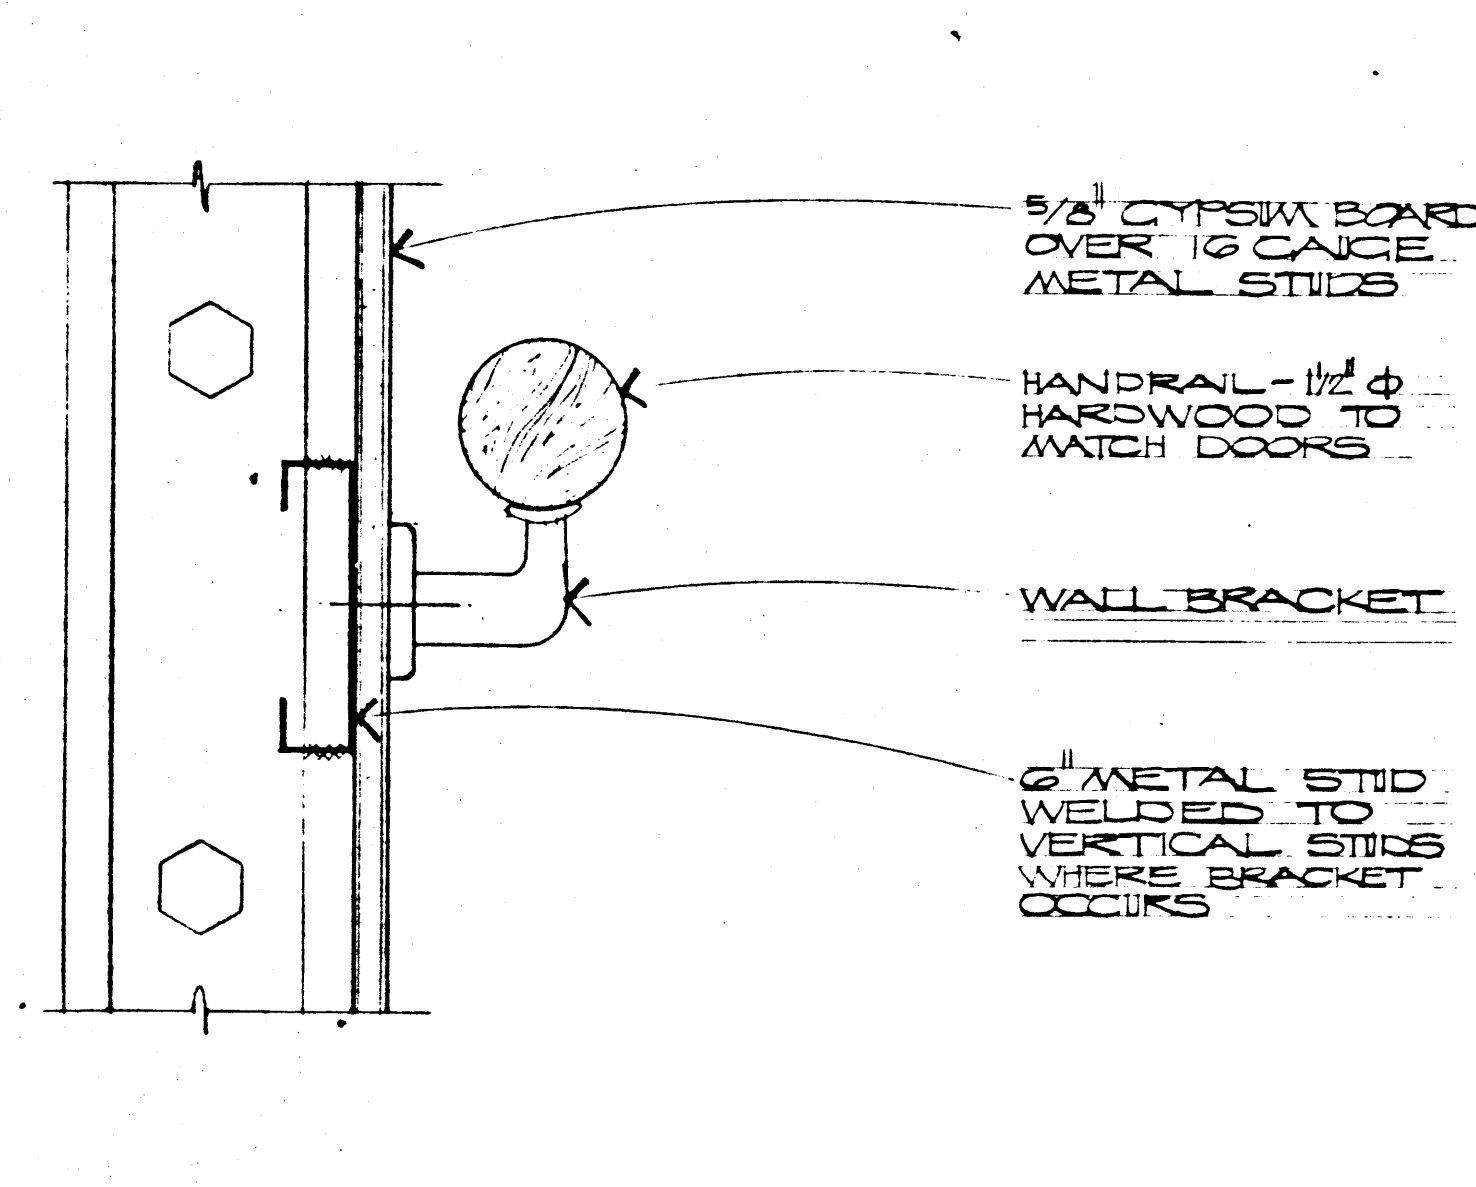


DETAIL 10
SCALE: 3" = 1'-0"

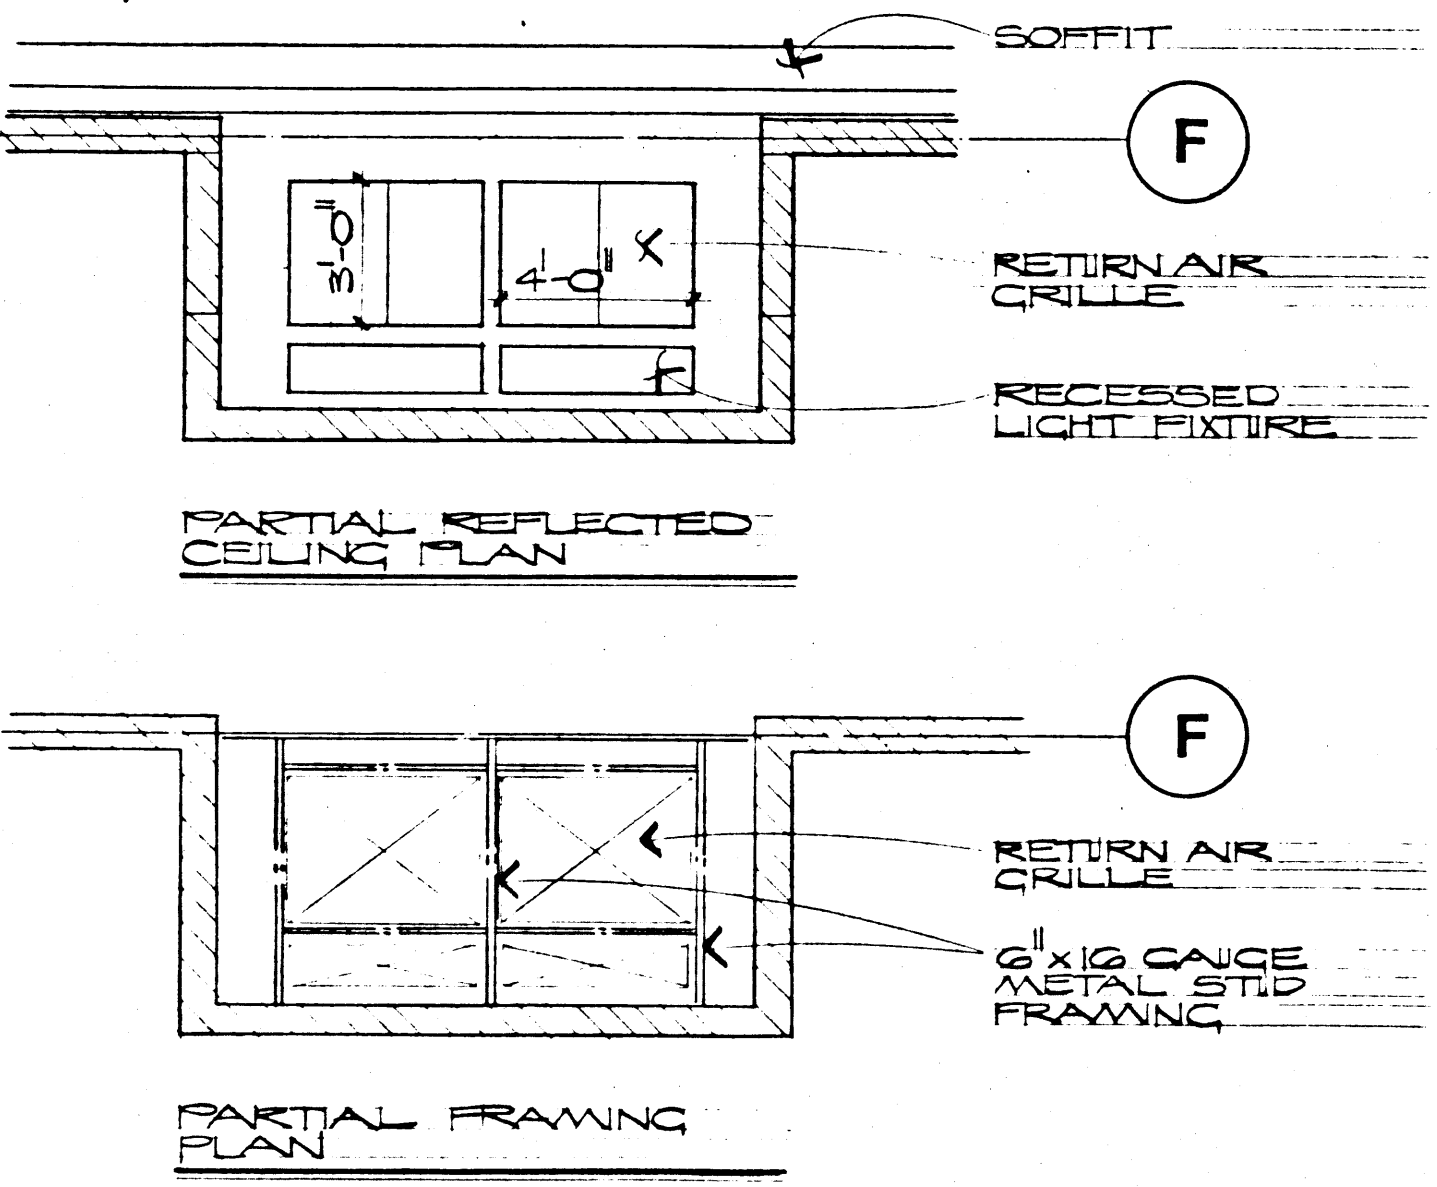


DETAIL 11
SCALE: 3" = 1'-0"

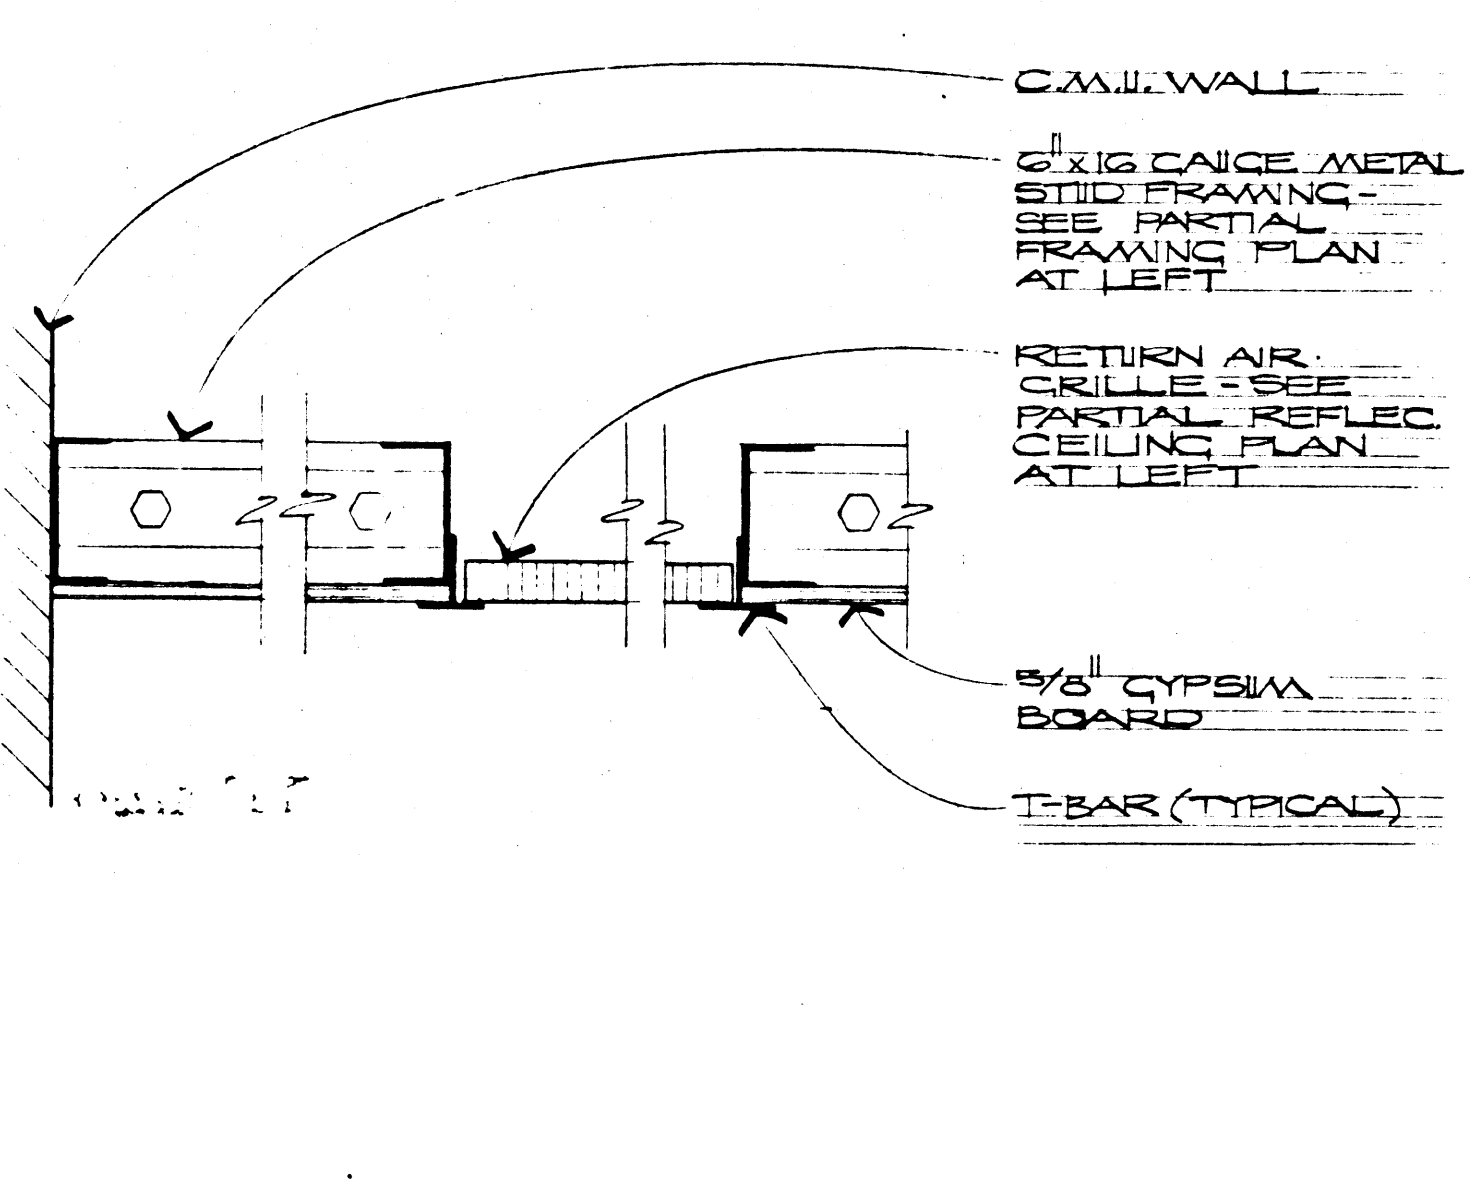


DETAIL 12
SCALE: 1 1/2" = 1'-0"

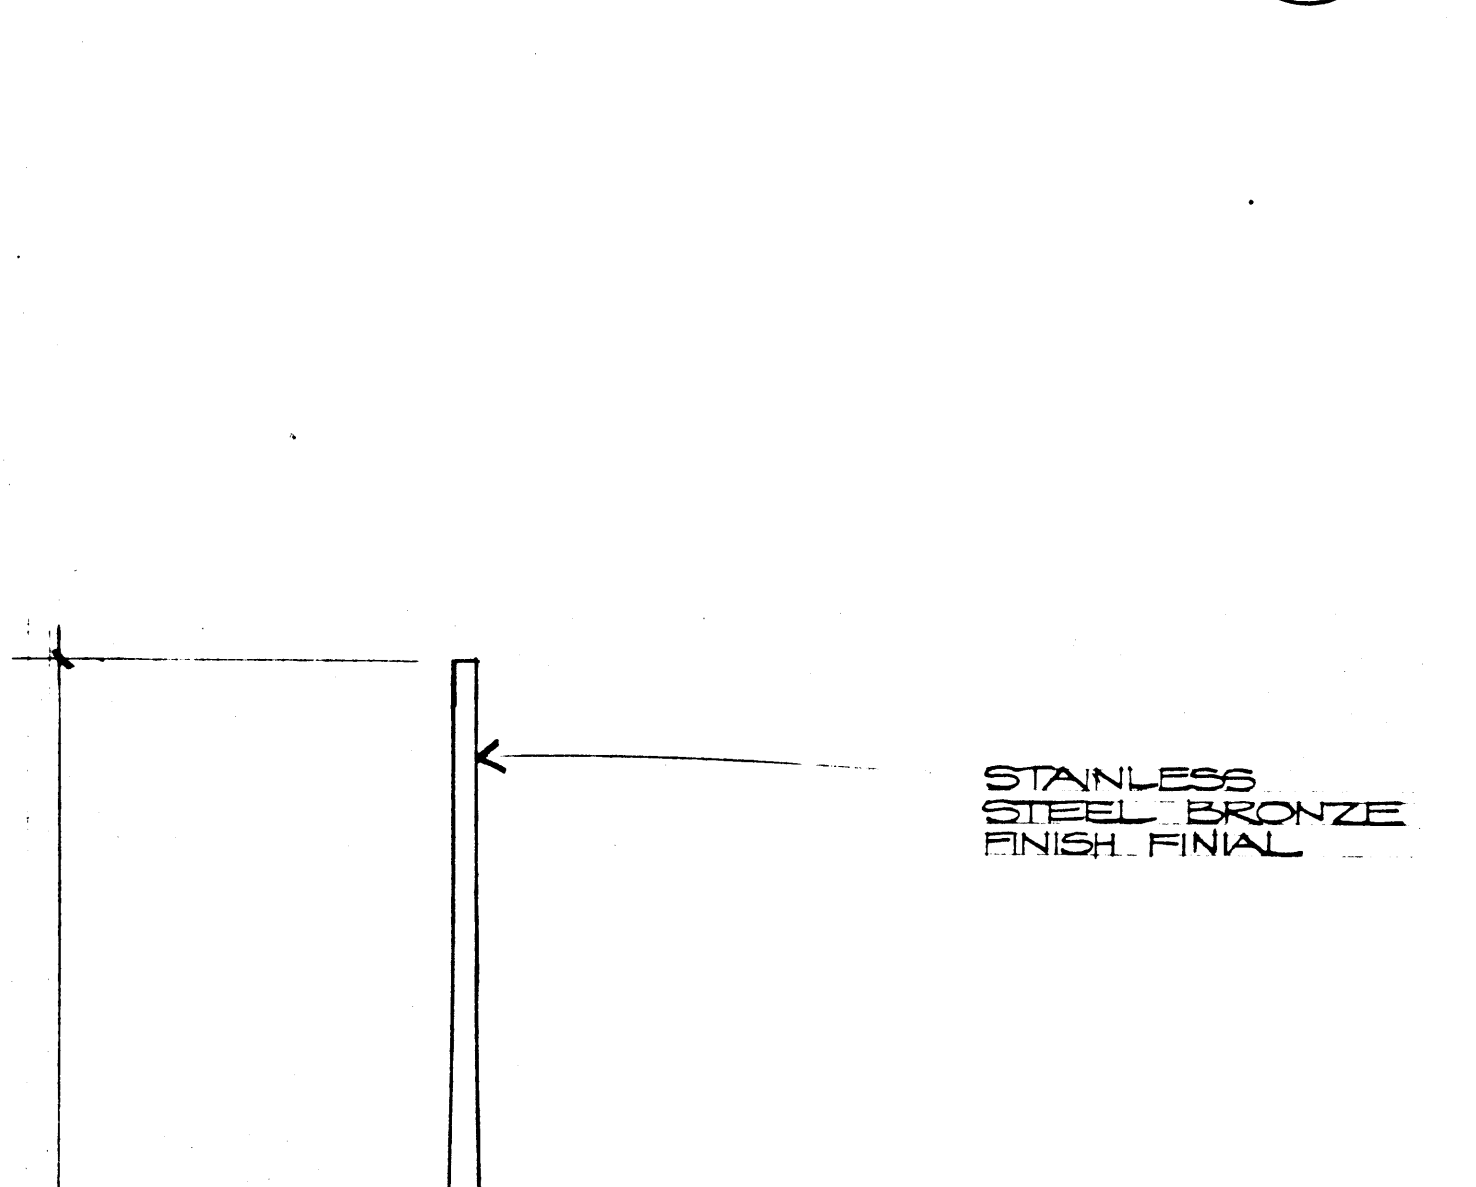


DETAIL 13
SCALE: 3" = 1'-0"

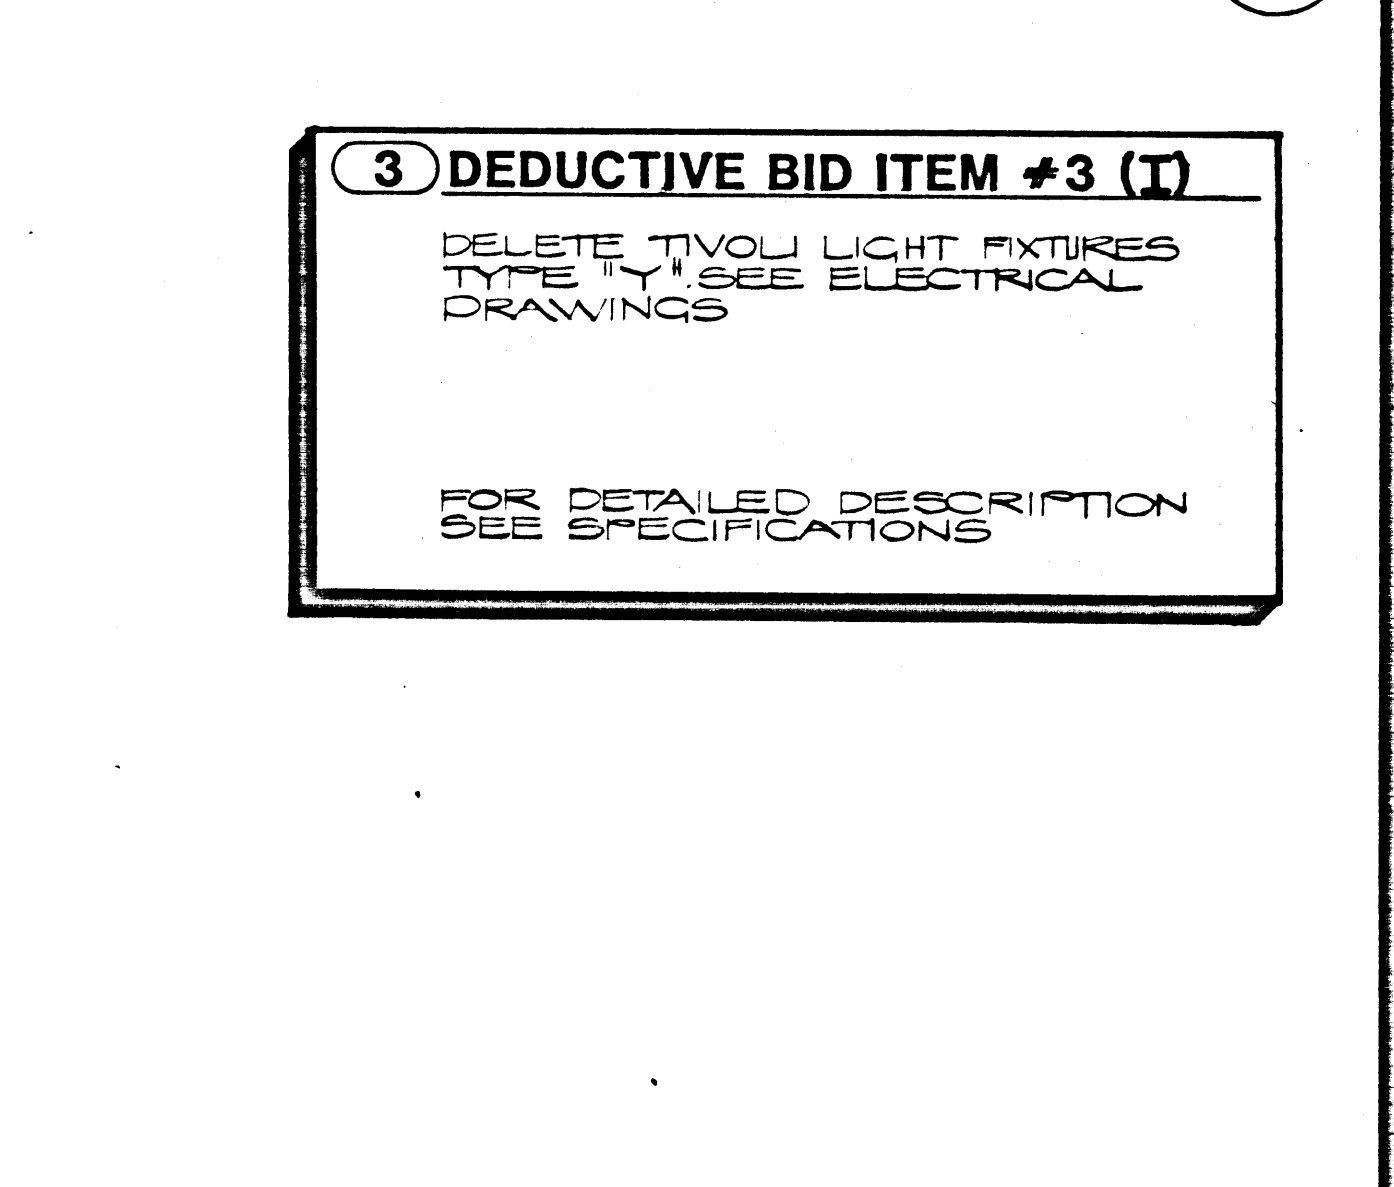



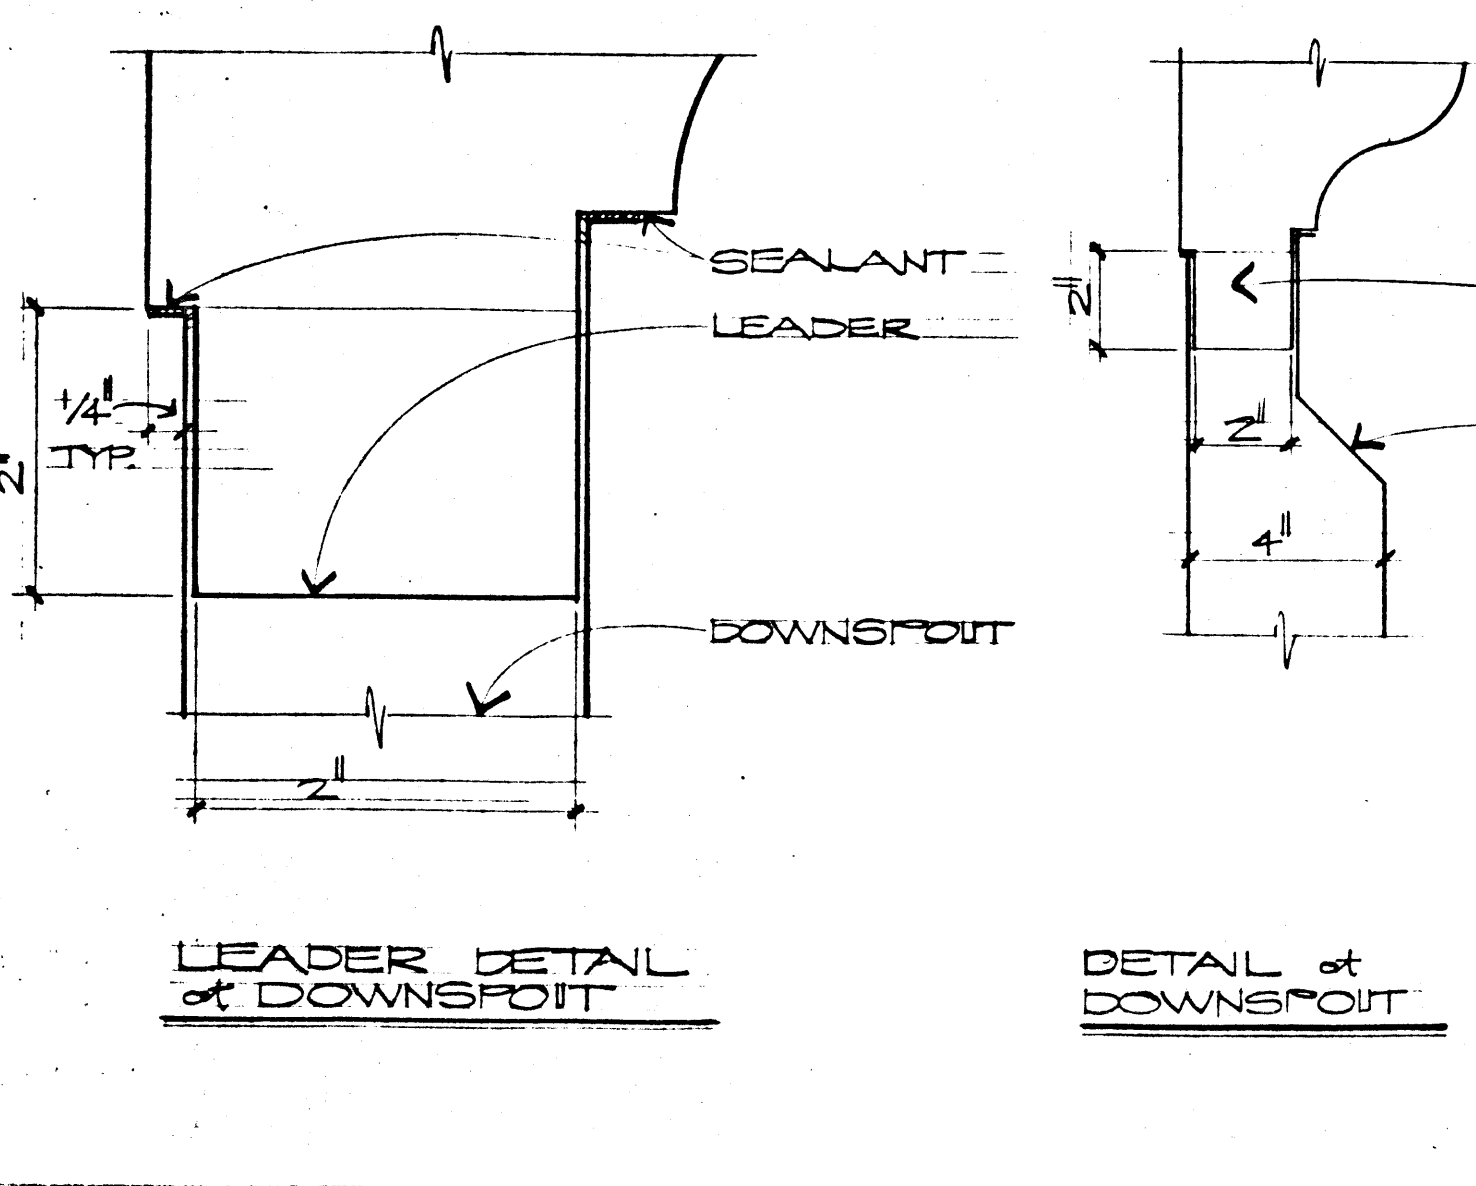



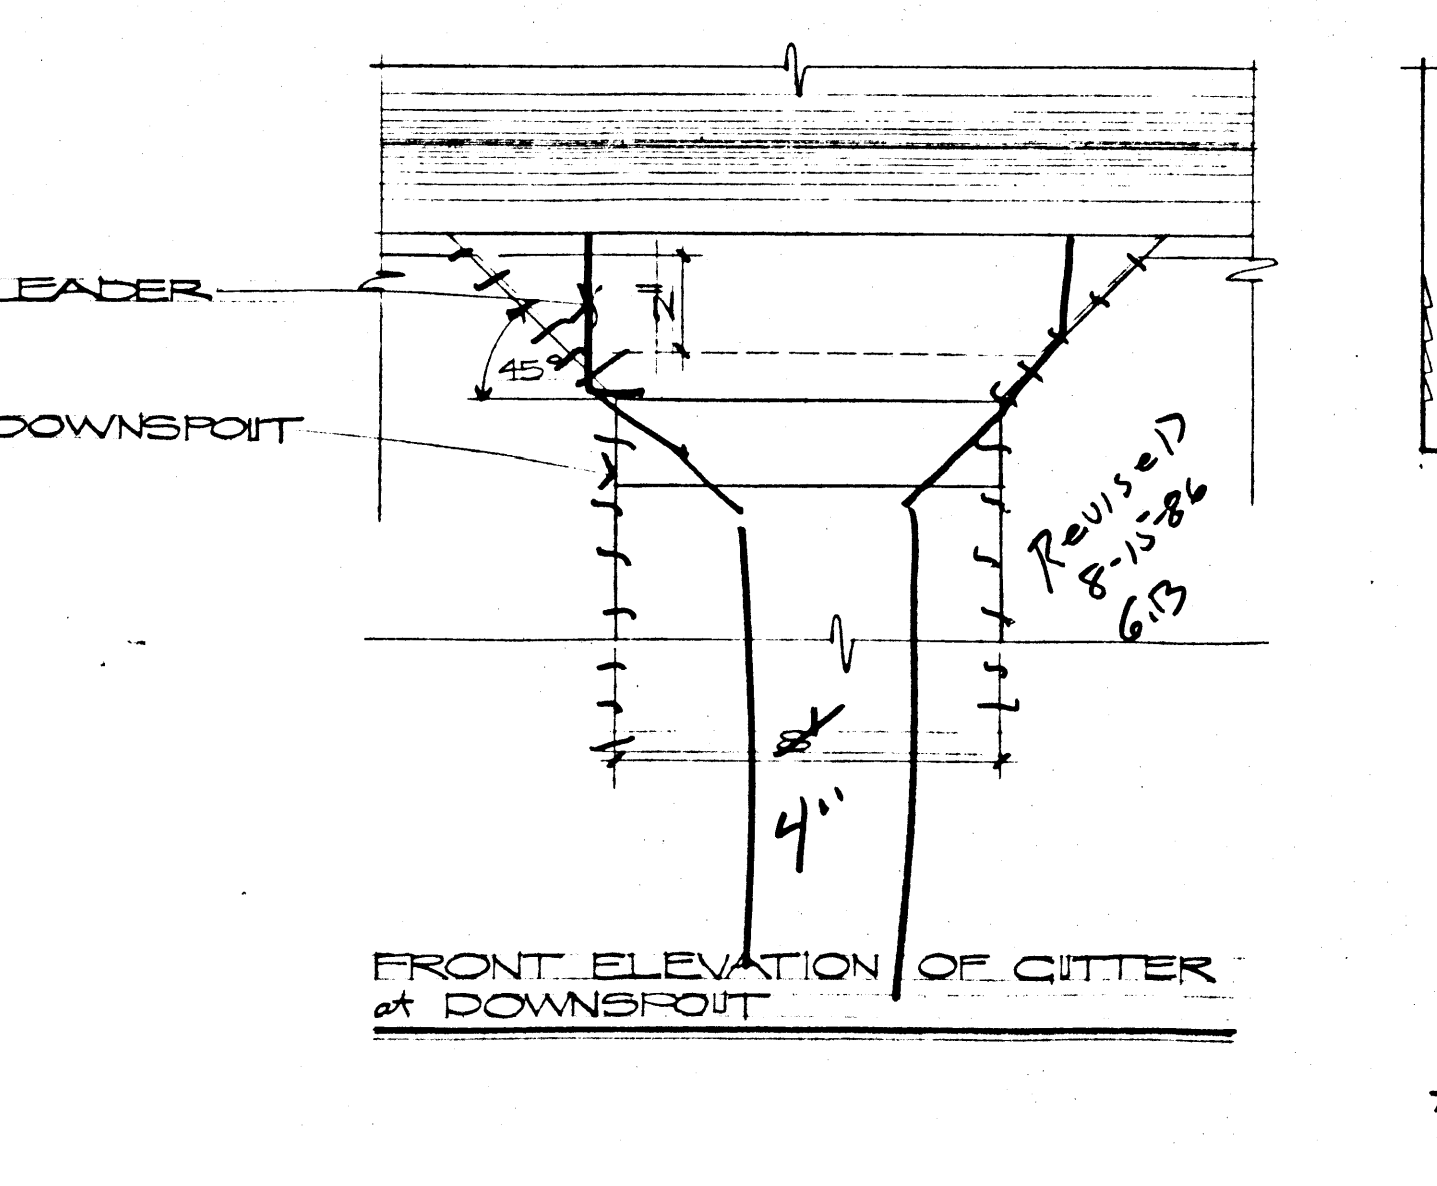



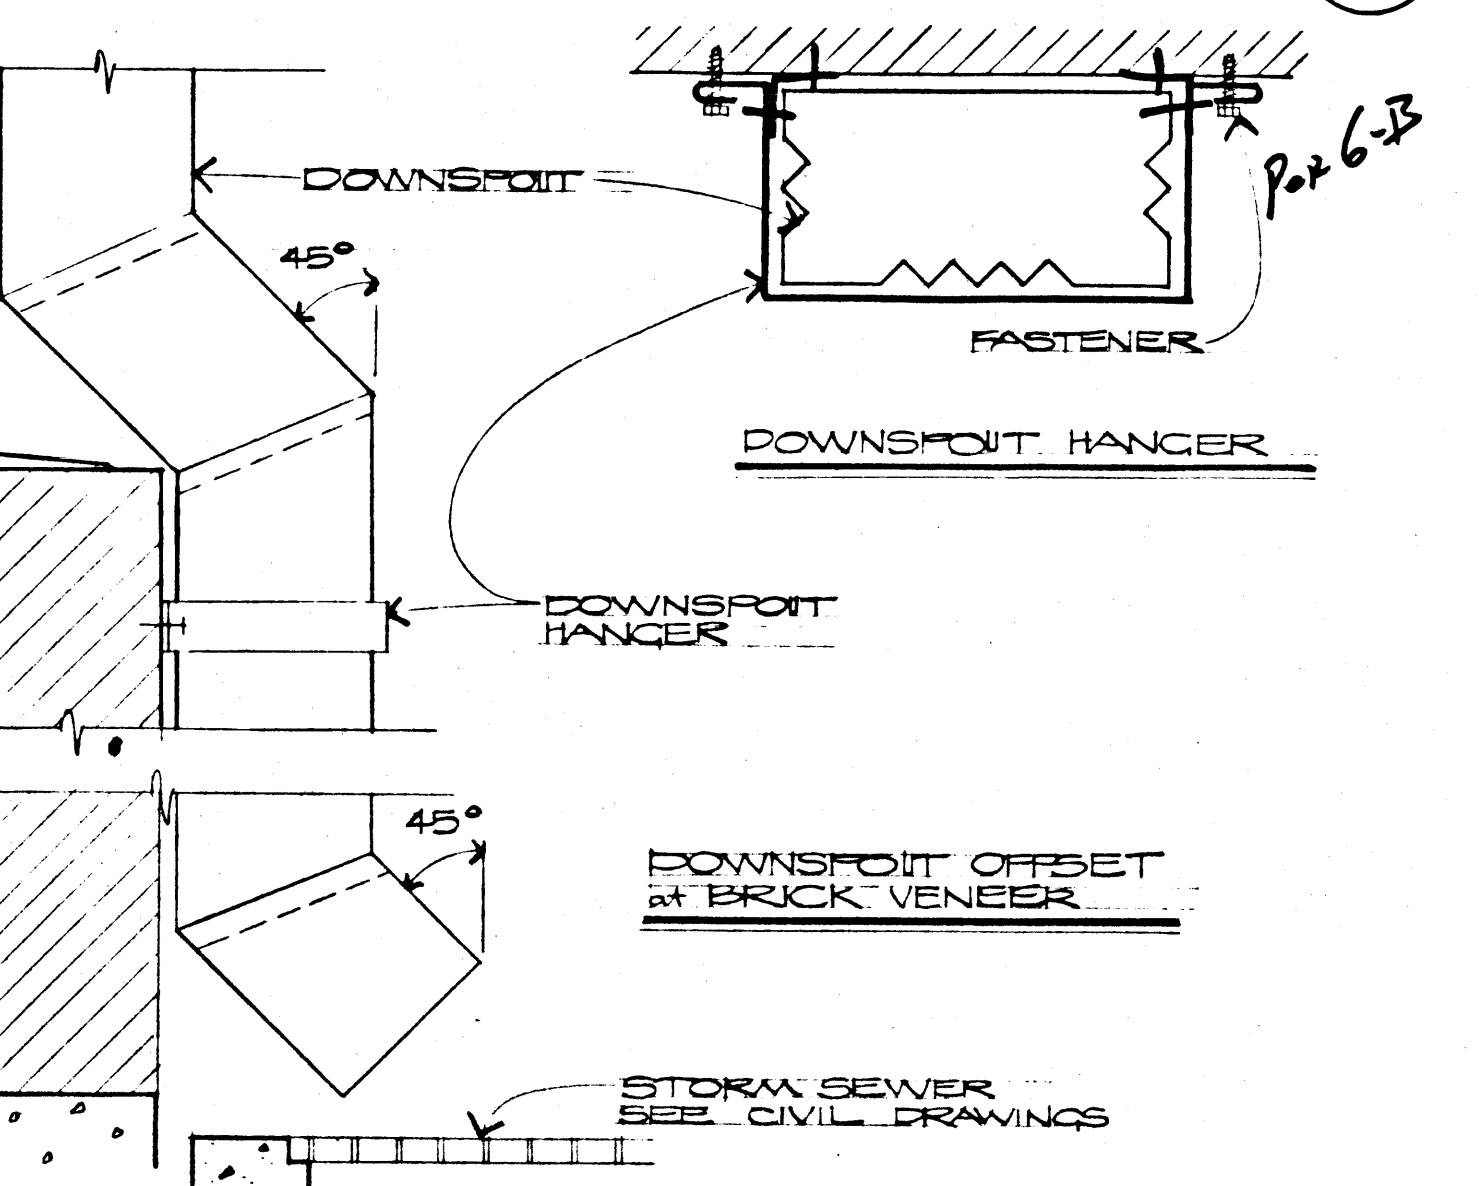


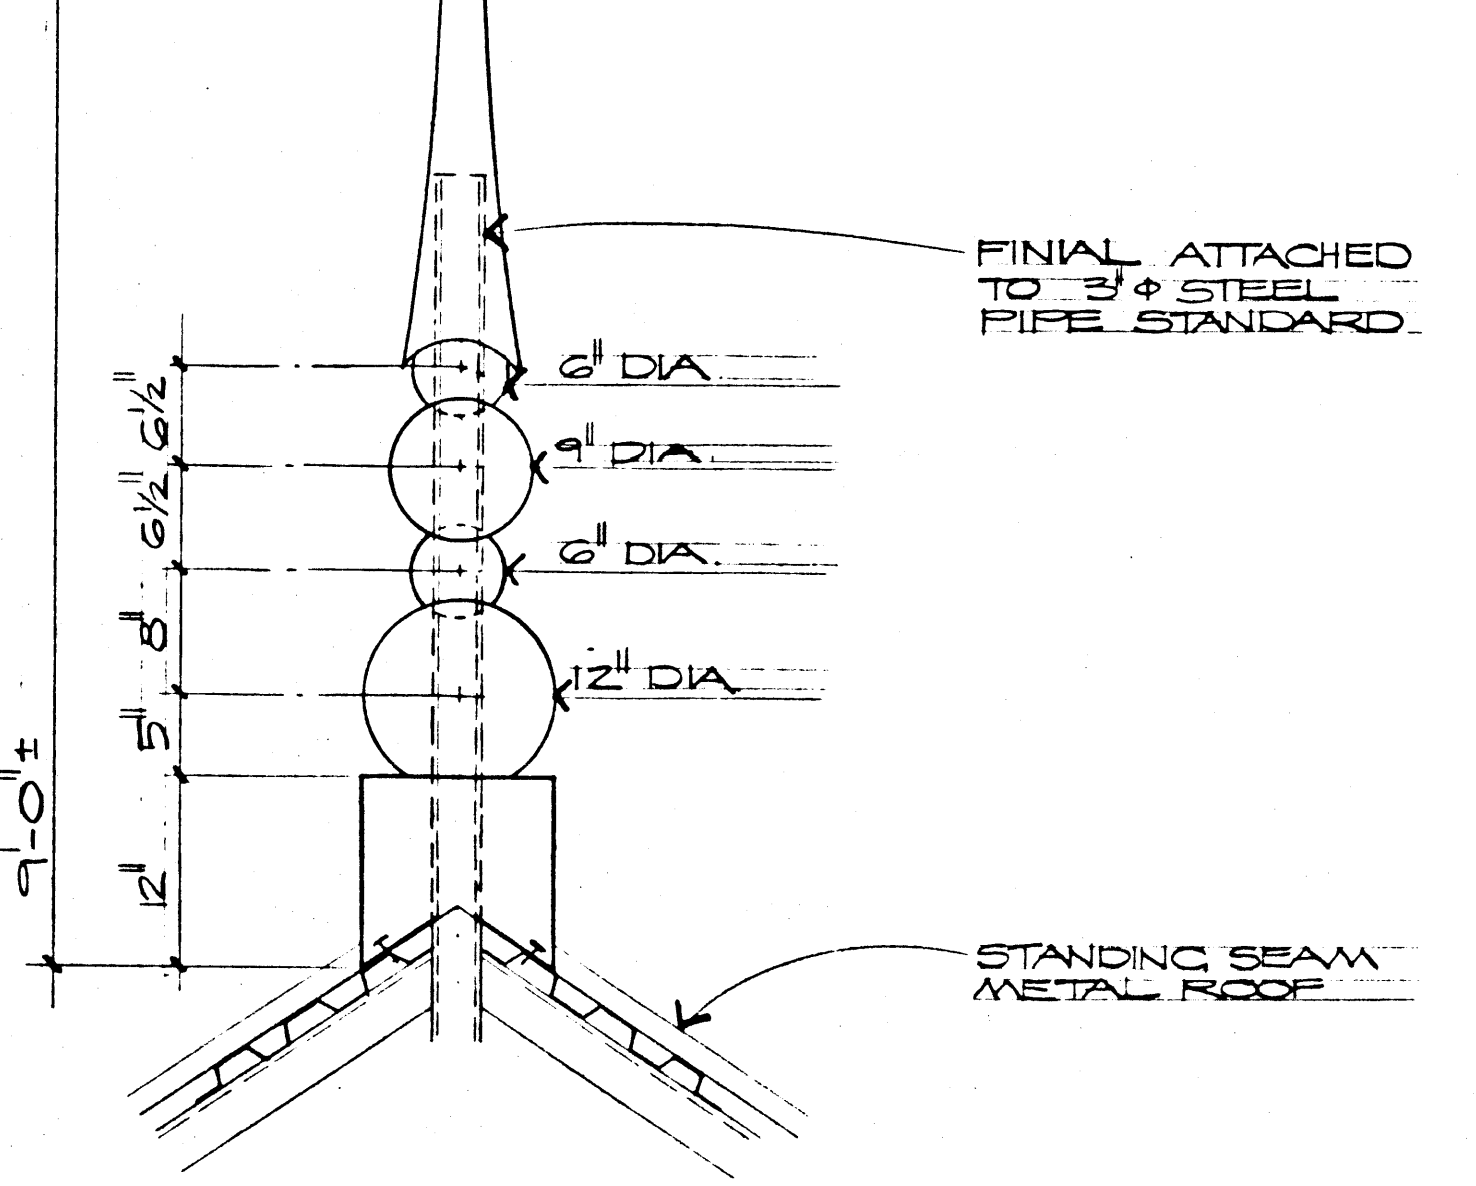


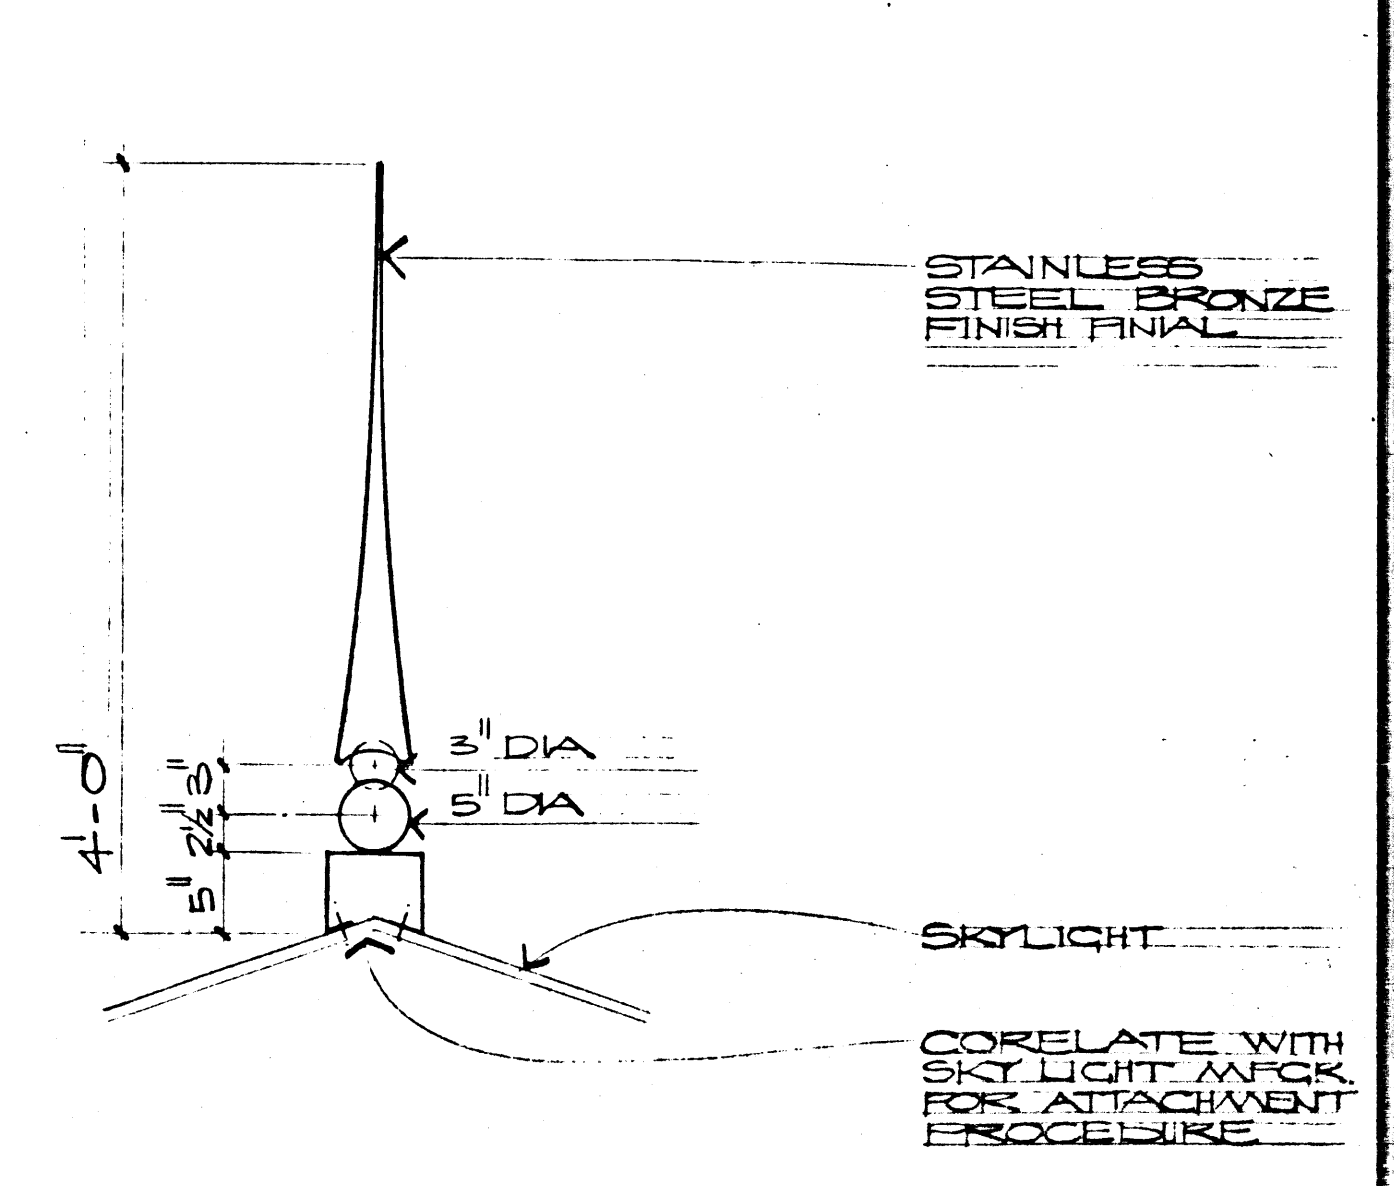


3 DEDUCTIVE BID ITEM #3 (I)
FOR DETAILED DESCRIPTION SEE SPECIFICATIONS

DATE	11-1-82
DRAWN	JK
CHECKED	JK
APP. NO.	2587-1001

DOBRSUKY KITRELL GARLOCK Architects
2555 CALLEJON DE LAS PROBAS, NEVADA 89106 (702) 735-0455

Center Downtown Transportation Las Vegas, Nevada

A-30
39 OF 65
FILE NUMBER 990-21