


**HIGH SOFFIT PLAN**


SCALE 1/8" = 1'-0"

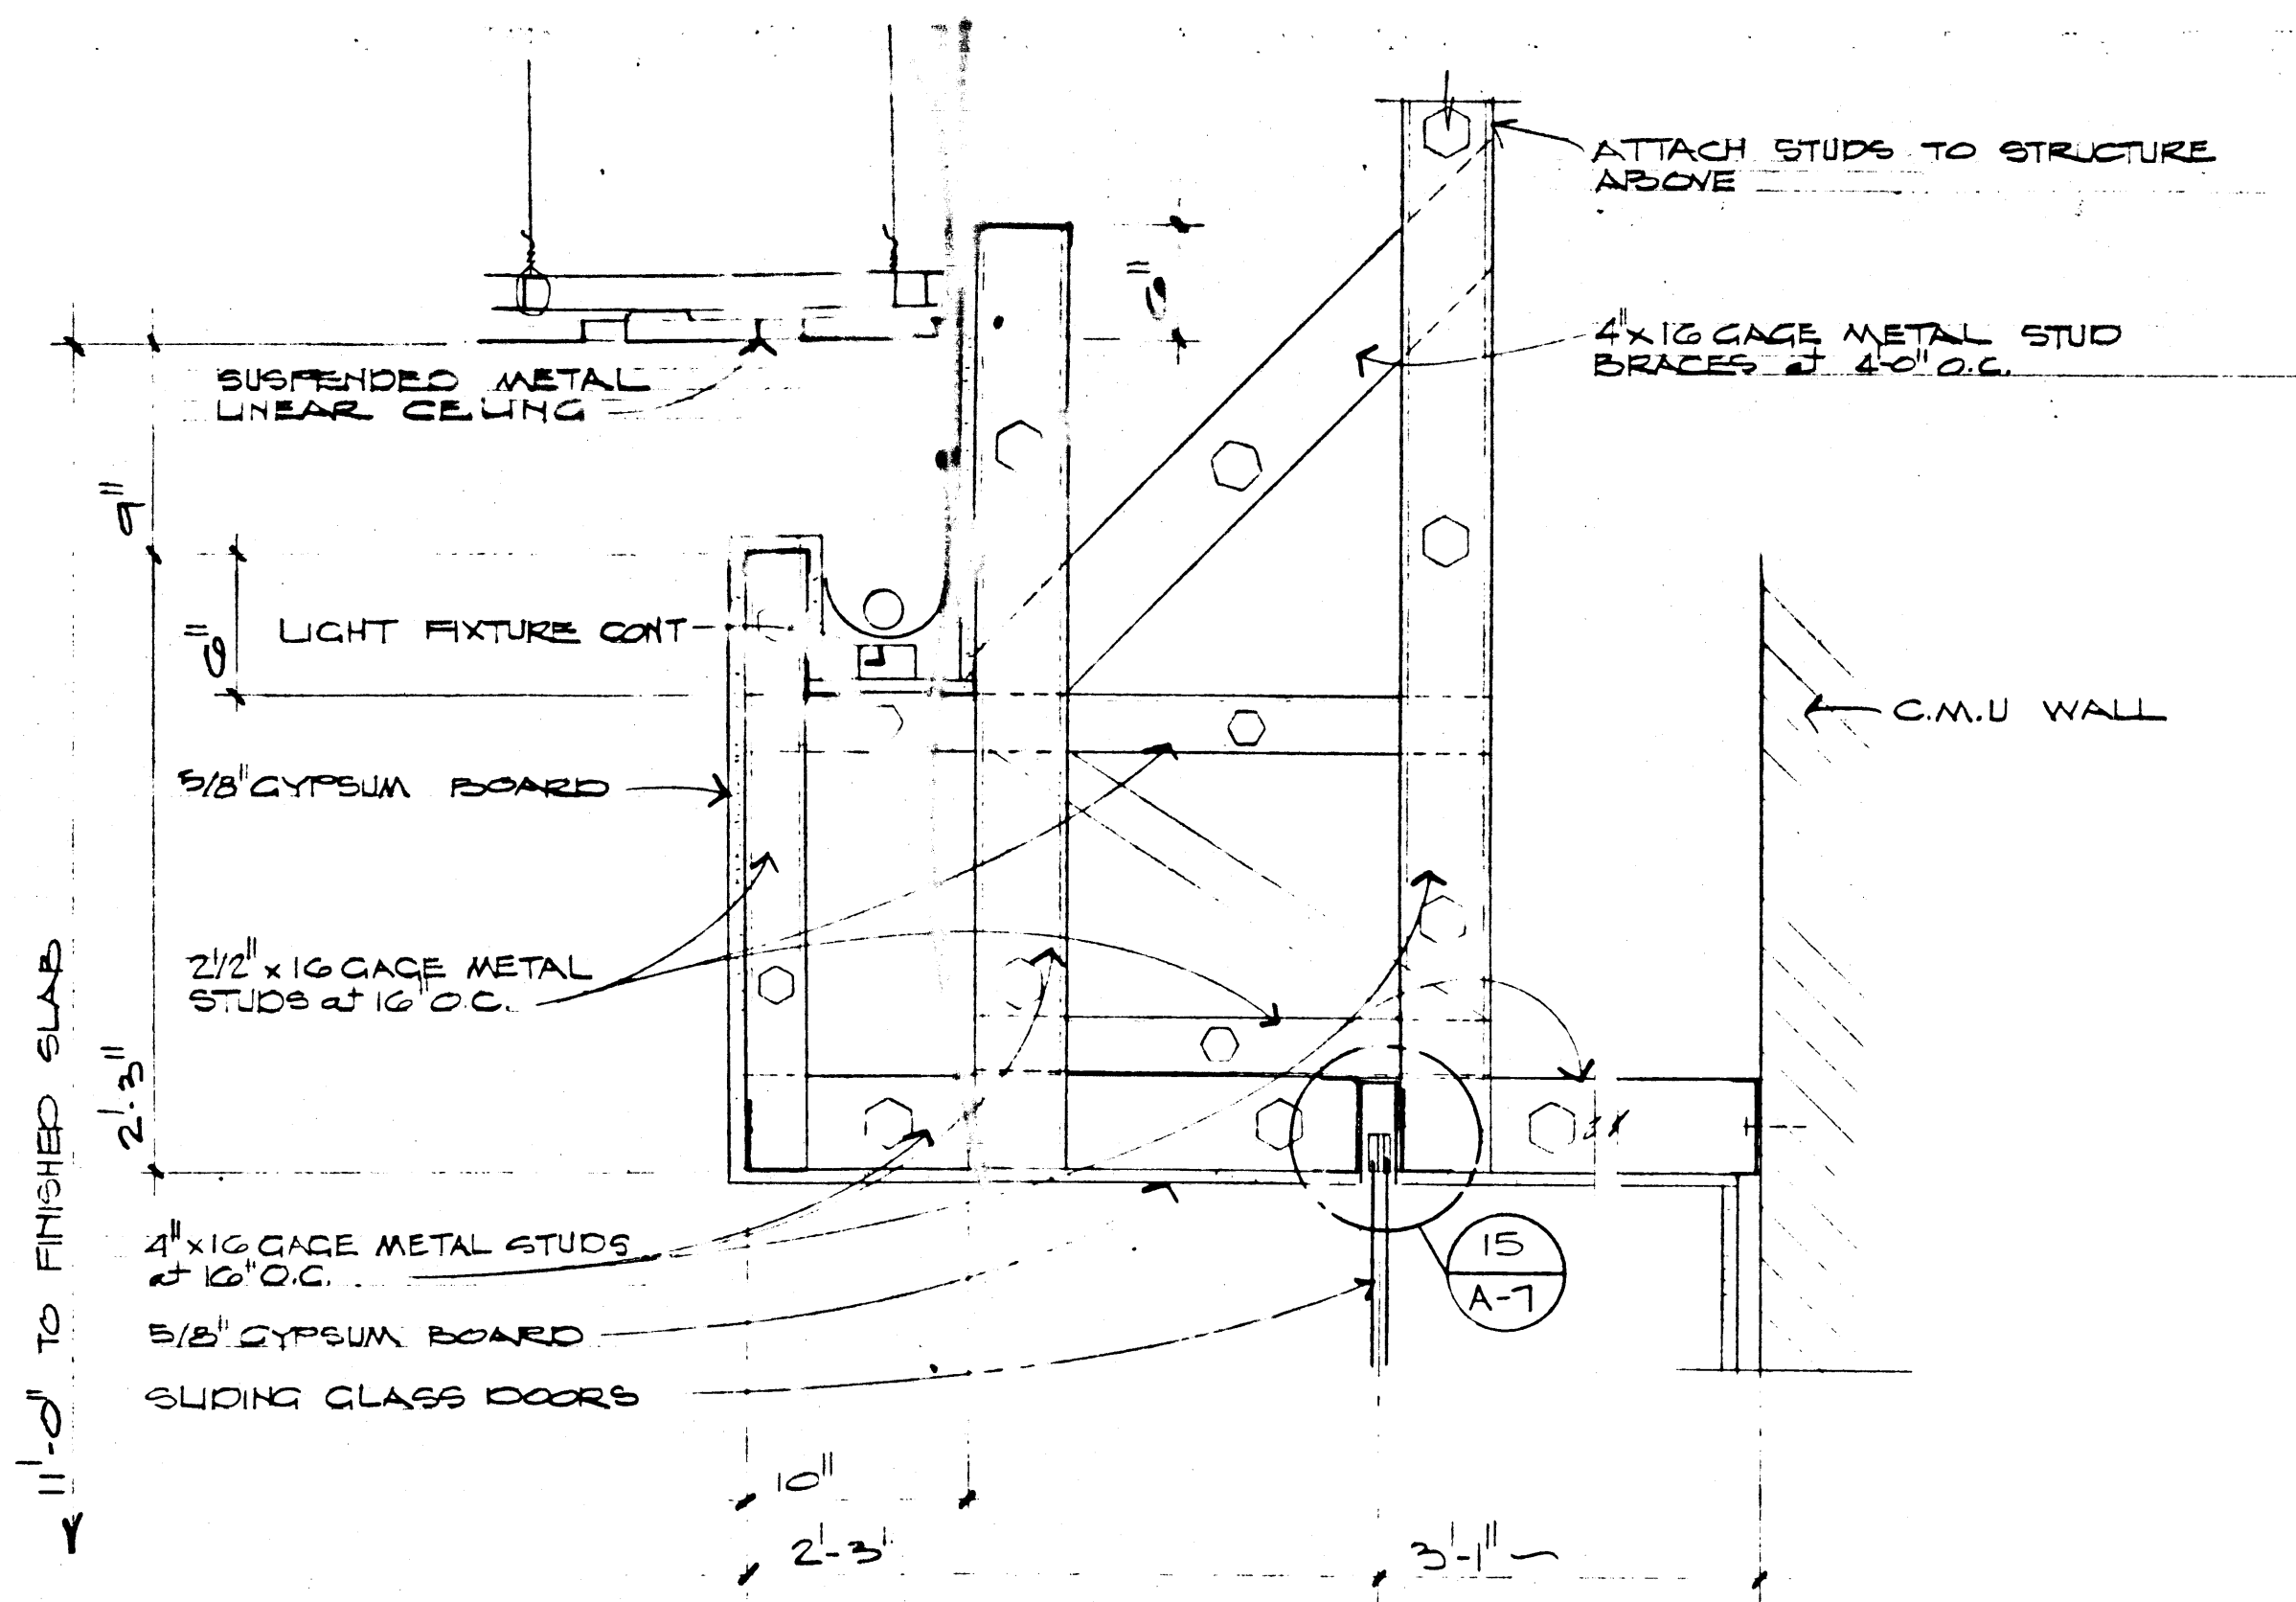

**DETAIL**

SCALE 1 1/2" = 1'-0"


1  
A-32

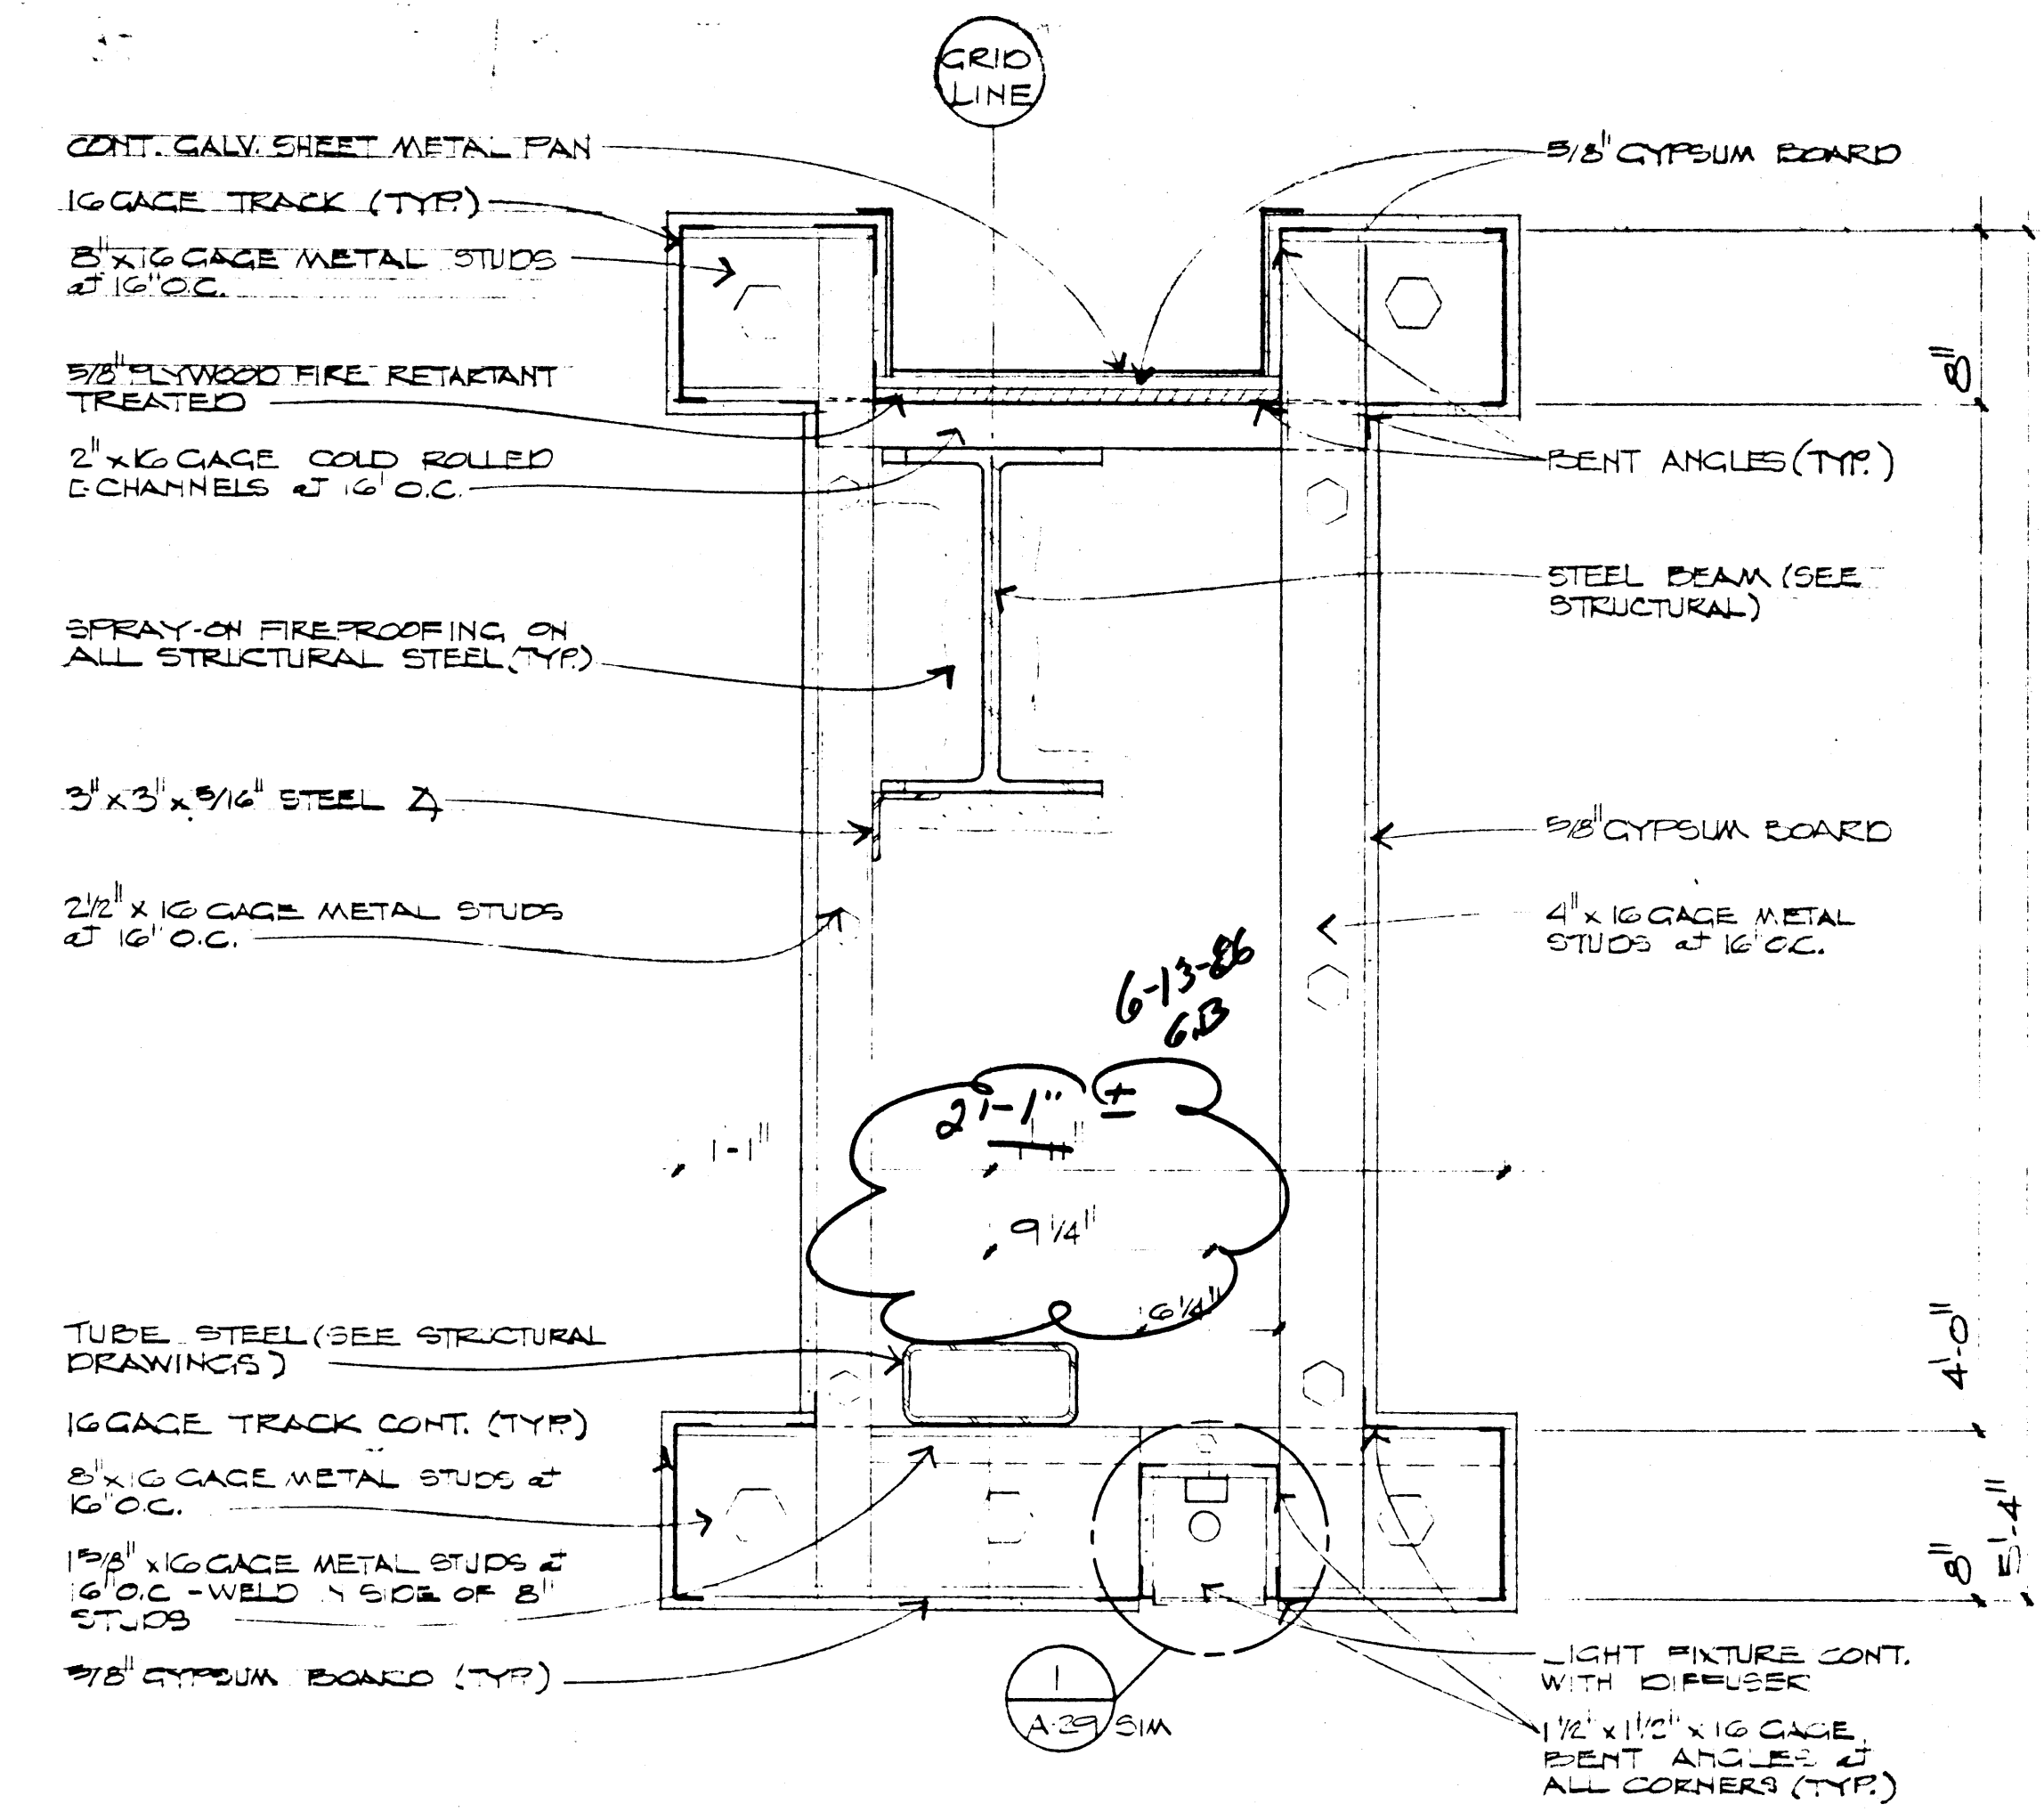

**DETAIL**

SCALE 1 1/2" = 1'-0"

2  
A-32

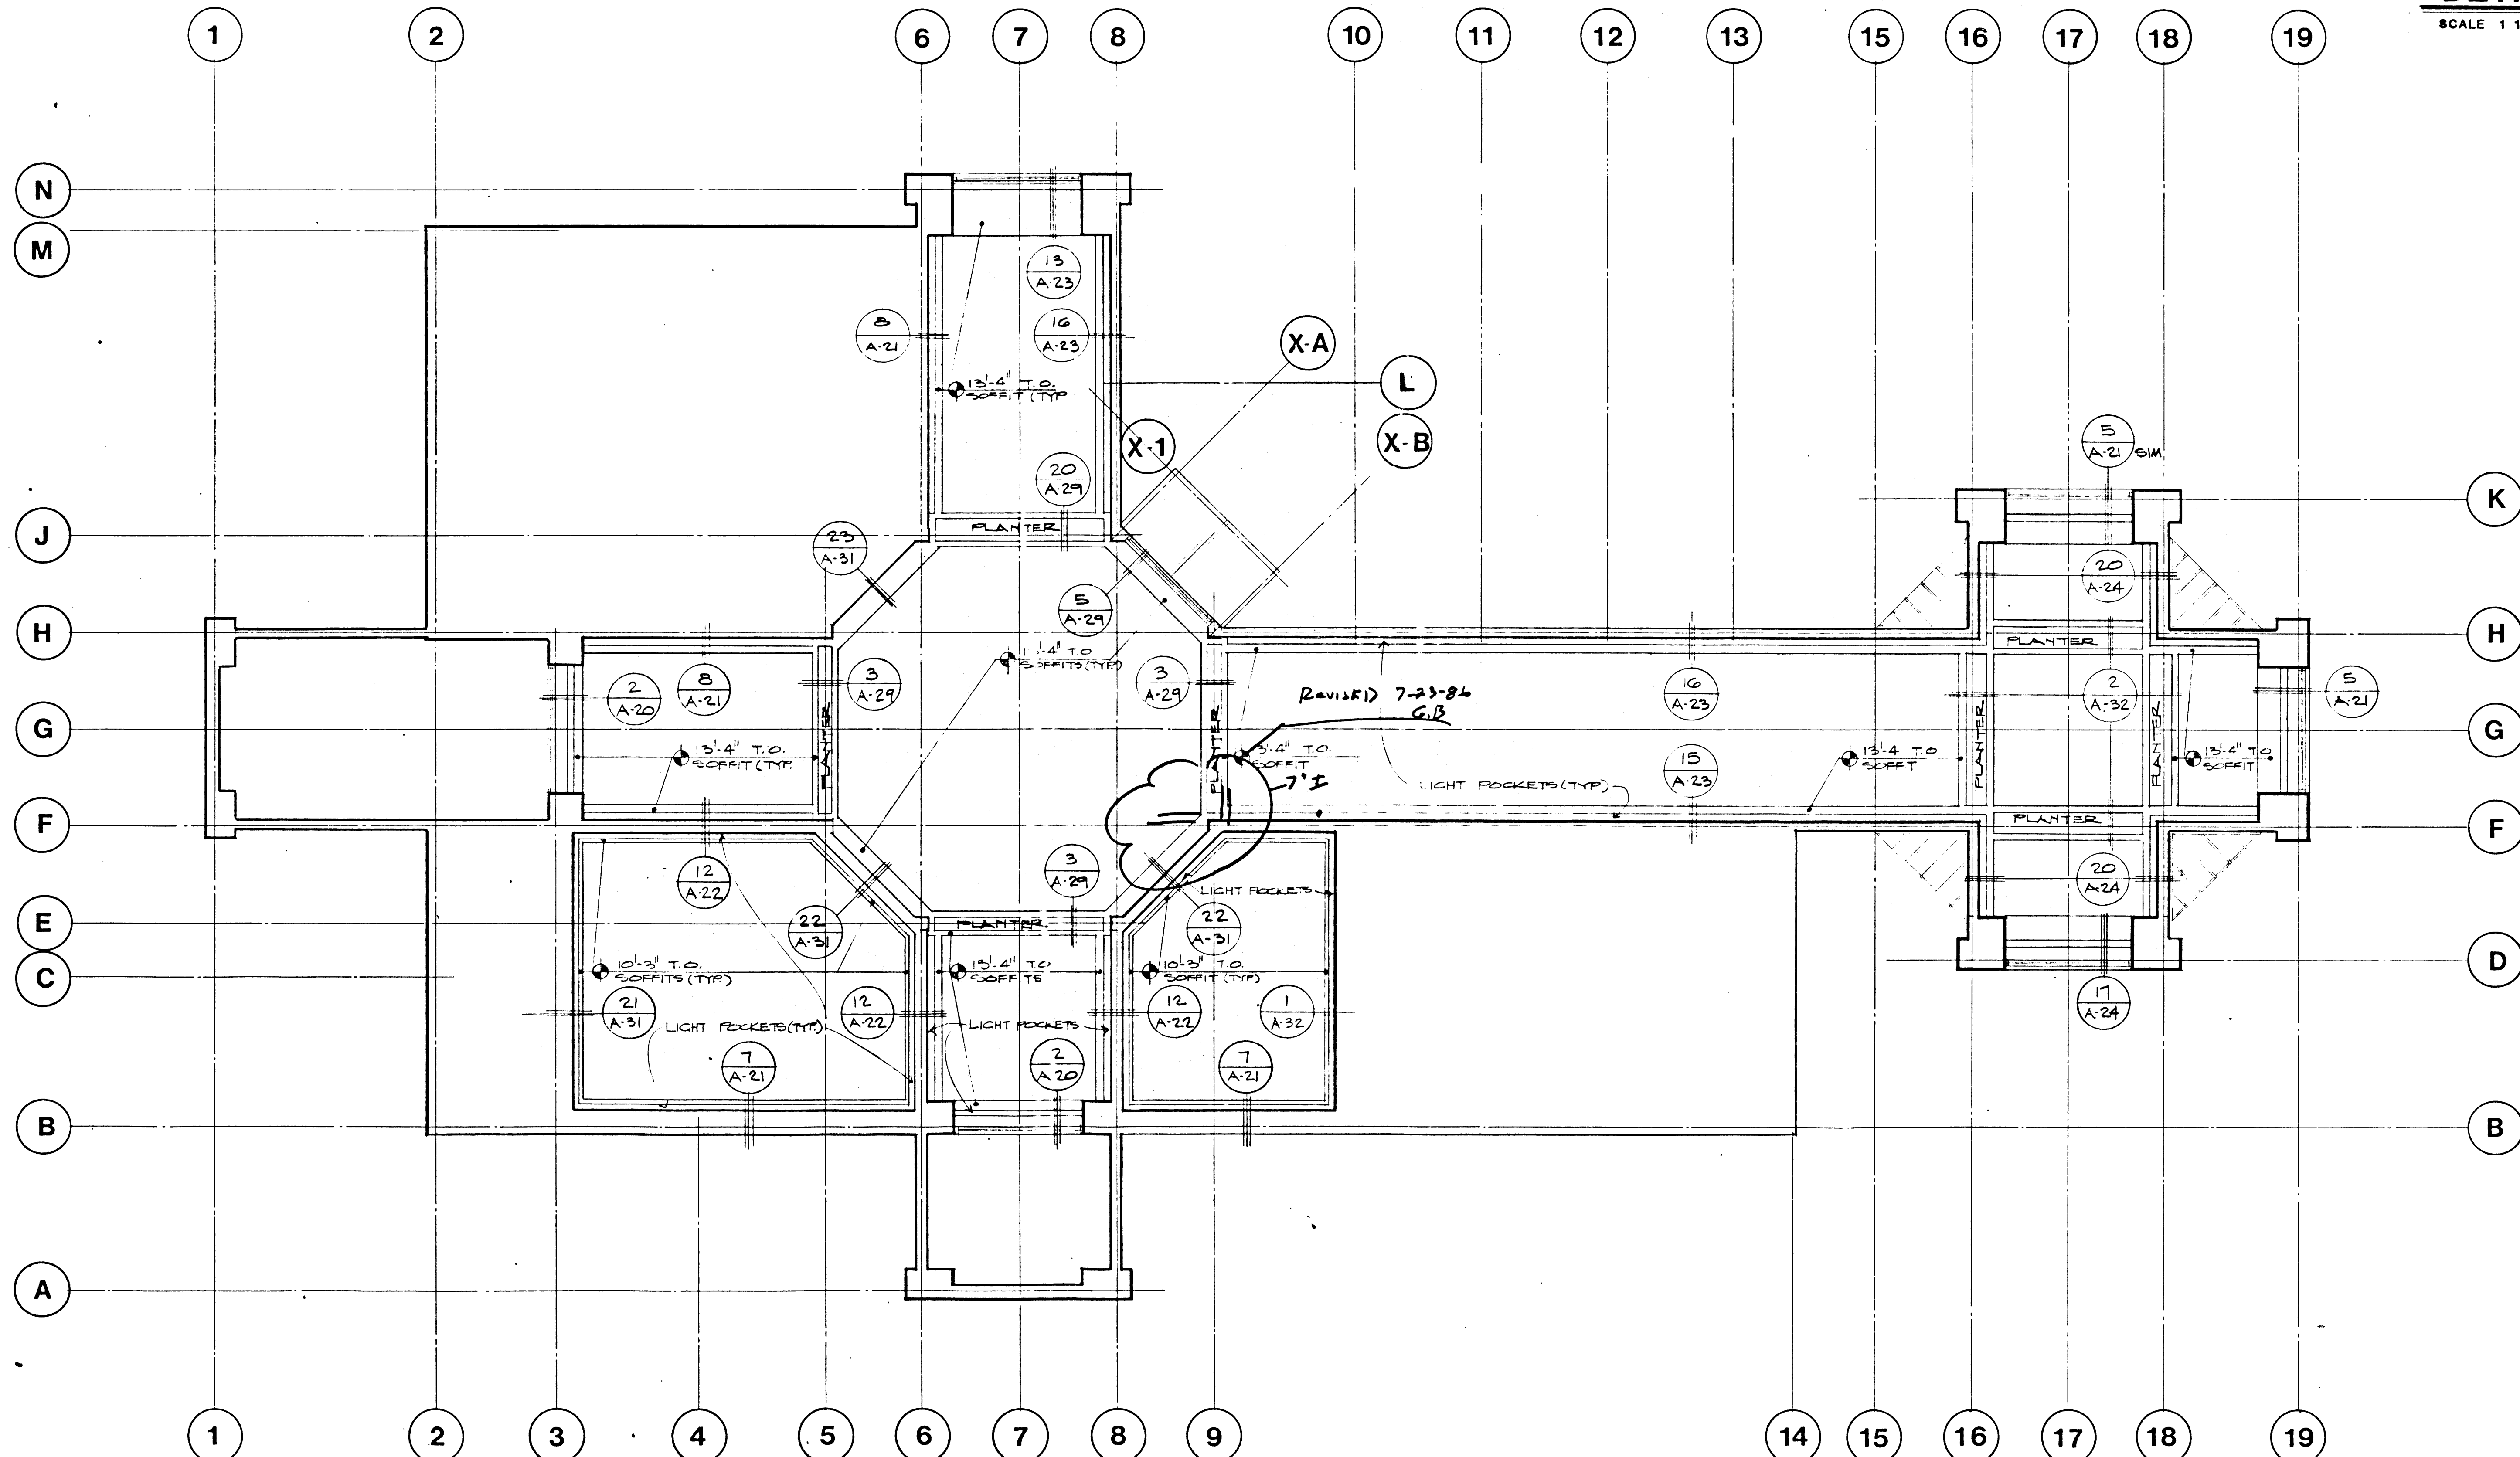


**UPPER SOFFIT PLAN**

SCALE 1/8" = 1'-0"



DATE	12-11-85
DRAWN	JKS
CHECKED	JKS
DATE	12-11-85

**DOBUSIKY KITRELL GARLOCK**  
aia  
Architects  
3333 CALVERTIDE ST., LAS VEGAS, NEVADA 89108  
(702) 733-0433

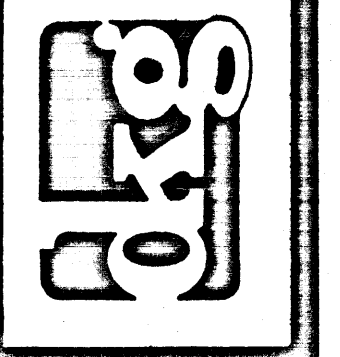

City of Las Vegas  
**Transportation Center**  
Las Vegas, Nevada

SHEET	<b>A-32</b>
OF	41
DATE	4/2/85
FILE NUMBER	20-027