
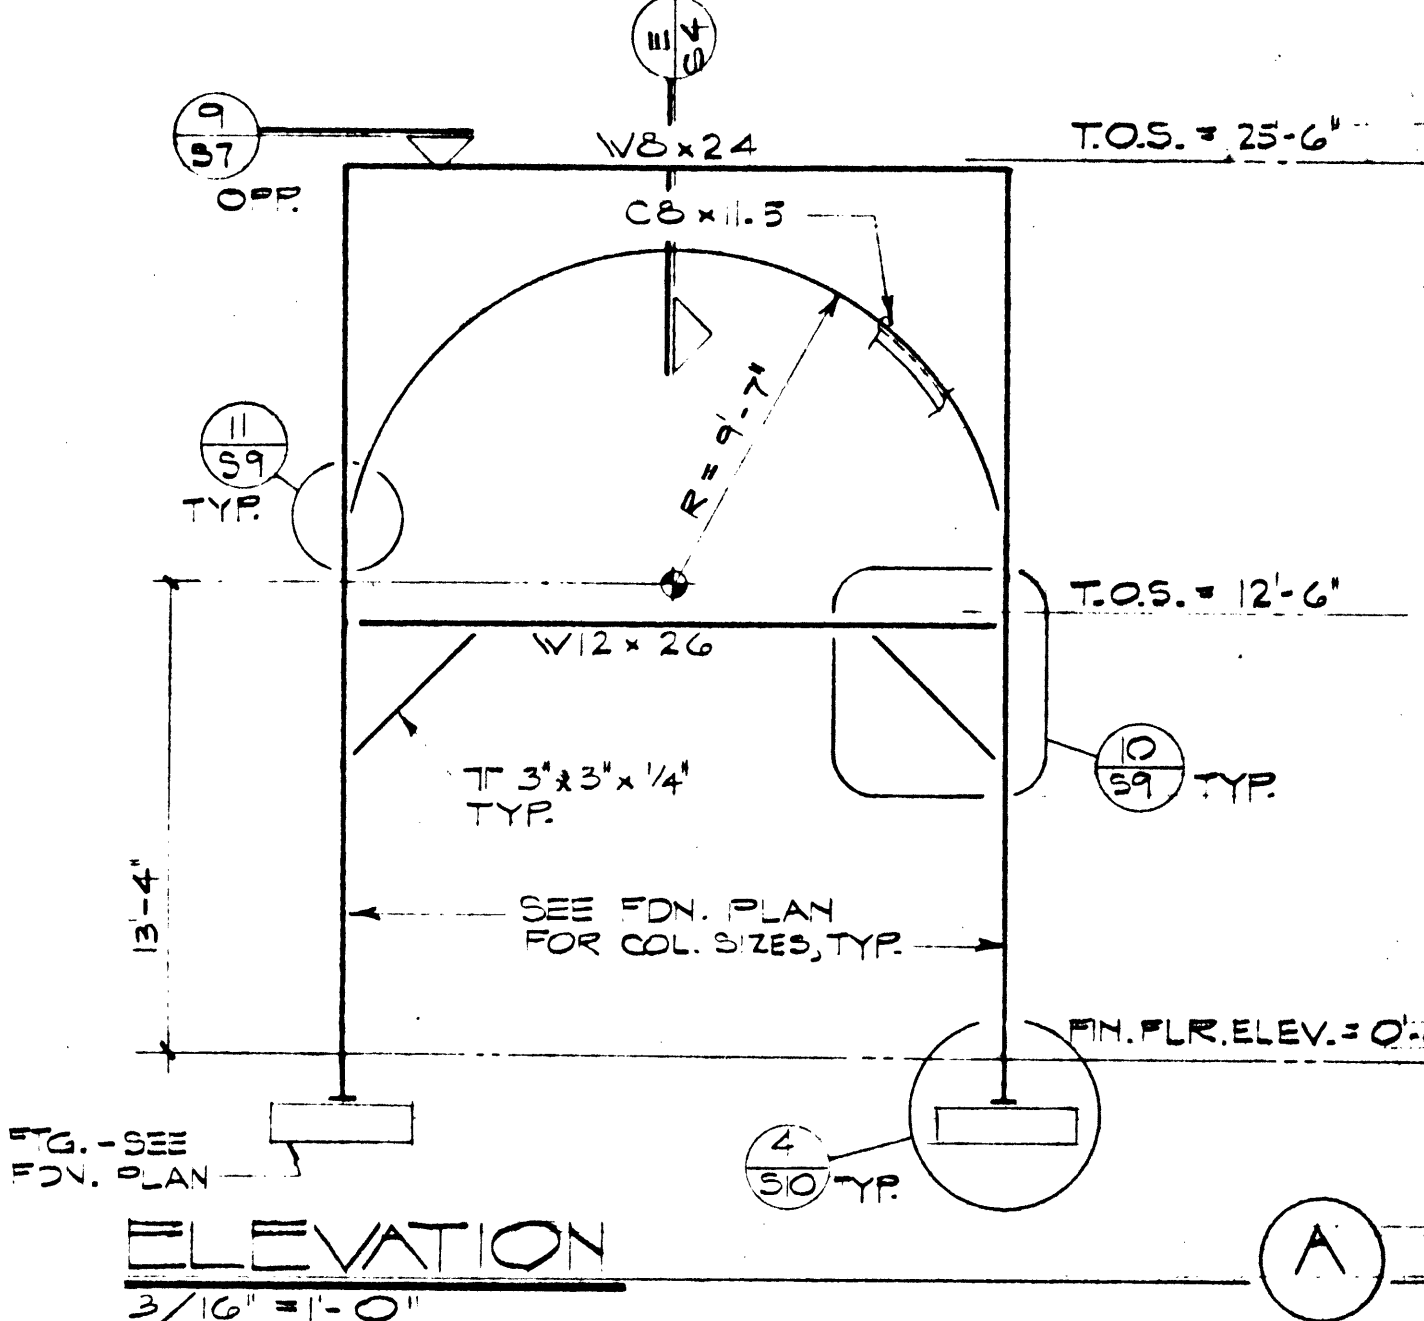
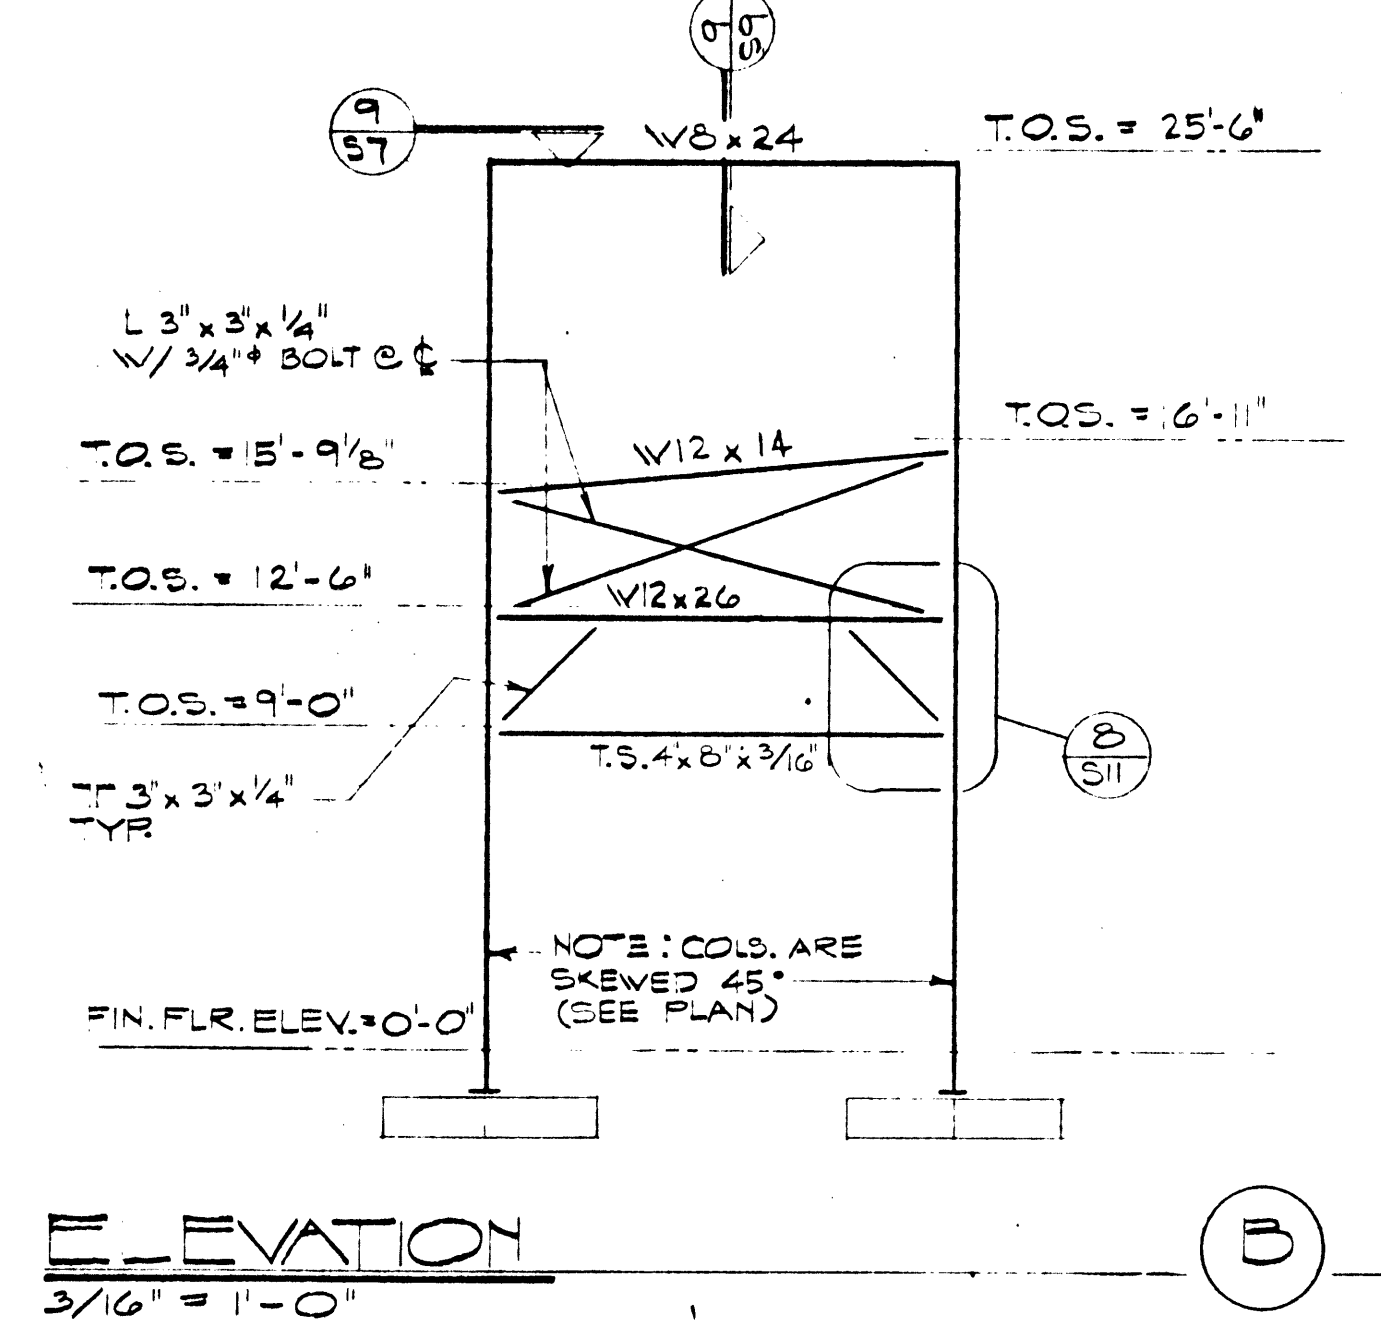
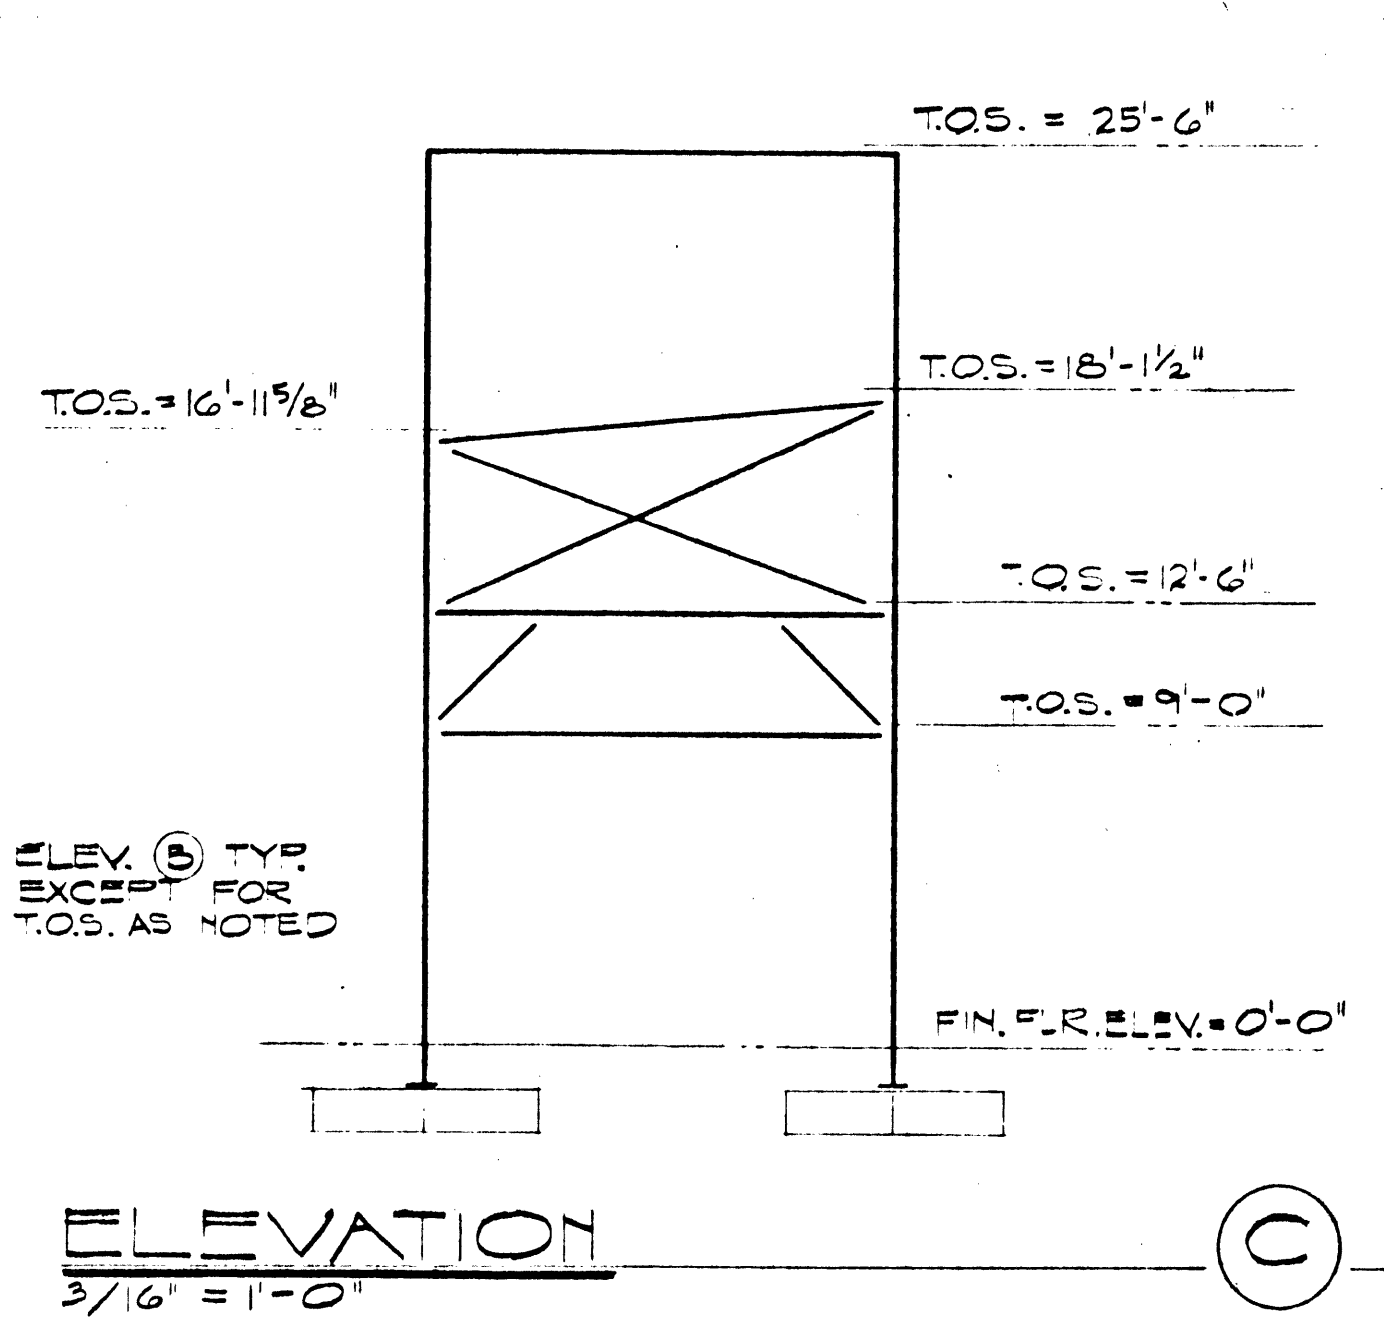
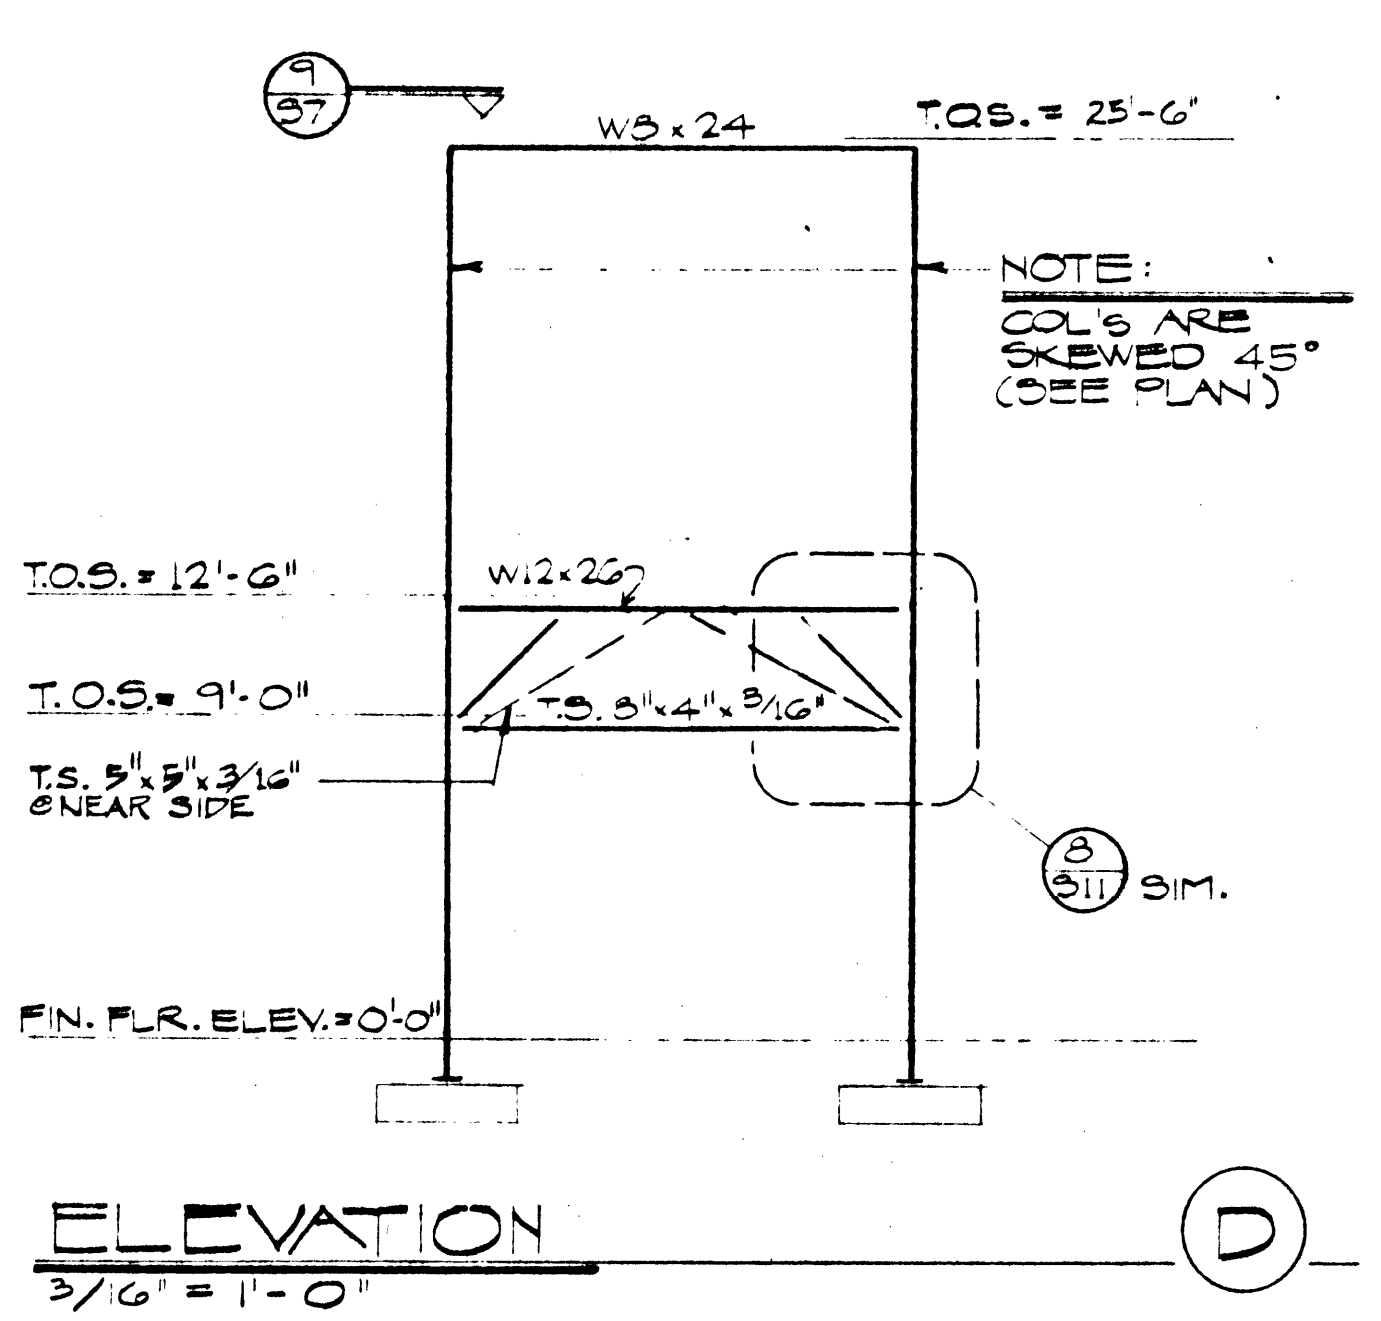





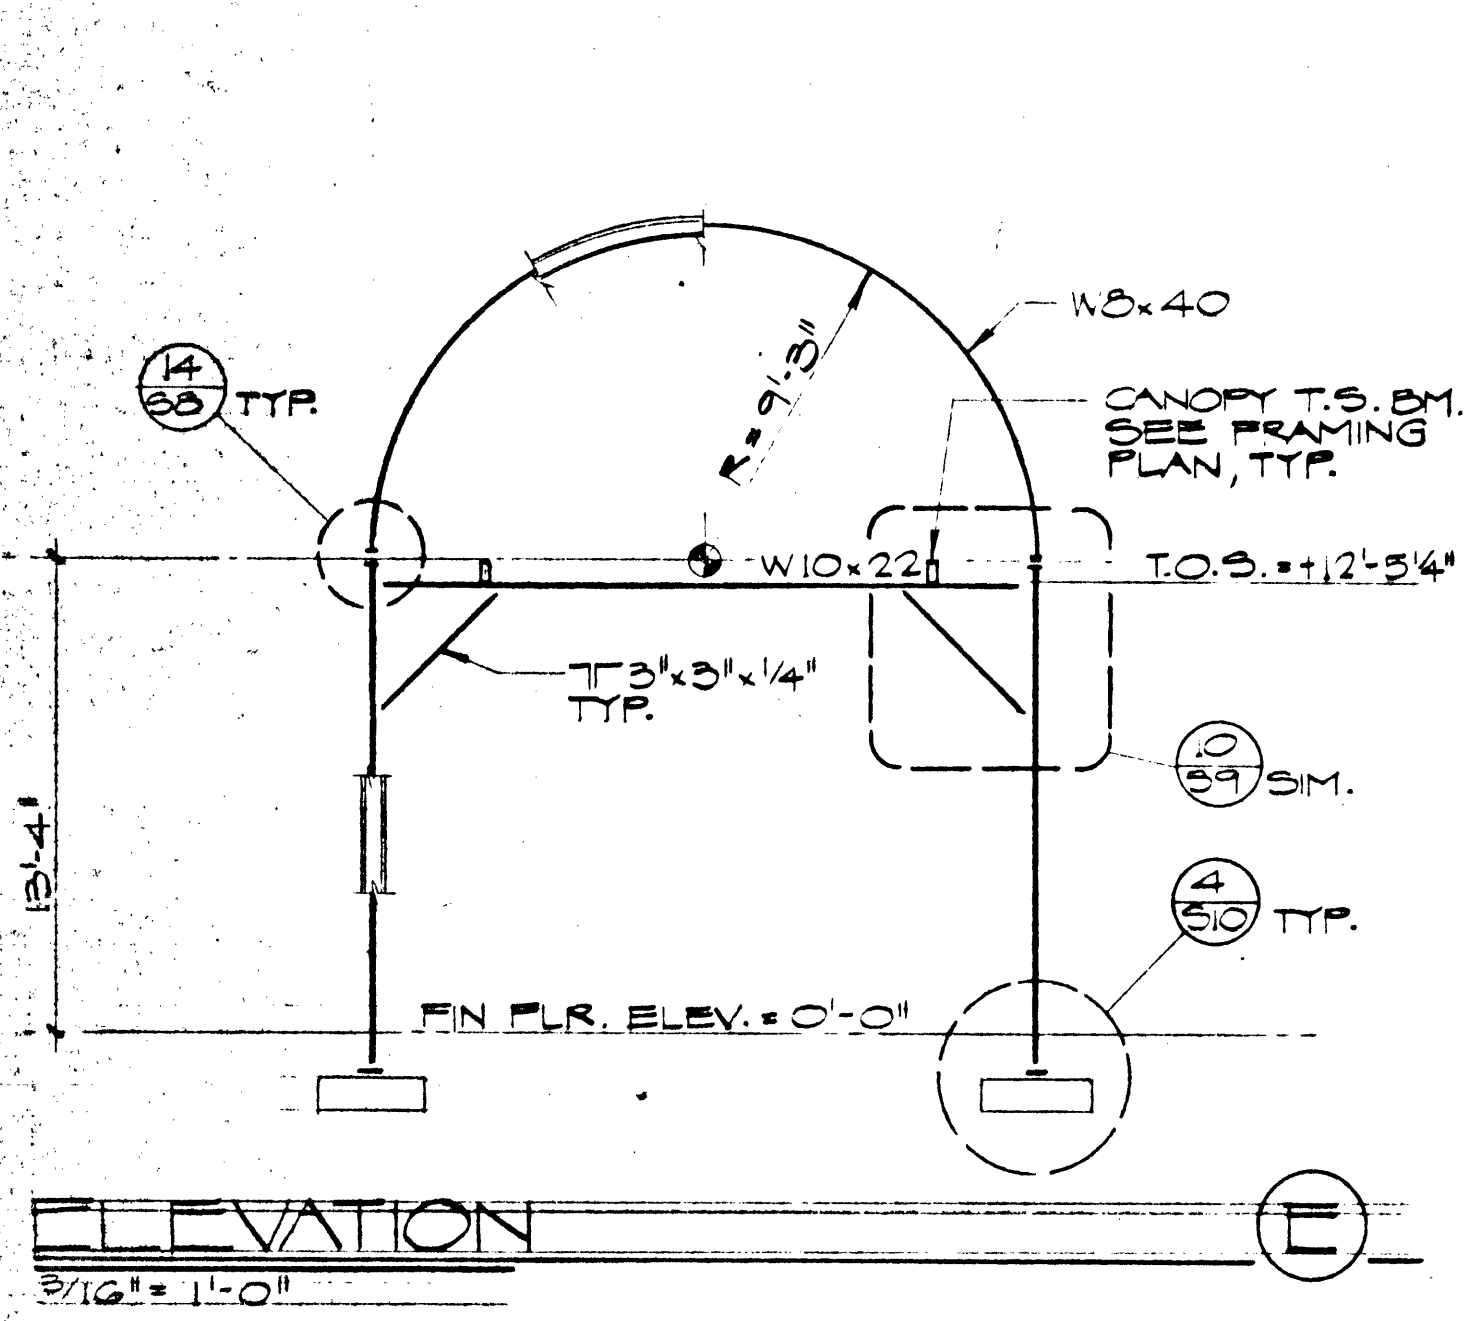








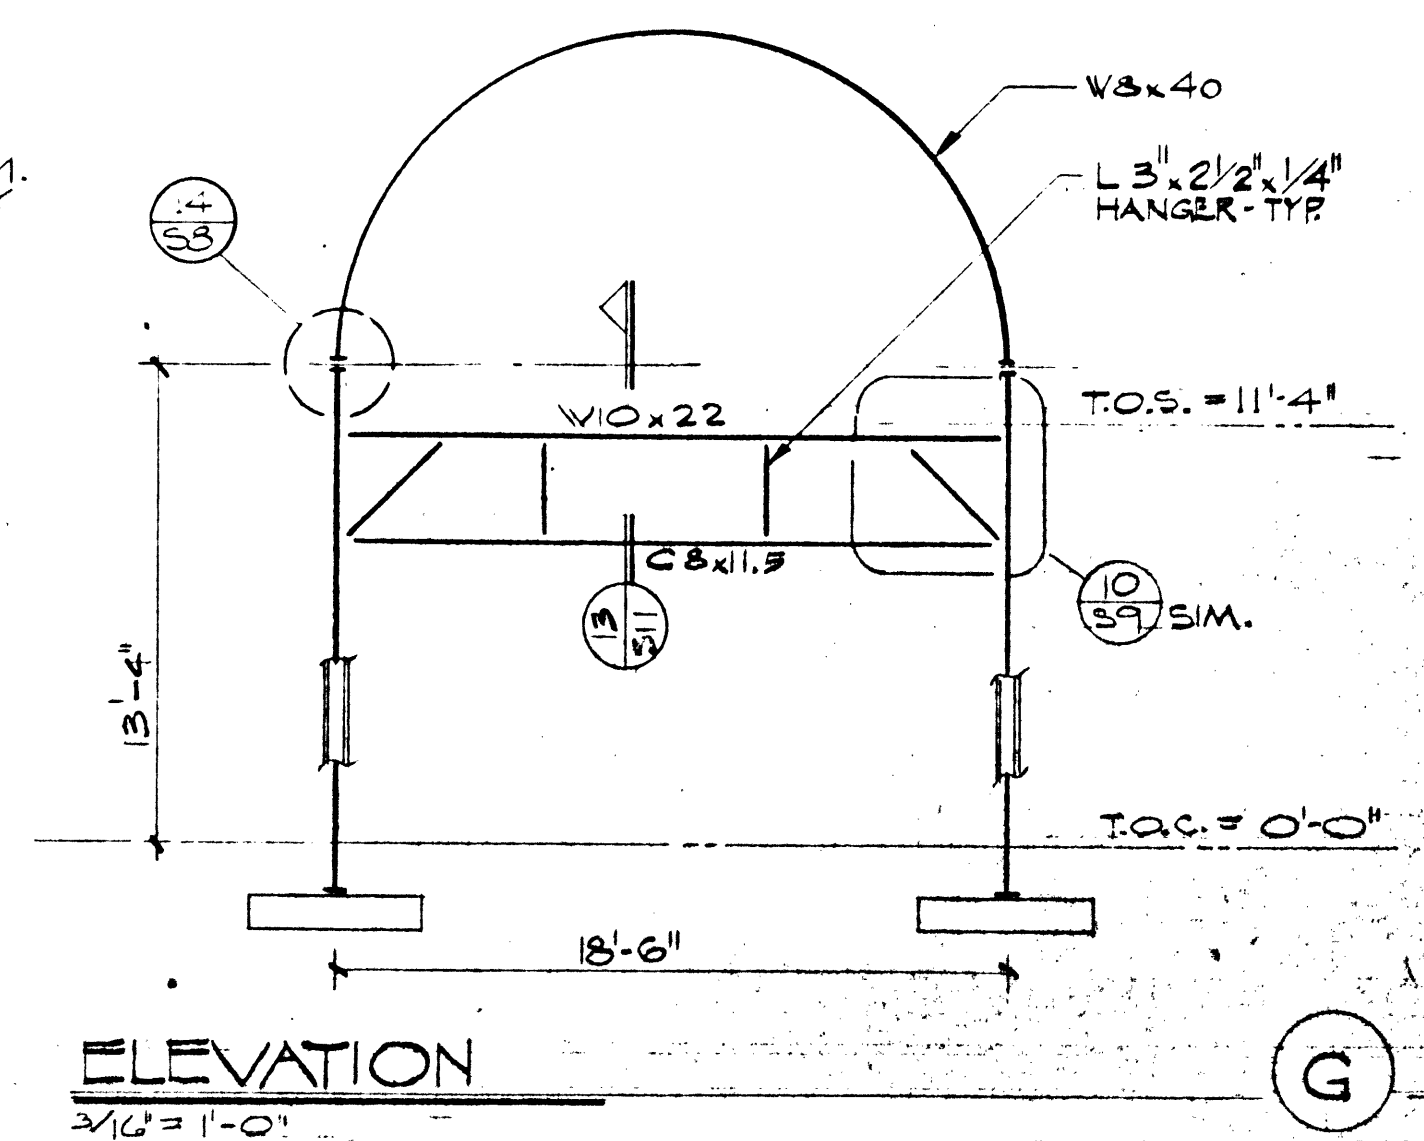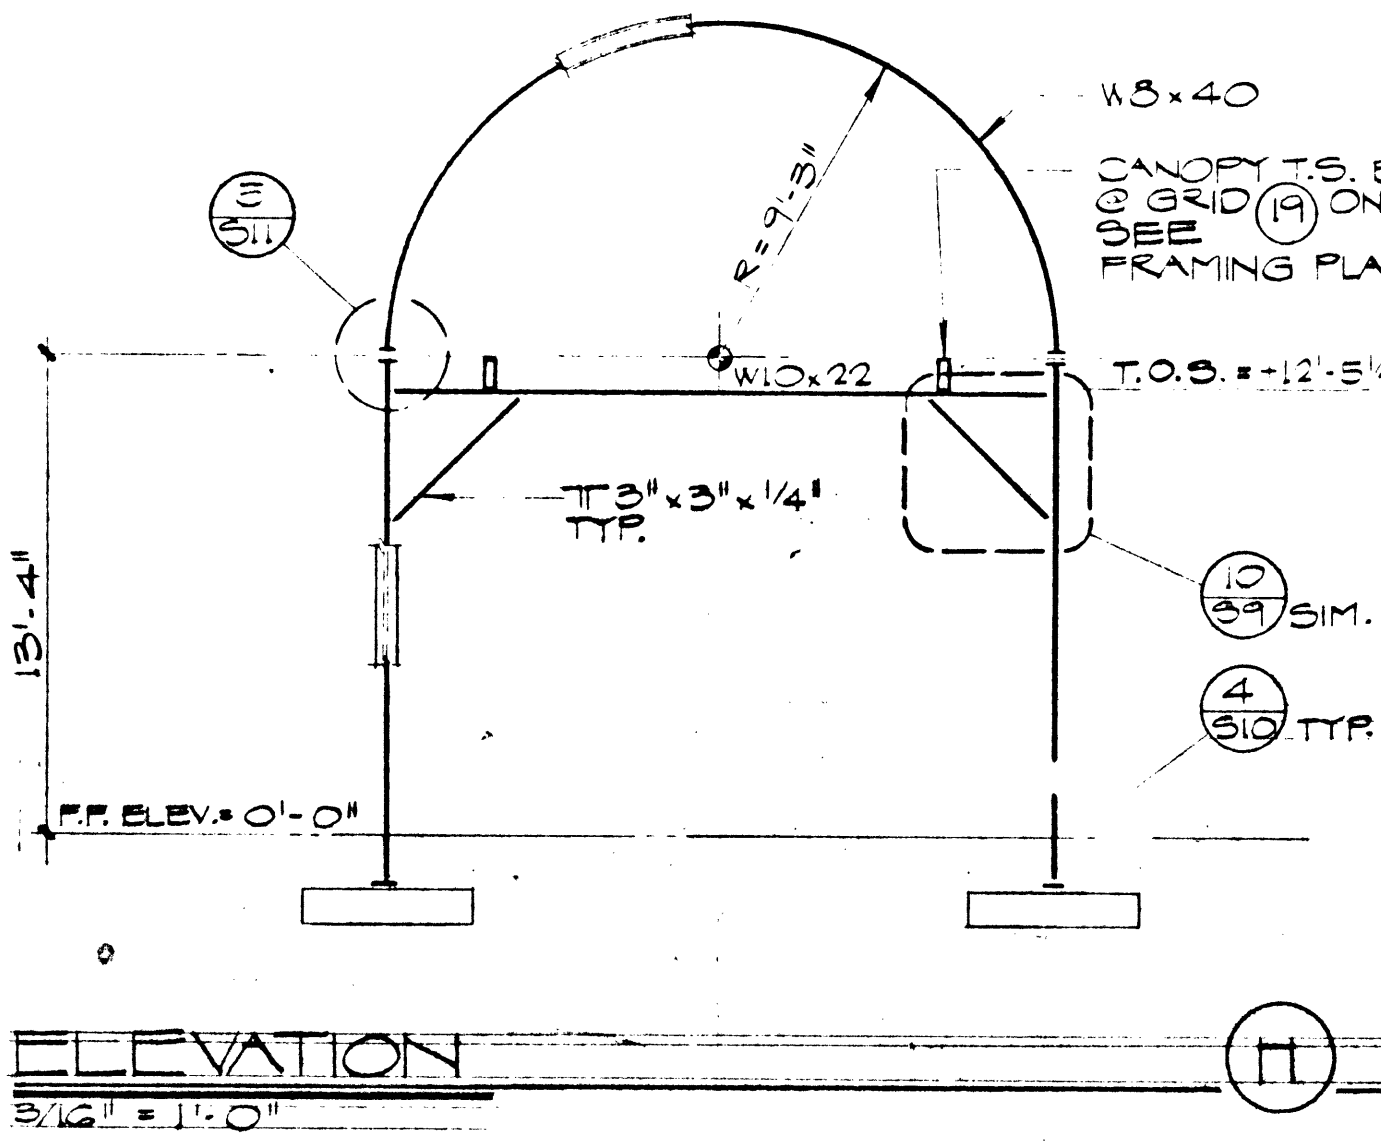






11-15-85 ADDENDUM

GUNNY, BRIZENDINE & POGGEMEYER
ENGINEERS
PLANNERS
ARCHITECTS

DOHRUSKY KITTRELL GARLOCK
Architects

City of Las Vegas
Transportation
Center
Las Vegas, Nevada

S-4
OF 46 OF 65
FILE NUMBER: 59021