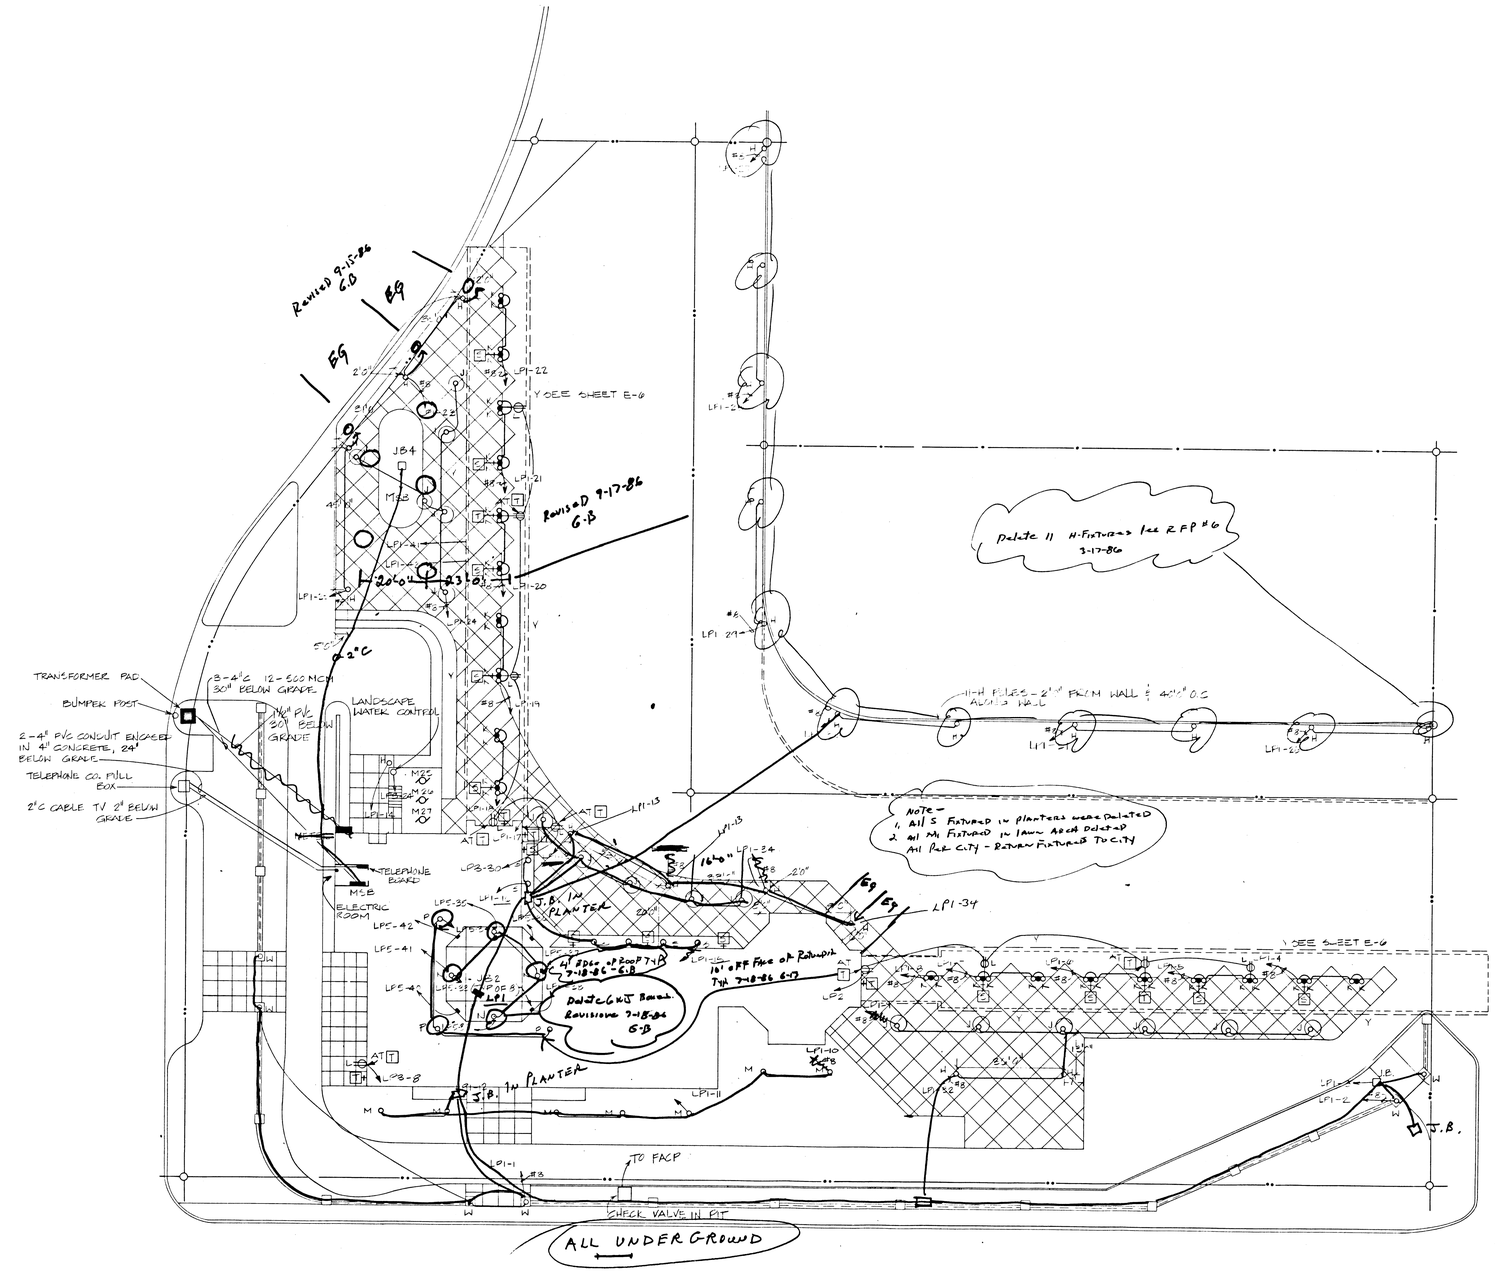

EXTERIOR LIGHTING & SERVICES PLAN

SCALE: 1" = 20'-0"

NORTH

DUNHAM ASSOCIATES INC
CONSULTING ENGINEERS
1111 E. FLAMINGO ROAD LAS VEGAS, NEVADA 89109 TELEPHONE 702 369 7911

DATE	
DRAWN	7-17-86
CHECKED	

DOBRUSKY KITTRELL GARLOCK aia Architects
3538 CAMBRIDGE ST. LAS VEGAS, NEVADA 89109 (702) 732-0433

City of Las Vegas Transportation Center
Downtown Las Vegas, Nevada

SHEET E-1
OF 10 11 12 13
FILE NUMBER 290-2ut

Pelican Print • 1819 FREEMAN DRAFTING PLUS