


SURVEYOR'S CERTIFICATE

I, RALPH E. WATSON, A PROFESSIONAL LAND SURVEYOR, LICENSED IN THE STATE OF NEVADA, AND ACTING IN BEHALF OF MR. MATT McCULLOUGH, SLETTEN CONSTRUCTION, DO HEREBY CERTIFY THAT:


- 1. THIS MAP REPRESENTS THE RESULTS OF A SURVEY CONDUCTED UNDER MY DIRECT SUPERVISION AT THE REQUEST OF THE CITY OF LAS VEGAS, NEVADA.
- 2. THIS PLAT COMPLIES WITH THE APPLICABLE STATE STATUTES AND ANY LOCAL ORDINANCES IN EFFECT ON THE DATE THAT THE SURVEY WAS COMPLETED, AND THE SURVEY WAS CONDUCTED IN ACCORDANCE WITH CHAPTER 625 OF THE NEVADA ADMINISTRATIVE CODE.
- 3. THIS SURVEY WAS PERFORMED AND COMPLETED ON OCTOBER 7, 2013 FOR POST-CONSTRUCTION SANITARY SEWER FINAL LOCATION AND IS NOT A SUBDIVISION.

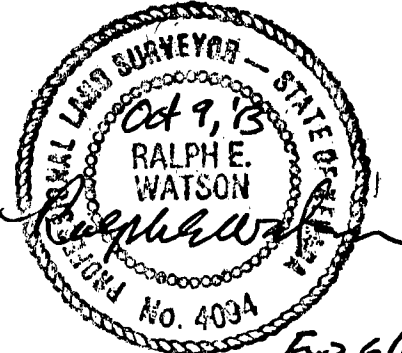

RALPH E. WATSON
PROFESSIONAL LAND SURVEYOR
NEVADA CERTIFICATE NO. 4094

FND ALUM. CAP "PLS 5094"
N626677.4024
E274926.7309
NCRS

BRIDGER AVENUE (PUBLIC)

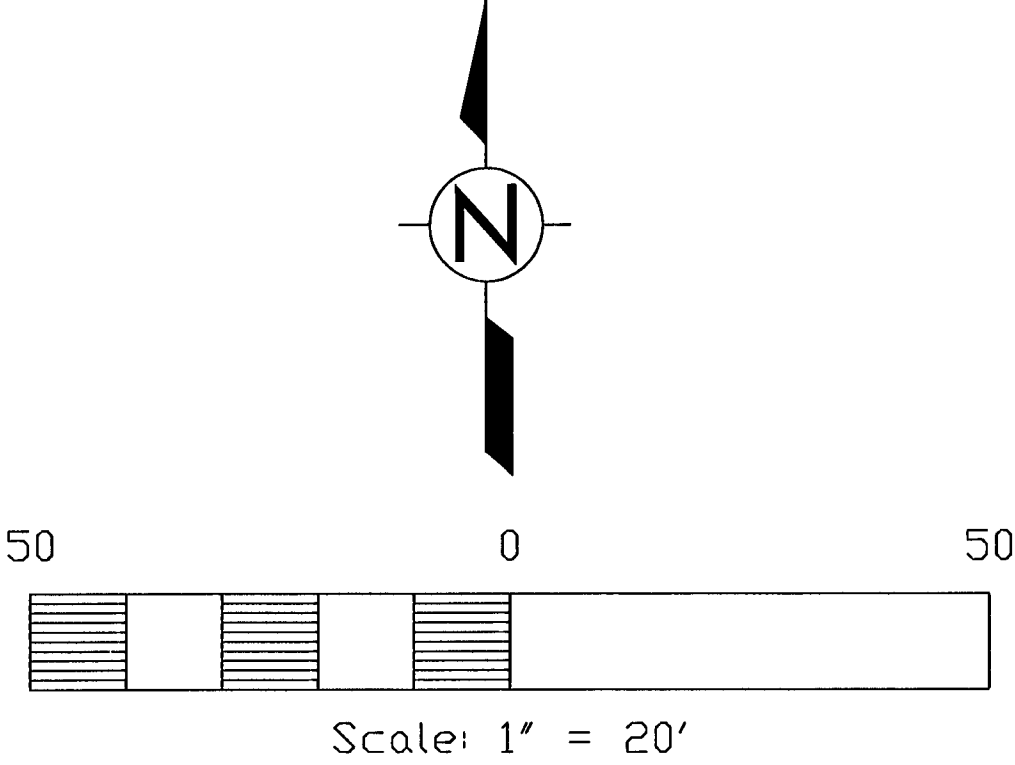

LEGEND

- SEWER LINE (LATERAL)
- EXISTING SAN. SEWER LINE
- STREET CENTERLINE
- EXISTING CURB AND GUTTER
- CENTERLINE MANHOLE - NEW
- CENTERLINE CLEANOUT LID

BASIS OF BEARING

GRID NORTH AS DEFINED BY THE CENTRAL MERIDIAN OF THE NEVADA COORDINATE REFERENCE SYSTEM (NCRS), LAS VEGAS AND LAS VEGAS HIGH ELEVATION ZONES, NORTH AMERICAN DATUM OF 1983 (NAD83); SAID MERIDIAN BEING COINCIDENT WITH 114°58' WEST OF THE GREENWICH MERIDIAN.

BENCH MARK

BENCH MARK 1LV0134NW6 LOCATED AT THE S.E. CORNER OF MAIN AND BRIDGER IS A 3" NDOT BRASS CAP IN TOP OF CURB. ELEVATION (METERS) 617.329, ELEVATION (FEET) 2025.35, NAVD88, 2008 ADJUSTMENT.

COORDINATES

NEVADA COORDINATE REFERENCE SYSTEM (NCRS); LAS VEGAS ZONE; NAD83(2011) EPOCH 2010.0; HORIZONTAL AND VERTICAL POSITIONAL CERTAINTY OF 0.3 FT.

1 ST. STREET (PUBLIC)

N 60°45' 19.93"
E 2°18' 14.828"

SSMH (NEW)
RIM = 22.28 (CENTER)
12" INV. (THRU) 09.45
10" INV. IN (E.) 09.62
CENTERLINE MANHOLE

SSCO - 0.92' DIA. LID
RIM = 22.64
INV. = 11.04 +/-
N626436.4411
E274852.1859

10" S.S.

EXISTING 12" P.C.S.S.

ROW LINE

CLARK COUNTY
DETENTION CENTER

LEWIS AVENUE (PUBLIC)

FND ALUM. CAP "SLIGAR"
N626253.6095
E274701.0371
NCRS

CLV DRAWING NO. 107V5765
HANSEN NO. 45496

Sanitary Sewer Final Location
Map
for
City of Las Vegas
Dept. of Public Works

107V5765

REVISIONS	BY

PROJECT NAME

SANITARY SEWER FINAL LOCATION MAP

SHEET NAME

CCDC NORTH TOWER RENOVATION

WATSON ENGINEERING COMPANY, INC.

580 NORTH MAIN STREET
CEDAR CITY, UTAH 84721
TEL. (435) 586-3004 FAX (435) 586-7480
www.wecinc.com

DRAWN BY: R.E.W.
CHECKED BY: R.E. WATSON
DATE: 10/08/13
SCALE: 1" = 20'
WEC PROJECT No.: DS 109/06/13
FILE: C:\SLETTEN\CONST\SEWER.dwg
SHEET
1 of 1