
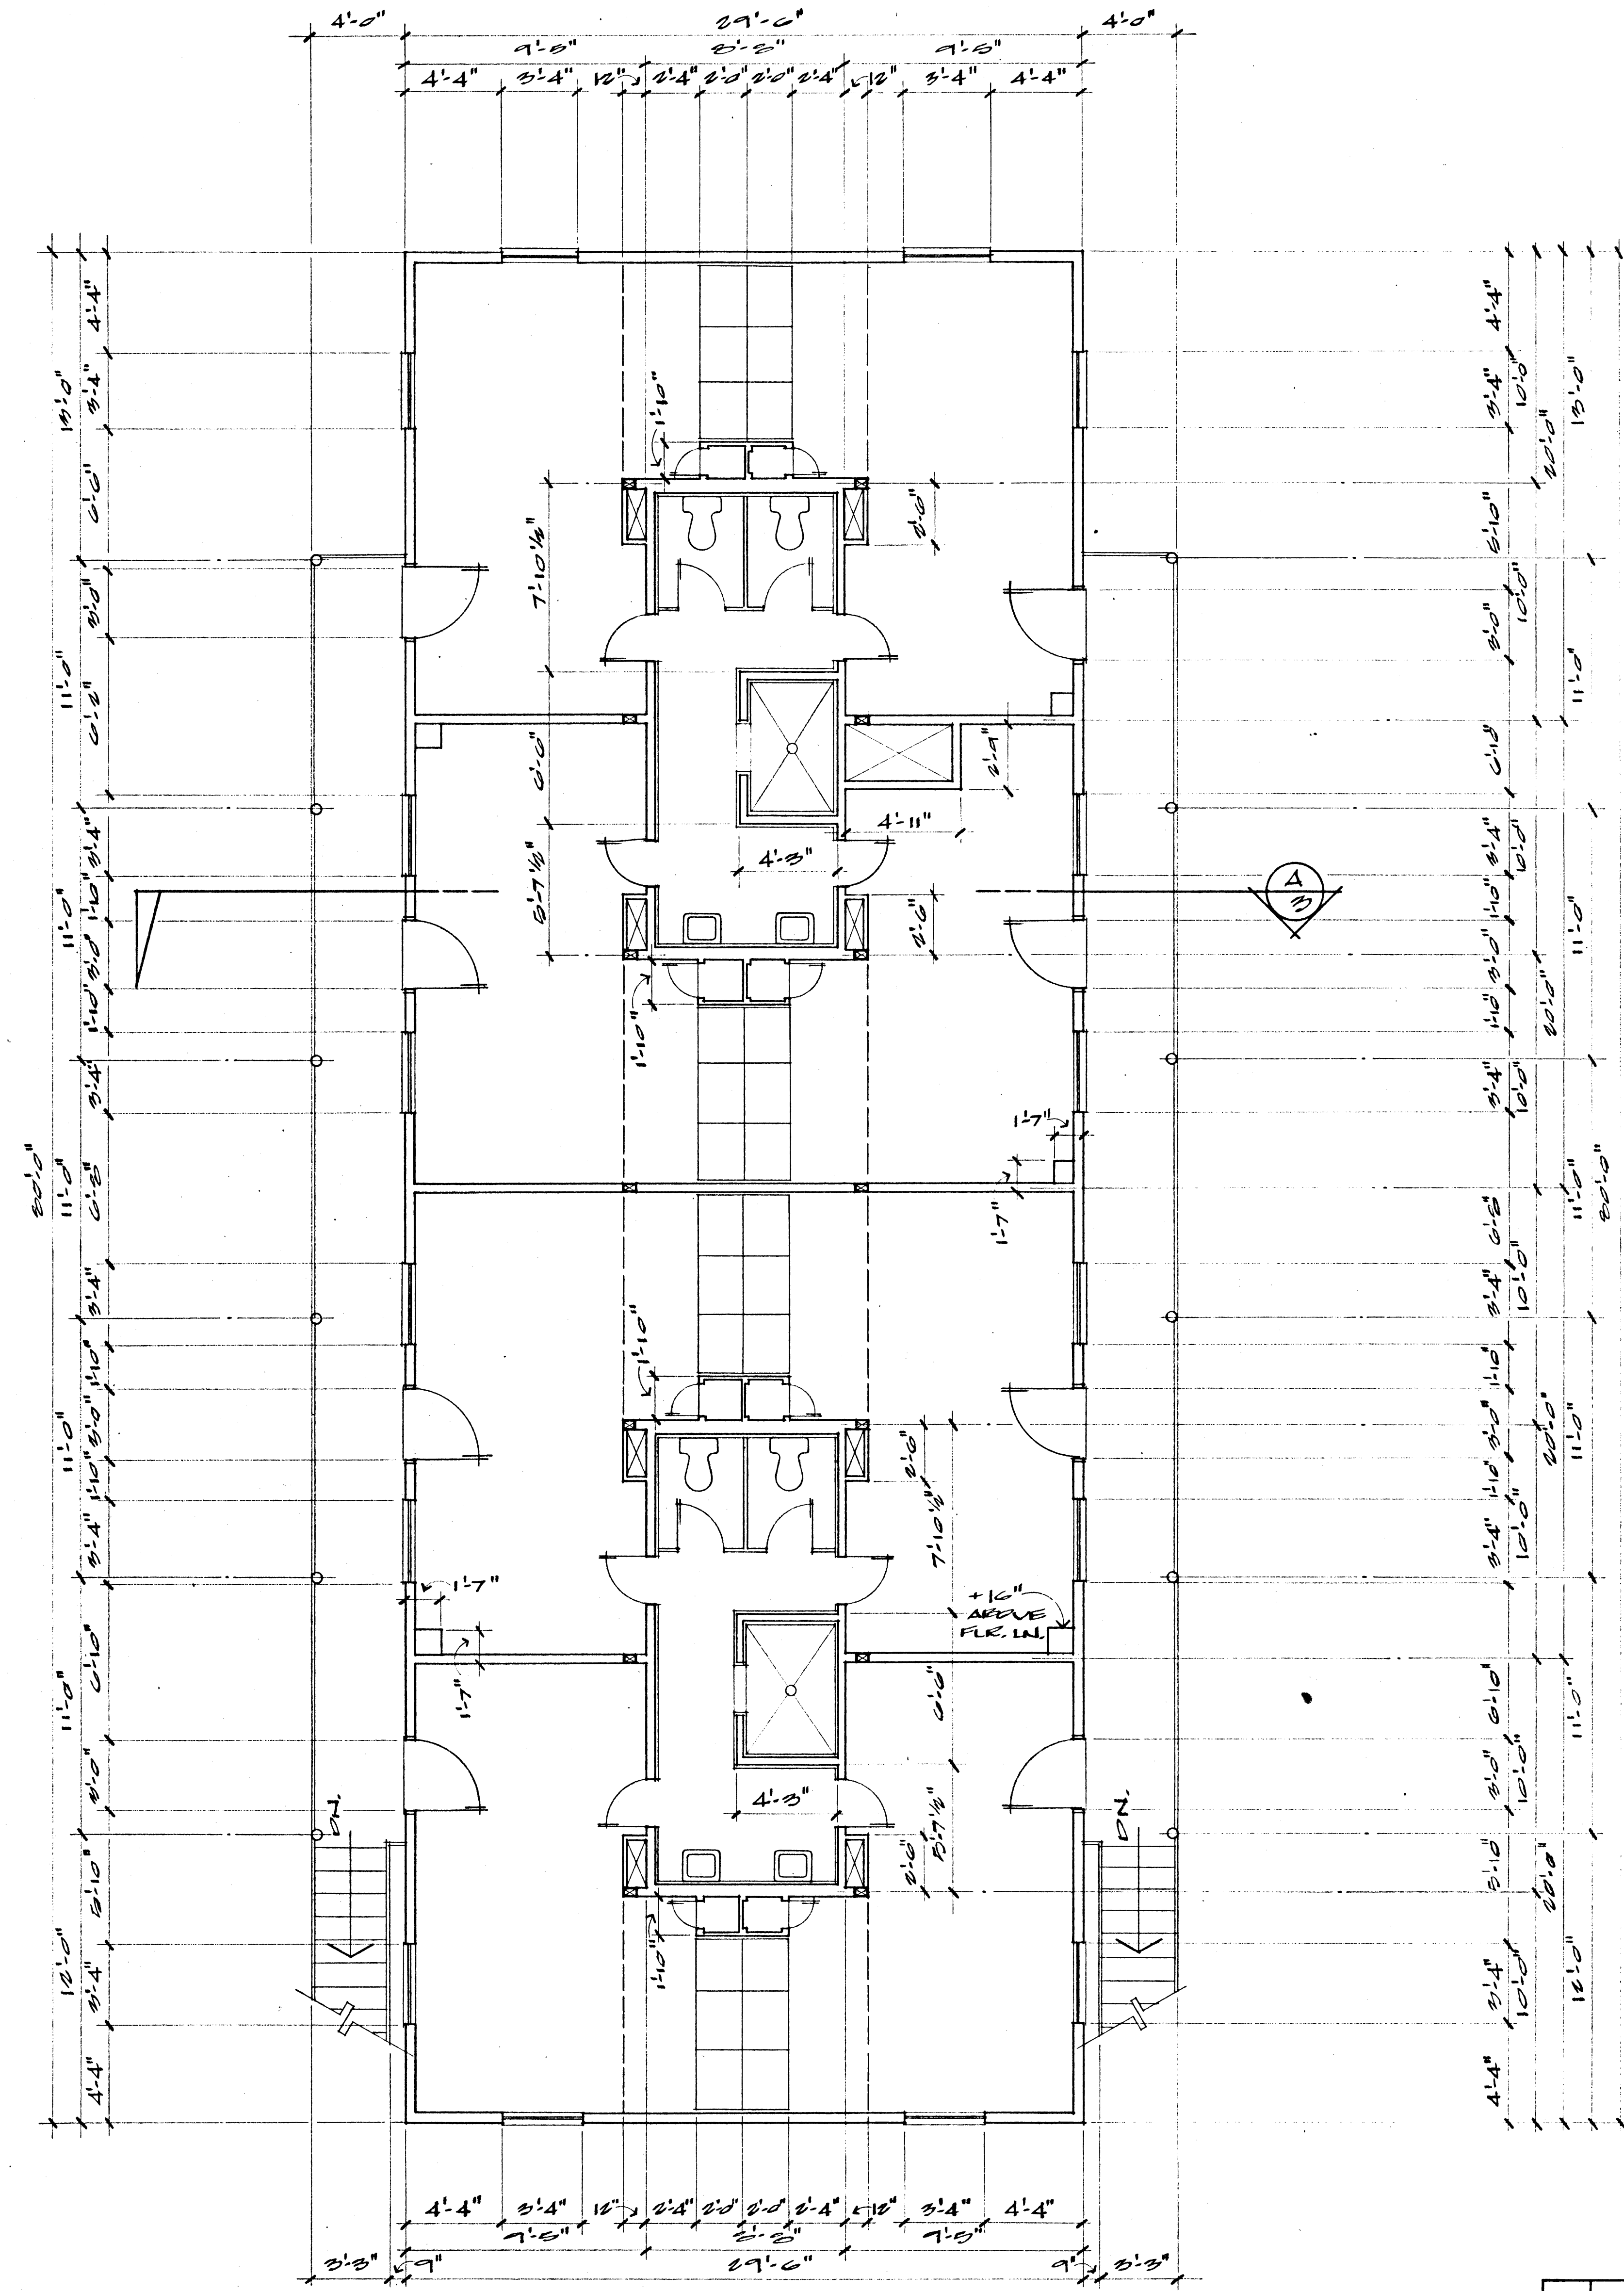
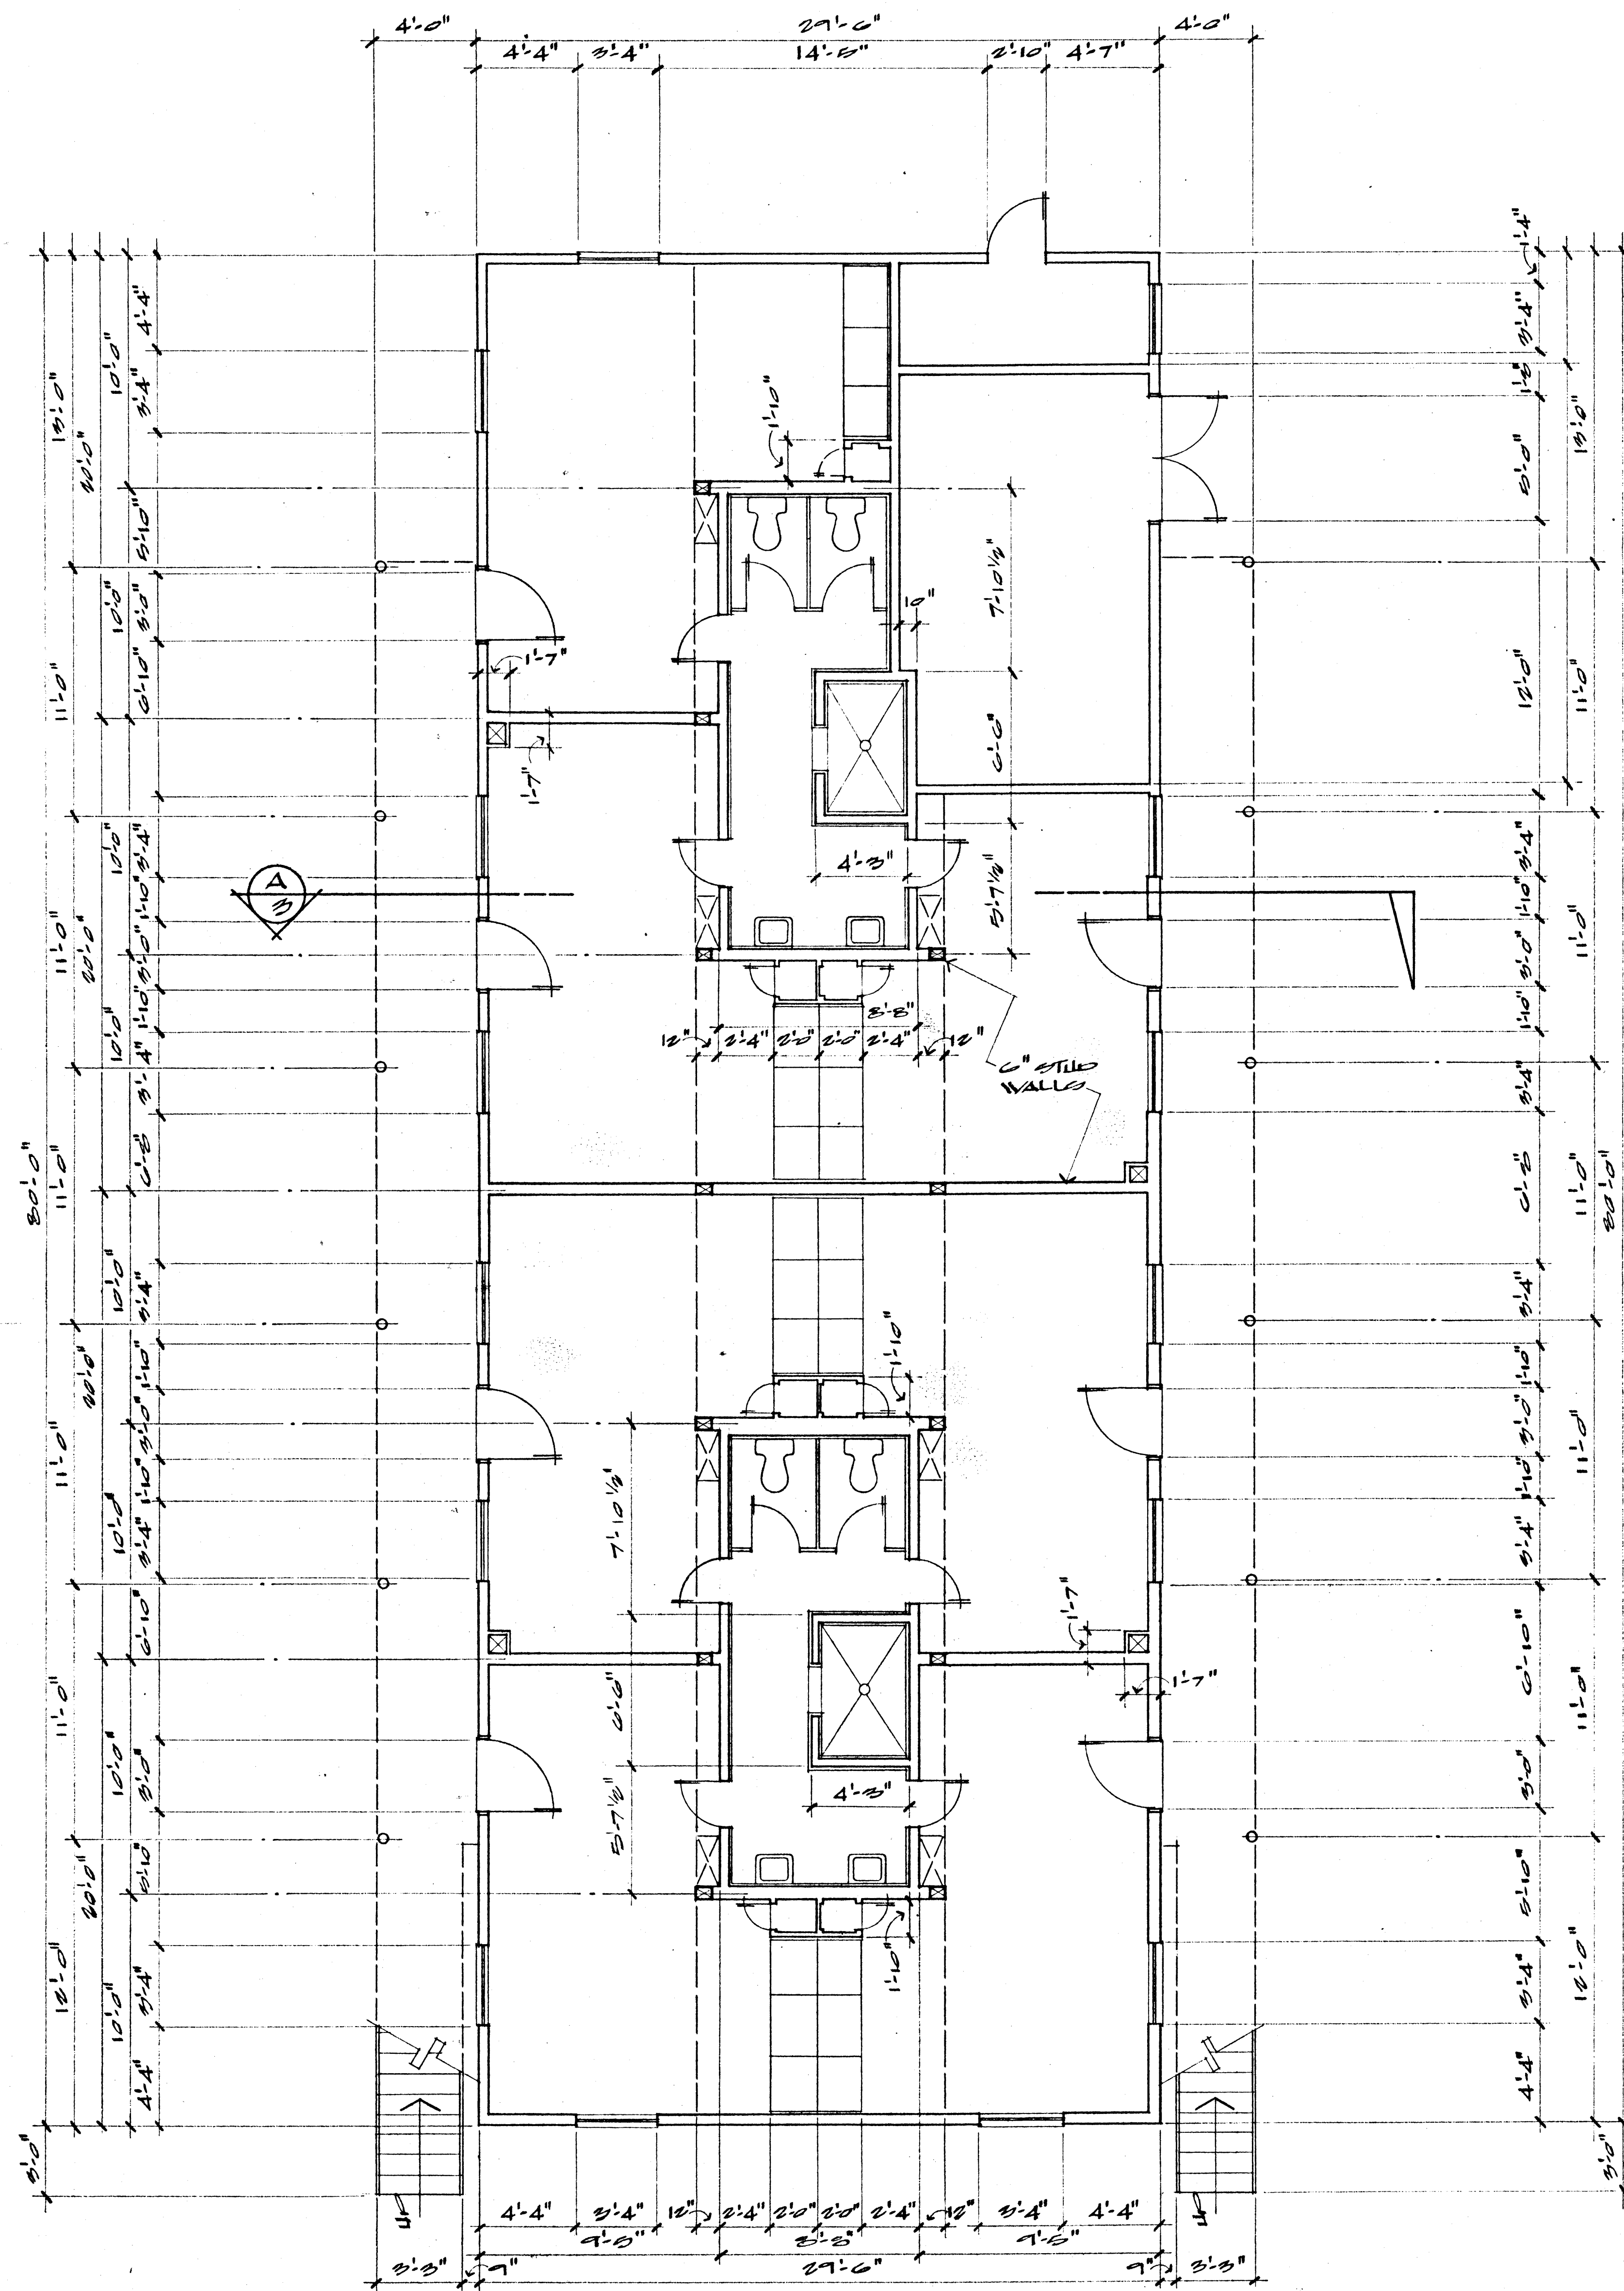


Daniel, Mann, Johnson, & Mendenhall
Architects & Engineers
3355 South Highland Drive, Suite 109
Las Vegas, Nevada 89109
Telephone: 702/732-9518

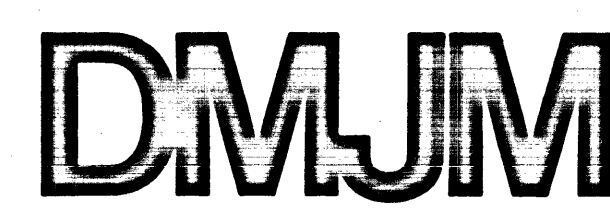

CITY OF LAS VEGAS

JOB TITLE
BARRACKS AD-BUILTS

SHEET TITLE
FLOOR PLANS

REVISION	DATE	DESCRIPTION	DTM
DESIGNED BY		JOB NO.	0001-07-01
DRAWN BY	gjm	SHEET NO.	1 OF 7
CHECKED BY	JAC	DATE	DEC 1 1981