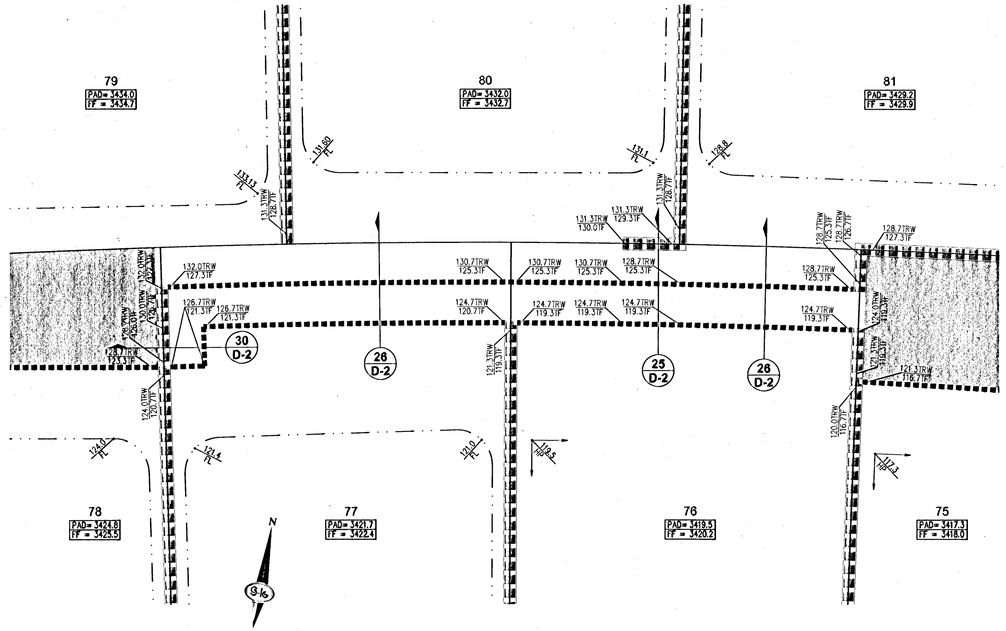

24. RETAINING WALL DETAIL

SCALE – 1"=10'

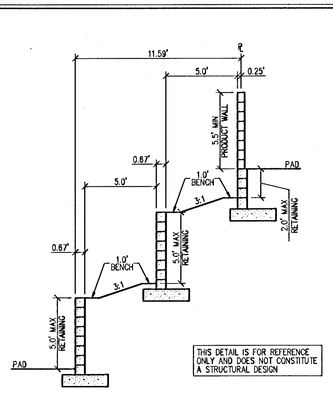

25. INTERIOR RETAINING WALLS

NOT TO SCALE

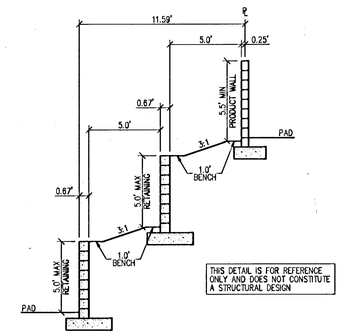

26. INTERIOR RETAINING WALLS

NOT TO SCALE

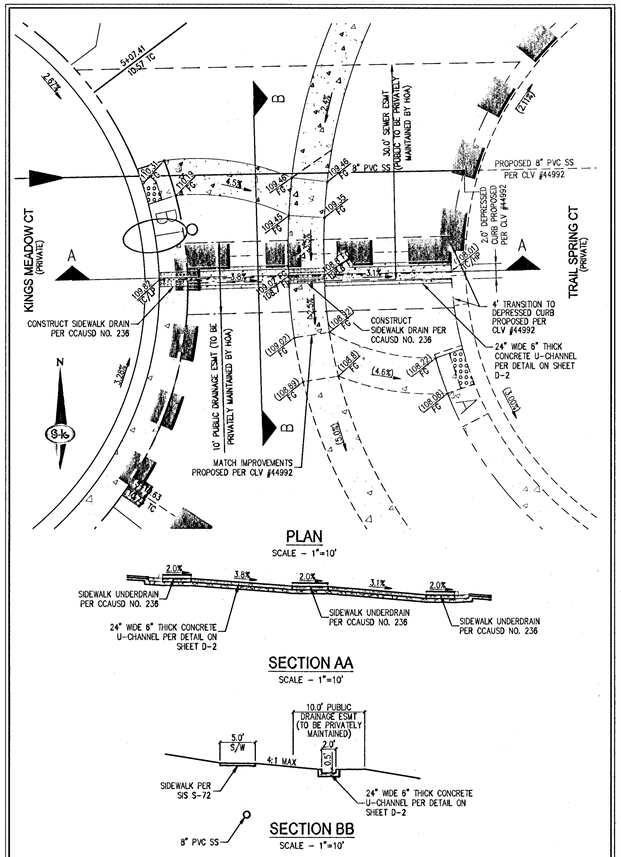

PLAN

SCALE – 1"=10'

SECTION AA

SCALE – 1"=10'

SECTION BB

SCALE – 1"=10'

27. COMMON LOT "C" DETAIL

NOT TO SCALE



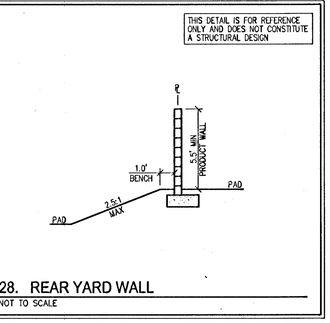

28. REAR YARD WALL

NOT TO SCALE

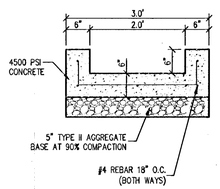

29. 24" U-CHANNEL DETAIL

NOT TO SCALE

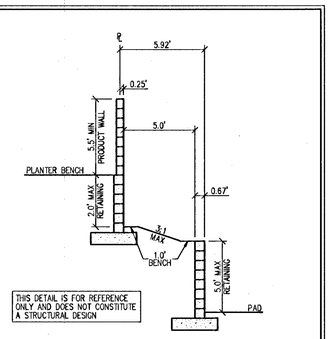

30. INTERIOR RETAINING WALLS

NOT TO SCALE

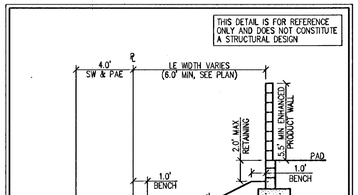

31. CORNER LOT SCREEN WALL

NOT TO SCALE

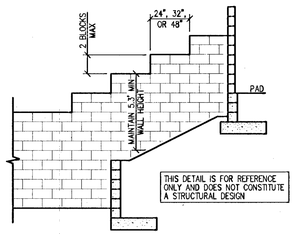

32. STEP DETAIL FOR SIDE YARD WALLS

NOT TO SCALE

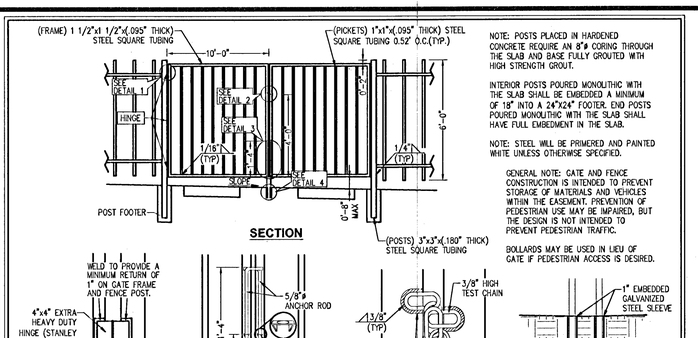

33. WROUGHT IRON FENCE DETAIL

NOT TO SCALE

PER CLV DWG 421B

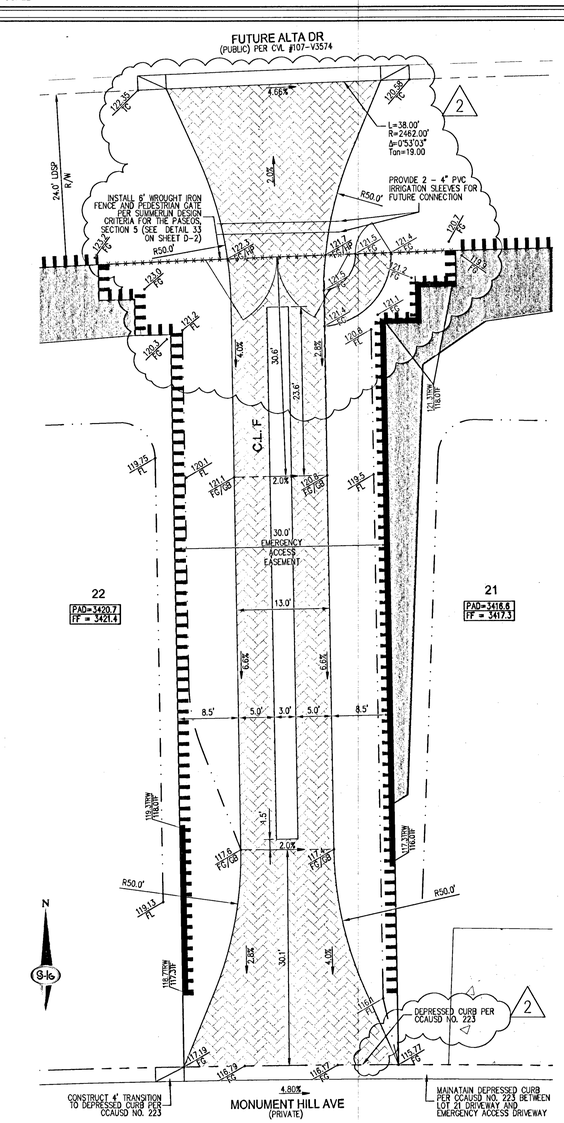

34. EMERGENCY/PEDESTRIAN ACCESS DETAIL

SCALE – 1" = 10'

REPLOT
lony 14982-2

SLATER HANIFAN GROUP
CONSULTING ENGINEERS & PLANNERS
5740 S. ARVILLE STREET #216, LAS VEGAS, NV 89118
PHONE (702) 284-5300 FAX (702) 284-5399

NO.	DESCRIPTION	DATE	BY	APP. DATE	APP.
2	CONNECT EMERGENCY ACCESS TO ALTA	8/20/13	DSP	10-14-13	RK

Woodside Homes
BETTER BY DESIGN

LAS VEGAS, NV

ANDORRA AND CASTILLE - PHASE II
GRADING DETAILS

S 34
T 20
R 59

DATE: 2/12/13
DRAFTER: DSP
DESIGNER: DSP
CHECKED: CAL

PROJECT NO.
WSH1105-002

ENGINEER'S SEAL
CORBY A. LIEBER
Exp. 12/31/2013
CIVIL
No. 15875
STATE OF NEVADA
10-3-13

D-2
SHEET 5 OF 9

CLV #46963

\\wsh1105-002 v3\ nomad o ohose k\new\lamoreau\wsh1105-002tit.dwg 10/3/2013 9:48 AM David Altacher