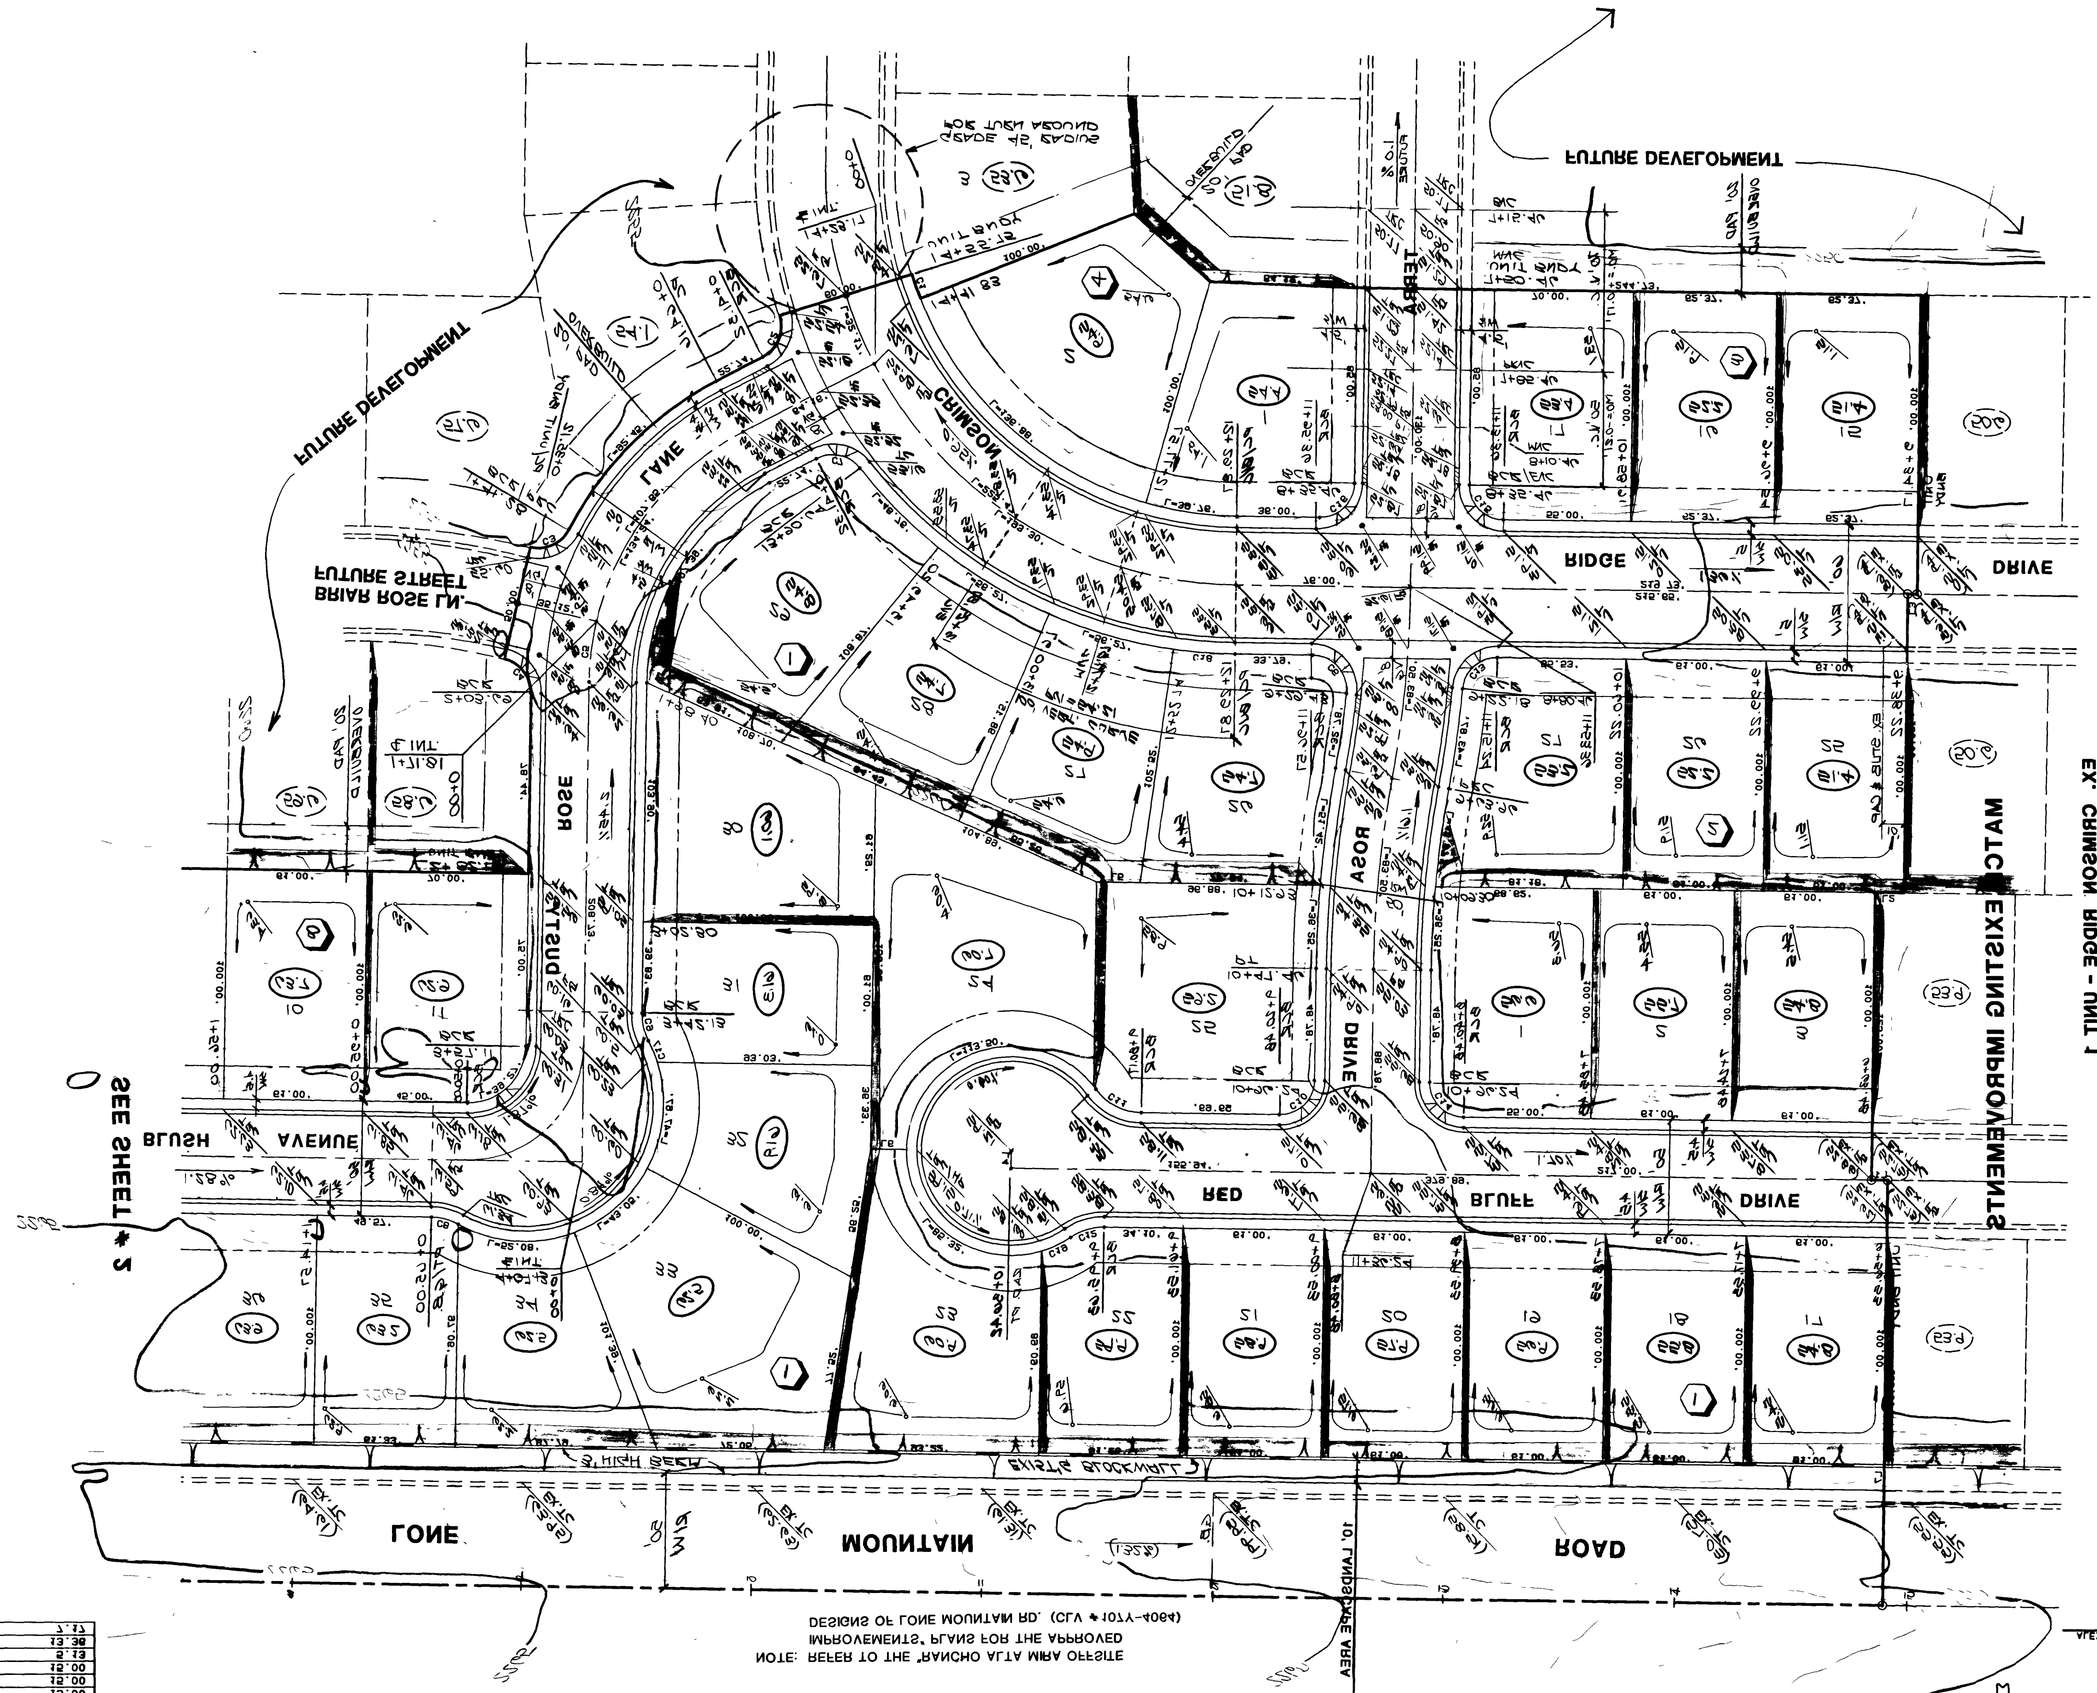






CRIMSON RIDGE - UNIT 1 (RANCHO ALTA ARIA LOT 1)

PLAN GRADING ROUGH

EAST HALL

S-0885 :ON OB NO
RRA\AMM :YB
OCT 2004 :DATE
1"=40' :SCALE

SHEET 3 OF 11 SHEETS

CITY OF LAS VEGAS
R.D. DEVELOPMENT

NO. | DATE | BY | REVISIONS

ENGINEERS - PLANNERS
CONSULTING ENGINEERS
5900 PARCO DEL BUILDING A SUITE 100
LAS VEGAS, NEVADA PHONE (702) 873-7500

ARC urban


ROUGH GRADING PLAN