

1011-1082-1 SHEET
10 SHEET

SCALE 1" = 40'
 DATE 11/11/11
 BY J.L.
 NO. 1082-1


CRIMSON RIDGE I

ROUGH GRADING PLAN



CONSULTING ENGINEERS - PLANNERS
 2300 PASEO DEL PRADO BUILDING SUITE 100
 LAS VEGAS, NEVADA 89102 PHONE (702) 878-1220

REVISION	DATE	BY

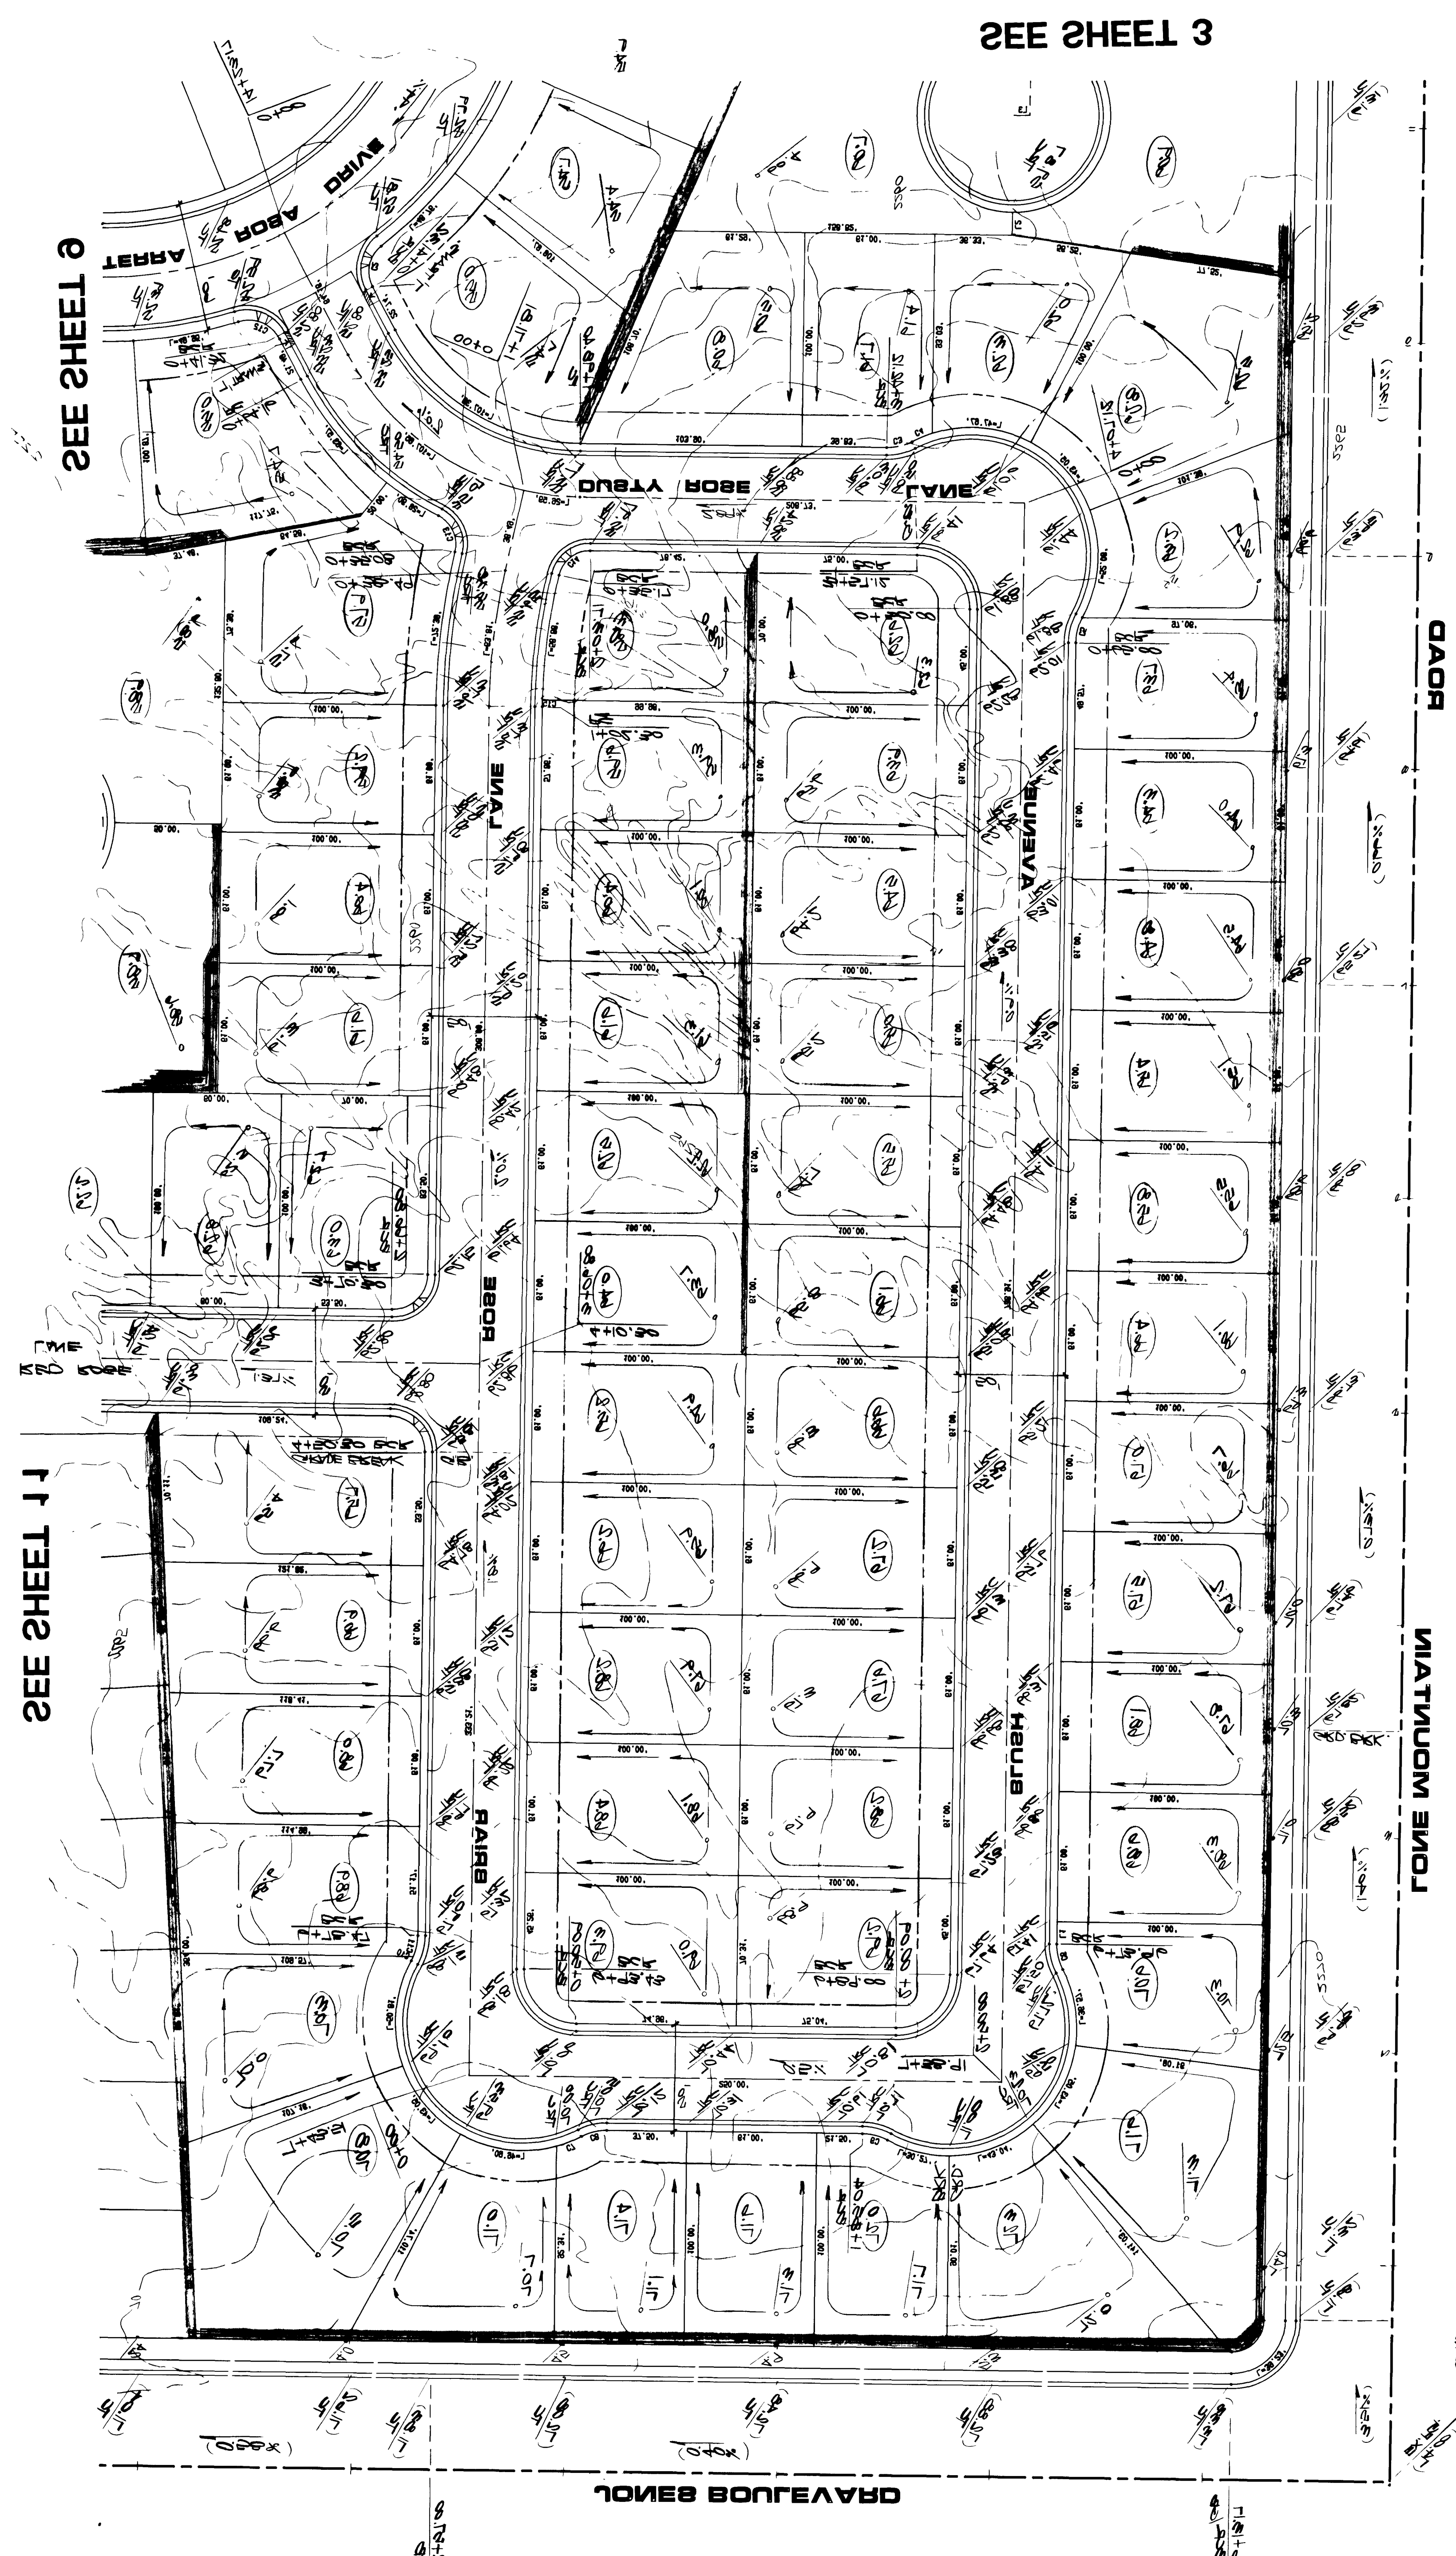


233/

SEE SHEET 3

SEE SHEET 2

SEE SHEET 1

JONES BOULEVARD

MATIUM BLVD

GARD

SEE SHEET 3

