


DATE: 2-2-21

NO.	DESCRIPTION	DATE
1	ISSUE FOR PERMIT	02/02/21
2	ISSUE FOR PERMIT	02/02/21
DESIGN: GSW/GTP
 DRAWN: GTP
 CHECK: BAH
 ISSUE DATE: 02/02/21
 ISSUE EDITOR: GTP
 PLOT DATE: 02-22-21
 PLOT TIME: 11:36:53

G.C. WALLACE COMPANIES
 ENGINEERS | PLANNERS | SURVEYORS
 1555 S. RAINBOY BOULEVARD - LAS VEGAS, NV 89146
 T: 702.884.2000 F: 702.884.2299 G: WALLACE.COM


THE HOWARD HUGHES COMPANY, LLC
 VILLAGE 23A/23B ALTA DRIVE IMPROVEMENTS
 TYPICAL SECTIONS

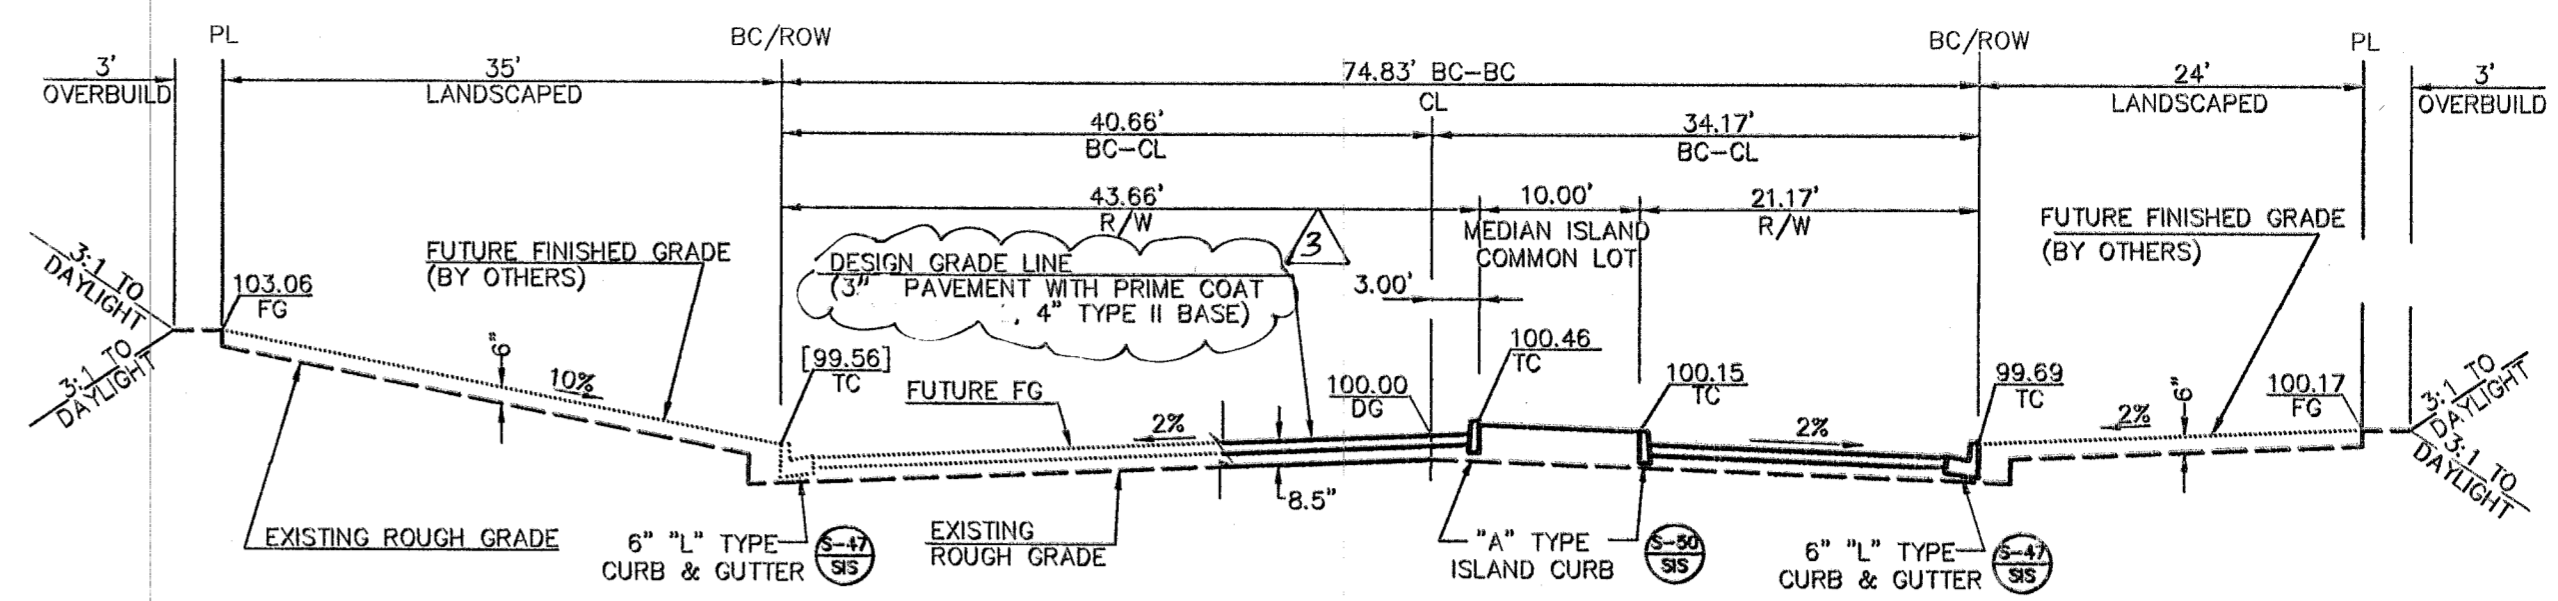


FOX HILL DRIVE
 (PUBLIC NEIGHBORHOOD COLLECTOR LEVEL 1 WITH ADDITIONAL PARKING LANE AND SHARED BIKE LANES)
 NOT TO SCALE

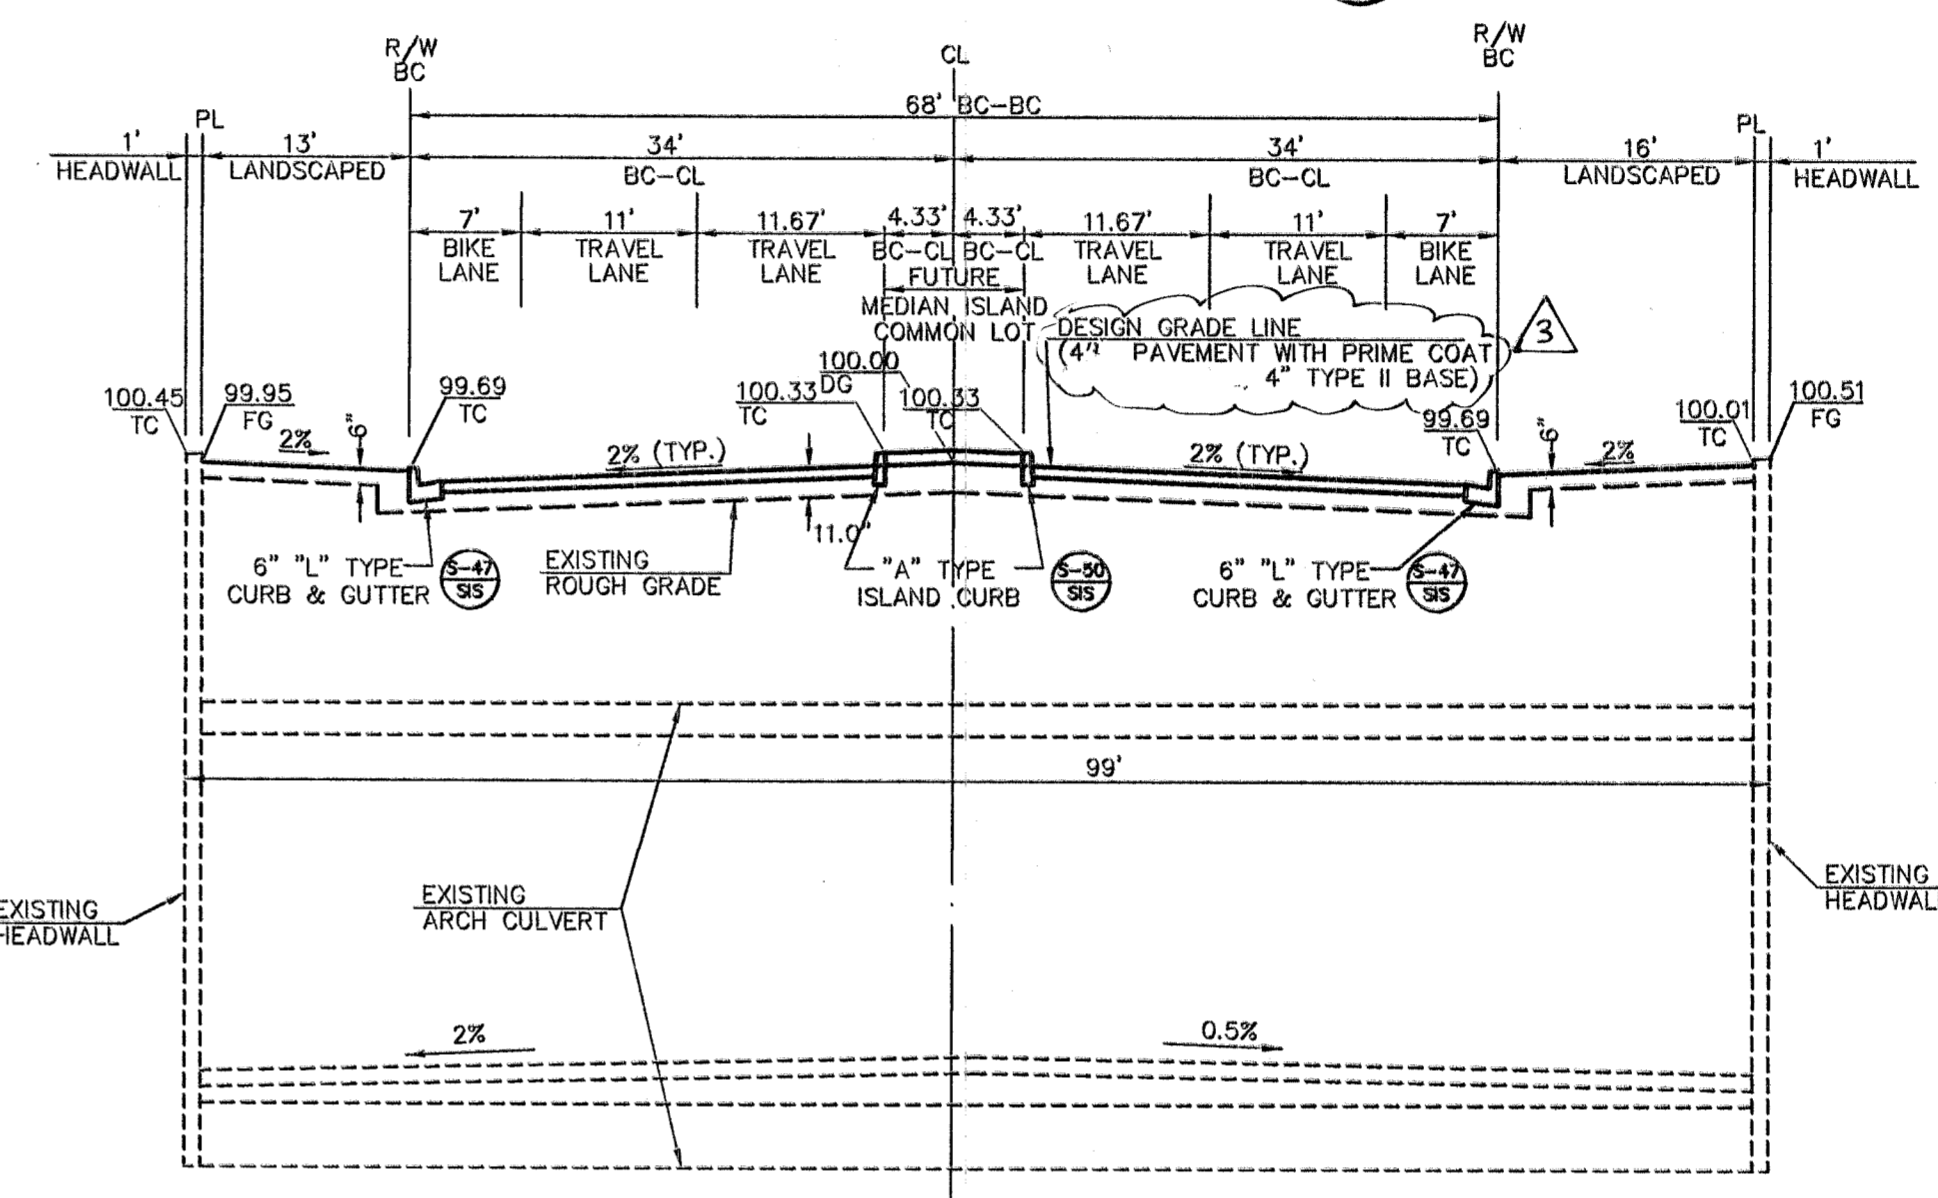


ALTA DRIVE - EXISTING ARCH CULVERT/ HEADWALL SECTION
 (PUBLIC NEIGHBORHOOD ARTERIAL WITH BIKE LANES)
 NOT TO SCALE

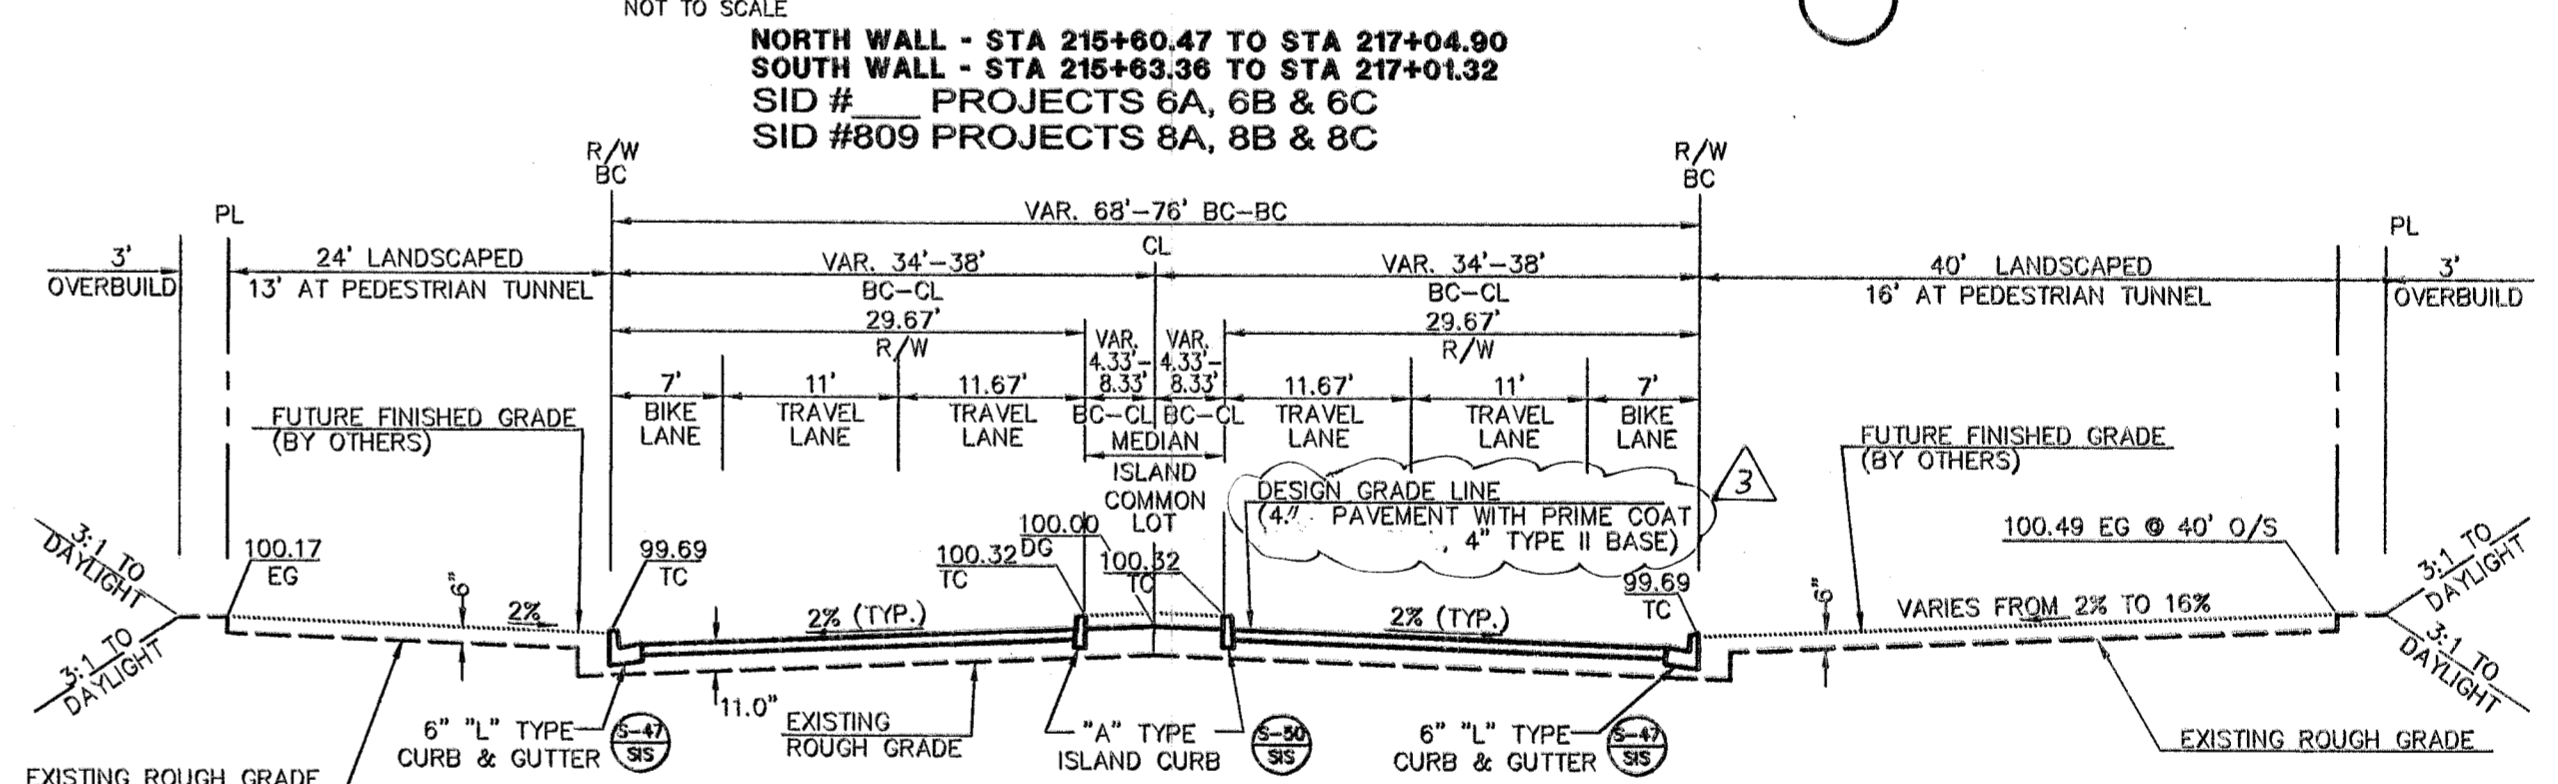

ALTA DRIVE - TYPICAL MEDIAN TRANSITION SECTION
 (PUBLIC NEIGHBORHOOD ARTERIAL WITH BIKE LANES)
 NOT TO SCALE

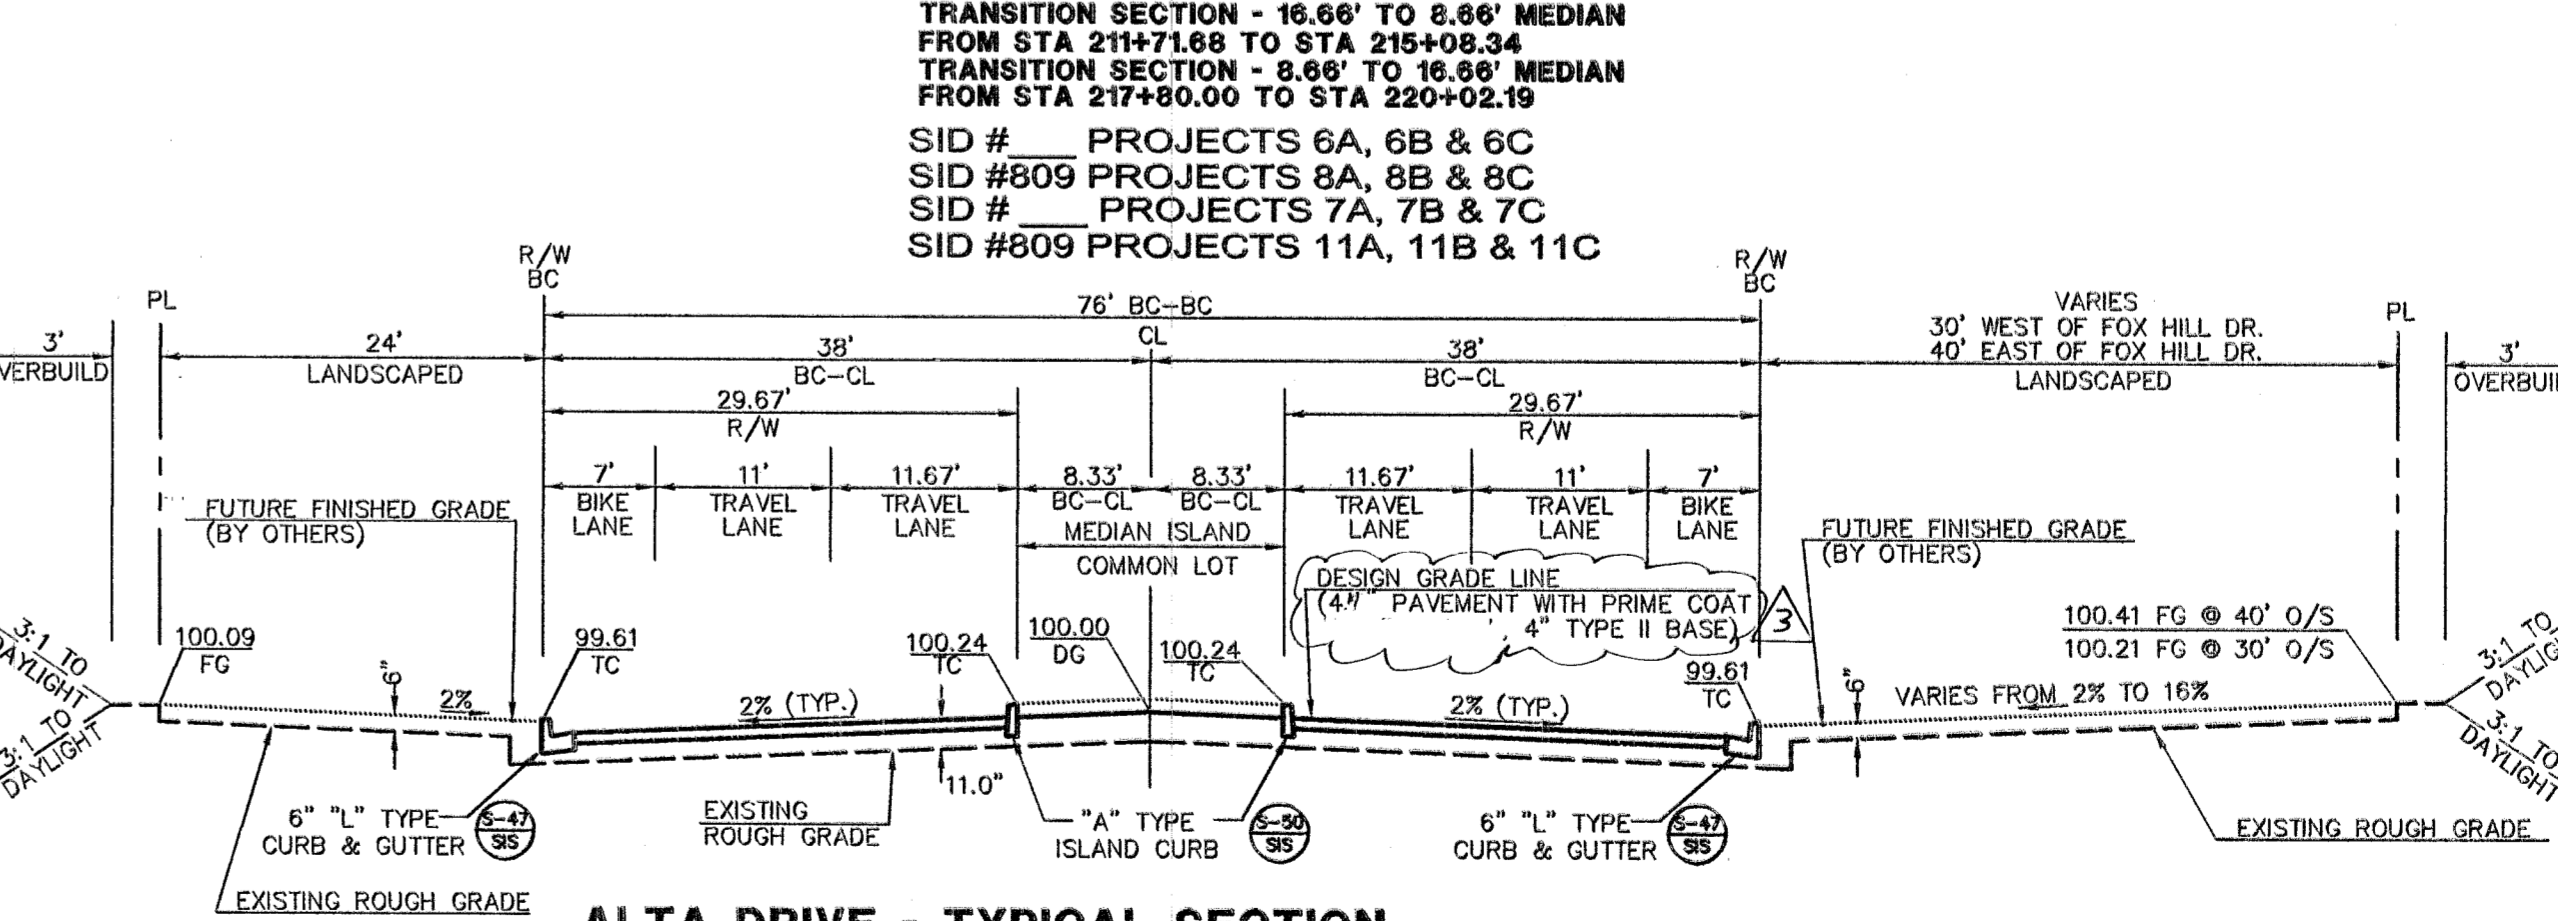


ALTA DRIVE - TYPICAL SECTION
 (PUBLIC NEIGHBORHOOD ARTERIAL WITH BIKE LANES)
 NOT TO SCALE

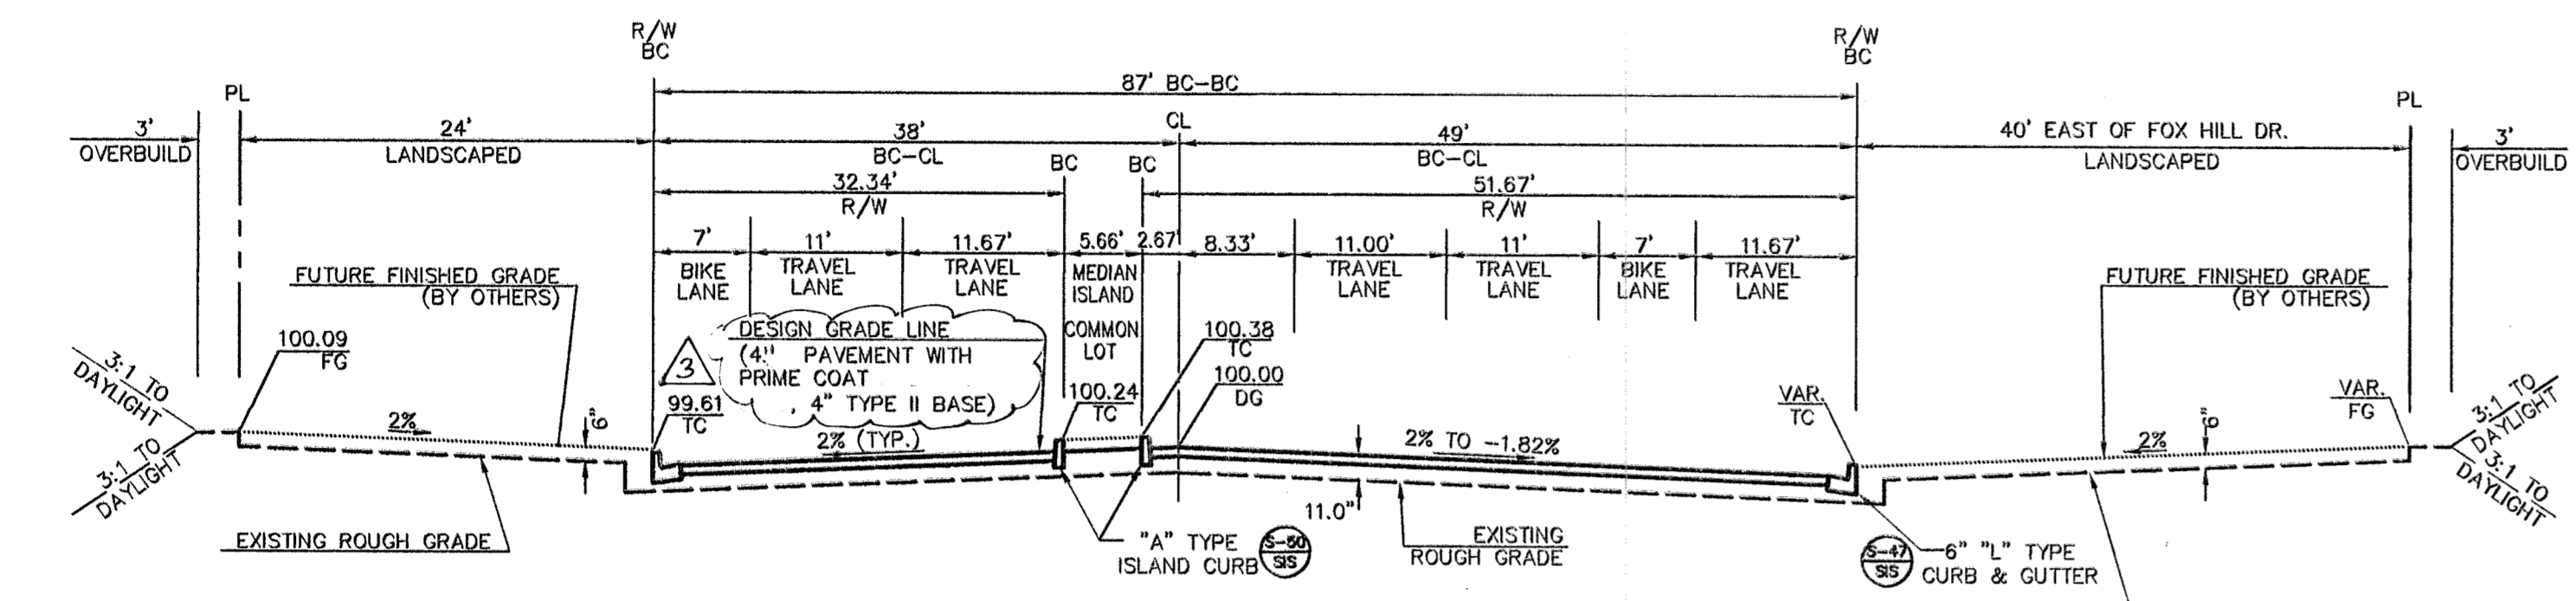


ALTA DRIVE - TYPICAL SECTION AT INTERSECTION APPROACHES
 SHOWING LEFT AND RIGHT TURNING LANES
 (PUBLIC NEIGHBORHOOD ARTERIAL WITH BIKE LANES)
 NOT TO SCALE

SID # PROJECTS 6A, 6B & 6C
 SID #809 PROJECTS 8A, 8B & 8C
 SID # PROJECTS 7A, 7B & 7C
 SID #809 PROJECTS 11A, 11B & 11C

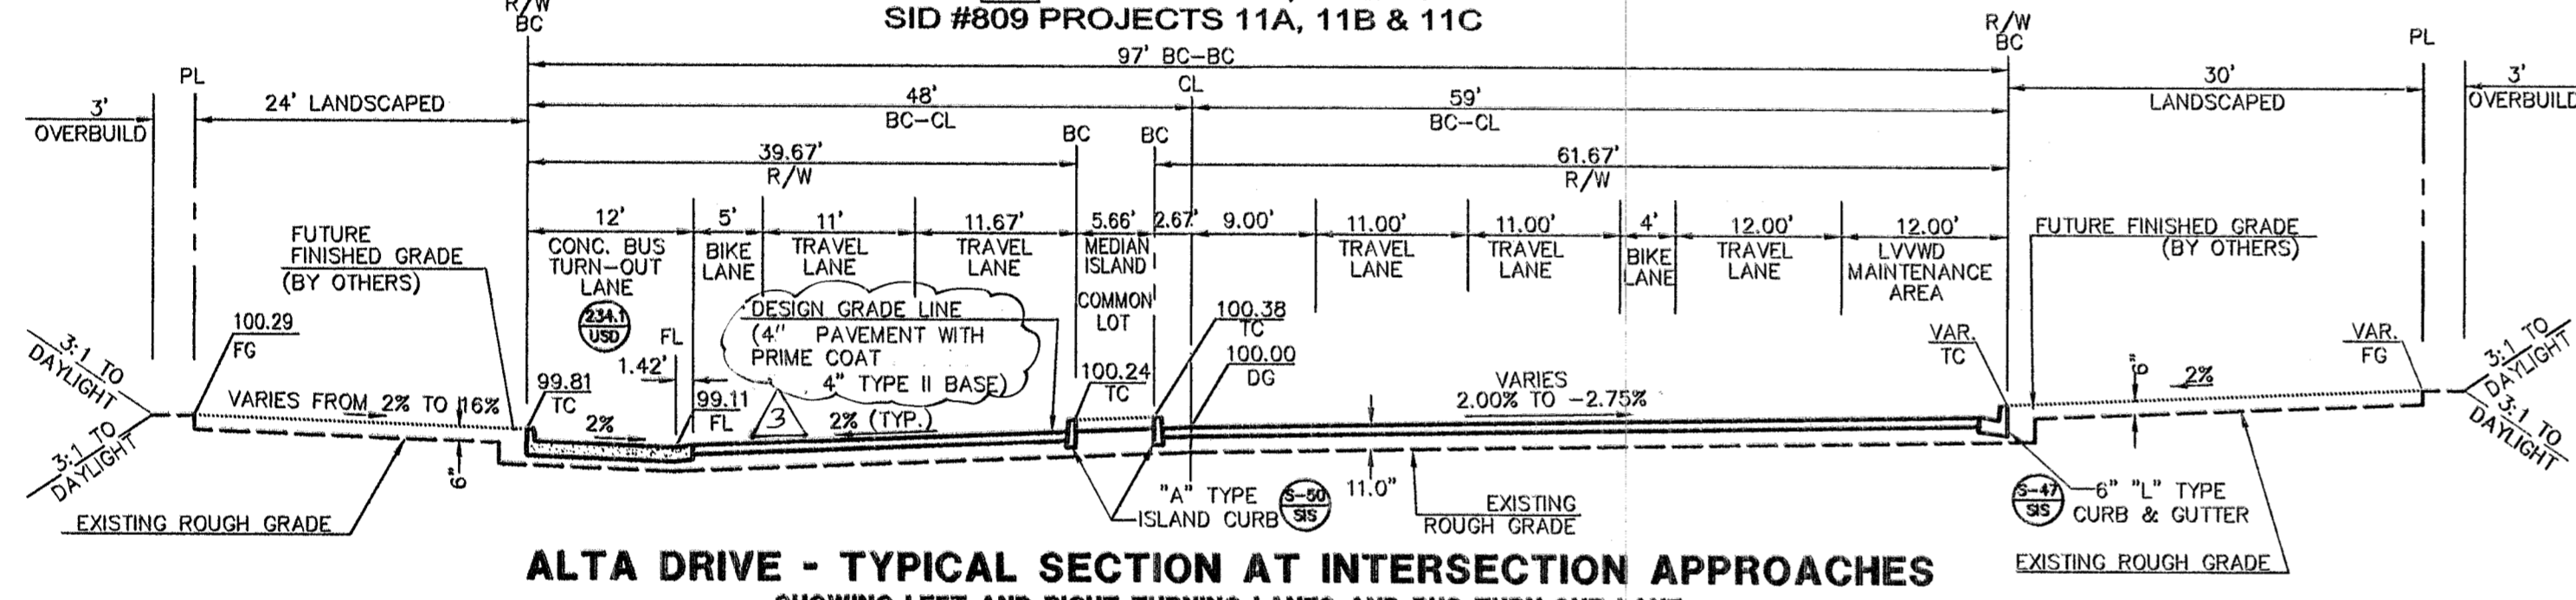


ALTA DRIVE - TYPICAL SECTION AT INTERSECTION APPROACHES
 SHOWING LEFT AND RIGHT TURNING LANES AND BUS TURN-OUT LANE
 (PUBLIC NEIGHBORHOOD ARTERIAL WITH BIKE LANES)
 NOT TO SCALE

SID # PROJECTS 6A, 6B & 6C
 SID #809 PROJECTS 8A, 8B & 8C
 SID # PROJECTS 7A, 7B & 7C
 SID #809 PROJECTS 11A, 11B & 11C

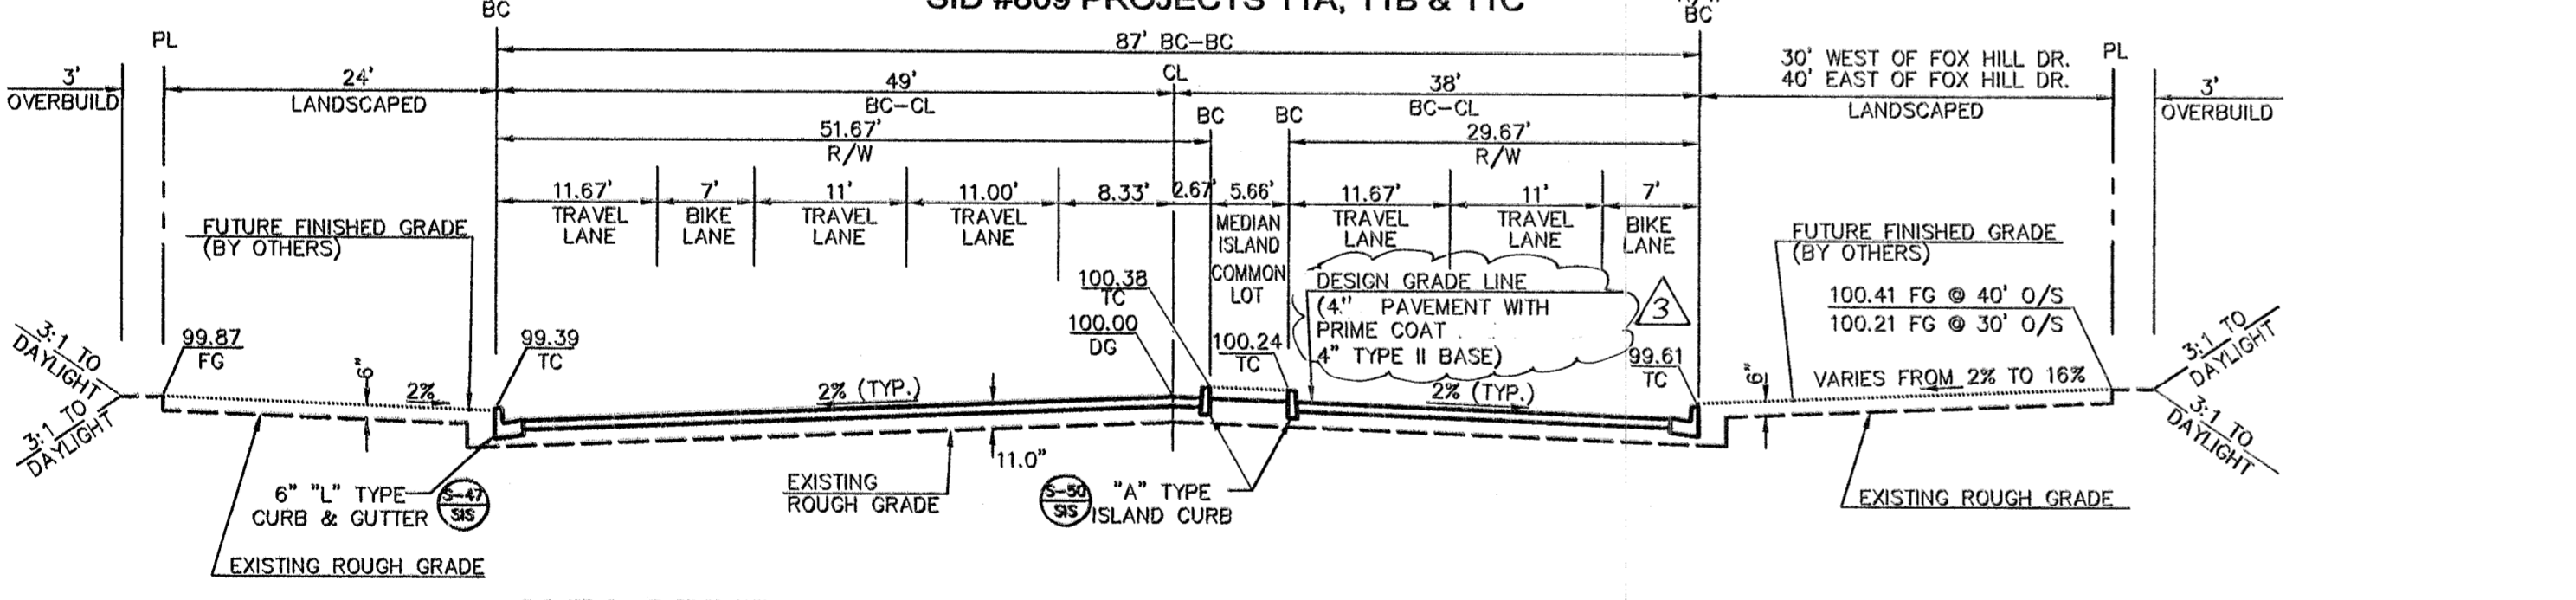

ALTA DRIVE - TYPICAL SECTION AT INTERSECTION APPROACHES
 SHOWING LEFT AND RIGHT TURNING LANES
 (PUBLIC NEIGHBORHOOD ARTERIAL WITH BIKE LANES)
 NOT TO SCALE

SID # PROJECTS 6A, 6B & 6C
 SID #809 PROJECTS 8A, 8B & 8C
 SID # PROJECTS 7A, 7B & 7C
 SID #809 PROJECTS 11A, 11B & 11C

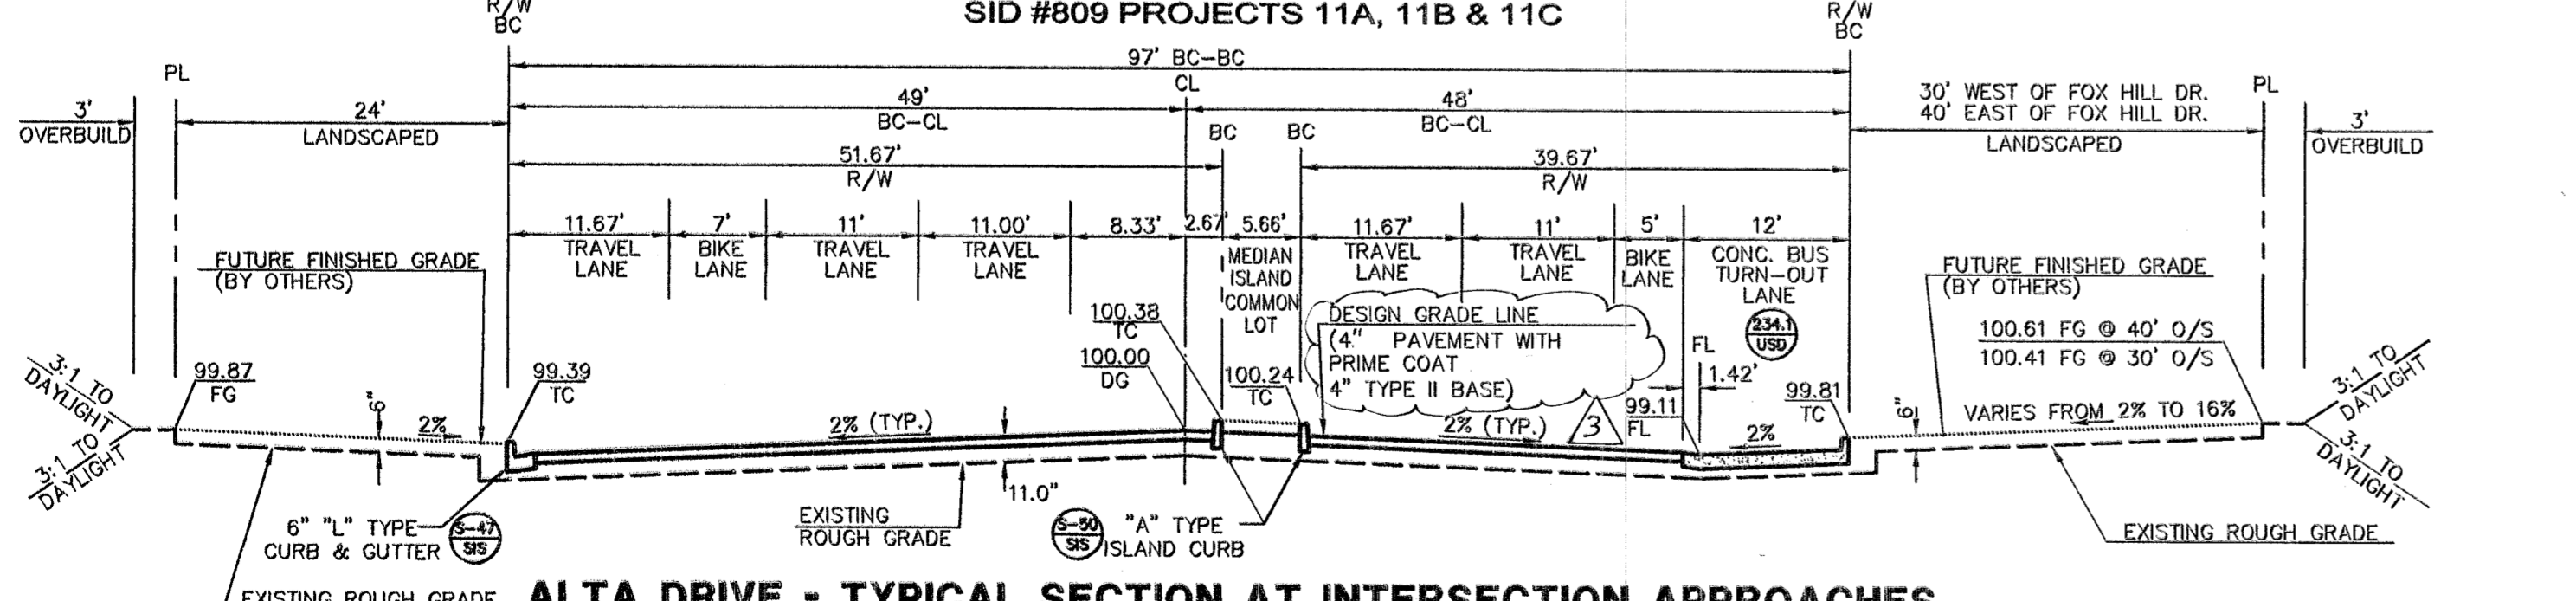

ALTA DRIVE - TYPICAL SECTION AT INTERSECTION APPROACHES
 SHOWING LEFT AND RIGHT TURNING LANES AND BUS TURN-OUT LANE
 (PUBLIC NEIGHBORHOOD ARTERIAL WITH BIKE LANES)
 NOT TO SCALE

SID # PROJECTS 6A, 6B & 6C
 SID #809 PROJECTS 8A, 8B & 8C
 SID # PROJECTS 7A, 7B & 7C
 SID #809 PROJECTS 11A, 11B & 11C

2743
 2013 0855
 plm

H# 47511