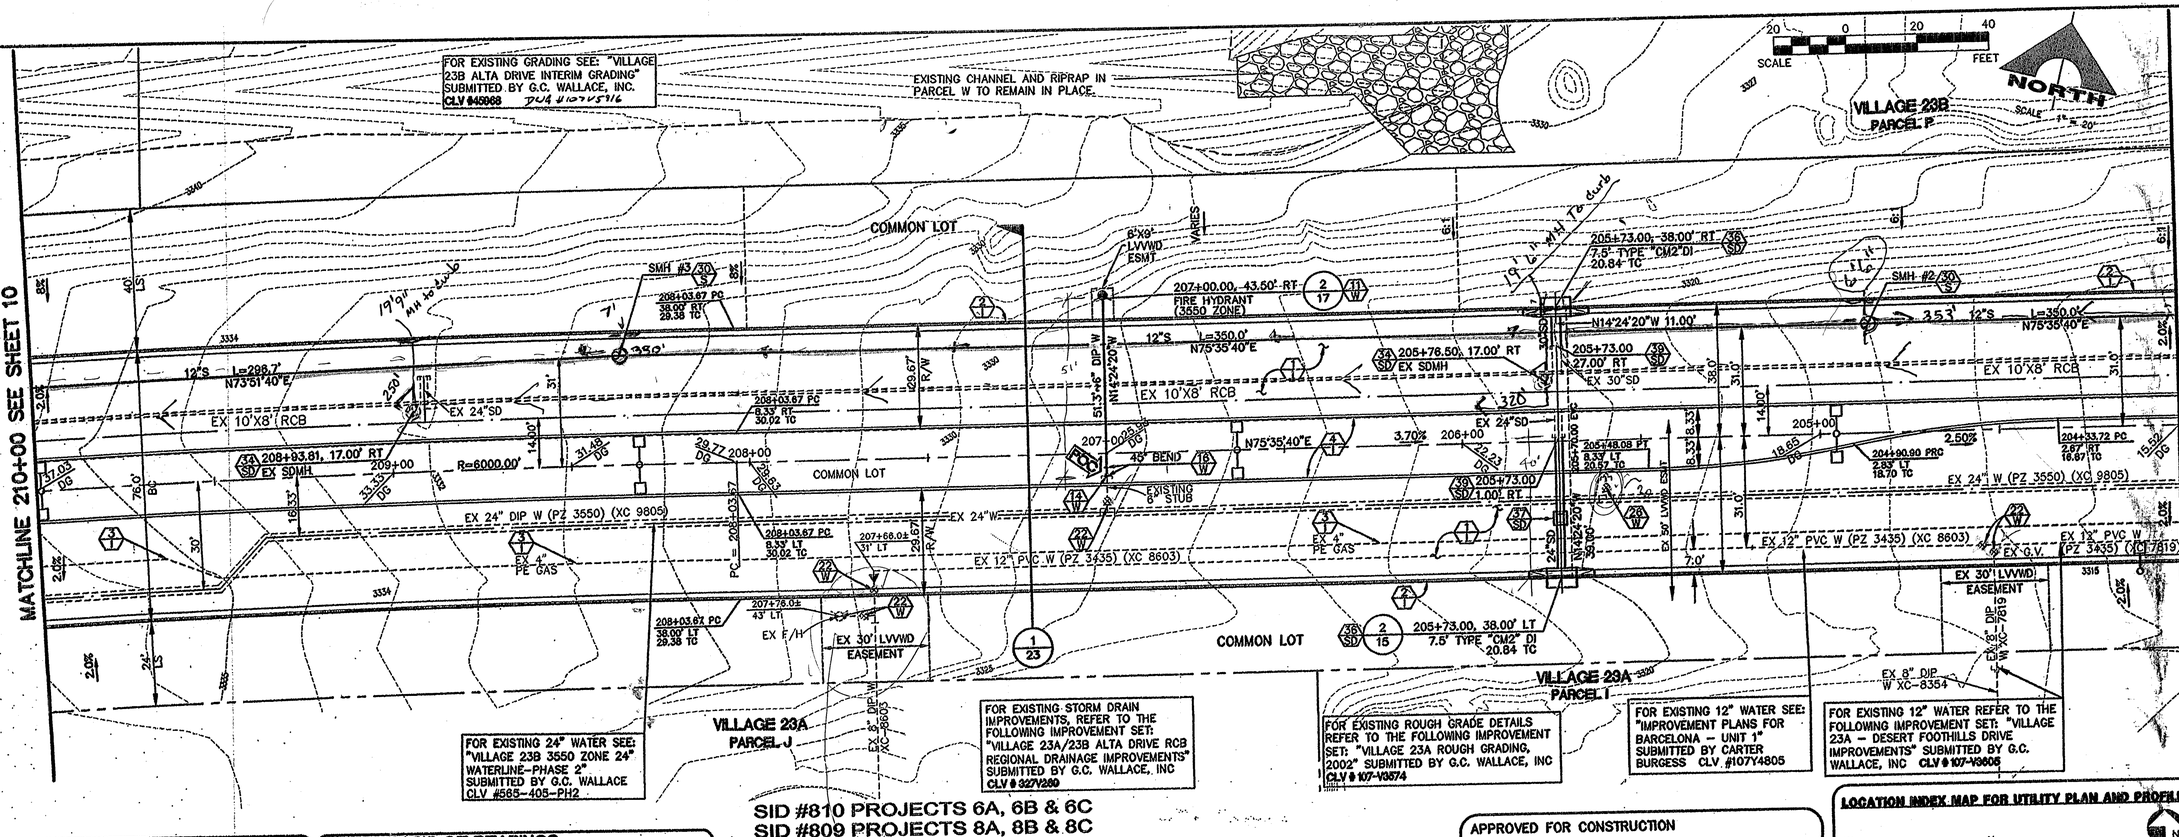

SID #810 PROJECTS 6A, 6B & 6C
SID #809 PROJECTS 8A, 8B & 8C

ALTA DRIVE (PUBLIC)

SCALE: HORIZ. 1" = 20'
VERT. 1" = 5'

REFER TO SHEET 2 FOR CONSTRUCTION NOTES

BENCHMARK

DESCRIPTION	NAVD 88 DATUM	NAVD 88 DATUM
RIVET AND PLATE IN TOP OF CURB @ NORTHEAST CORNER OF DESERT FOOTHILLS AND ALTA DRIVE	3304.45 (FEET)	1007.197 (METERS)

CLV BM No. SLV09 34NE8

BASIS OF BEARINGS

NORTH 89°45'05" EAST BEING THE SOUTH LINE OF THE SOUTHWEST QUARTER (SW 1/4) OF SECTION 36, TOWNSHIP 20 SOUTH, RANGE 59 EAST, M.D.M., AS SHOWN BY MAP ON FILE IN FILE 91, PAGE 28 OF PARCEL MAPS IN THE CLARK COUNTY RECORDER'S OFFICE, CLARK COUNTY, NEVADA

APPROVED FOR CONSTRUCTION
LAS VEGAS VALLEY WATER DISTRICT ENGINEERING SERVICES MANAGER
PROJECT NO. 121343 DATE: 02/27/13

LOCATION INDEX MAP FOR UTILITY PLAN AND PROFILE SHEETS

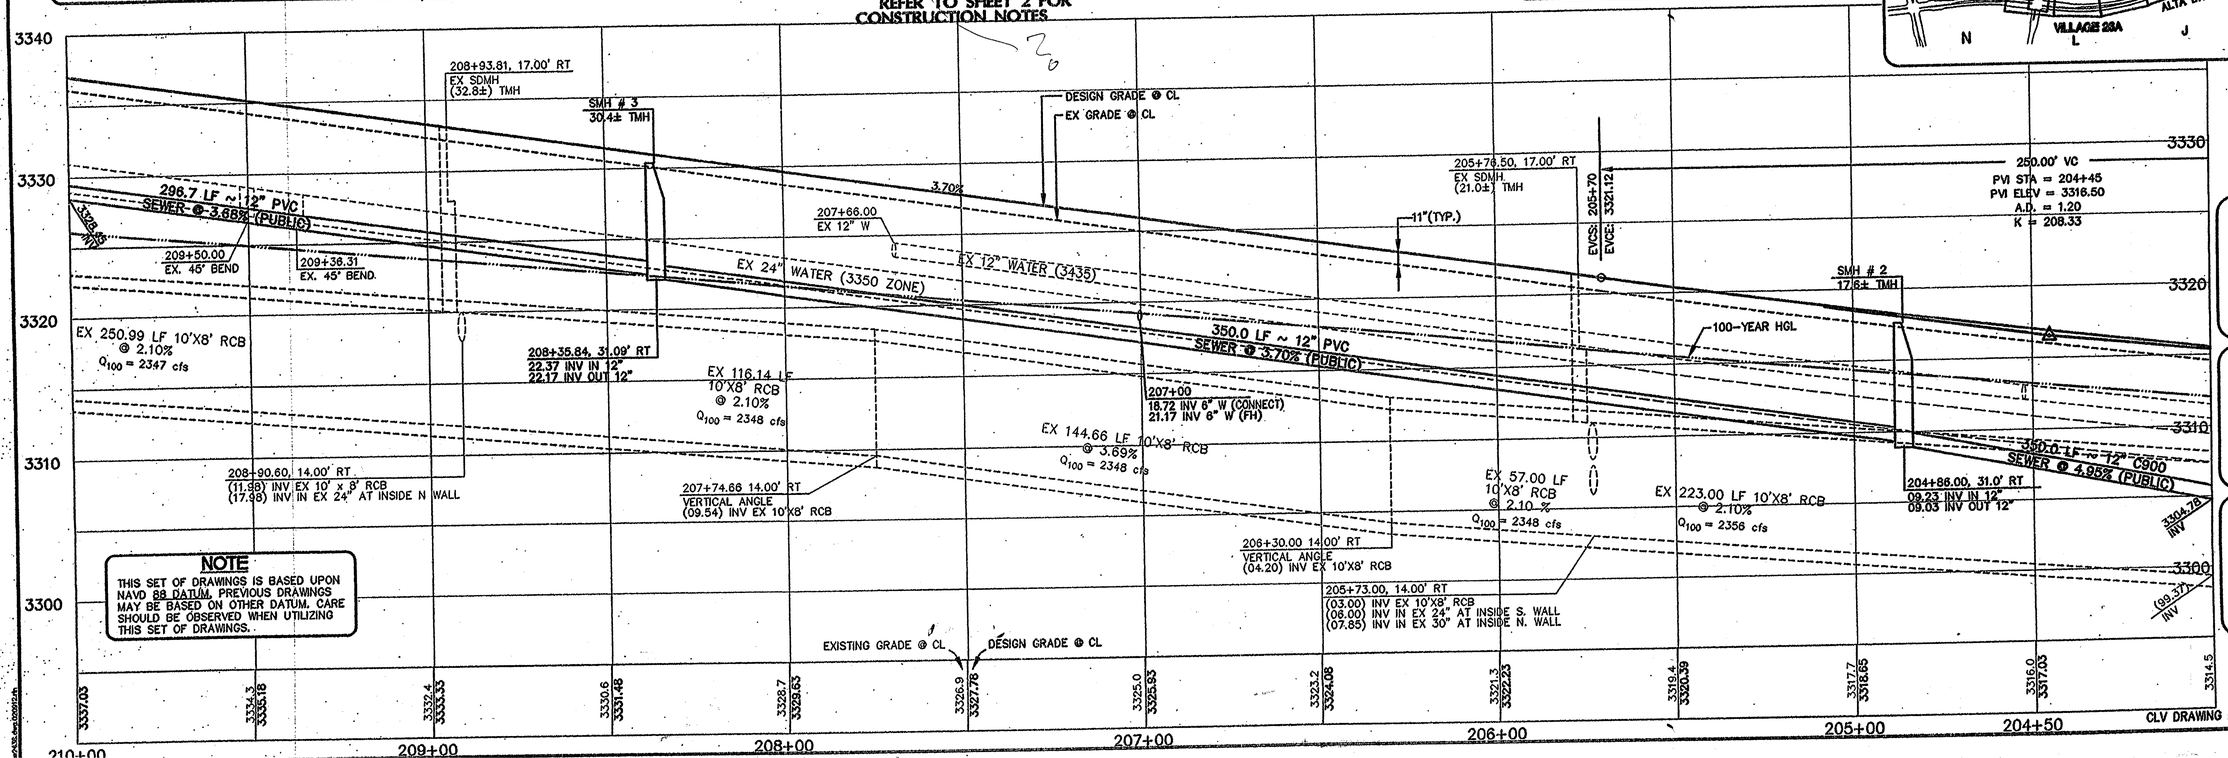

NOTE

THIS SET OF DRAWINGS IS BASED UPON NAVD 88 DATUM. PREVIOUS DRAWINGS MAY BE BASED ON OTHER DATUM. CARE SHOULD BE OBSERVED WHEN UTILIZING THIS SET OF DRAWINGS.

CLV DRAWING NO. H#47511 107V5922

AS BUILTS

Call before you Dig. Avoid cutting underground utility lines. It's easy. Call 811 or 1-800-227-2600

CALL BEFORE YOU DO OVERHEAD 1-702-227-2929

FAST Call before you UnderGround. 1-702-432-5300 FREEWAY AND ARTERIAL SYSTEM OF TRANSPORTATION

THE HOWARD HUGHES COMPANY, LLC
VILLAGE 23A/23B ALTA DRIVE IMPROVEMENTS
ALTA DRIVE UTILITY PLAN AND PROFILE
STA. 204+00 TO STA. 210+00

JOB NO. 630239-202

SHEET 9 OF 28 SHTS

G.C. WALLACE COMPANIES
ENGINEERS | PLANNERS | SURVEYORS
5555 S. RAINBOW BOULEVARD - LAS VEGAS, NV 89146
T: 702.804.2000 - F: 702.804.2299 - GCWALLACE.COM

REV.	DATE	DESCRIPTION	DATE AGEN. APP.	DATE COM. APP.

DESIGN: GSW/GTP
DRAWN: GTP
CHECK: BAH
ISSUE DATE:
ISSUE EDITOR:
PLOT DATE: 02-12-13
PLOT TIME: 15:19:39

P:\Projects\NEW\630239-202\DWG\Production\202-C09.dwg

dsoley

DATE 2/27/13