


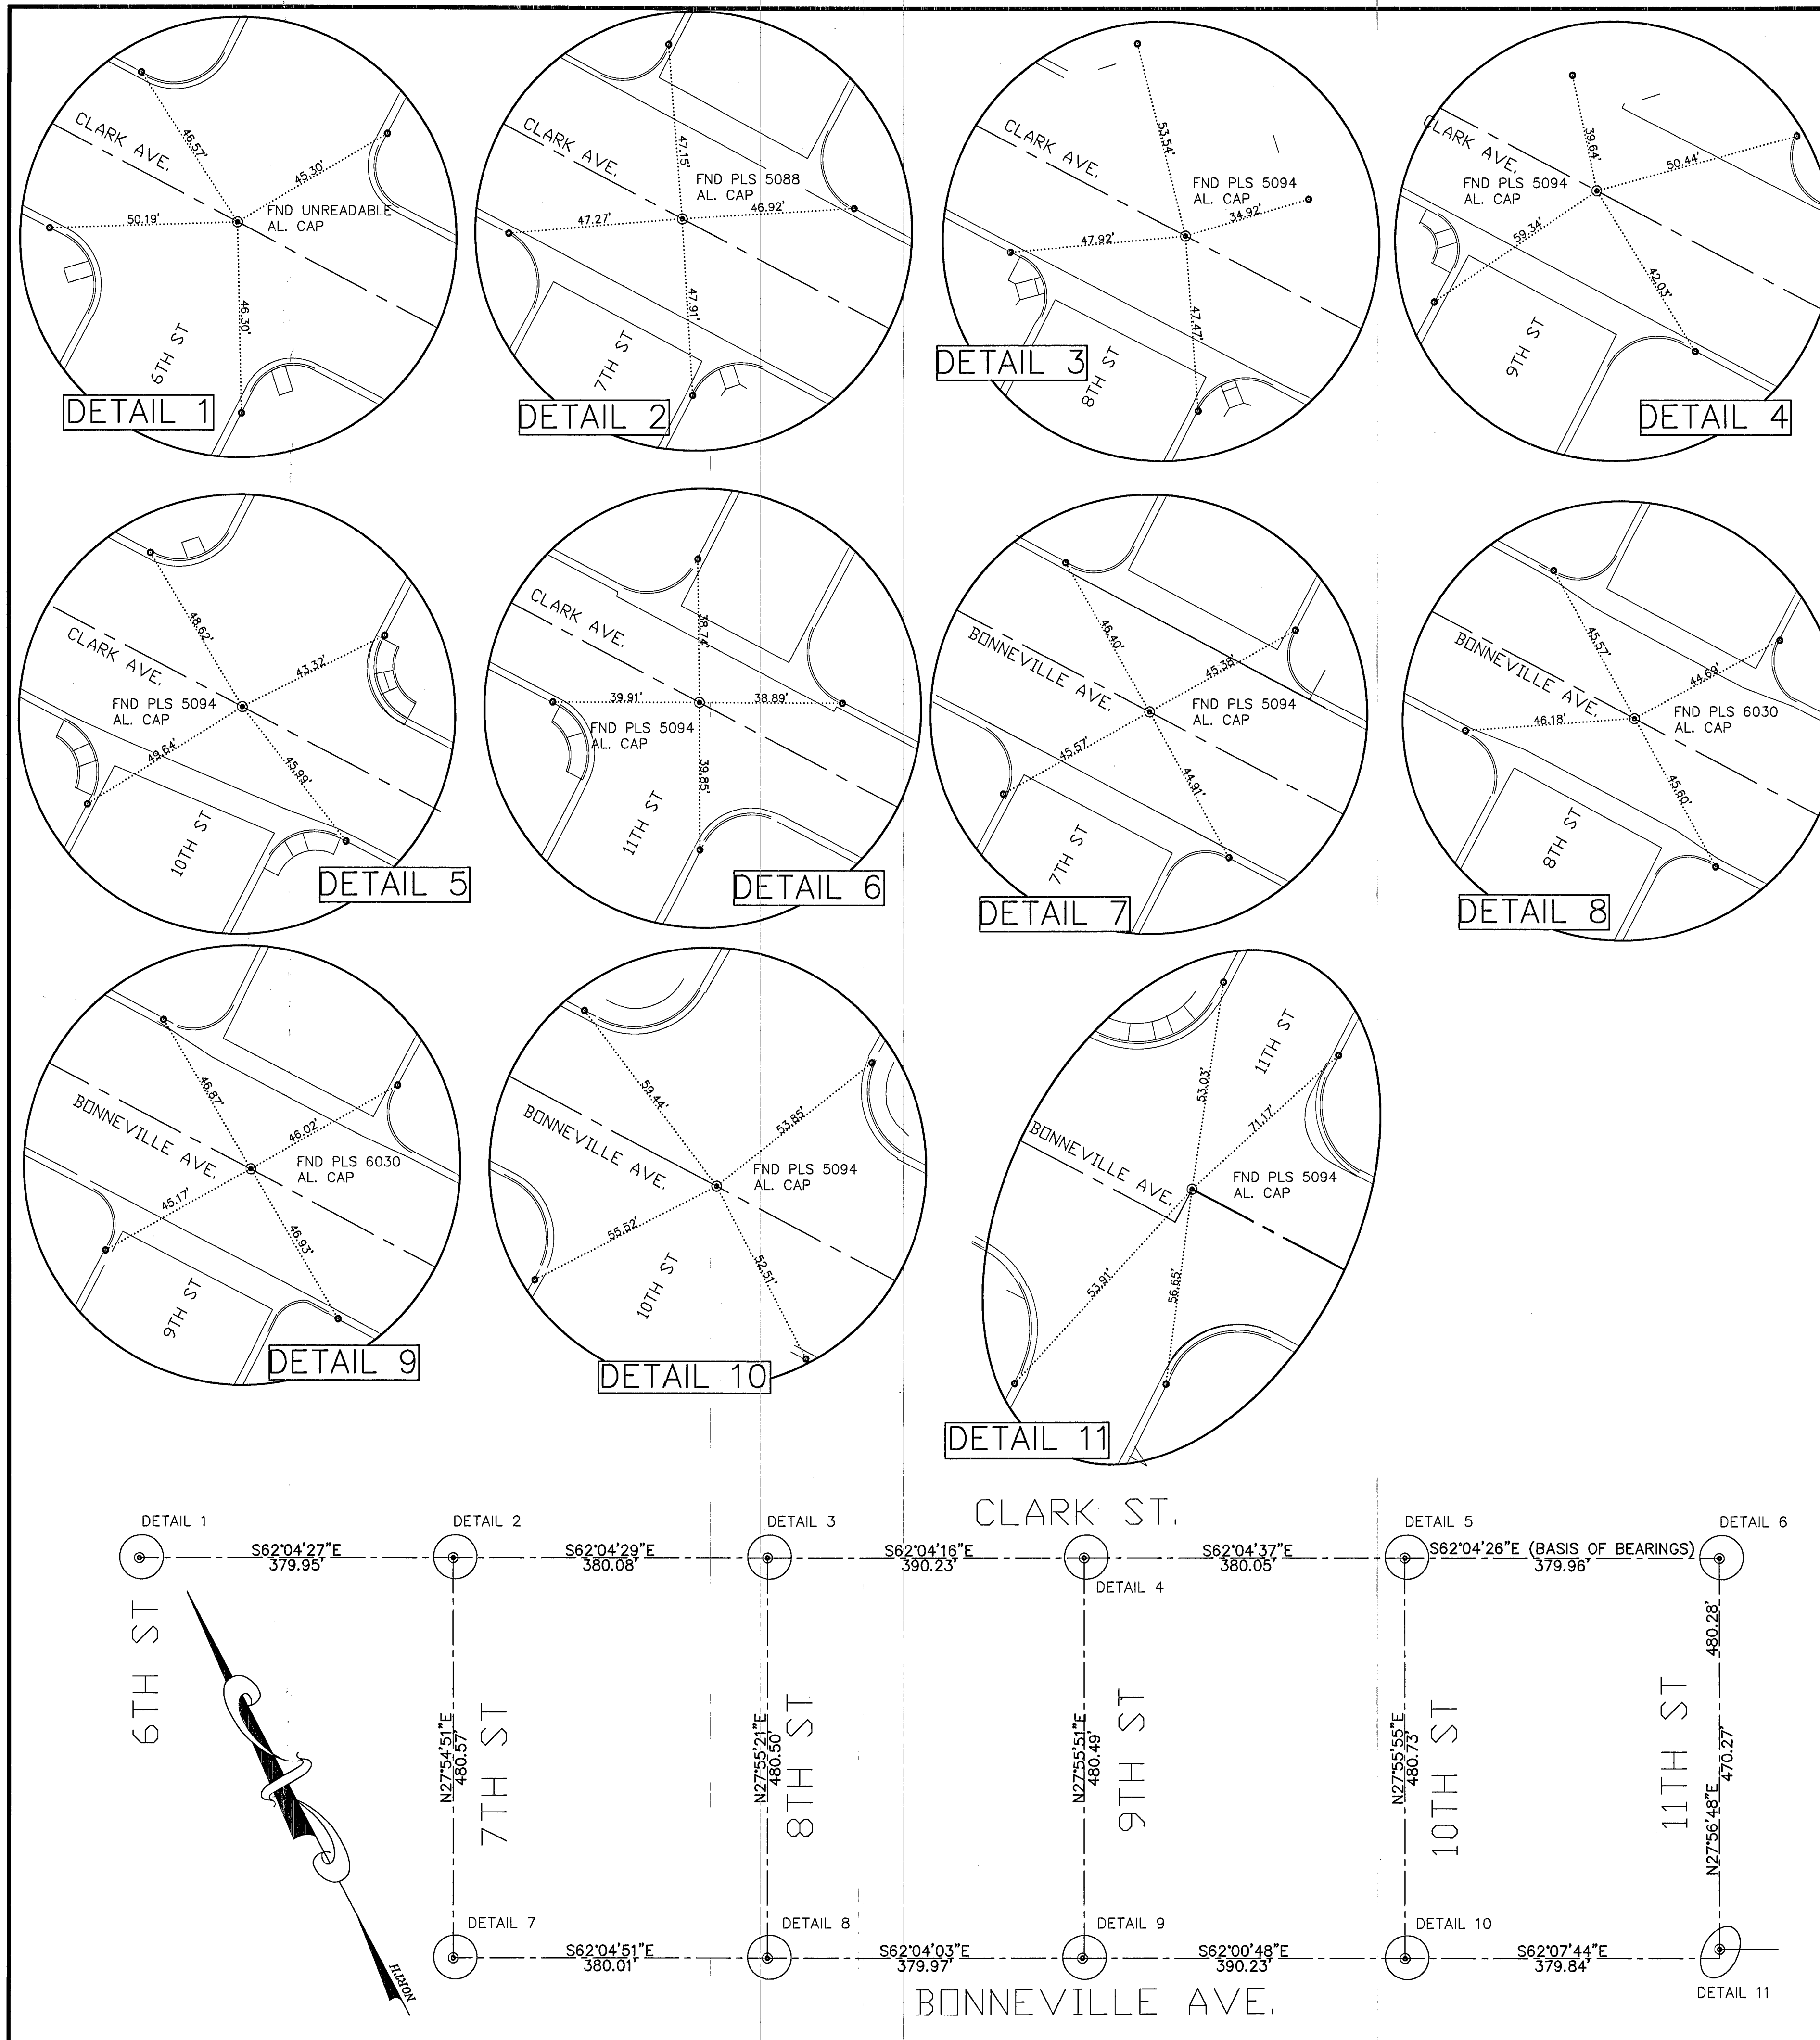

SURVEYOR'S CERTIFICATE

I, GERALD L. WIRTHLIN, A PROFESSIONAL LAND SURVEYOR IN THE STATE OF NEVADA, DO HEREBY CERTIFY THAT:

1. THIS PLAT REPRESENTS THE RESULTS OF A SURVEY CONDUCTED UNDER MY DIRECT SUPERVISION AT THE INSTANCE OF LAS VEGAS PAVING CORP.
2. THE LANDS SURVEYED LIE WITHIN THE SE 1/4 OF SECTION 34, TOWNSHIP 20 SOUTH, RANGE 61 EAST, M.D.M..
3. THIS PLAT COMPLIES WITH THE APPLICABLE STATE STATUTES AND ANY LOCAL ORDINANCES IN EFFECT ON THE DATE THAT THE GOVERNING BODY GAVE ITS FINAL APPROVAL.
4. THE MONUMENTS DEPICTED ON THE PLAT WILL BE OF THE CHARACTER SHOWN, OCCUPY THE POSITIONS INDICATED BY
5. THIS SURVEY WAS COMPLETED ON 2-10-2014.
6. CERTIFY THAT THE MONUMENTS HAVE BEEN SET AND THE TIE DISTANCES ESTABLISHED AS SHOWN HEREON

GERALD L. WIRTHLIN
PROFESSIONAL LAND SURVEYOR
NEVADA CERTIFICATE No. 7008




BASIS OF BEARINGS

THE BASIS OF BEARINGS FOR THIS SURVEY IS THE CENTERLINE OF CLARK ST. BETWEEN 10th AND 11th AS SHOWN IN FILE 67, PAGE 79 OF RECORDED SURVEYS OFFICIAL RECORDS, CLARK COUNTY, NEVADA. SAID LINE BEARS S62°04'26"E

LEGEND

- SET TYPE III MON., PLS 7008 (DESCRIPTION SHOWN IN DETAIL REFLECTS MONUMENT FOUND PRIOR TO CONSTRUCTION)
- TYPE IV REFERENCE MONUMENT
- CURB LINE
- CENTERLINE
- BOUNDARY LINE
- TIE LINE

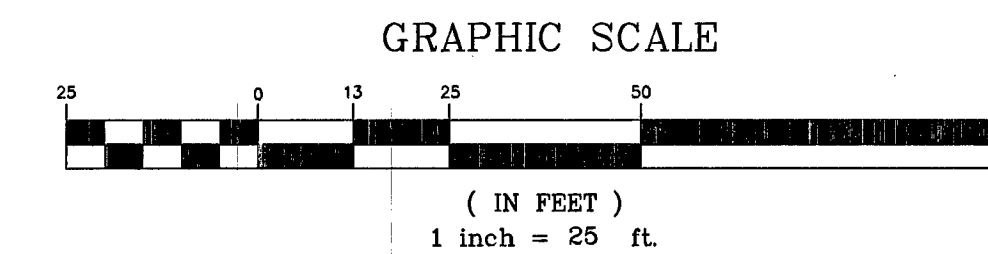

RECORDER'S NOTE

ANY SUBSEQUENT CHANGES TO THIS MAP SHOULD BE EXAMINED AND MAY BE DETERMINED BY REFERENCE TO THE COUNTY RECORDER'S CUMULATIVE MAP INDEX. N.R.S. 278.5695

RECORD OF SURVEY

A PORTION OF THE SE 1/4
OF SECTION 34, TOWNSHIP 20 SOUTH, RANGE 61 EAST, M.D.M.,
CLARK COUNTY, NEVADA

LAS VEGAS PAVING CORPORATION

LAS VEGAS PAVING CORP.
GERALD "CROCKETT" WIRTHLIN
PLS #7008

649-0009
OFFICE
353-4363
MOBILE

056-052

No.	
FILED AT THE REQUEST OF:	LAS VEGAS PAVING CORP.
DATE:	AT
FILE:	PAGE:
OF SURVEYS	OFFICIAL RECORDS BOOK No.
CLARK COUNTY, NEVADA RECORDS	DEBBIE CONWAY, RECORDER
FEE:	DEPUTY

H48103-T2
MFC
5/14/14
APPROVED

