


BELCASTRO ESTATES

A SUBDIVISION OF THE EAST HALF (E 1/2) OF THE NORTHWEST QUARTER (NW 1/4) OF THE SOUTHWEST QUARTER (SW 1/4) OF THE SOUTHEAST QUARTER (SE 1/4) OF SECTION 3, TOWNSHIP 21 SOUTH, RANGE 60 EAST, M.D.B. & M., CLARK COUNTY NEVADA

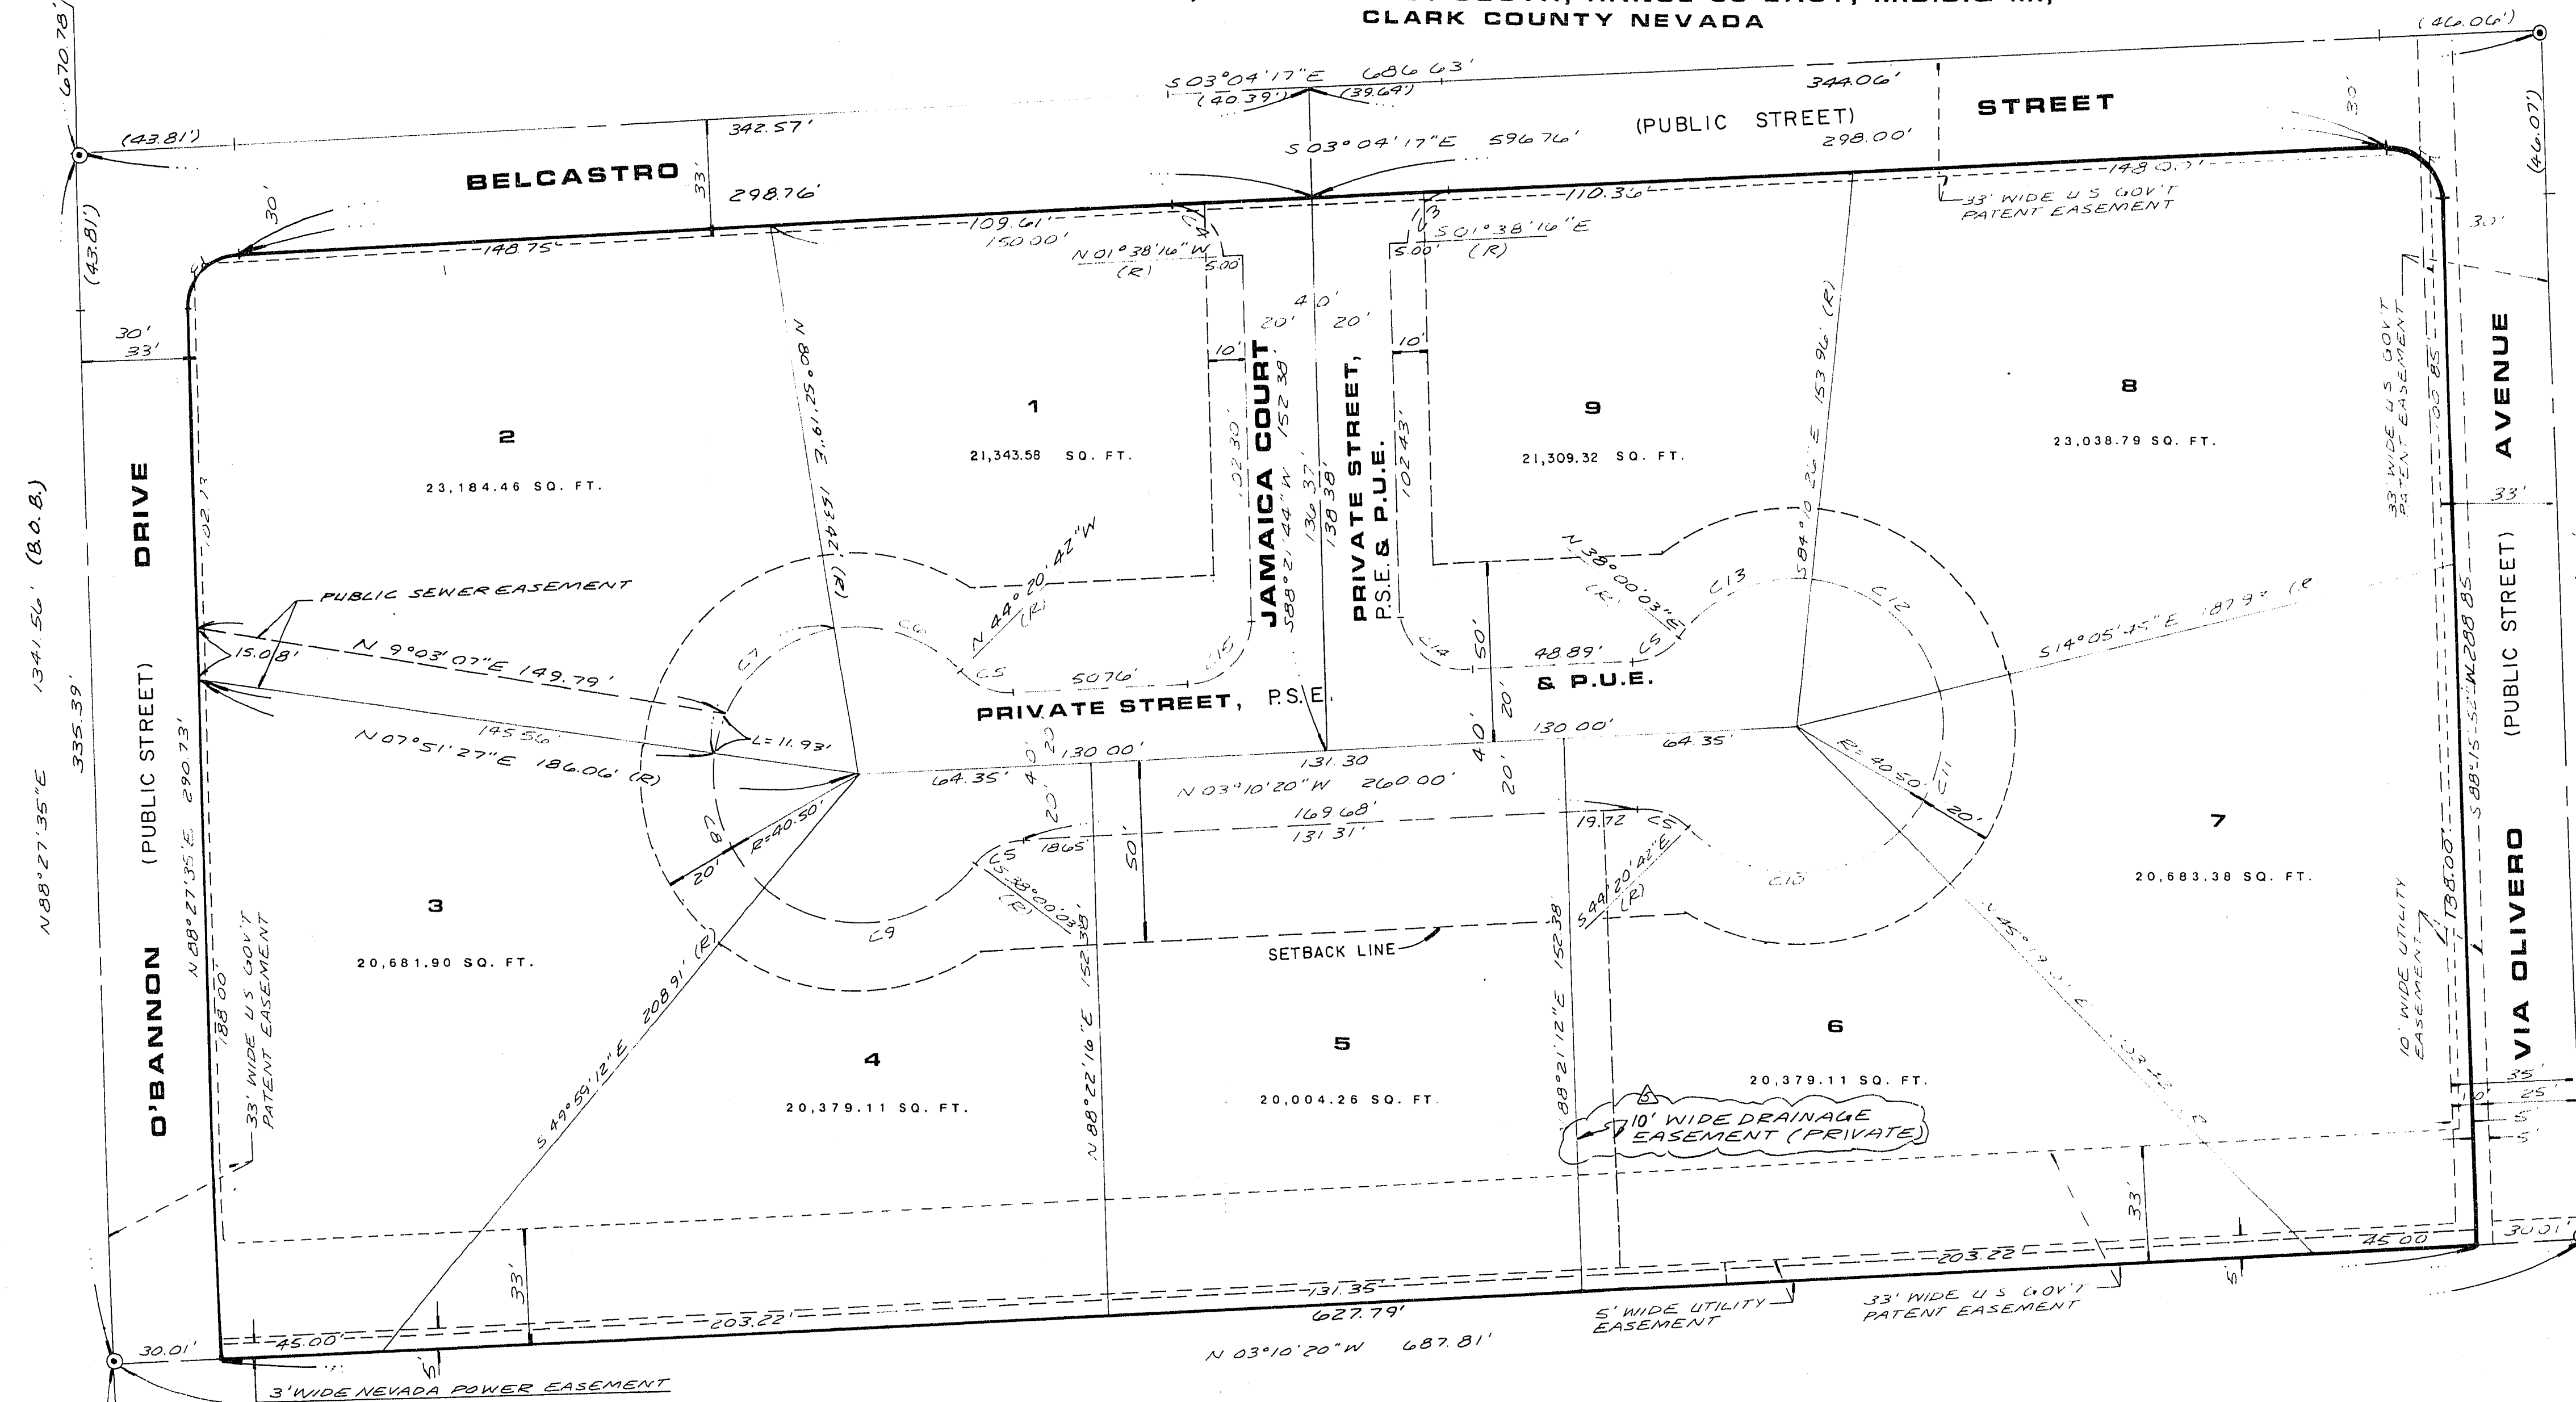


LEGEND

- ⊙ SET 5/8 REBAR & R.L.S. 6015 ALUMINUM CAP WITH REFERENCE TIES SET IN TOP OF CURB
- 1/16 SECTION CORNER
- 6 LOT NUMBER
- CS CURVE NUMBER
- P.U.E. PUBLIC UTILITY EASEMENT
- P.S.E. PUBLIC SEWER EASEMENT

BASIS OF BEARING

N 88° 27' 35" E BEING THE NORTH LINE OF THE SW 1/4 OF THE SE 1/4 OF SECTION 3, T. 21 S., R. 60 E., M.D.M., PER FILE 31, PAGE 12 OF PARCEL MAPS.

CURVE	ARC	DELTA	RADIUS	TAN LENGTH
C1	23.16	88° 28' 08"	15.00	14.60
C2	23.91	91° 20' 10"	15.00	15.35
C3	23.19	88° 33' 58"	15.00	14.63
C4	23.94	91° 26' 02"	15.00	15.38
C5	16.62	48° 49' 38"	19.50	8.85
C6	38.72	54° 46' 59"	40.50	20.99
C7	51.61	73° 00' 52"	40.50	29.98
C8	40.89	57° 50' 39"	40.50	22.38
C9	65.04	92° 00' 45"	40.50	41.95
C10	63.85	90° 20' 10"	40.50	40.74
C11	42.00	59° 24' 52"	40.50	23.11
C12	49.54	70° 04' 41"	40.50	28.40
C13	40.87	57° 49' 32"	40.50	22.37
C14	23.96	91° 32' 04"	15.00	15.41
C15	23.16	88° 27' 56"	15.00	14.60

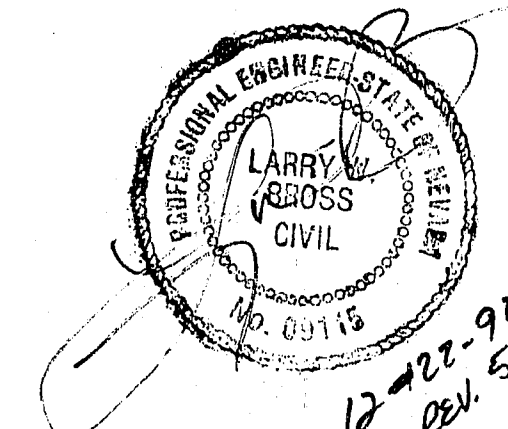

12-22-92
for Rev. 5 only

REVISION NO.	DESCRIPTION	BY	DATE	APPROVAL
1	REVISED ESM'T. NOTE	LWB	12-21-92	
2	REVISED BOUNDARY, REVISED EASEMENTS, ADDED SETBACK LINES	TLO	3/23/90	

REVISIONS

BELCASTRO ESTATES

LAS VEGAS NEVADA

**HORIZONTAL CONTROL MAP
REFERENCE ONLY**

SCALE (H) 1"=30'	SCALE (V)
DES. TLO	
DR. TLO	
CHK. BY:	
JOB NO. 2355B	
SHEET 2 OF 6	

1074-4098