

SHEET 4 OF 6
JOB NO. 9011-02-02
DWG DATE 02/12/91
DWG NAME CHERRY MEADOWS

JOB TITLE
CHERRY MEADOWS
WATER & SEWER PLAN
NEVADA

ALCA
ENGINEERING & SURVEYING, INC.
850 S. VALLEY VIEW BOULEVARD
LAS VEGAS, NEVADA 89107-4411
(702) 878-3358 FAX: 878-1092

SCALE (H) 1" = 30'
SCALE (V) 1" = 5'
DES. RWC
DR. ARS
SECTION 33 T.20 S. R. 60 E.


NO.	REVISION	DATE
1	ISSUED FOR PERMITS	5-2-91
2	REVISED TO SHOW LINE BOUNDARY	5-2-91
3	REVISED TO SHOW DRIVE	4-24-91
4	REVISED TO SHOW DRIVE	4-24-91
DATE 5-11-91
DATE 3/22/91
CITY OF LAS VEGAS FIRE MARSHALL
REQUIRE FIRE FLOW = 1500 GPM
RESIDUAL PRESSURE = 20 PSI

QUANTITY ESTIMATES
WATER
6" WATER LINE 388 LF
8" WATER LINE 56 LF
FIRE HYDRANT AND ASSY. 2 EA
3/4" SERVICE AND 1/2" WATER 15 EA
SEWER
8" SEWER LINE 456 LF
4" SEWER LATERALS 296 LF
SEWER MANHOLES 3 EA


NOTE:
FIRE HYDRANT TO BE LOCATED 18" BEHIND BACK OF SIDEWALK ON CHERRY RIVER DRIVE AND CHERRY MEADOWS COURT, PER V.T.E. 3
LEGEND
EXISTING SEWER MAIN (S)
EXISTING WATER MAIN (W)
EXISTING FIRE HYDRANT
PROPOSED SEWER MAIN
PROPOSED WATER MAIN
PROPOSED FIRE HYDRANT
PROPOSED SIDEWALK
PROPOSED DRIVEWAY LOCATION
BLOW-OFF
B.O.

Call before you Dig
1-800-227-2600
Underground Utility Alert (USA)
Locate existing underground utility lines before digging.

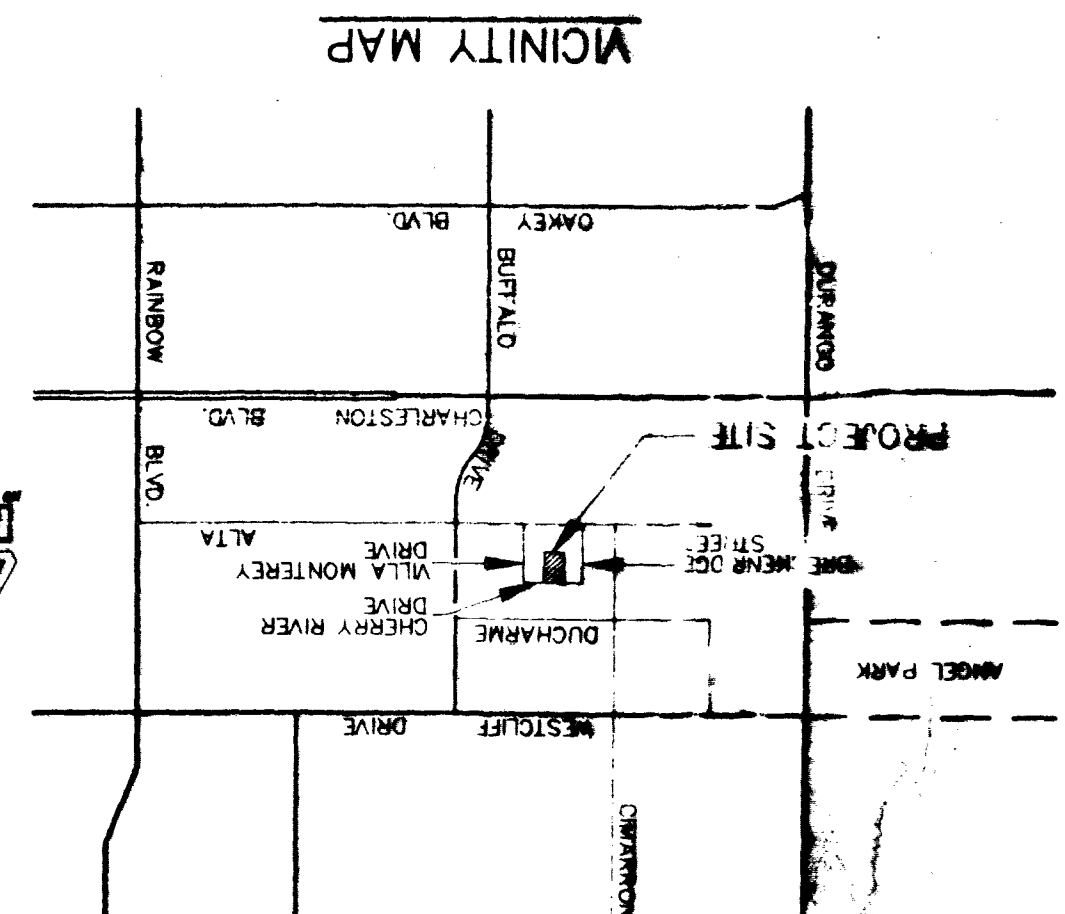

SERVICE LATERALS FOR LOTS 1, 2 & 12-15 WILL BE TAPPED ON EXISTING MAIN BY OWNER'S CONTRACTOR UNDER DIRECTION OF THE LAS VEGAS VALLEY WATER DISTRICT.

PROJECT NAME: CHERRY MEADOWS
DATE: 3-21-91
DRAWN BY: [Signature]
CHECKED BY: [Signature]
NOTED BY: [Signature]

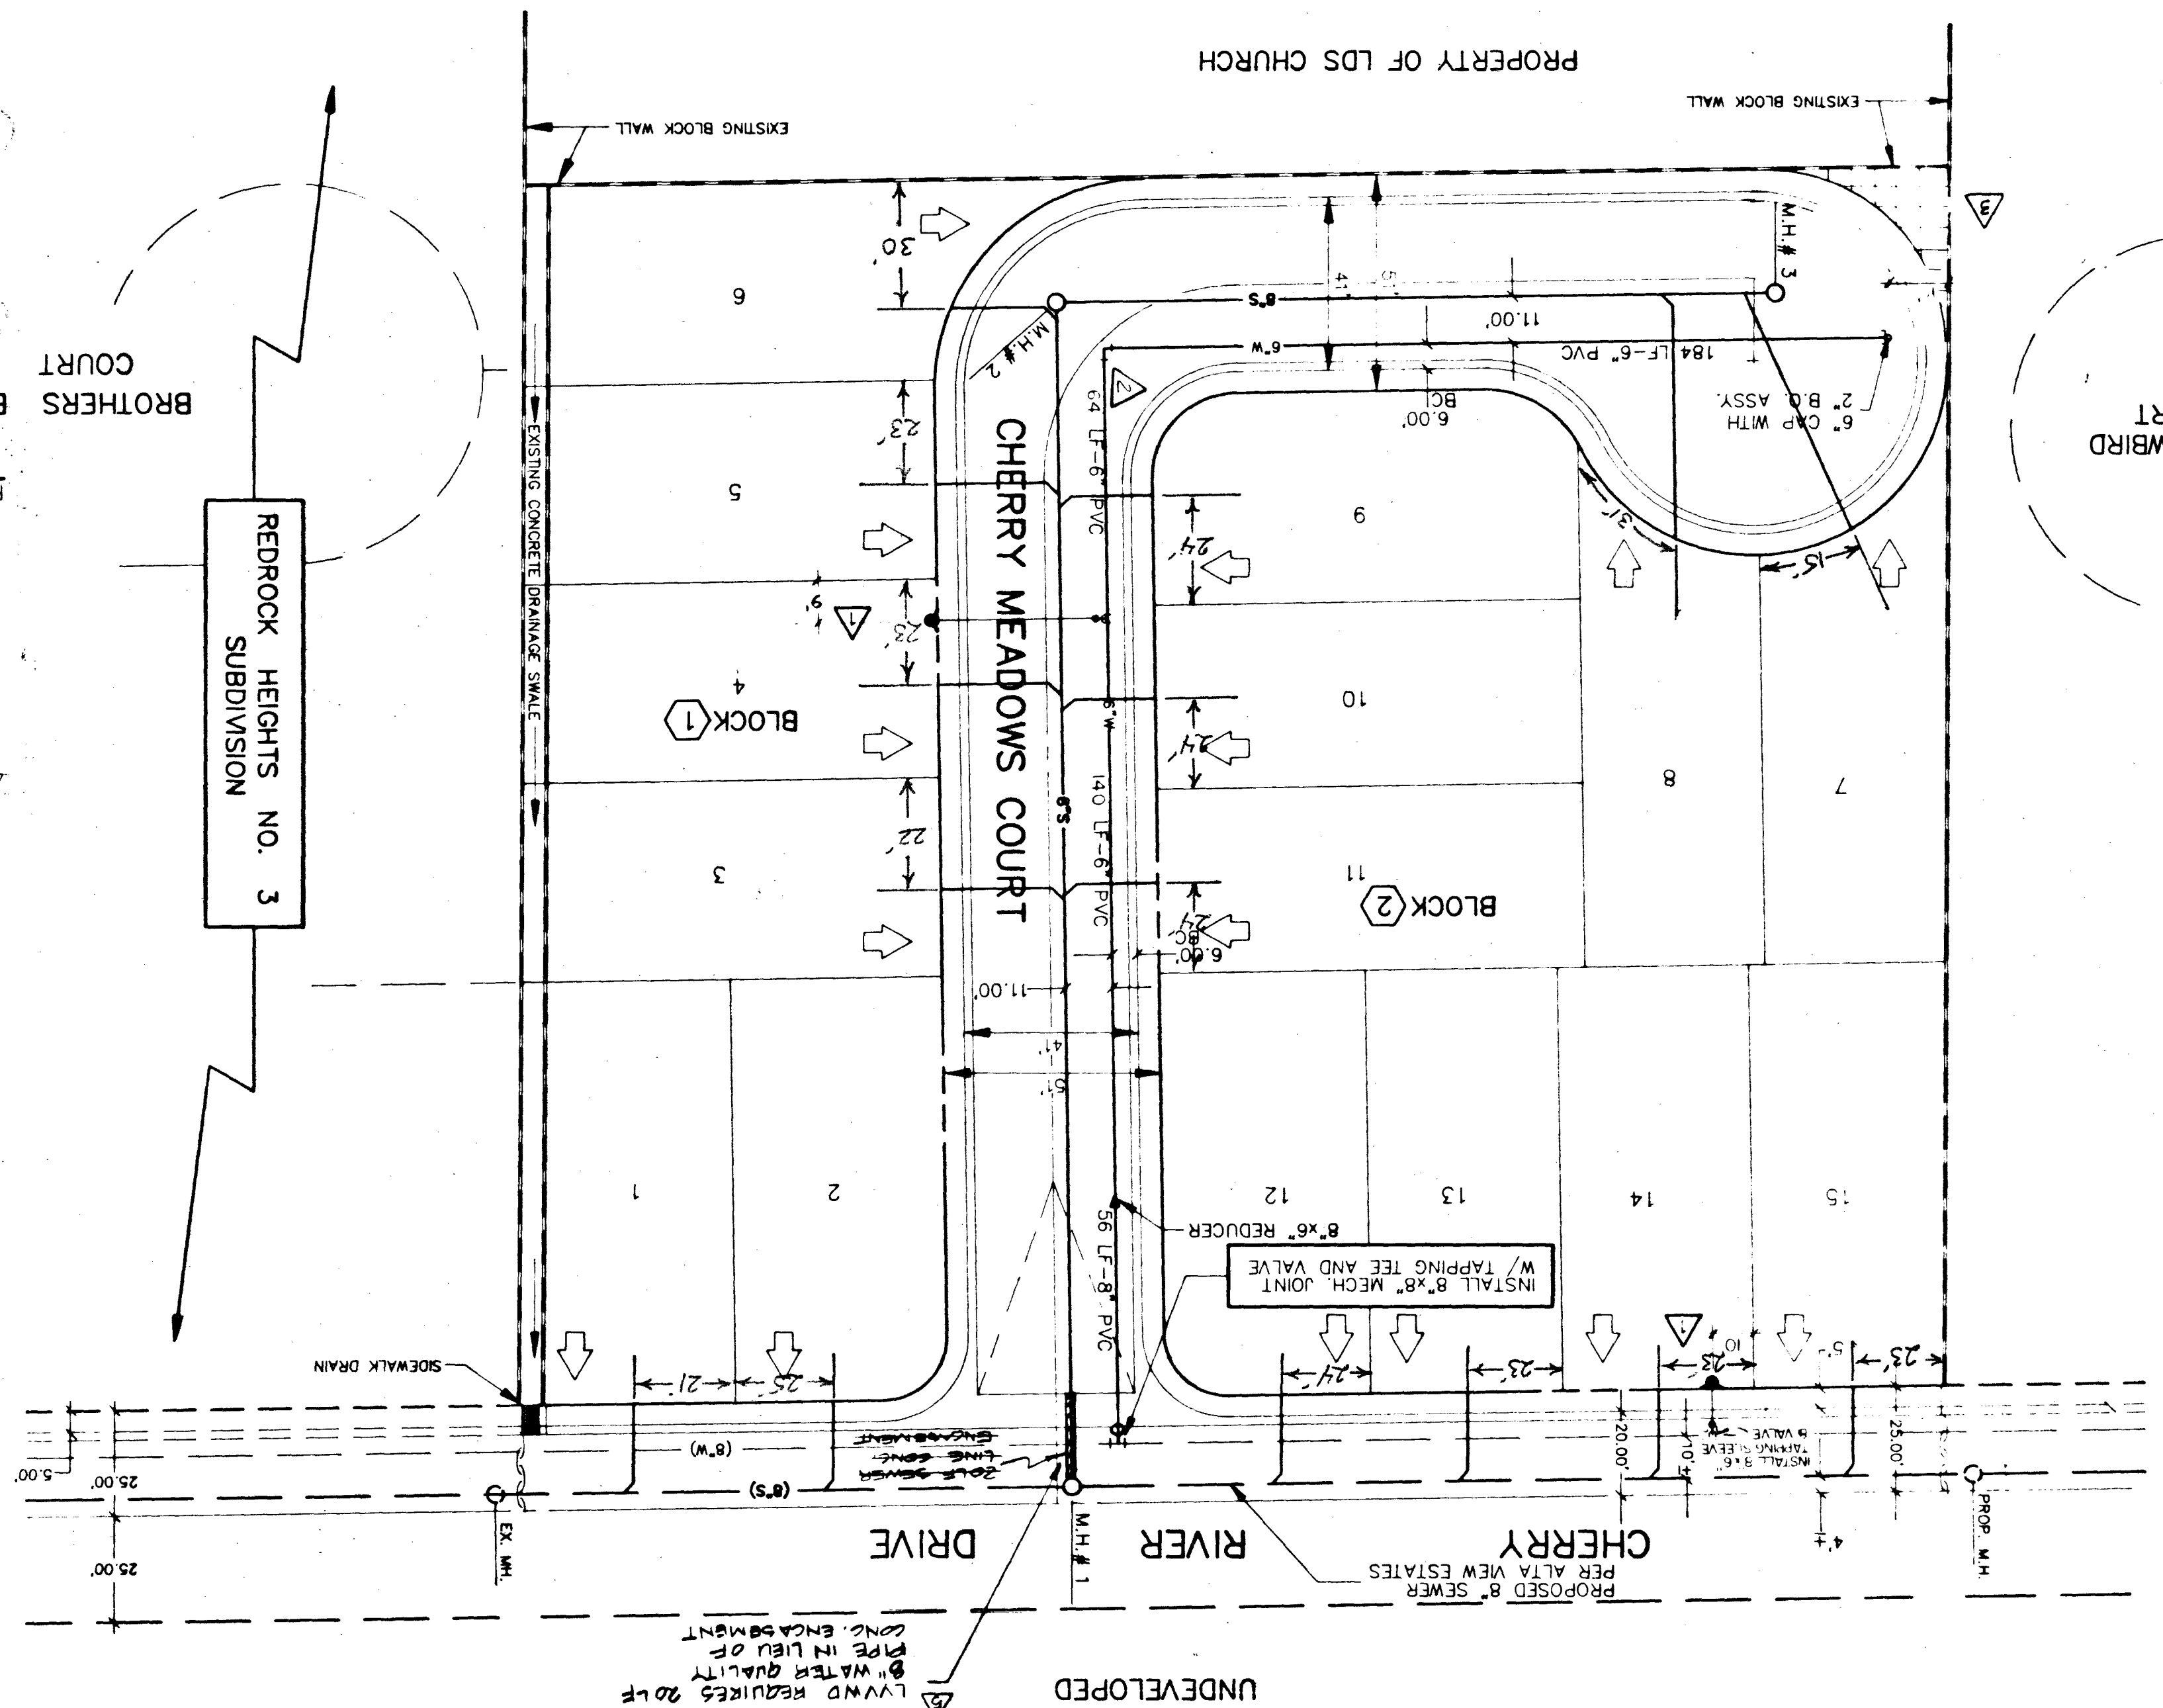

SCALE 1" = 30'

[illegible]

DR. J. S. K. S.





