



BALSAM STREET SECTION

N.T.S. **A**

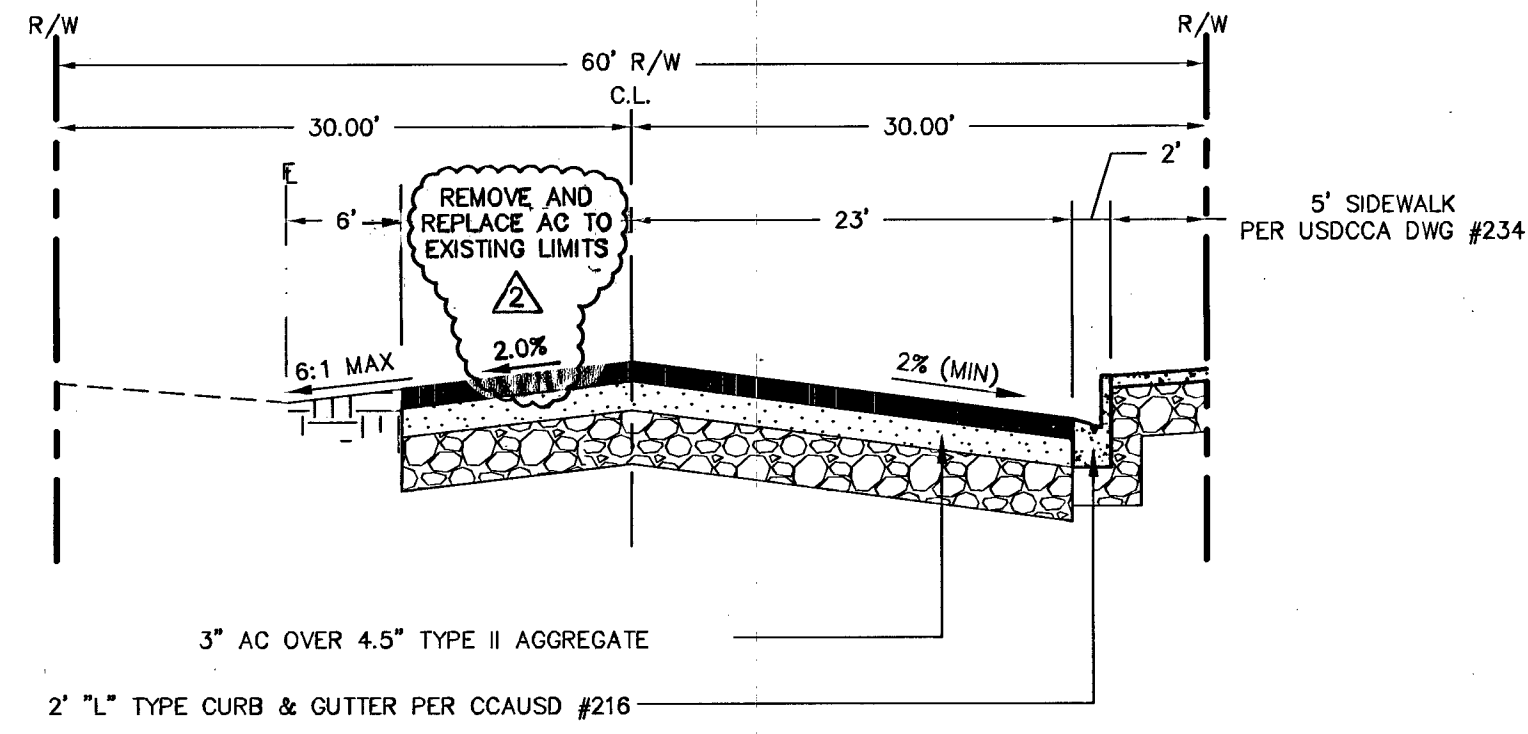


RED COACH AVENUE SECTION

N.T.S. **B**

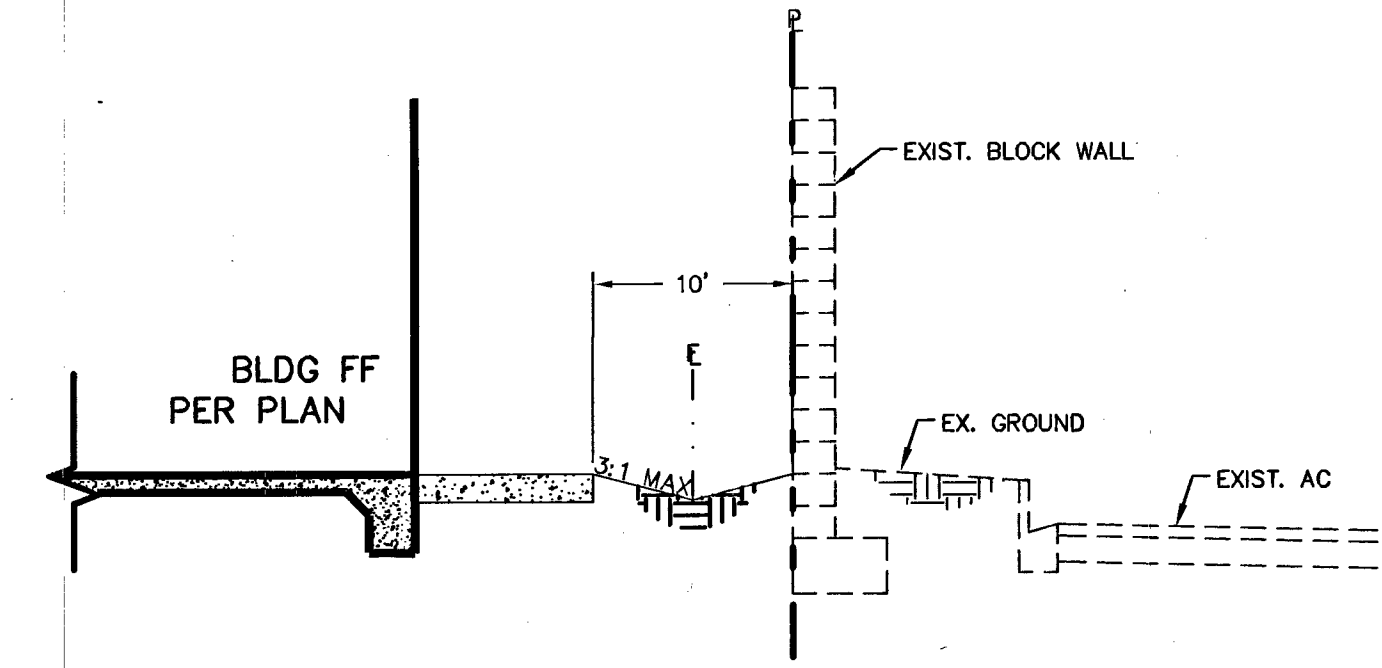


SECTION - EAST PROPERTY LINE

N.T.S. **C**

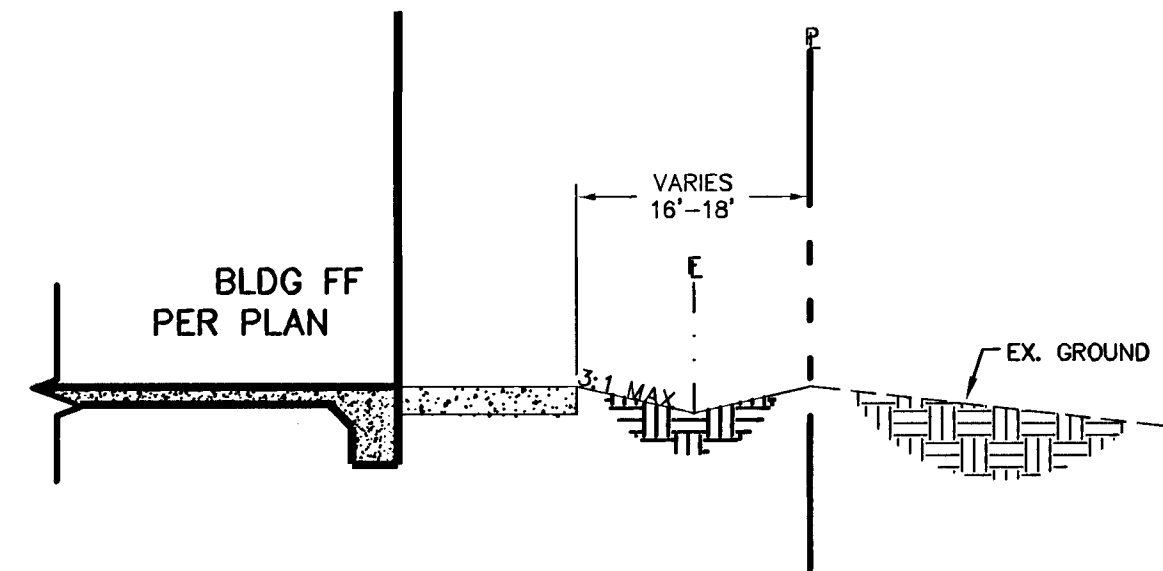


SECTION - SOUTH PROPERTY LINE

N.T.S. **D**

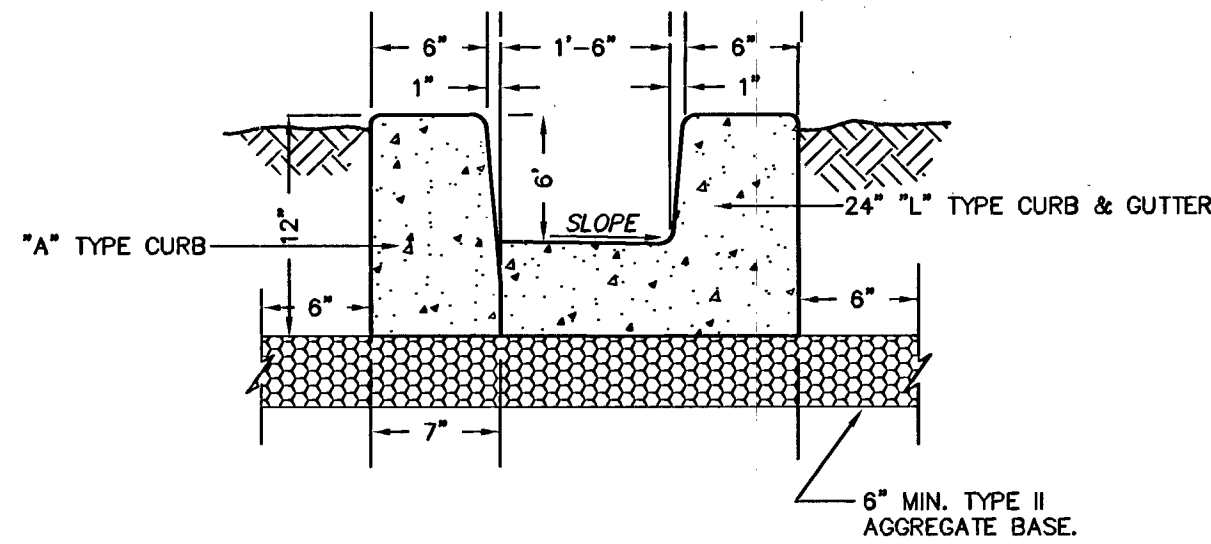

DETAIL- SLOT GUTTER

N.T.S. **1**

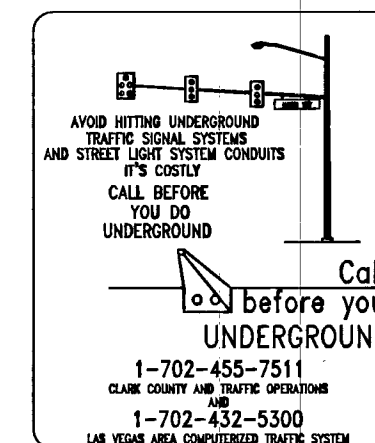


DISCLAIMER NOTE

UTILITY LOCATIONS SHOWN HEREON ARE APPROXIMATE ONLY. IT SHALL BE THE CONTRACTOR'S RESPONSIBILITY TO DETERMINE THE EXACT HORIZONTAL AND VERTICAL LOCATION OF ALL EXISTING UNDERGROUND AND OVERHEAD UTILITIES PRIOR TO COMMENCING CONSTRUCTION. NO REPRESENTATION IS MADE THAT ALL EXISTING UTILITIES ARE SHOWN HEREON. THE ENGINEER ASSUMES NO RESPONSIBILITY FOR UTILITIES NOT SHOWN OR UTILITIES NOT SHOWN IN THEIR PROPER LOCATION.




HTE: 14-3333

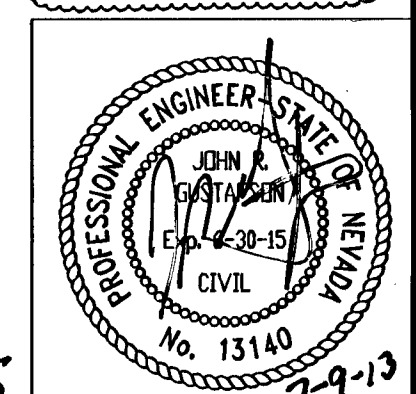

CLV * 49481/107V6065

KABOOM BATTING ACADEMY
DETAIL SHEET
 SECTION 3, TOWNSHIP 20 SOUTH, RANGE 60 EAST, M.D.B. & M. LAS VEGAS
 APN: 138-03-602-018

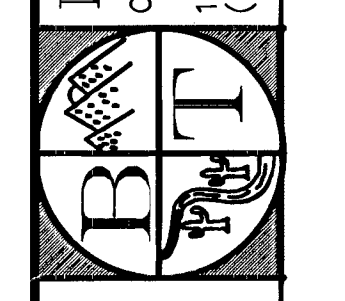

BAUGHMAN & TURNER, INC.
 CIVIL ENGINEERS
 1210 HINSON STREET
 LAS VEGAS, NEVADA 89102
 (702) 870-8771

DATE: FEBRUARY 2013
 DESIGN: MJ
 DRAWN: CR
 CHECK: RB
 SCALE: NTS

PREPARED FOR:
WHEELER/LIVERI
 50 EAST NORTH TEMPLE STREET
 SALT LAKE CITY, UTAH 84102

DATE: 04/14/14
 REVISIONS:
 1. 04/14/14 CLARK COUNTY REVENUE COMMENTS
 2. 04/14/14

SHEET
DT1
 OF
3 OF 8
 PROJ. NO.
 WHEELER/LIVERI