
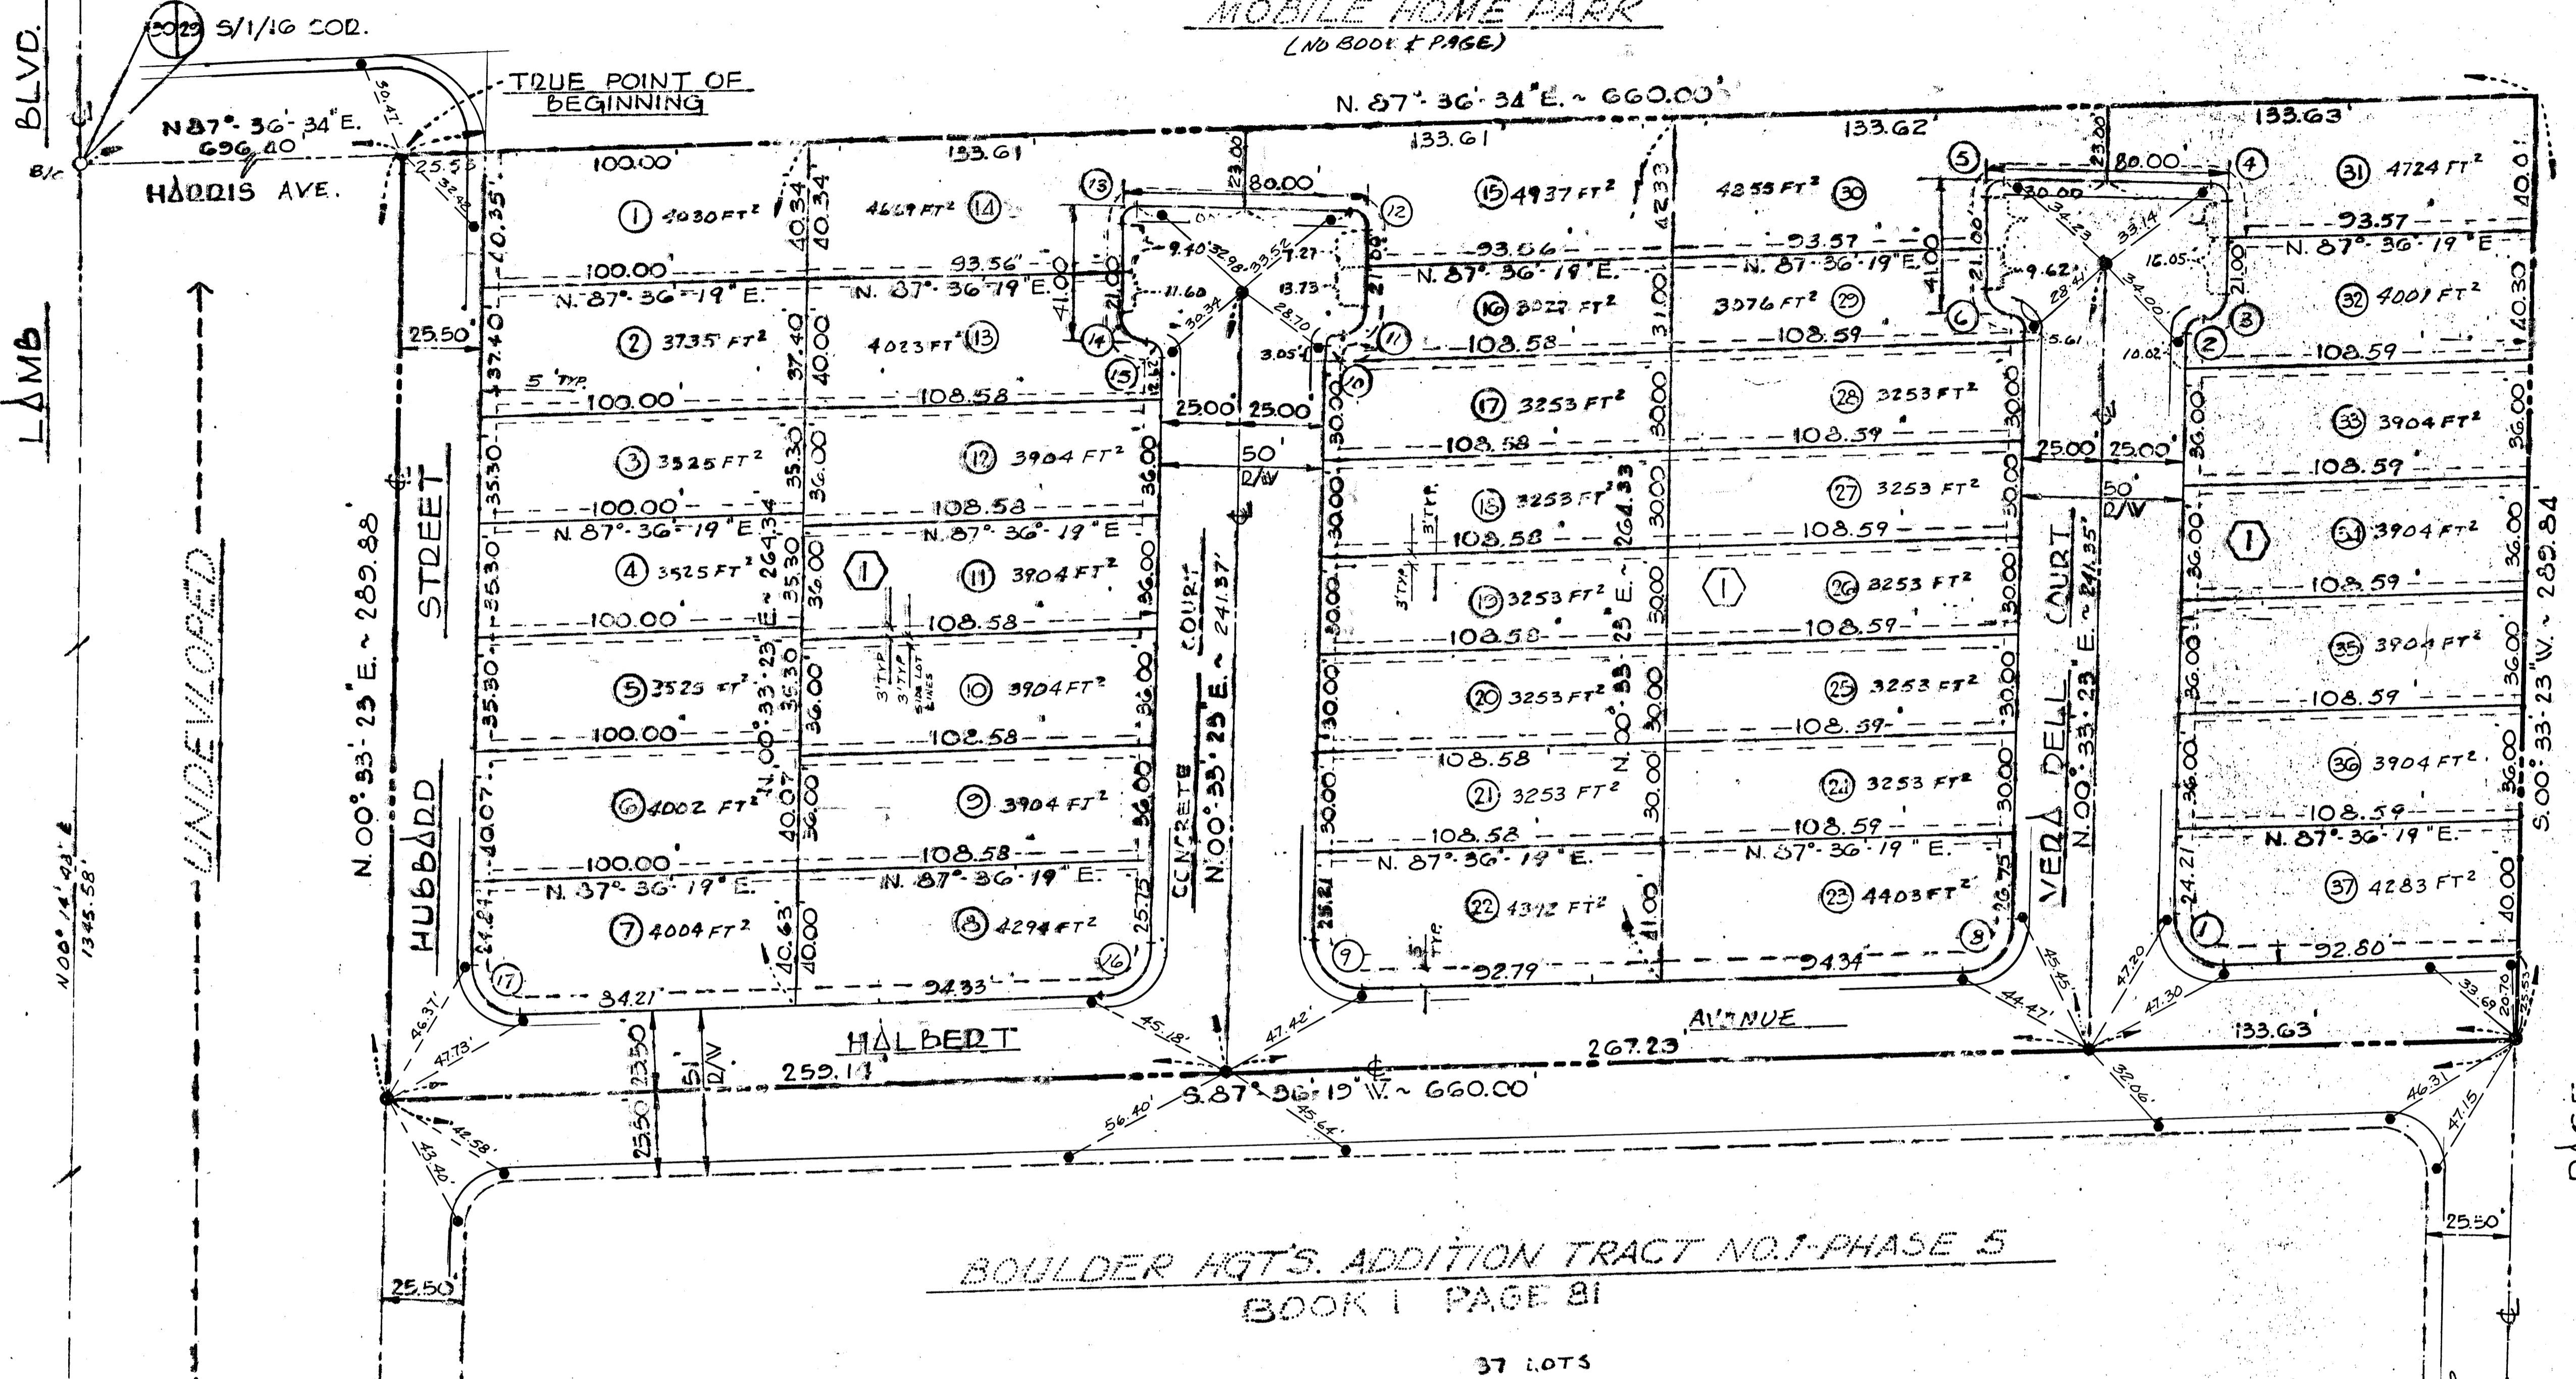


MONUMENT MAP

MOBILE HOME PARK
(NO BOOK & PAGE)

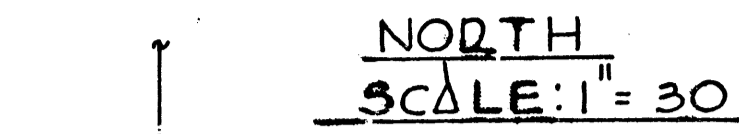

BOULDER HGT'S. ADDITION TRACT NO. 1-PHASE 5
BOOK 1 PAGE 81

37 LOTS

LEGEND

- 16' SETBACK LINE TO GARAGE DOOR
- SUBDIVISION BOUNDARY LINE
- LOT LINE
- LOT NUMBER
- Ⓢ BLOCK NUMBER
- Ⓢ RECORDED AL CO. RLS # 4134
- SET 1" BRASS CAP IN TOP OF CURB WITH THE DISTANCE STAMPED IN CAP
- 5/4 PL NAIL W/TIES

CURVE DATA

NO.	Δ	R.	L.	T.
1	92° 37' 04"	15.00'	24.33'	15.79'
2	90° 00' 00"	5.00'	7.85'	5.00'
3	"	10.00'	15.71'	10.00'
4	"	"	"	"
5	"	"	"	"
6	"	10.00'	15.71'	10.00'
7	90° 00' 00"	5.00'	7.85'	5.00'
8	87° 02' 56"	15.00'	22.79'	14.25'
9	92° 57' 04"	15.00'	24.33'	15.79'
10	90° 00' 00"	5.00'	7.85'	5.00'
11	"	10.00'	15.71'	10.00'
12	"	"	"	"
13	"	"	"	"
14	"	10.00'	15.71'	10.00'
15	90° 00' 00"	5.00'	7.85'	5.00'
16	87° 02' 56"	15.00'	22.79'	14.25'
17	92° 57' 04"	15.00'	24.33'	15.79'

I, KENNETH D. FARRIMOND, A PROFESSIONAL LAND SURVEYOR IN THE STATE OF NEVADA, DO HEREBY CERTIFY THAT THE MONUMENTS HAVE BEEN SET AND THE DISTANCE IS AS SHOWN HEREON. THE SURVEY WAS COMPLETED ON FEB. 22, 1990.



31190

1-6-37