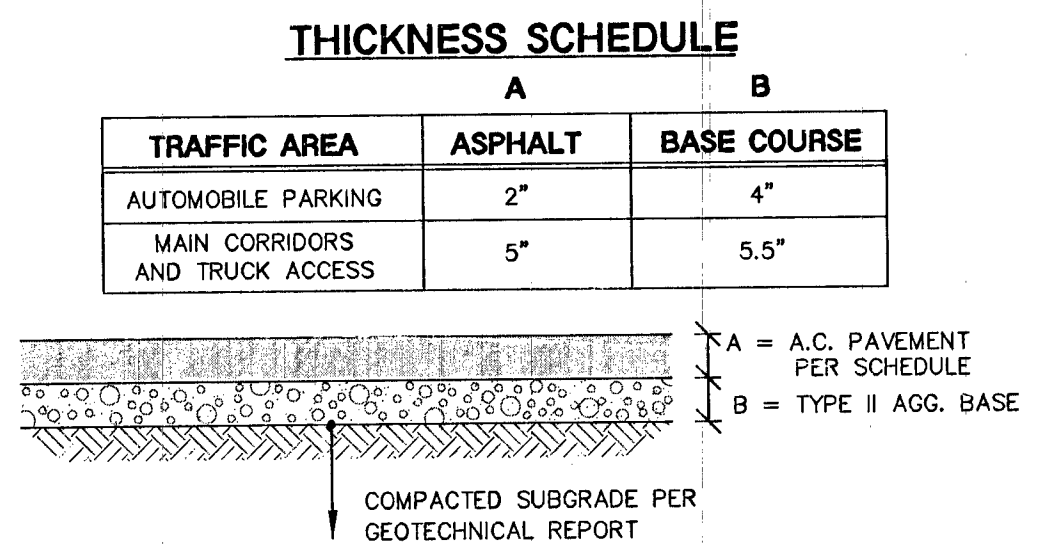
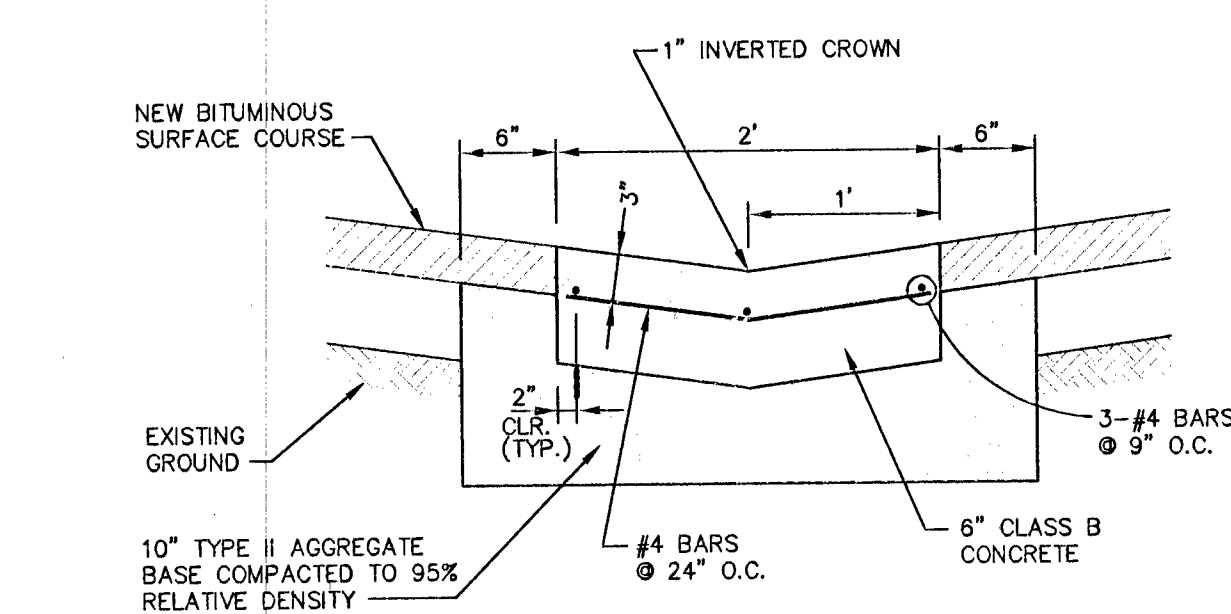
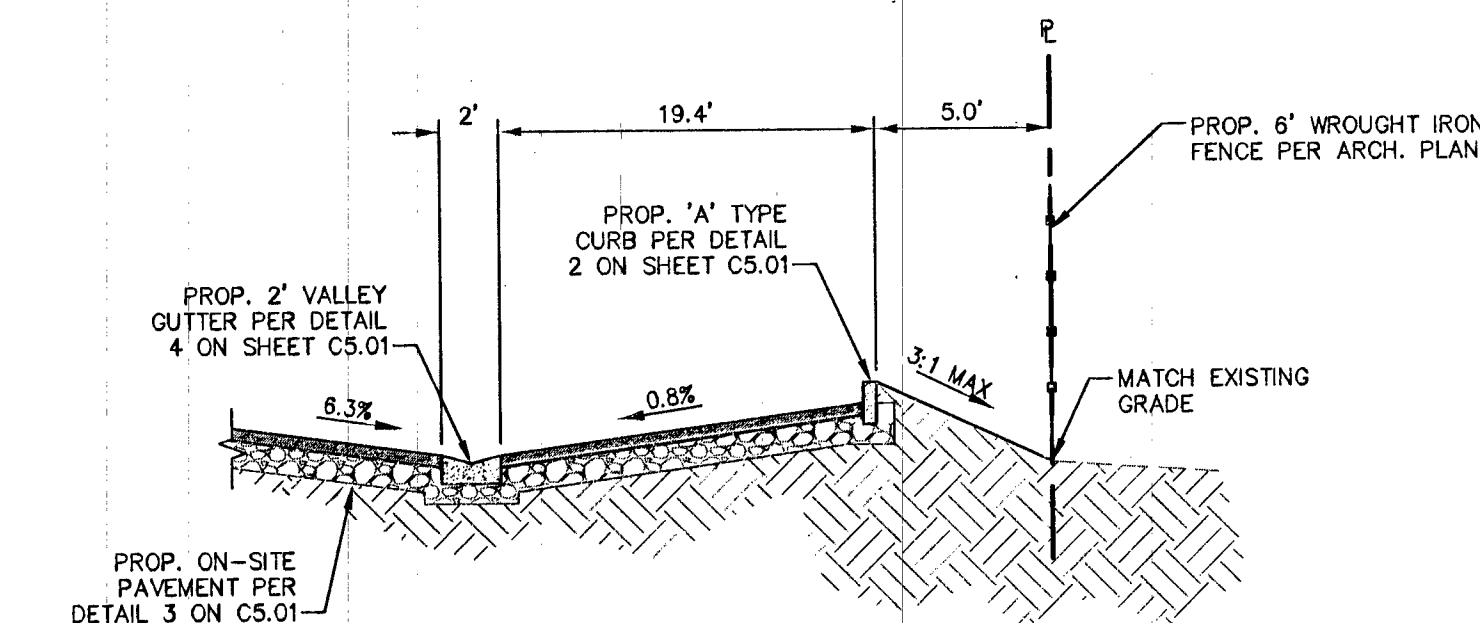
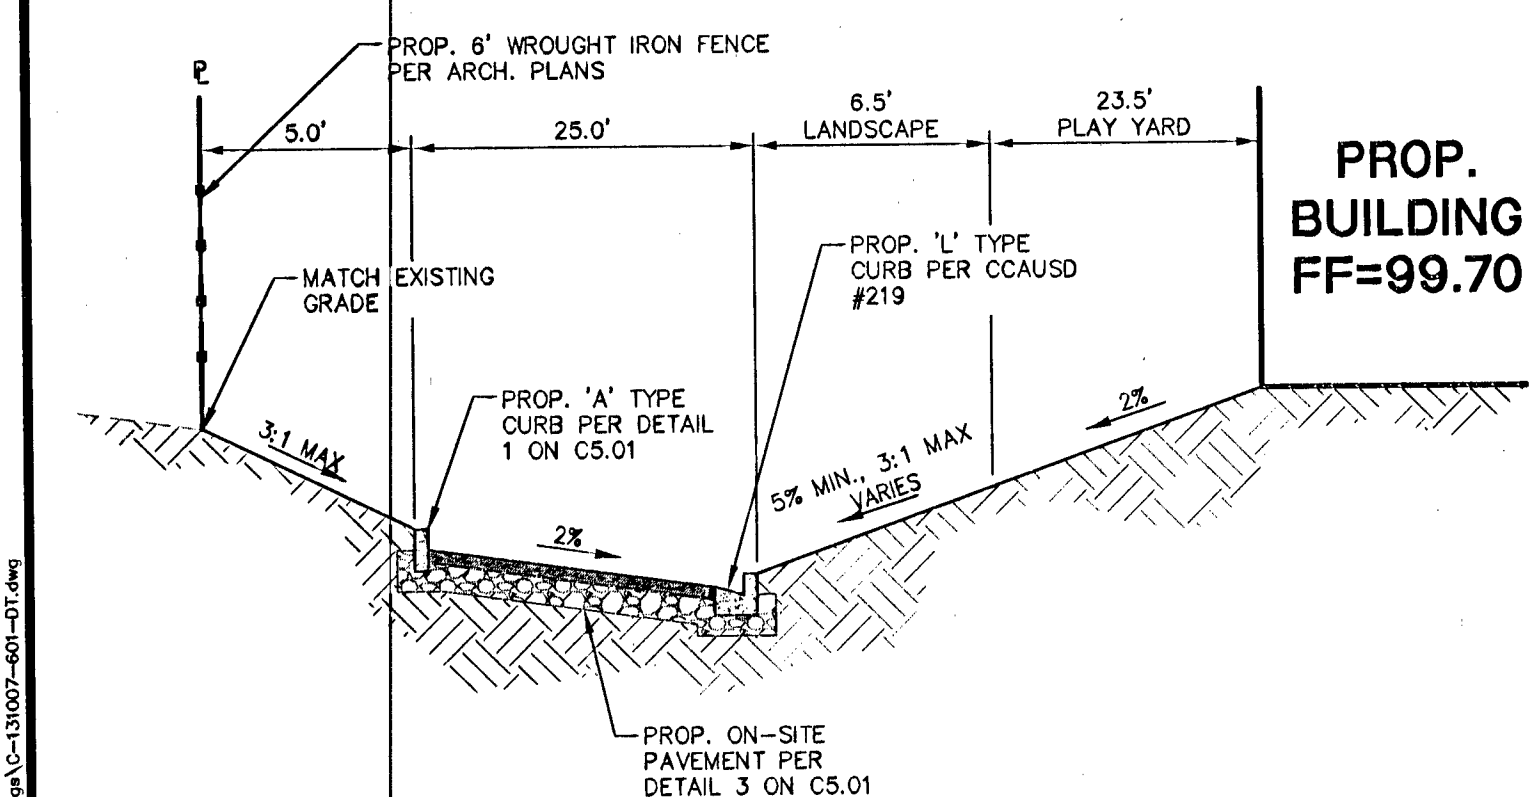
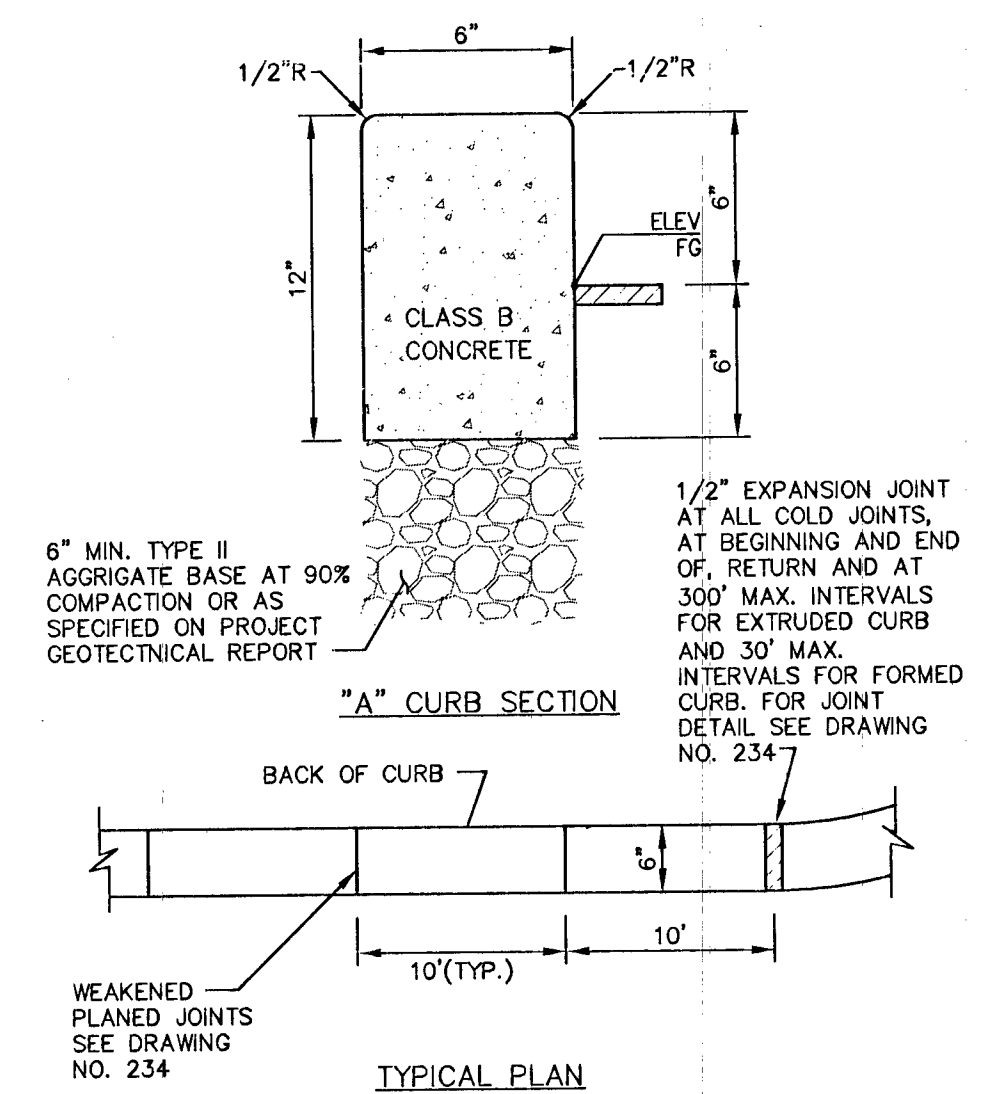
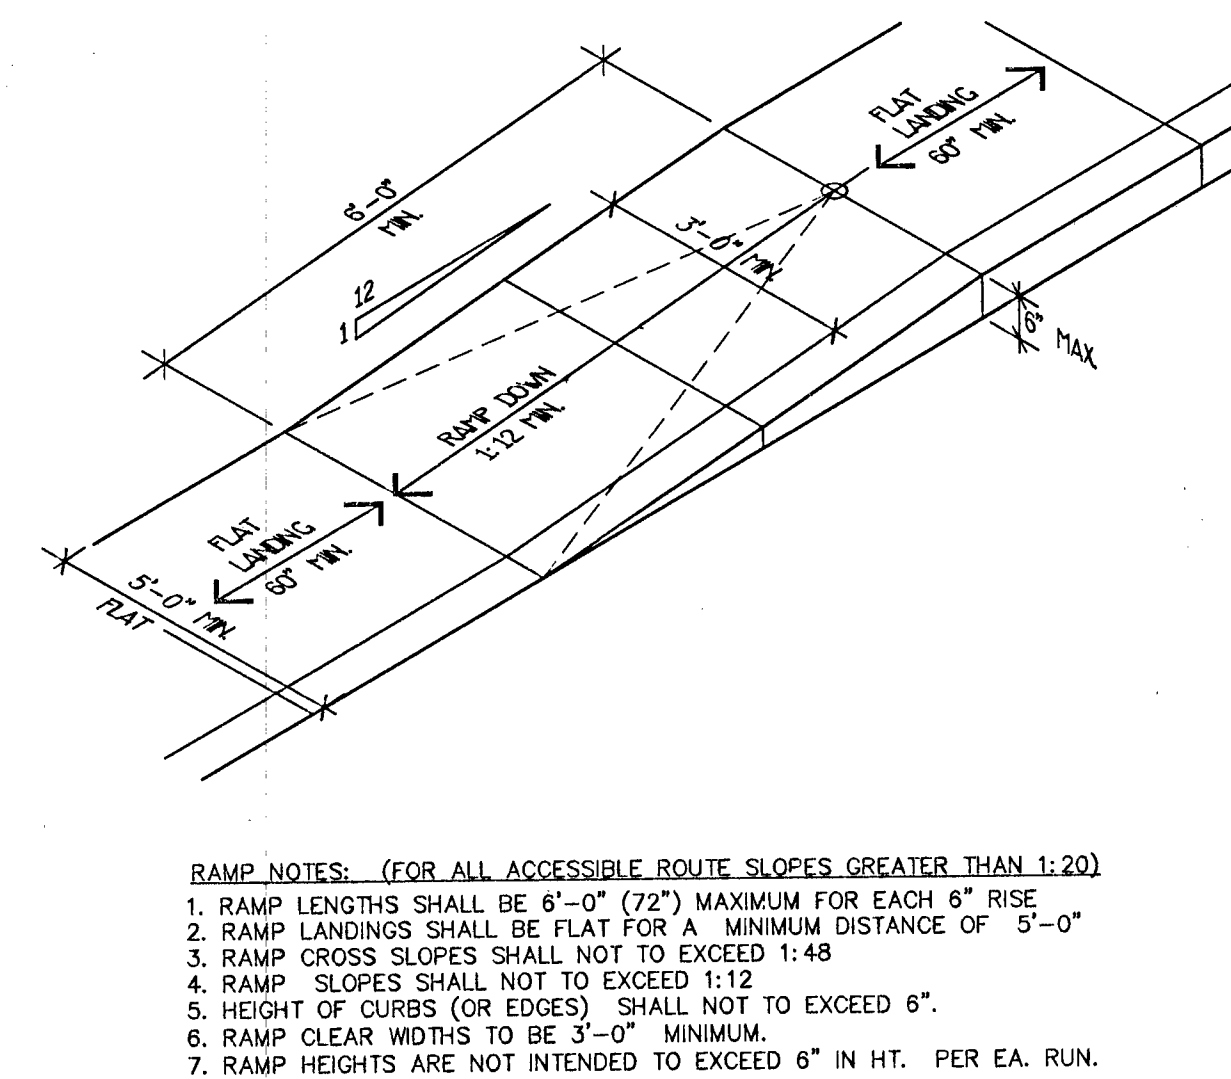
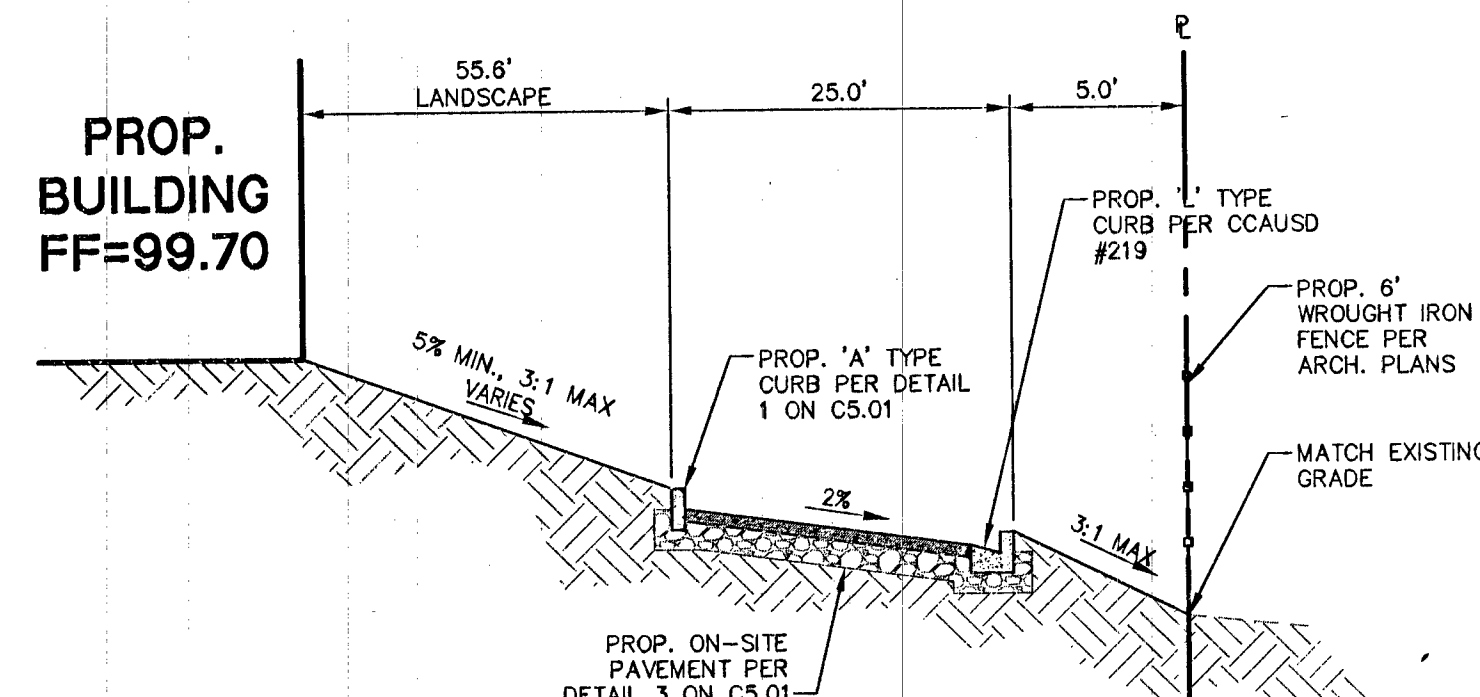
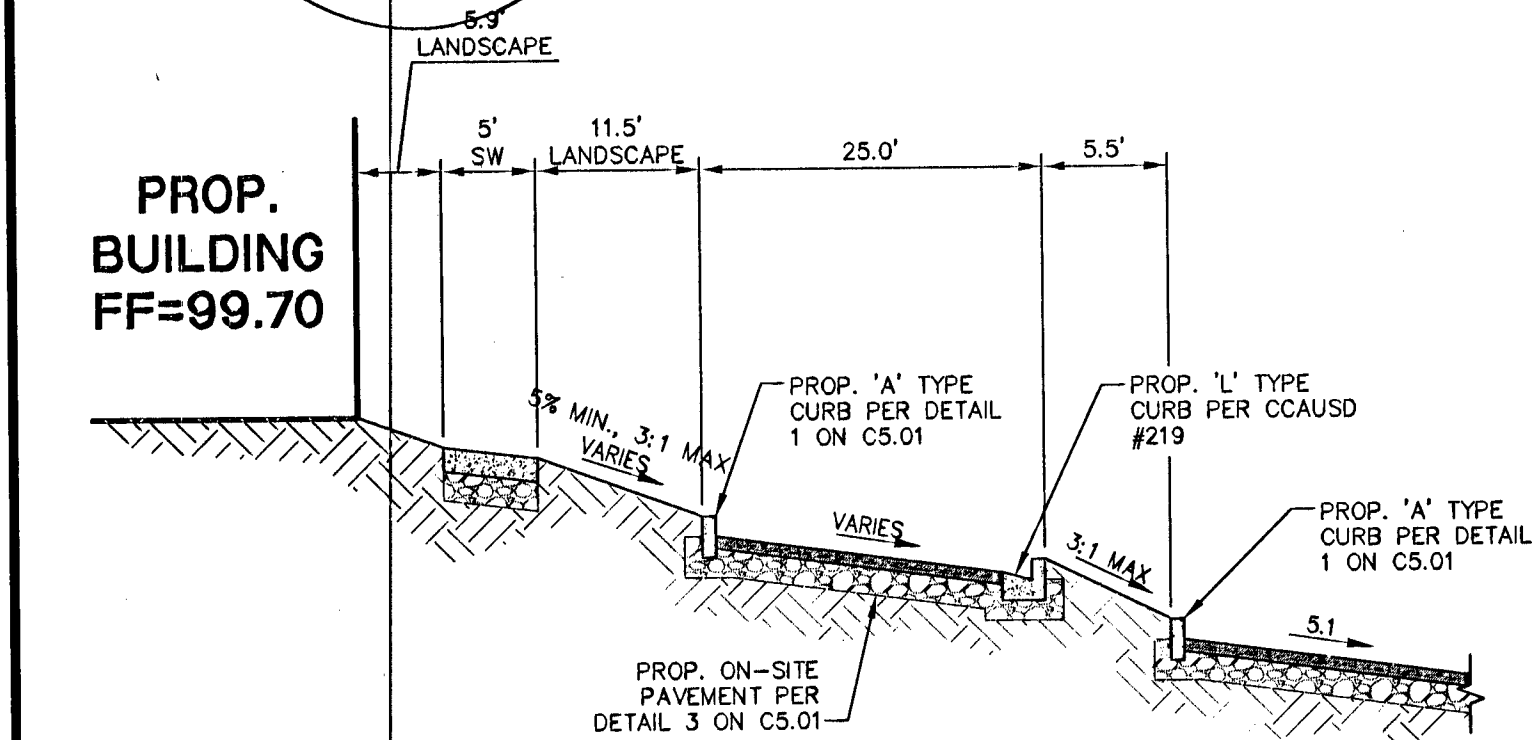


BET YOSSEF COMMUNITY CENTER OF LAS VEGAS
8551 VEGAS DRIVE

Suite 100
Las Vegas, NV 89118
Phone (702) 365-9312
Fax (702) 365-9317
www.lochsa.com

1	8-20-14	G.M.	REVISED SEWER LATERAL 9-16-14 L.V.M. 9/19/14
REV.:	DATE:	BY:	DESCRIPTION:

SUBJECT No: 131007
 DATE: 08/19/13
 TITLE: N/A
 DRAWN BY: JLI
 DESIGNED BY: JLI
 CHECKED BY: JMM
 GUY M. MORRIS
 EXP. 12-31-15
 CIVIL
 No 14526
 08-19-13
 SHEET No.
C6.01
 SHEET 7 of 7
 HITE No
 4# 49564
 10376412