


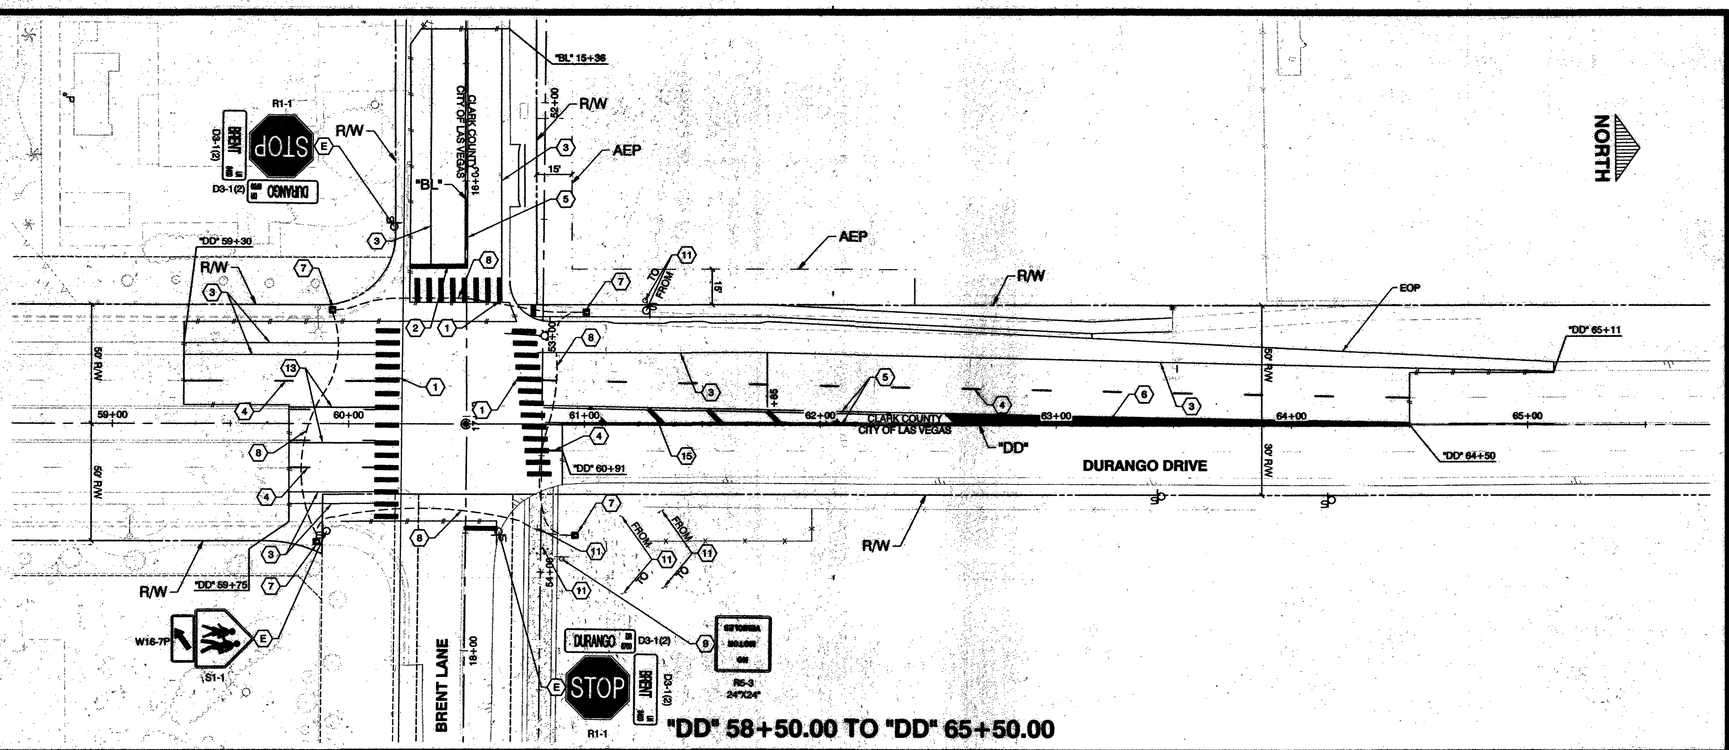


AS BUILT DRAWINGS

Per Plans

MC4 Construction

GRAPHIC SCALE

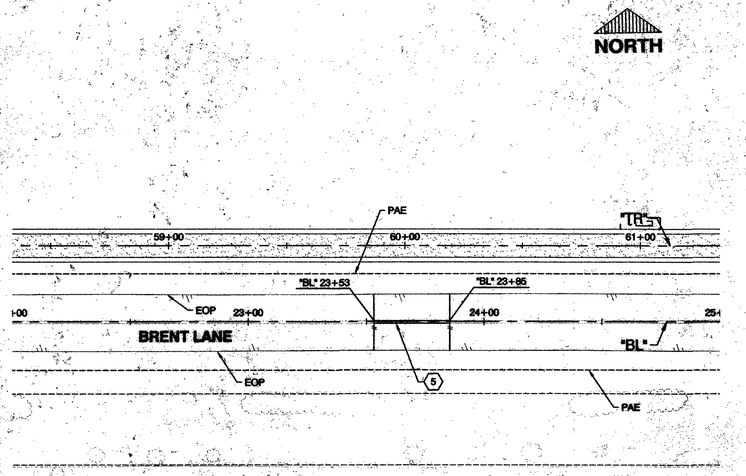30 0 15 30 60

( IN FEET )

**CALL BEFORE CONSTRUCTION**

| | | |
|---|---|---|
| BEFORE YOU DIG | USA NORTH | 811 OR 800-227-2600 |
| BEFORE YOU UNDERGROUND | F.A.S.T. | 702-432-5300 |
| | CLARK COUNTY TRAFFIC OPERATIONS | 702-455-7511 |
| | CITY OF LAS VEGAS T.E.F.O. | 702-229-6811 |
| BEFORE YOU OVERHEAD | NV ENERGY | 702-227-2929 |

## CONSTRUCTION NOTES

1. INSTALL 24-INCH WHITE CROSSWALK (PPM) (USDCCA STD. DWG. NO. 254)
2. INSTALL 24-INCH WHITE STOP LINE (PPM) (USDCCA STD. DWG. NO. 254)
3. INSTALL 6-INCH SOLID WHITE LINE (PPM)
4. INSTALL TYPE 4 LANE LINE (RPM) (USDCCA STD. DWG. NO. 244.1)
5. INSTALL TYPE I CENTERLINE (PPM) (USDCCA STD. DWG. NO. 244)
6. INSTALL SOLID YELLOW TO 5-FOOT WIDTH (PPM)
7. INSTALL NO. 7 PULL BOX (USDCCA STD. DWG. NO. 707)
8. INSTALL 2-3" CONDUIT WITH 1-#6 TRACER WIRE
9. INSTALL NEW GROUND MOUNTED SIGN(S)
10. INSTALL YIELD BAR (PPM)(MUTCD FIGURE 3B-17 AND NDOT STD. DWG. T-3B.1.3)
11. REMOVE AND RESET EXISTING SIGN(S)
12. RESET EXISTING PARK SIGN(S) ADJACENT TO TRAIL
13. INSTALL TYPE 2 CENTERLINE (RPM) (USDCCA STD. DWG. NO. 244)
14. REMOVE EXISTING SIGN(S)
15. INSTALL 24-INCH YELLOW DIAGONAL @ 25' O.C. (PPM)

(E) EXISTING SIGN(S) TO REMAIN

| NO. | DATE | REVISIONS |
|---|---|---|
| | | |

PREPARED BY
SLATER HANIFAN GROUP
CONSULTING ENGINEERS & PLANNERS
5740 S. ARVILLE STREET #216, LAS VEGAS, NV 89118
PHONE (702) 284-2200 FAX (702) 284-2299

PREPARED FOR
CITY OF LAS VEGAS

BID# 16-49876
DESIGNED BY: DAM
DRAWN BY: SPC/DAM
CHECKED BY: JSR/MJF
DATE: AUGUST 2016
SUBMITTAL STAGE:

TITLE
BRENT LANE DRAINAGE SYSTEM & TRAIL

SHEET
STRIPING AND TRAFFIC PLAN

PROFESSIONAL ENGINEER - STATE OF NEVADA
MARK J. FAILLA
Exp. 06/30/2017
CIVIL
No. 14566
8/15/17

SHEET
SM-01
44 OF 64
DRAWING NO.
731-92