BRISTLE FALLS UNIT 1
MONUMENTATION TIE MAP

(A COMMON INTEREST COMMUNITY)
BEING A SUBDIVISION OF A PORTION OF GOVERNMENT LOT 21 OF
SECTION 19, TOWNSHIP 19 SOUTH, RANGE 60 EAST, M.D.M., CITY OF LAS VEGAS, CLARK COUNTY, NEVADA.

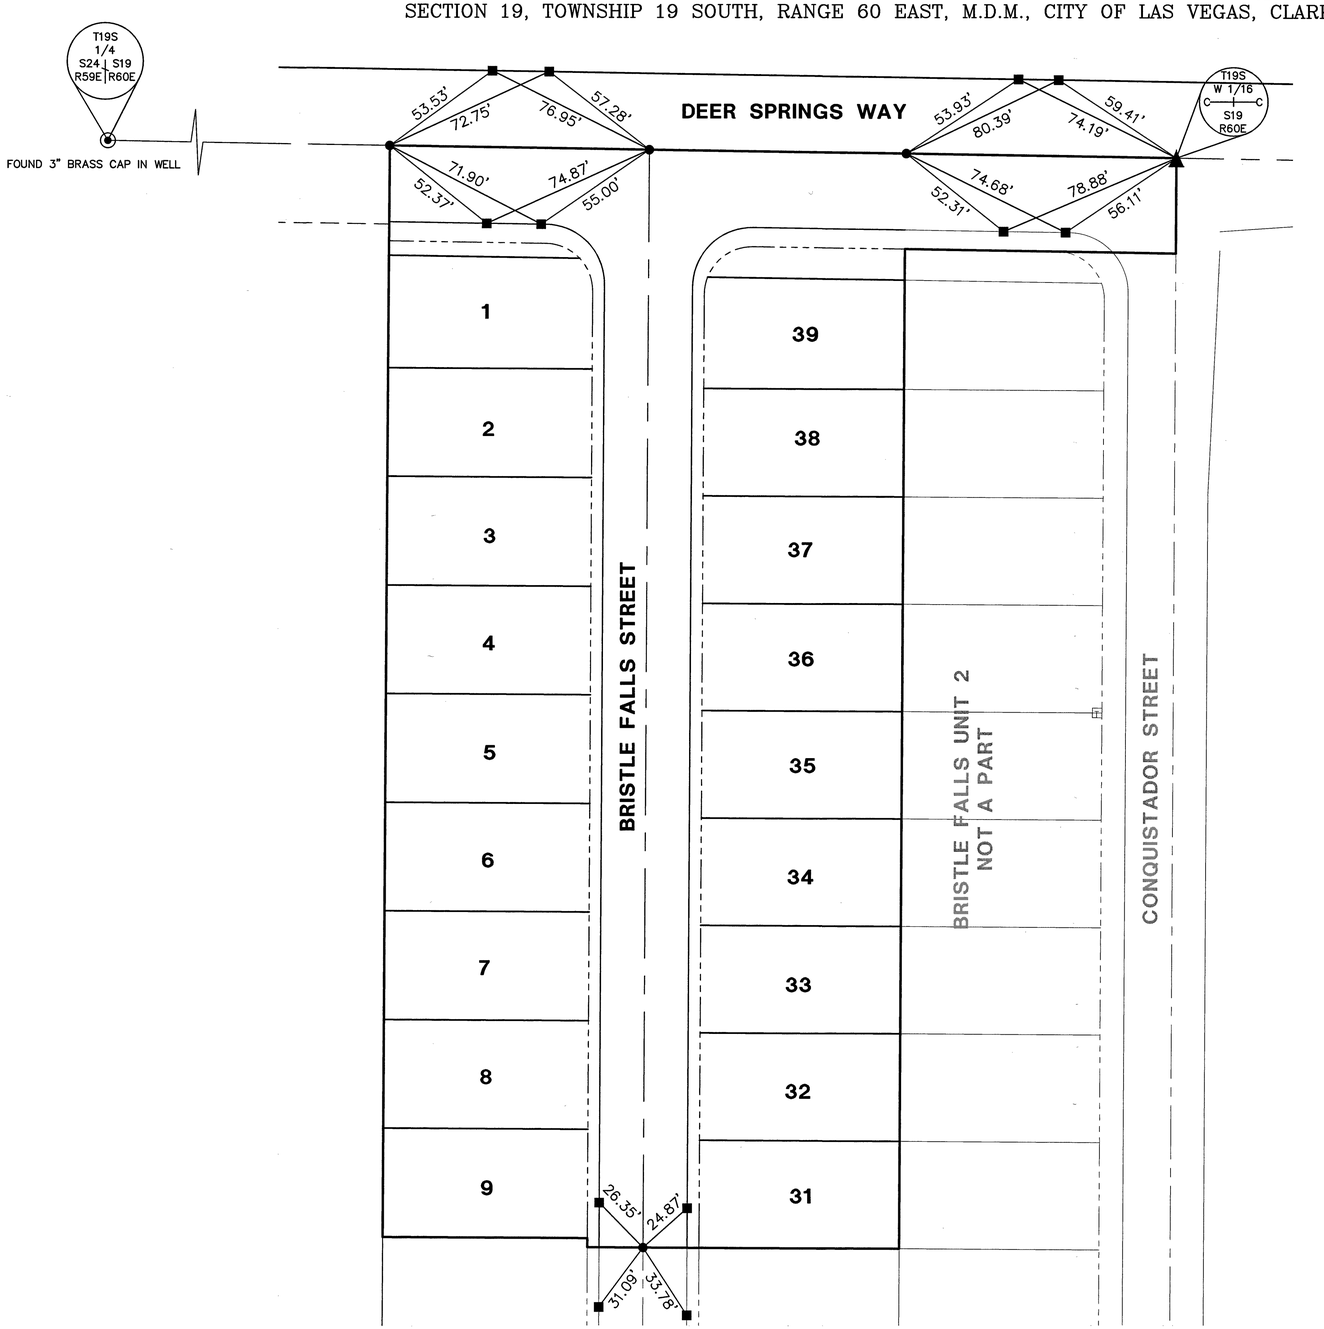

I, ANTHONY ZICARI, A PROFESSIONAL LAND SURVEYOR LICENSED IN THE STATE OF NEVADA, DO HEREBY CERTIFY THAT THE MONUMENTS HAVE BEEN SET AND THE TIE DISTANCES ESTABLISHED AS SHOWN HEREON. THIS SURVEY WAS COMPLETED ON JUNE 26, 2015.

PROFESSIONAL LAND SURVEYOR · STATE OF NEVADA
ANTHONY ZICARI
Exp: 6-30-18
No. 11449

06/23/16

ANTHONY ZICARI, P.L.S.
NEVADA LICENSE NO. 11449

NORTH

GRAPHIC SCALE

30 0 15 30 60
1" = 30'

NOTES

SEE FINAL MAP FOR BEARING AND DISTANCES.
(BOOK 146, PAGE 0089)

LEGEND

2	LOT NUMBER
— — —	RIGHT OF WAY
———	LOT LINES
———	SUBDIVISION BOUNDARY LINE
— – —	STREET CENTERLINE
———	BACK OF CURB LINE
▲	SET 2" BRASS IN CONCRETE STAMPED "VTN PLS 11449"
●	SET 5/8" REBAR AND AL. CAP STAMPED "VTN PLS 11449"
■	SET REFERENCE MONUMENTS STAMPED "VTN PLS 11449" IN TOP BACK OF CURB
◉	FOUND MONUMENT AS DESCRIBED

SHEET 1 OF 1

VTN NEVADA
CONSULTING ENGINEERS • PLANNERS • LAND SURVEYORS
2727 SOUTH RAINBOW BOULEVARD
LAS VEGAS, NEVADA 89102
(702) 873 – 7550 FAX (702) 362 – 2597

MONUMENTATION TIE MAP
FOR
BRISTLE FALLS UNIT 1
(BOOK 146 OF PLATS, PAGE 0089)
BEING A SUBDIVISION OF A PORTION OF GOVERNMENT LOT 21 OF S. 19, T. 19 S., R. 60 E., M.D.M., CITY OF LAS VEGAS, CLARK COUNTY, NEVADA

SCALE: 1" = 30'	W.O.# 7519-1	DATE: 6-29-2015	SHEET	OF
FILE: 7519MTM	DRN. BY: JCB	REV.:	1	1
	CKD. BY: AZ			

RECEIVED
JUN 23 2016
CITY OF LAS VEGAS
SURVEY

53 Sheets