
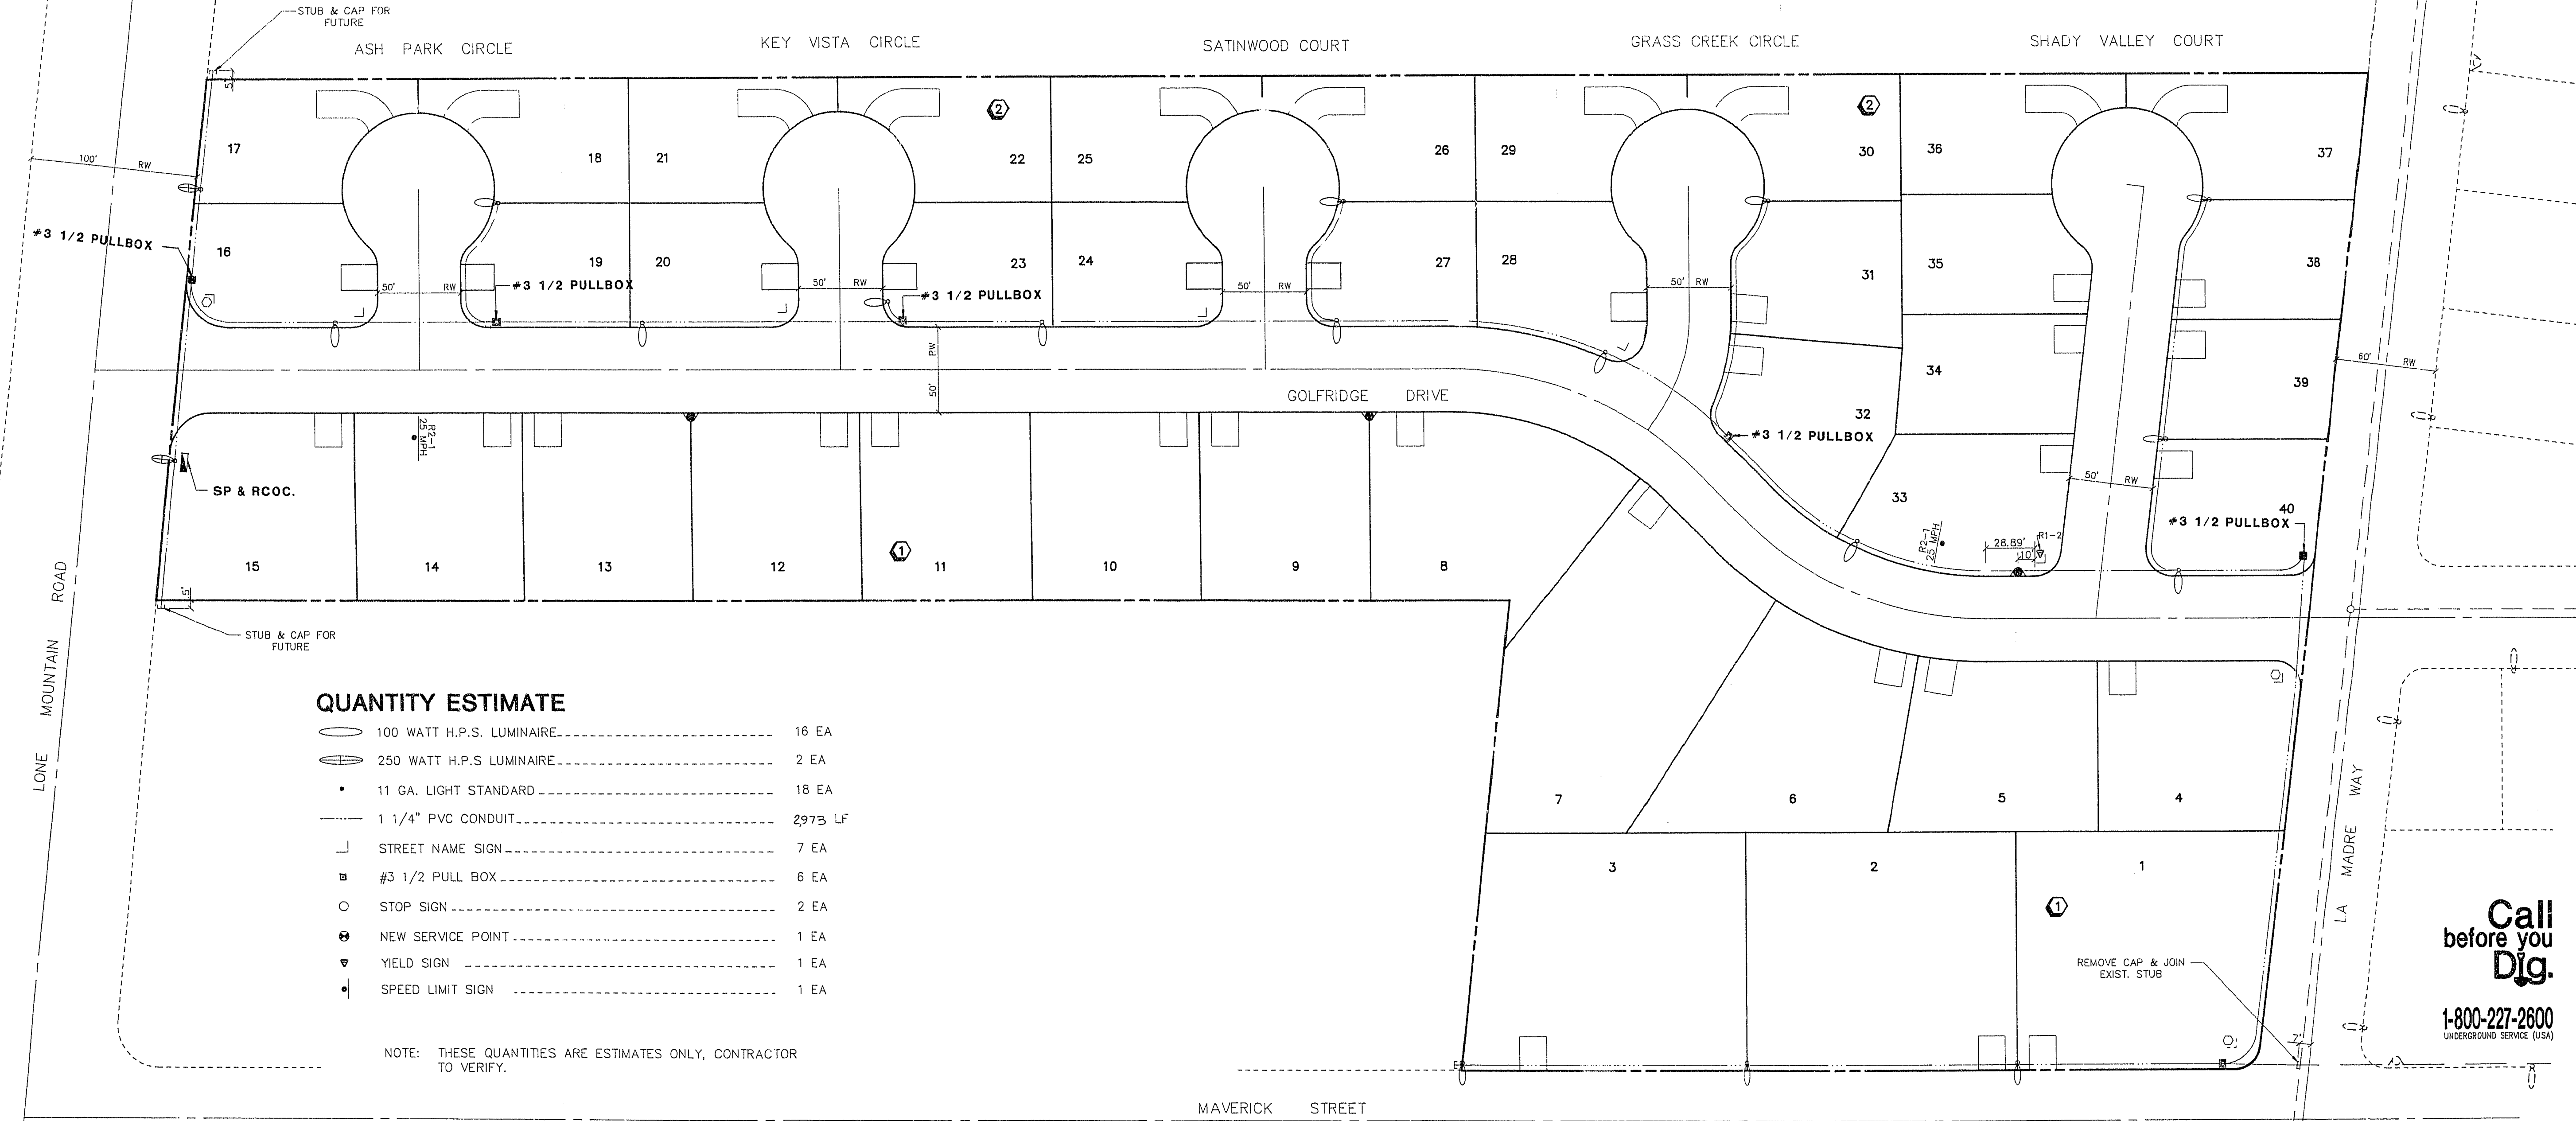
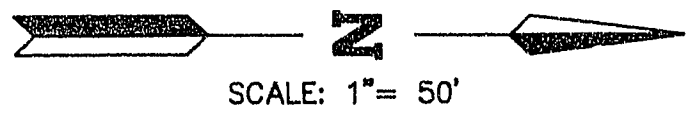


CITY OF LAS VEGAS STREET LIGHT NOTES

ALL STREET LIGHTING INSTALLATIONS SHALL CONFORM TO THE LATEST ISSUE OF THE STANDARD DETAIL AND SPECIFICATIONS OF THE CITY OF LAS VEGAS, AND SHALL ALSO CONFORM TO THE UNIFORM STANDARD SPECIFICATIONS FOR PUBLIC WORKS' CONSTRUCTION OF OFF-SITE IMPROVEMENTS, CLARK COUNTY AREA, LATEST EDITION, UNLESS OTHERWISE NOTED. ALL HAND HOLE COVERS MUST BE INSTALLED, POLE CAPS POURED, AND PULL BOX LIDS BOLTED DOWN PRIOR TO ENERGIZING CIRCUIT. ALL WIRE MUST HAVE THW INSULATIONS.

NOTE:

EXISTING UTILITY LOCATIONS SHOWN HEREON ARE APPROXIMATE ONLY. IT SHALL BE THE CONTRACTOR'S RESPONSIBILITY TO DETERMINE THE EXACT VERTICAL AND HORIZONTAL LOCATION OF ALL EXISTING UNDERGROUND UTILITIES PRIOR TO COMMENCING CONSTRUCTION. NO REPRESENTATION IS MADE THAT ALL EXISTING UTILITIES ARE SHOWN HEREON. THE ENGINEER ASSUMES NO RESPONSIBILITY FOR UTILITIES NOT SHOWN OR UTILITIES NOT SHOWN IN THEIR PROPER LOCATION. CALL BEFORE YOU DIG: 1-800-227-2600.

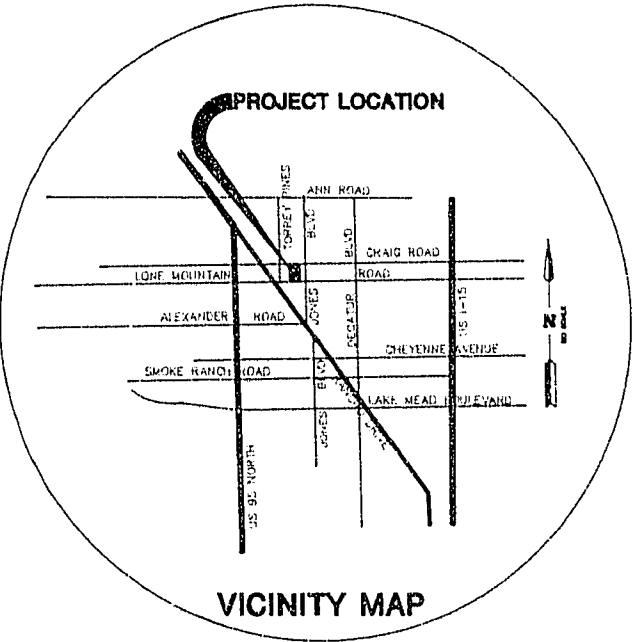

QUANTITY ESTIMATE

100 WATT H.P.S. LUMINAIRE	16 EA
250 WATT H.P.S. LUMINAIRE	2 EA
11 GA. LIGHT STANDARD	18 EA
1 1/4" PVC CONDUIT	2973 LF
STREET NAME SIGN	7 EA
#3 1/2 PULL BOX	6 EA
STOP SIGN	2 EA
NEW SERVICE POINT	1 EA
YIELD SIGN	1 EA
SPEED LIMIT SIGN	1 EA

NOTE: THESE QUANTITIES ARE ESTIMATES ONLY, CONTRACTOR TO VERIFY.

BENCHMARK

RM 1 T-365
SET DRIVE RIVET IN A 2"x 2" ALUMINUM PLATE, IN DRILLED HOLE WITH EPOXY GLUE, IN TOP OF CURB, OF PLANTER, JUST EAST OF DRIVEWAY INTO 7-11 STORE, NORTHWEST CORNER OF CRAIG RD. & RANCHO RD. BENCH IS NEAR THE NORTH RIGHT-OF-WAY OF CRAIG RD. & ABOUT 70 FT. WEST OF THE WEST RIGHT-OF-WAY OF RANCHO RD.
ELEVATION = 2294.290

APPROVAL

Michael Brown
NEVADA POWER COMPANY
DATE 12-20-91

THIS APPROVAL IS ONLY FOR THE PLACEMENT AND CLEARANCE OF STREET LIGHT AND SIGNAL LIGHT INSTALLATIONS.

Call
before you
Dig.

1-800-227-2600
UNDERGROUND SERVICE (USA)

REVISION	BY	DATE	APPROVAL
1	12-13-91	TB	
2	07-02-92	EW	

RELOCATED STREET LIGHTS PER CLY

ESI ENGINEERS & INC.
SURVEYORS, INC.
SUBMITTED BY: *Michael Brown*

MASTER STREET LIGHT PLAN

COUNTRY LANE SERIES II

TITLE

PROJECT

W.O. #: A170

BY: BURCH

DATE: 9/91

SCALE: 1" = 50'

SHEET

15

OF 15 SHEETS

1023-128 2074-4223