


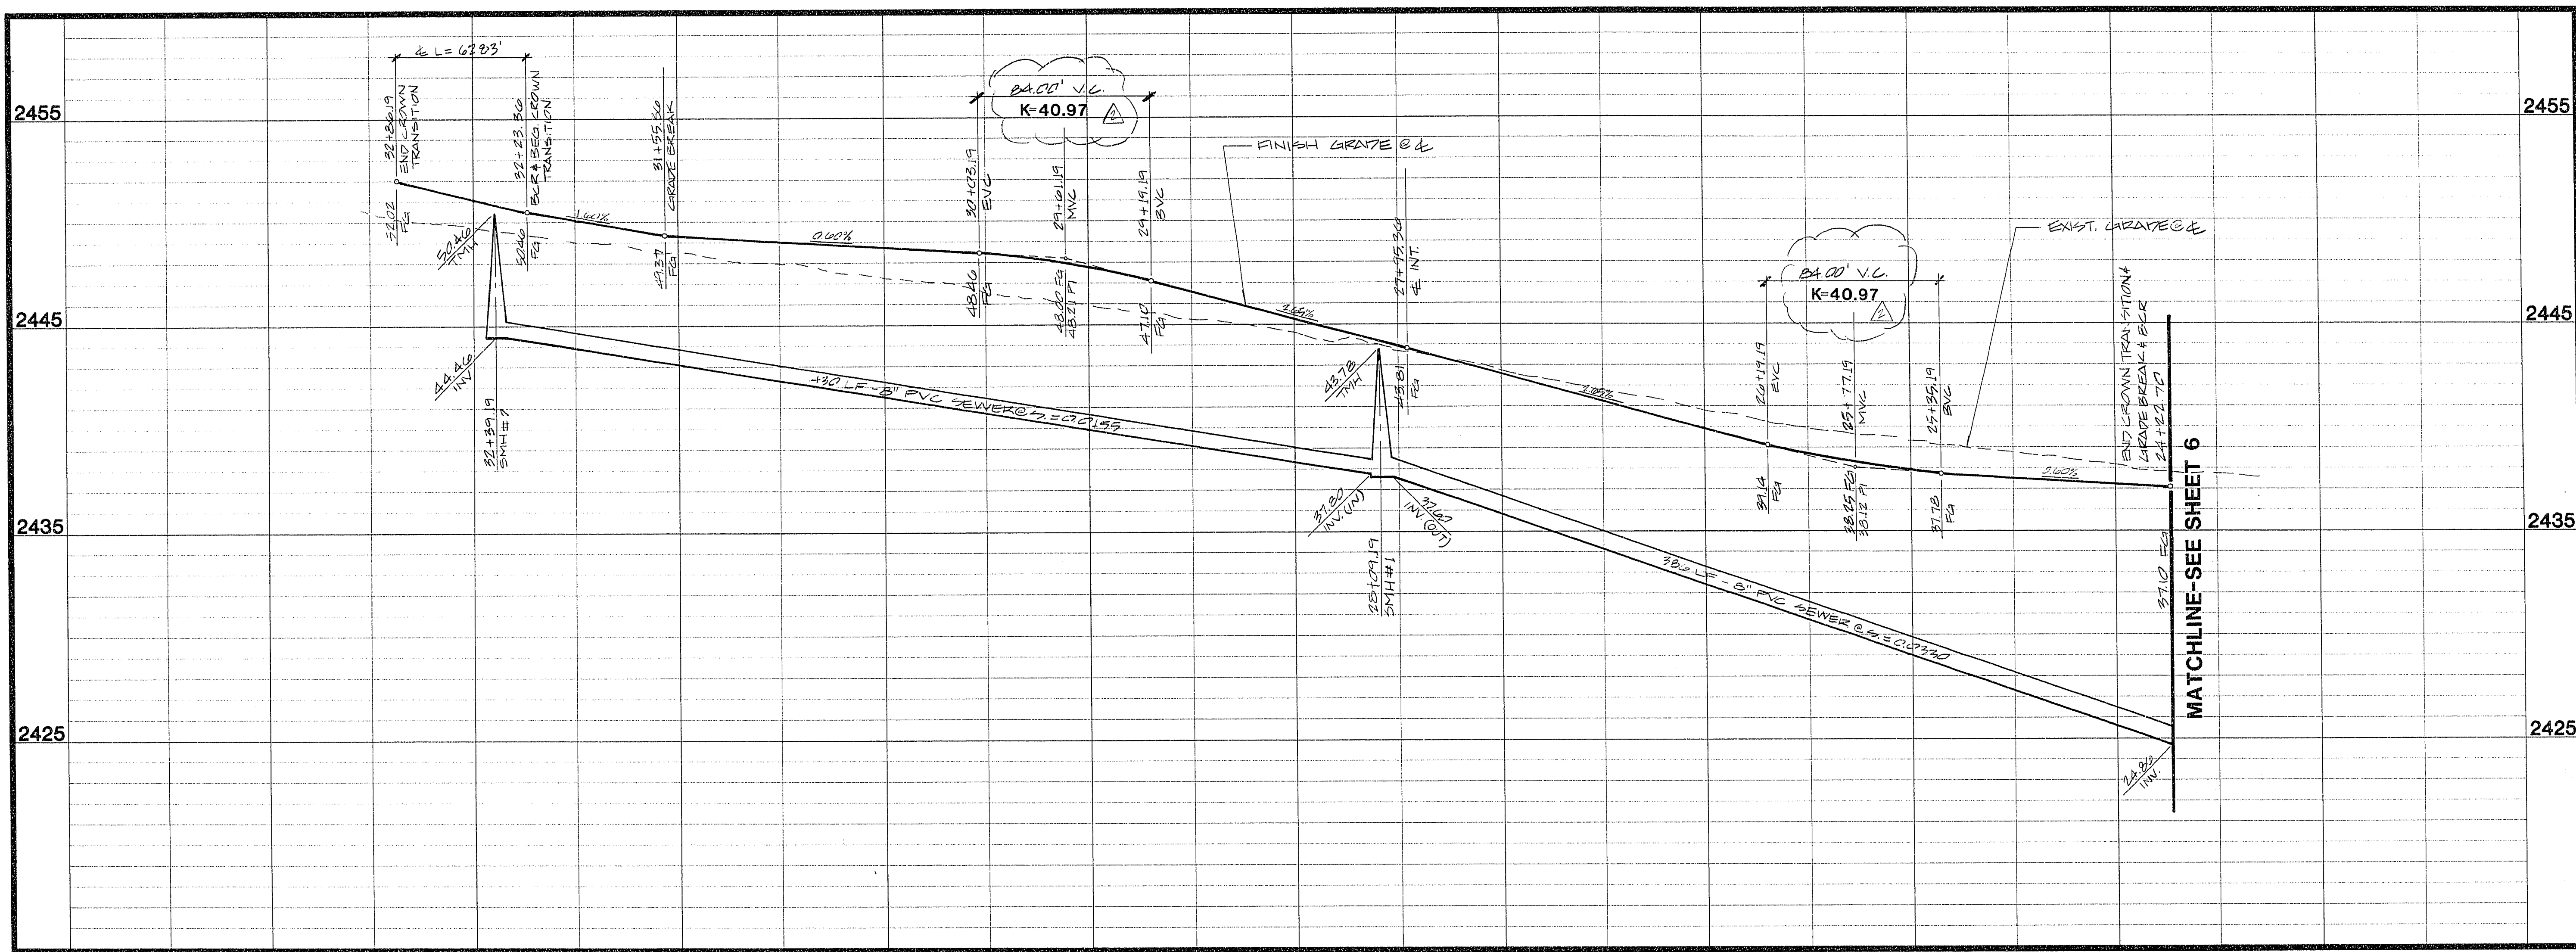


REV	DATE	BY	REVISION
1	4-11-94	ESA	REVISED SIDEWALK ELEVATIONS
2	4-11-94	ESA	REVISED SIDEWALK ELEVATIONS

34 33 32 31 30+00 29 28 27 26 25+00 24

STREET & SEWER PLAN & PROFILE
(AMATO STREET)
BUENA VISTA UNIT 2

SCALE 1" = 40'

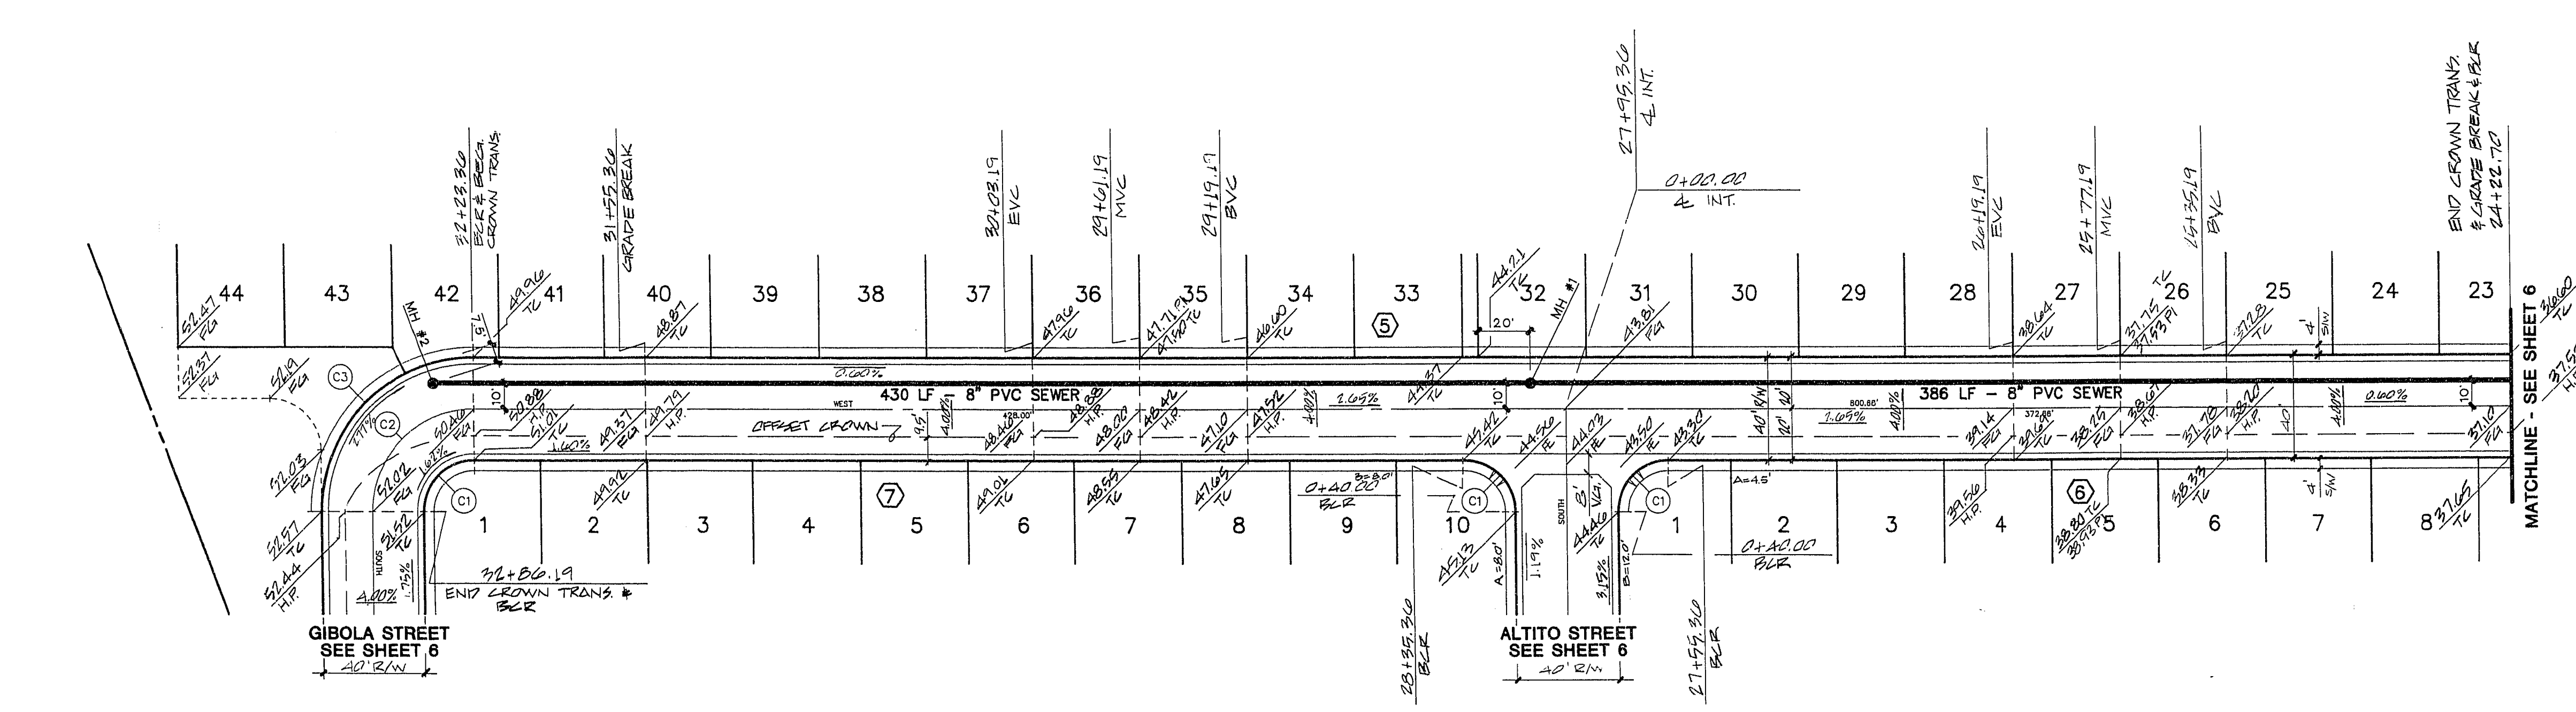

CURVE DATA

No.	RADIUS	DELTA	LENGTH	TANGENT
C1	20.00'	90°00'00"	31.42'	20.00'
C2	40.00'	90°00'00"	62.83'	40.00'
C3	60.00'	90°00'00"	94.25'	60.00'

BENCHMARK
C.L.V. BM #0LV0021E4
RIVET & PLATE IN TOP OF CURB, NW RETURN
OF BUFFALO DRIVE & LAKE MEAD BLVD.
ELEVATION = 2425.487


**SIDEWALK RAMPS
TRANSITION TABLE**

GRADE PAI " TO "	"X" (FT) MIN	"Y" (FT) MIN
+6 TO +6.01	4.5	21.5
+5 TO +6.01	4.5	15.0
+4 TO +5.01	4.5	10.0
+3 TO +4.01	4.5	7.5
+2 TO +3.01	4.5	5.0
+1 TO +2.01	4.5	4.5
+0 TO +1.01	4.5	4.5
-1 TO -0.01	4.5	4.5
-2 TO -1.01	4.5	4.5
-3 TO -2.01	4.5	4.5
-4 TO -3.01	4.5	4.5
-5 TO -4.01	4.5	4.5
-6 TO -5.01	4.5	4.5

NOTE:
FOR GRADING INFORMATION
SEE BUENA VISTA UNIT #1 PLANS
CLV DWG# 107Y-4260-1

QUANTITY ESTIMATE
2" ASPHALTIC CONCRETE 3,358 SY
30" "ROLL" TYPE CURB & GUTTER 1,647 LF
CONCRETE SIDEWALK 6,588 SF
THESE QUANTITIES ARE ONLY ESTIMATES, CONTRACTOR
TO VERIFY.

Call before you Dig.
1-800-227-2600
UNDERGROUND SERVICE (USA)

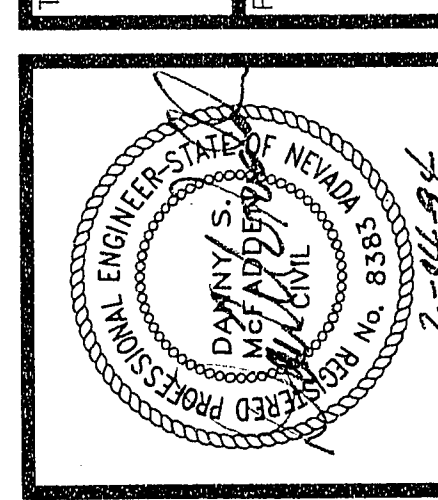

**ESI ENGINEERS AND
SURVEYORS INC.**
PLANNING • CONSULTING ENGINEERS • SURVEYORS
708 W. CHARLESTON BLVD. • LAS VEGAS, NEVADA 89102 • (702) 335-6405

W.D. # : 755 - A707
BY : /FA / DTB
DATE : JAN. 1994
SCALE : 1" = 40'

SHEET **3** OF **9**