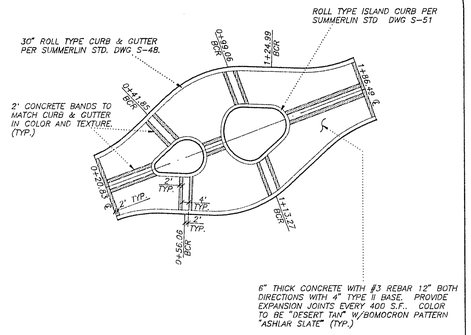

CORTA BELLA DRIVE ENTRY STATEMENT — 1/24
SCALE: 1" = 40'

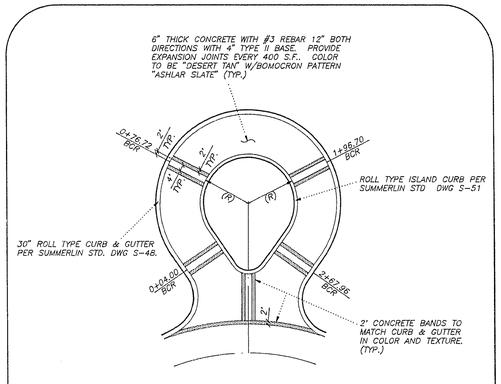

LUSSO COURT — 2/24
SCALE: 1" = 40'

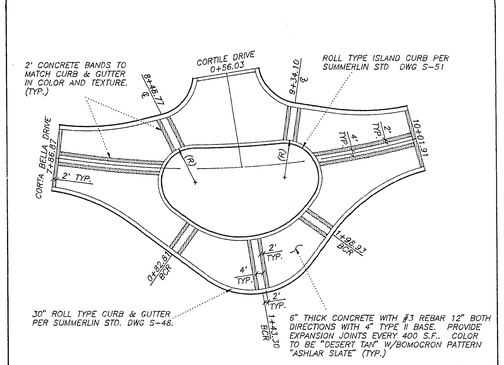

COURTYARD AT CORTILE DRIVE & CORTA BELLA DRIVE — 3/24
SCALE: 1" = 40'

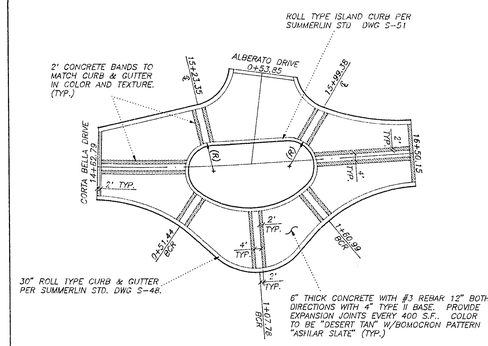

ROZETTA
COURTYARD AT ~~ALBERATO~~ COURT & CORTA BELLA DRIVE — 4/24
SCALE: 1" = 40'

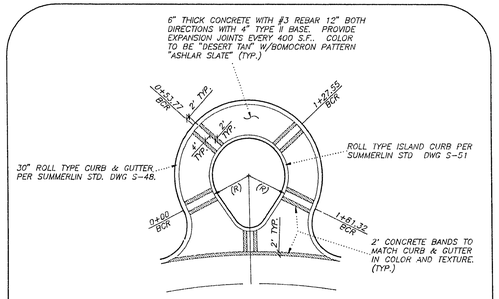

QUADRO COURT — 5/24
SCALE: 1" = 40'

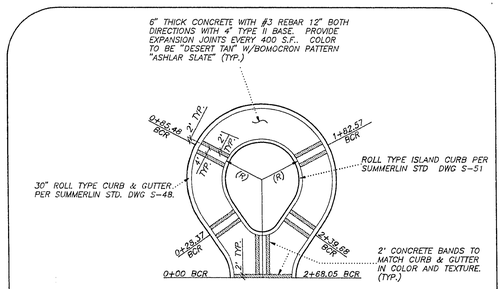

ROZETTA CT.
~~ALBERATO CT.~~, BONTA CT. & CORTA BELLA DR. — 6/24
SCALE: 1" = 40'

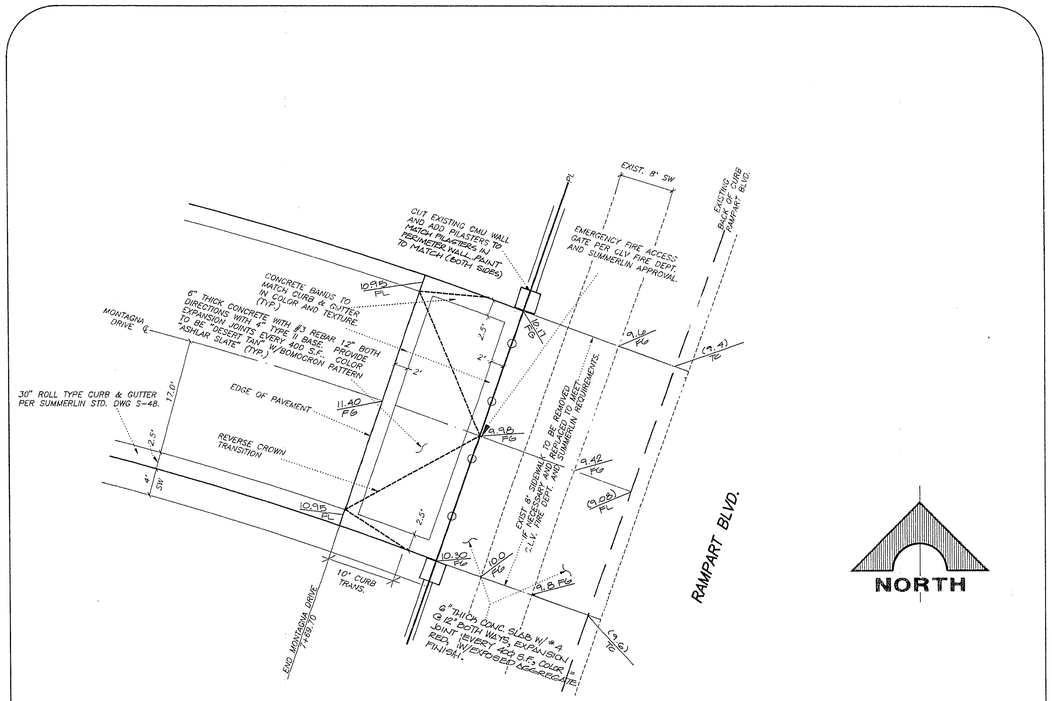

EMERGENCY FIRE ACCESS AT MONTAGNA DRIVE — 9/24
SCALE: 1" = 10'

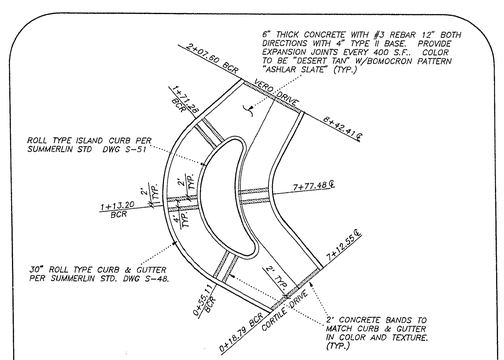

KNUCKLE AT CORTILE AND VERO DRIVES — 7/24
SCALE: 1" = 40'

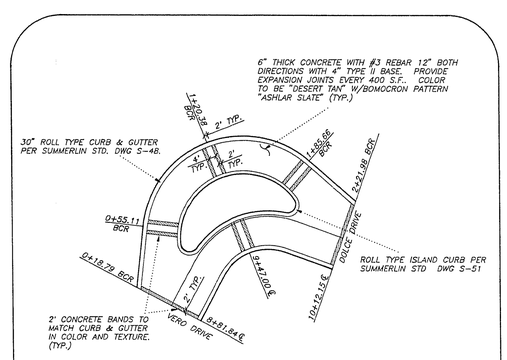

KNUCKLE AT VERO AND DOLCE DRIVES — 8/24
SCALE: 1" = 40'

JOB NO. 743.006 PLOTTED: 3/10/93 1:40 PM

REV	DATE	DESCRIPTION	C.L.V.	DATE

RECOMMENDED: MICHAEL D. BAKER 6218 P.E. NO. DATE
REGISTERED PROFESSIONAL ENGINEER STATE OF NEVADA MICHAEL D. BAKER No. 6218

G.C. WALLACE, INC.
Engineering/Architecture 1555 SOUTH RAINBOW BLVD., LAS VEGAS, NEVADA 89102

COLEMAN HOMES
CORTA BELLA AT SUMMERLIN
CONCRETE PAVEMENT DETAILS

SHEET 24 OF 24 SHEETS

10-27-91 1074-4248-1