


UTILITY LOCATIONS SHOWN HEREON ARE APPROXIMATE ONLY. IT SHALL BE THE CONTRACTORS RESPONSIBILITY TO DETERMINE THE EXACT HORIZONTAL AND VERTICAL LOCATION OF ALL EXISTING UNDERGROUND OR OVERHEAD UTILITIES PRIOR TO COMMENCING CONSTRUCTION. NO REPRESENTATION IS MADE THAT ALL EXISTING UTILITIES ARE SHOWN HEREON. THE ENGINEER ASSUMES NO RESPONSIBILITY FOR UTILITIES NOT SHOWN OR UTILITIES NOT SHOWN IN THEIR PROPER LOCATION. CONTRACTOR TO NOTIFY ENGINEER OF ANY CHANGES OR DISCREPANCIES.

Avoid Hitting Underground
Traffic Signal Systems
and Street Light Systems
Conduits It's Costly
CALL BEFORE
YOU DO
UNDERGROUND

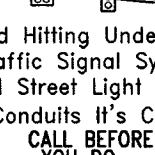

**Call
before you
UnderGround**

1-702-455-6000
CLARK COUNTY TRAFFIC OPERATIONS
AND

1-702-432-5300
LAS VEGAS AREA COMPUTERIZED TRAFFIC SYSTEM



CITY OF LAS VEGAS BENCHMARK 6L099 245CS
A RIVET AND PLATE IN THE TOP OF CURB AT THE NORTHWEST CORNER OF
CENTENNIAL PARKWAY AND HUALAPAI WAY.

ELEVATION=844.924 METERS (NAVD'88)
ELEVATION=2772.06 US SURVEY FEET (NAVD'88)

BASIS OF BEARINGS

SOUTH 89°47'00" EAST BEING THE BEARING OF THE NORTH LINE OF THE
NORTHWEST QUARTER (NW 1/4) OF THE NORTHWEST QUARTER (NW 1/4) OF
SECTION 30, TOWNSHIP 18S SOUTH, RANGE 60 EAST, W.D.M., CLARK COUNTY,
NEVADA AS SHOWN BY MAP THEREOF ON FILE IN THE CLARK COUNTY
RECORDER'S OFFICE IN FILE 89, PAGE 3 OF SURVEYS.

SOUTH 89°47'00" EAST BEING THE BEARING OF THE NORTH LINE OF THE NORTHWEST QUARTER (NW 1/4) OF THE NORTHWEST QUARTER (NW 1/4) OF SECTION 30, TOWNSHIP 19 SOUTH, RANGE 60 EAST, M.D.M., CLARK COUNTY, NEVADA AS SHOWN BY MAP THEREOF ON FILE IN THE CLARK COUNTY RECORDER'S OFFICE IN FILE 89, PAGE 3 OF SURVEYS.

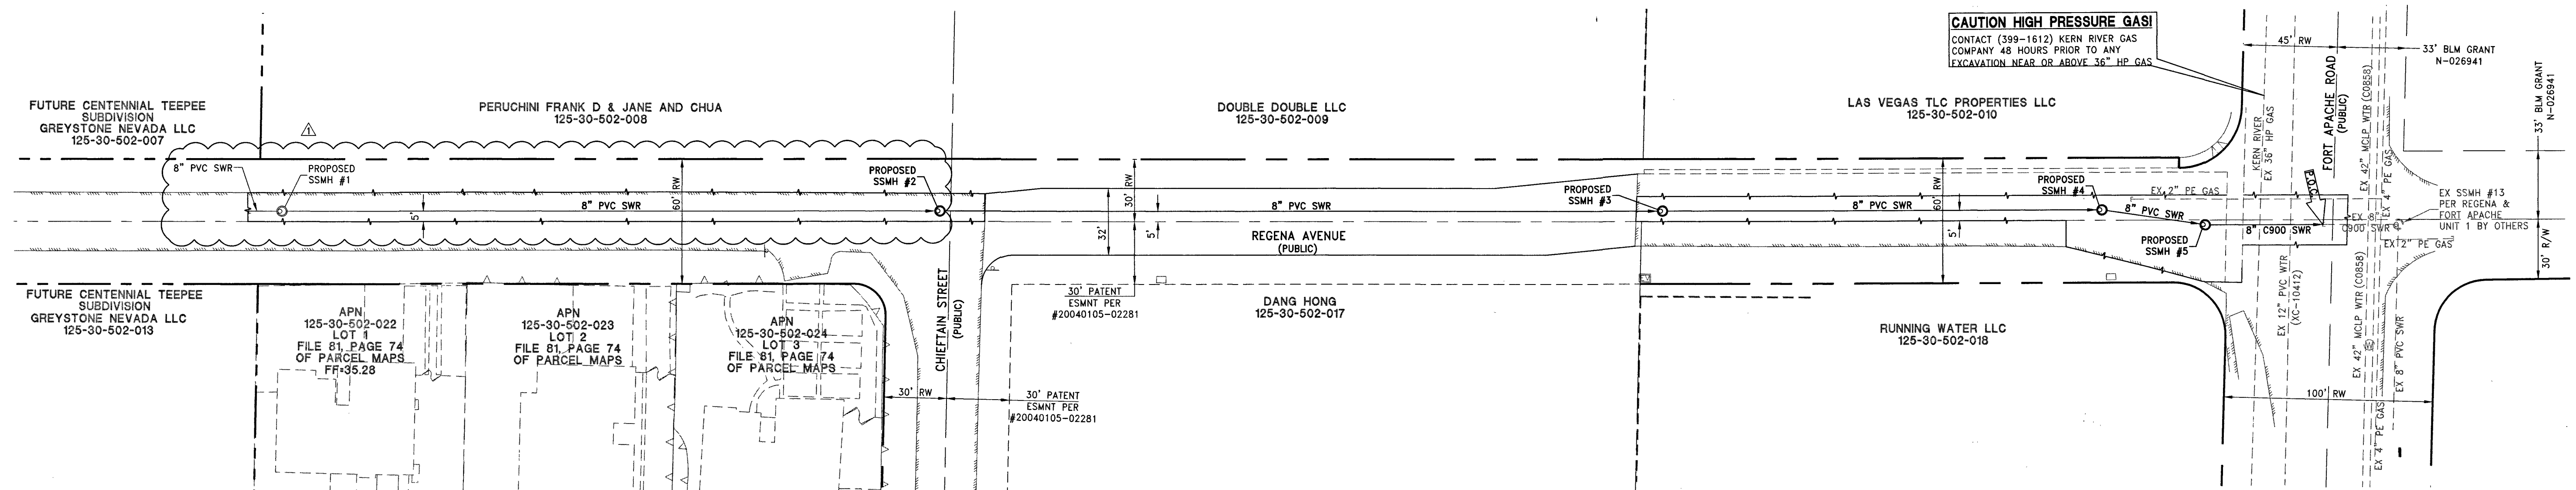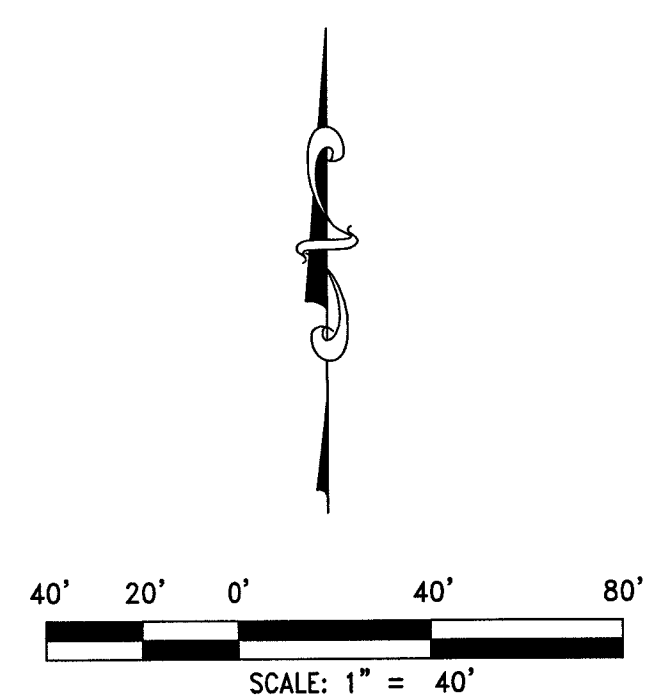

BY: Jam M. Kij 28 OCT 14 DATE

APPROVAL OF THESE PLANS SHALL NOT BE CONSTRUED TO BE A PERMIT FOR, OR ANY APPROVAL OF, ANY VIOLATION OF ANY OF THE PROVISIONS OF THE STATE OR COUNTY LAWS.

APPROVAL BY THE FIRE DEPARTMENT HAVING JURISDICTION IS REQUIRED PRIOR TO OBTAINING FINAL APPROVAL FROM THE LVVWD.

4. DISHARI FOR DJM
LAS VEGAS VALLEY WATER DISTRICT ENGINEERING SERVICES MANAGER
DATE: 11/5/15 PROJECT# 123116

LENNAR®
4950 PASEO VERDE PARKWAY SUITE 120 HENDERSON, NV 89073
PHONE: (702) 736-9100 FAX: (702) 736-9200

RCI Engineering

4325 Dean Martin Road, Suite 300, Las Vegas, NV 89103
PHF702-453.0800 FAX702-453.0801

**CENTENNIAL AND TEE PEE
REGENA AVENUE OFFSITE SEWER FACILITY
MASTER UTILITY PLAN**

MU-1

SHT **3** OF **6**

HTE NUMBER
14-33533

304V1047

```

;SQUAD_LENR\0036_Centennial and Lee Fee\m_Civil_War\01\JMS_Holcomb\00000_moving_circle 10/22/17 2:04pm

```