

UTILITY LOCATIONS SHOWN HEREON ARE APPROXIMATE ONLY. IT SHALL BE THE CONTRACTORS RESPONSIBILITY TO DETERMINE THE EXACT HORIZONTAL AND VERTICAL LOCATION OF ALL EXISTING UNDERGROUND OR OVERHEAD UTILITIES PRIOR TO COMMENCING CONSTRUCTION. NO REPRESENTATION IS MADE THAT ALL EXISTING UTILITIES ARE SHOWN HEREON. THE ENGINEER ASSUMES NO RESPONSIBILITY FOR UTILITIES NOT SHOWN OR UTILITIES NOT SHOWN IN THEIR PROPER LOCATION. CONTRACTOR TO NOTIFY ENGINEER OF ANY CHANGES OR DISCREPANCIES.

Avoid overhead power line contact. It's costly. Call before you Overhead 1-702-227-2929 Nevada Power Environment and Safety Services Department	Call before you Dig Avoid cutting underground utility lines. It's costly. Call 811 OR AND 1-800-227-2600 CLARK COUNTY TRAFFIC OPERATION 1-702-455-6000
--	---

Avoid Hitting Underground
Traffic Signal Systems
and Street Light System
Conduits It's Costly
**CALL BEFORE
YOU DO
UNDERGROUND**



**Call
before you
UnderGround**

1-702-455-6000
CLARK COUNTY TRAFFIC OPERATIONS
AND
1-702-432-5300
LAS VEGAS AREA COMPUTERIZED TRAFFIC SYSTEM

CITY OF LAS VEGAS BENCHMARK 6LV99 24SES
A RIVET AND PLATE IN THE TOP OF CURB AT THE NORTHWEST CORNER OF
CENTENNIAL PARKWAY AND HUALAPAI WAY.

ELEVATION=844.924 METERS (NAVD'88)
ELEVATION=2772.06 US SURVEY FEET (NAVD'88)

SOUTH 89°47'00" EAST BEING THE BEARING OF THE NORTH LINE OF THE NORTHWEST QUARTER (NW 1/4) OF THE NORTHWEST QUARTER (NW 1/4) OF SECTION 30, TOWNSHIP 19 SOUTH, RANGE 60 EAST, M.D.M., CLARK COUNTY NEVADA AS SHOWN BY MAP THEREOF ON FILE IN THE CLARK COUNTY RECORDER'S OFFICE IN FILE 89, PAGE 3 OF SURVEYS.

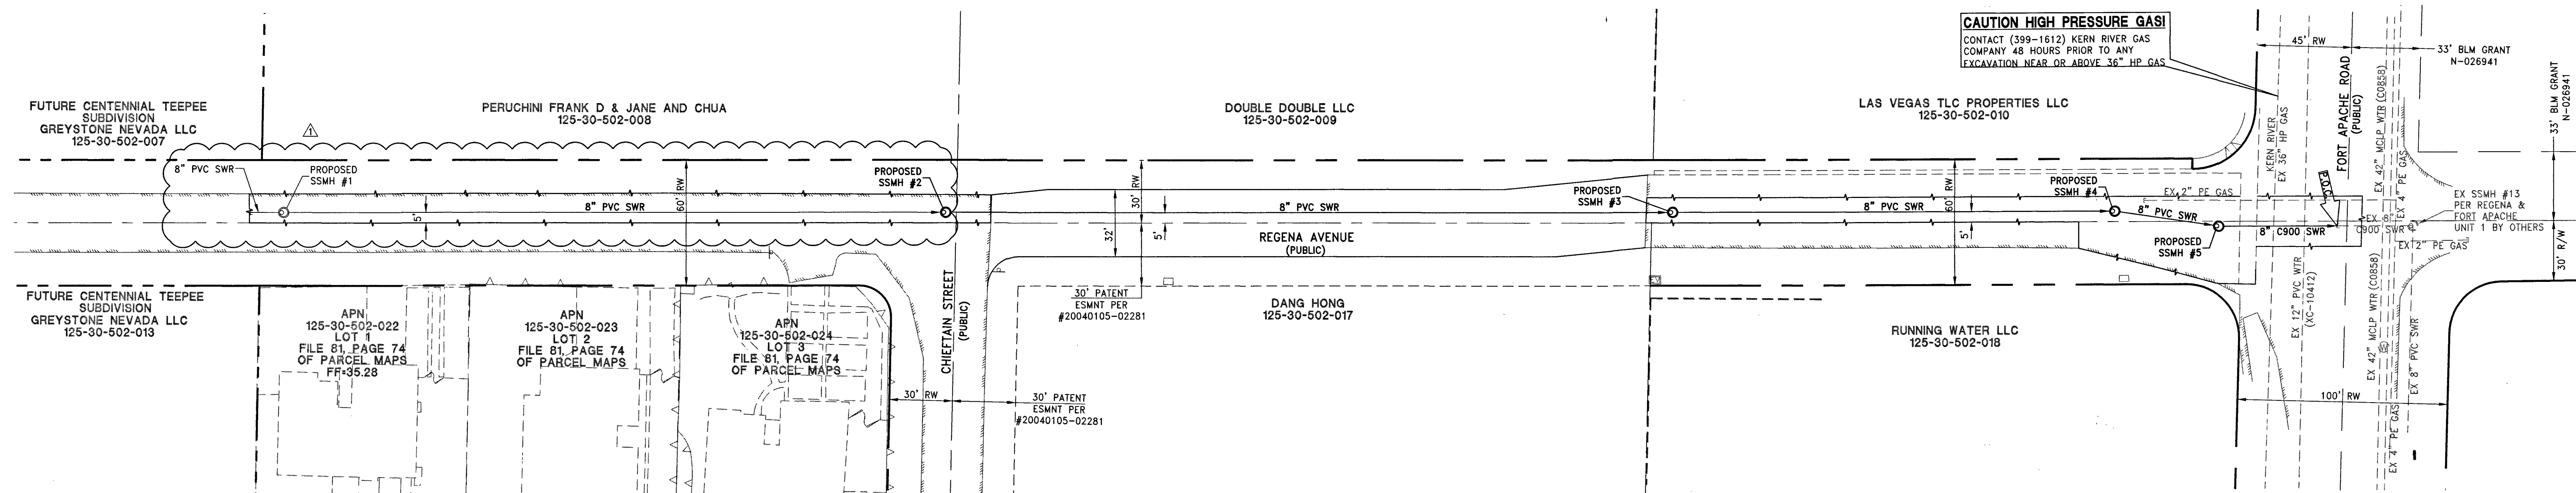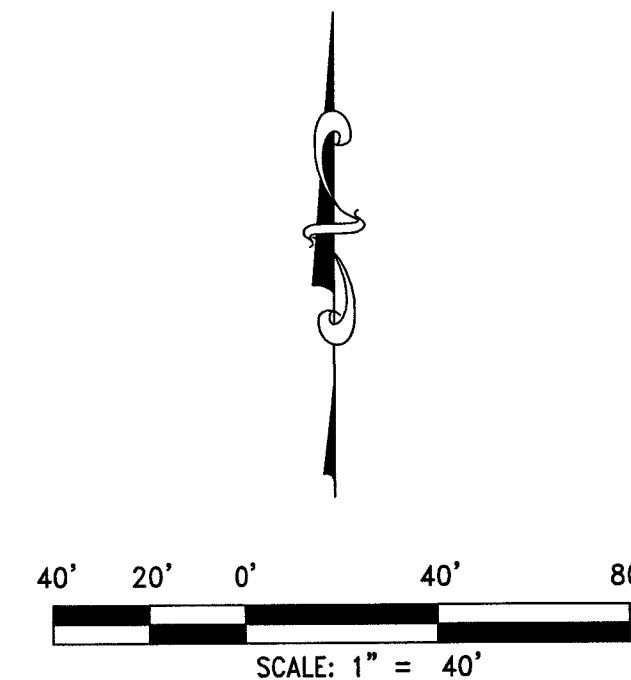

1/19/17

CLARK COUNTY FIRE DEPARTMENT APPROVAL

BY: James H. King DATE 28 OCT 14

APPROVAL OF THESE PLANS SHALL NOT BE CONSTRUED TO BE A PERMIT FOR, OR ANY APPROVAL OF, ANY VIOLATION OF ANY OF THE PROVISIONS OF THE STATE OR COUNTY LAWS.

APPROVAL BY THE FIRE DEPARTMENT HAVING JURISDICTION IS REQUIRED PRIOR TO OBTAINING FINAL APPROVAL FROM THE LVVWD.

APPROVED FOR CONSTRUCTION

4. DISHARFOR, JIM
LAS VEGAS VALLEY WATER DISTRICT ENGINEERING SERVICES MANAGER
DATE 11.5.15 PROJECT# 123116

LENNAR®
490 PASEO VERDE PARKWAY SUITE 120 HENDERSON, NV 89074
916.616.1701 / 702.735.0300 FAX: 702.735.0300

RCI
Engineering
PHONE: (702) 366-9100 FAX: (702) 366-5200

**CENTENNIAL AND TEE PEE
BREGENA AVENUE OFFSITE SEWER FACILITY
MASTER UTILITY PLAN**

NEVADA

PROFESSIONAL ENGINEER
STATE OF NEVADA
CHRISTOPHER
ZRINYI
Exp. 6/30/2016
CIVIL
No. 15976

10-22-14

DRAWING

MU-1

SHT 3 OF 6

HITE NUMBER
14-33533
30-151047

\\s010\proj\03040_LENR\0038_Centennial and Tee Pee\CIVIL\IPS\OFFSITE_REGENA\S003_MU01.dwg crivra 10/22/14 2:02pm