
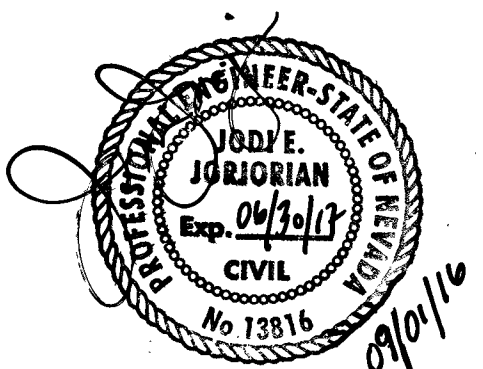
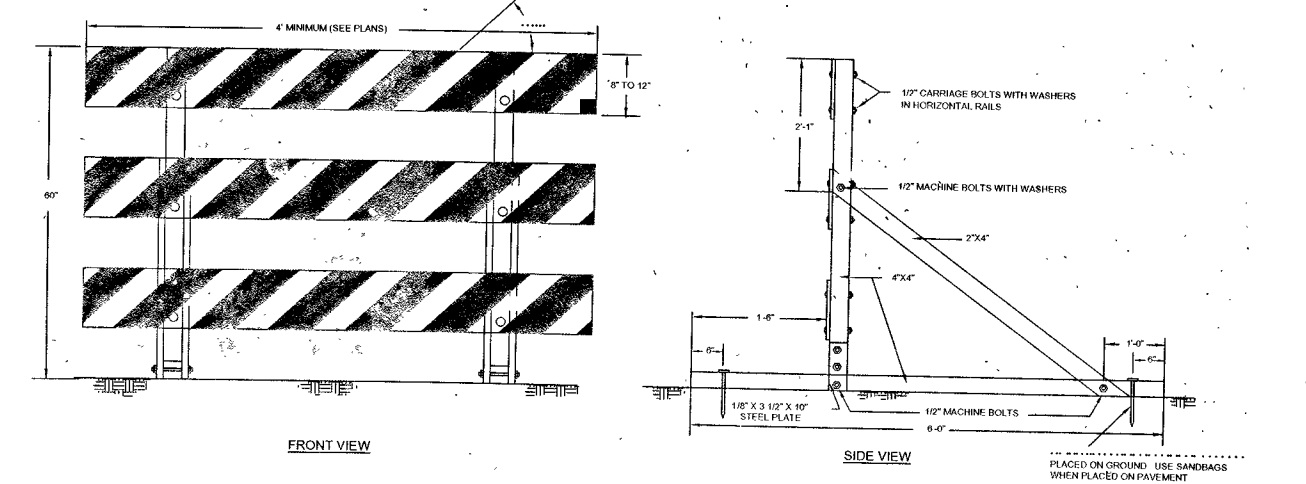
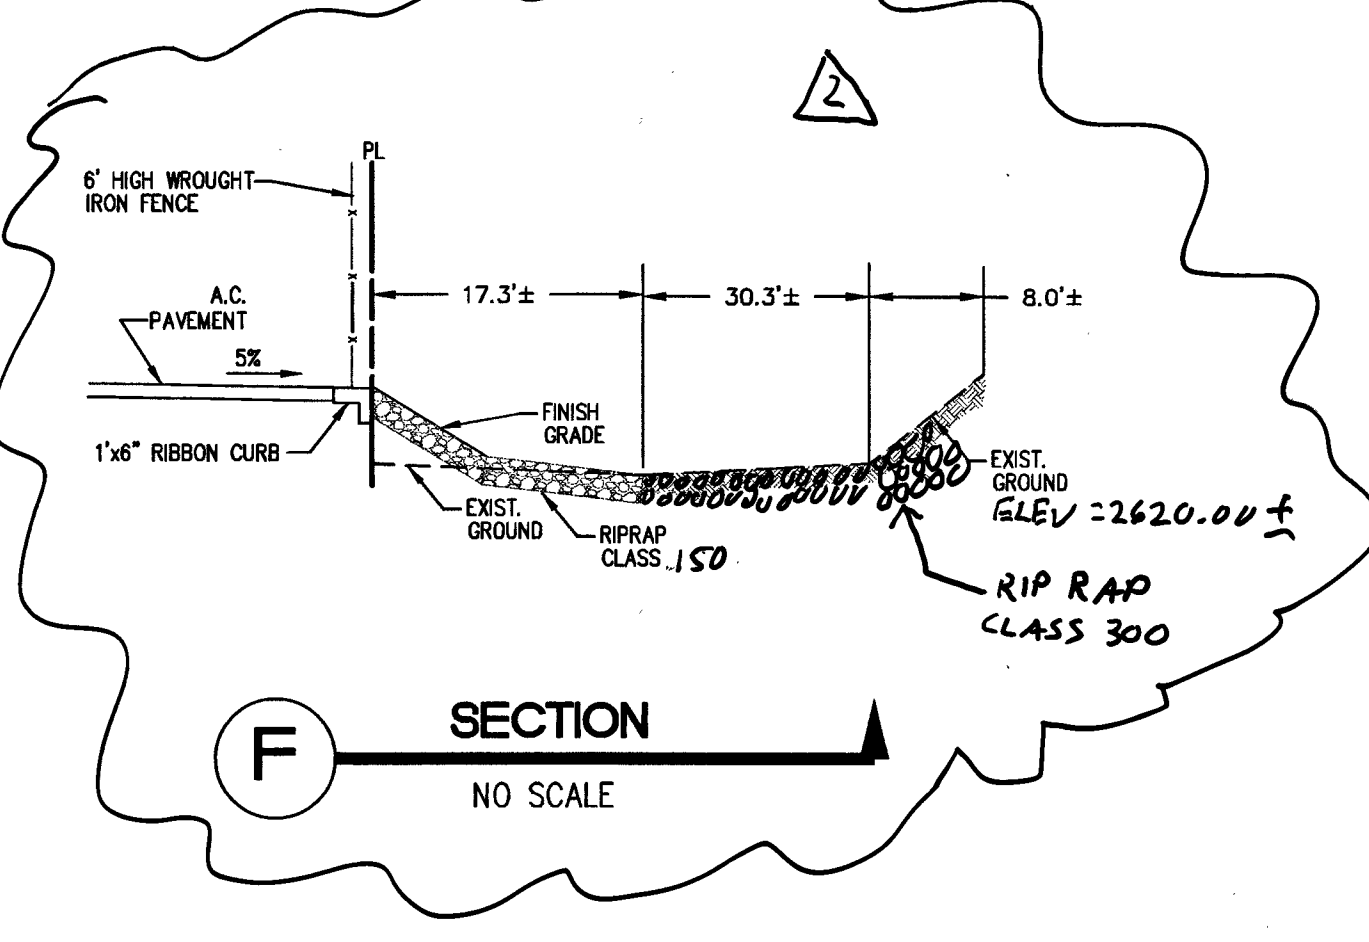
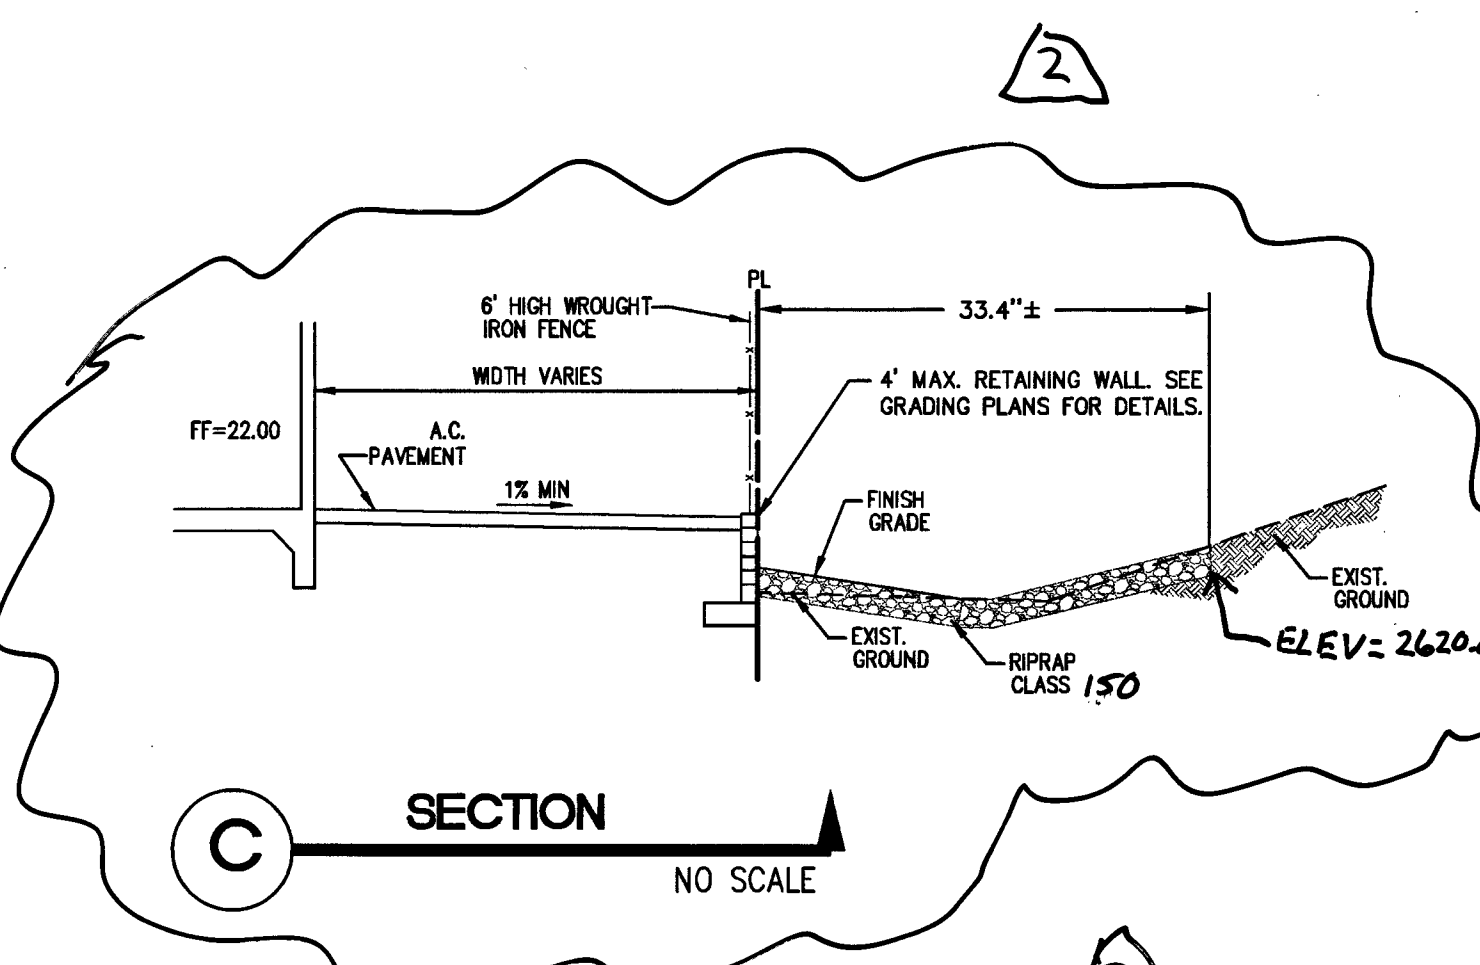
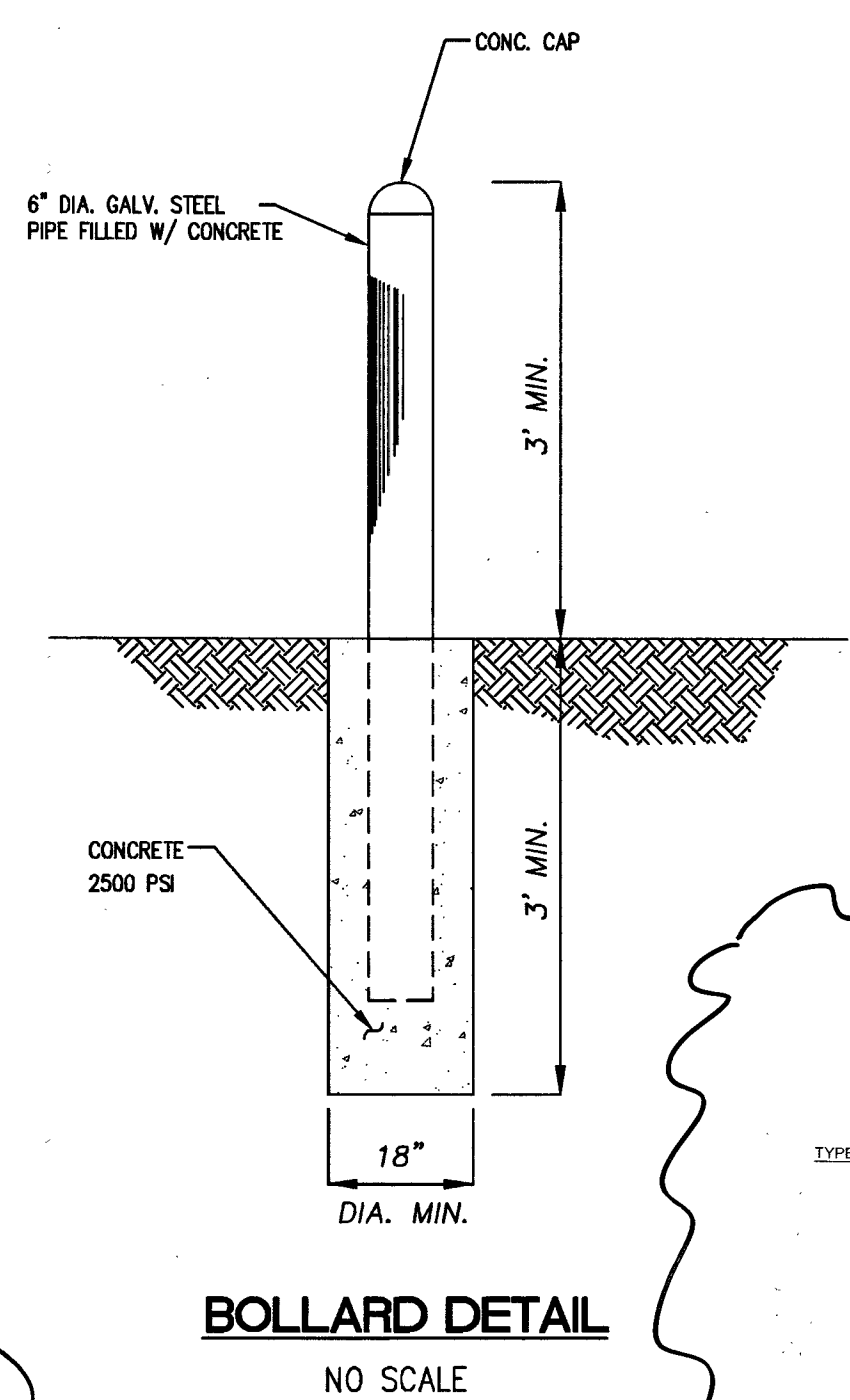
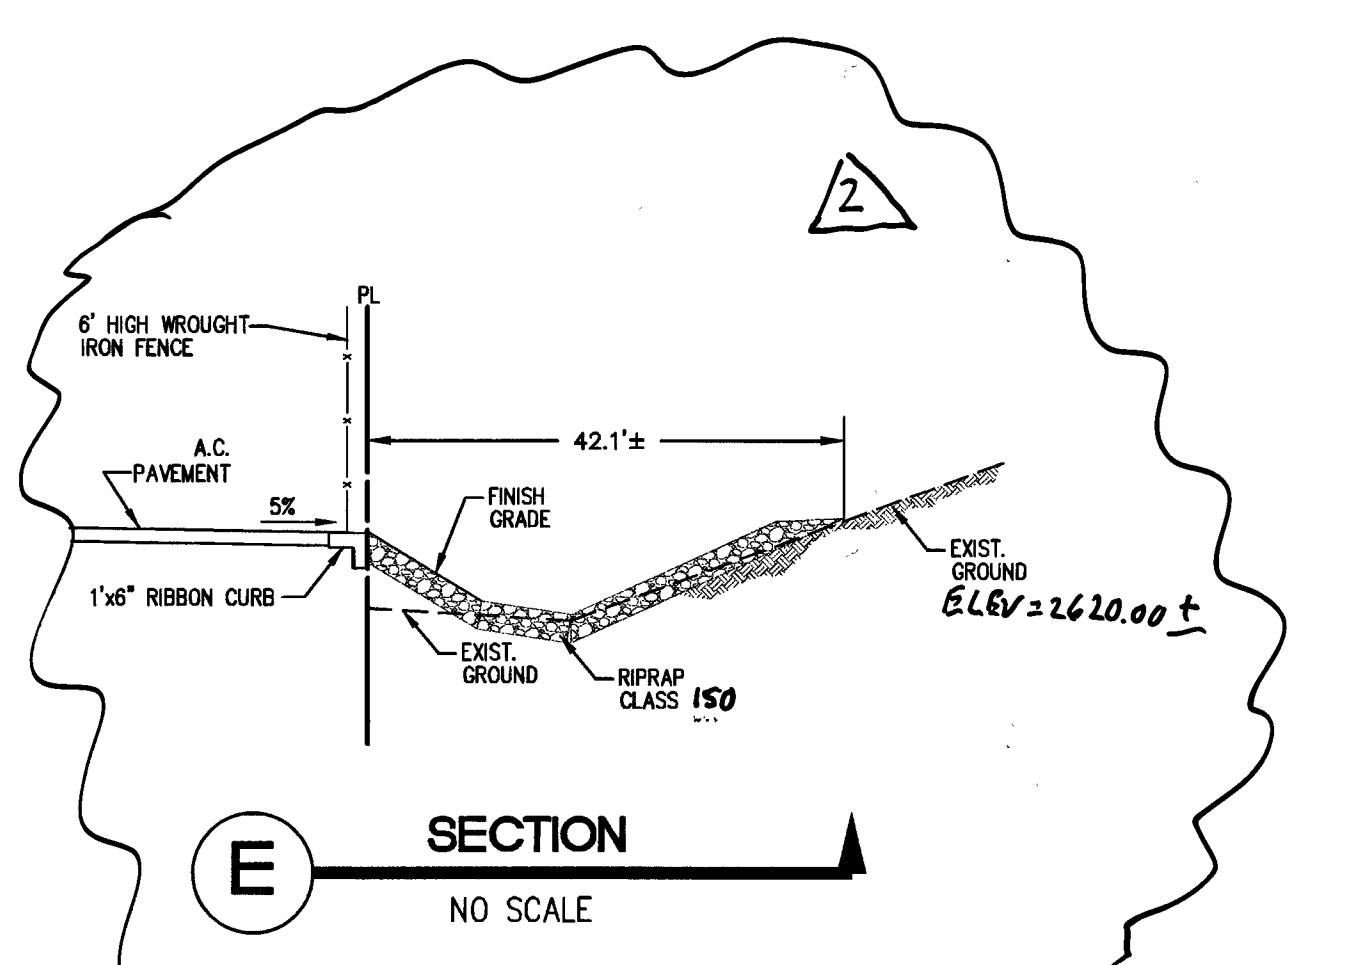
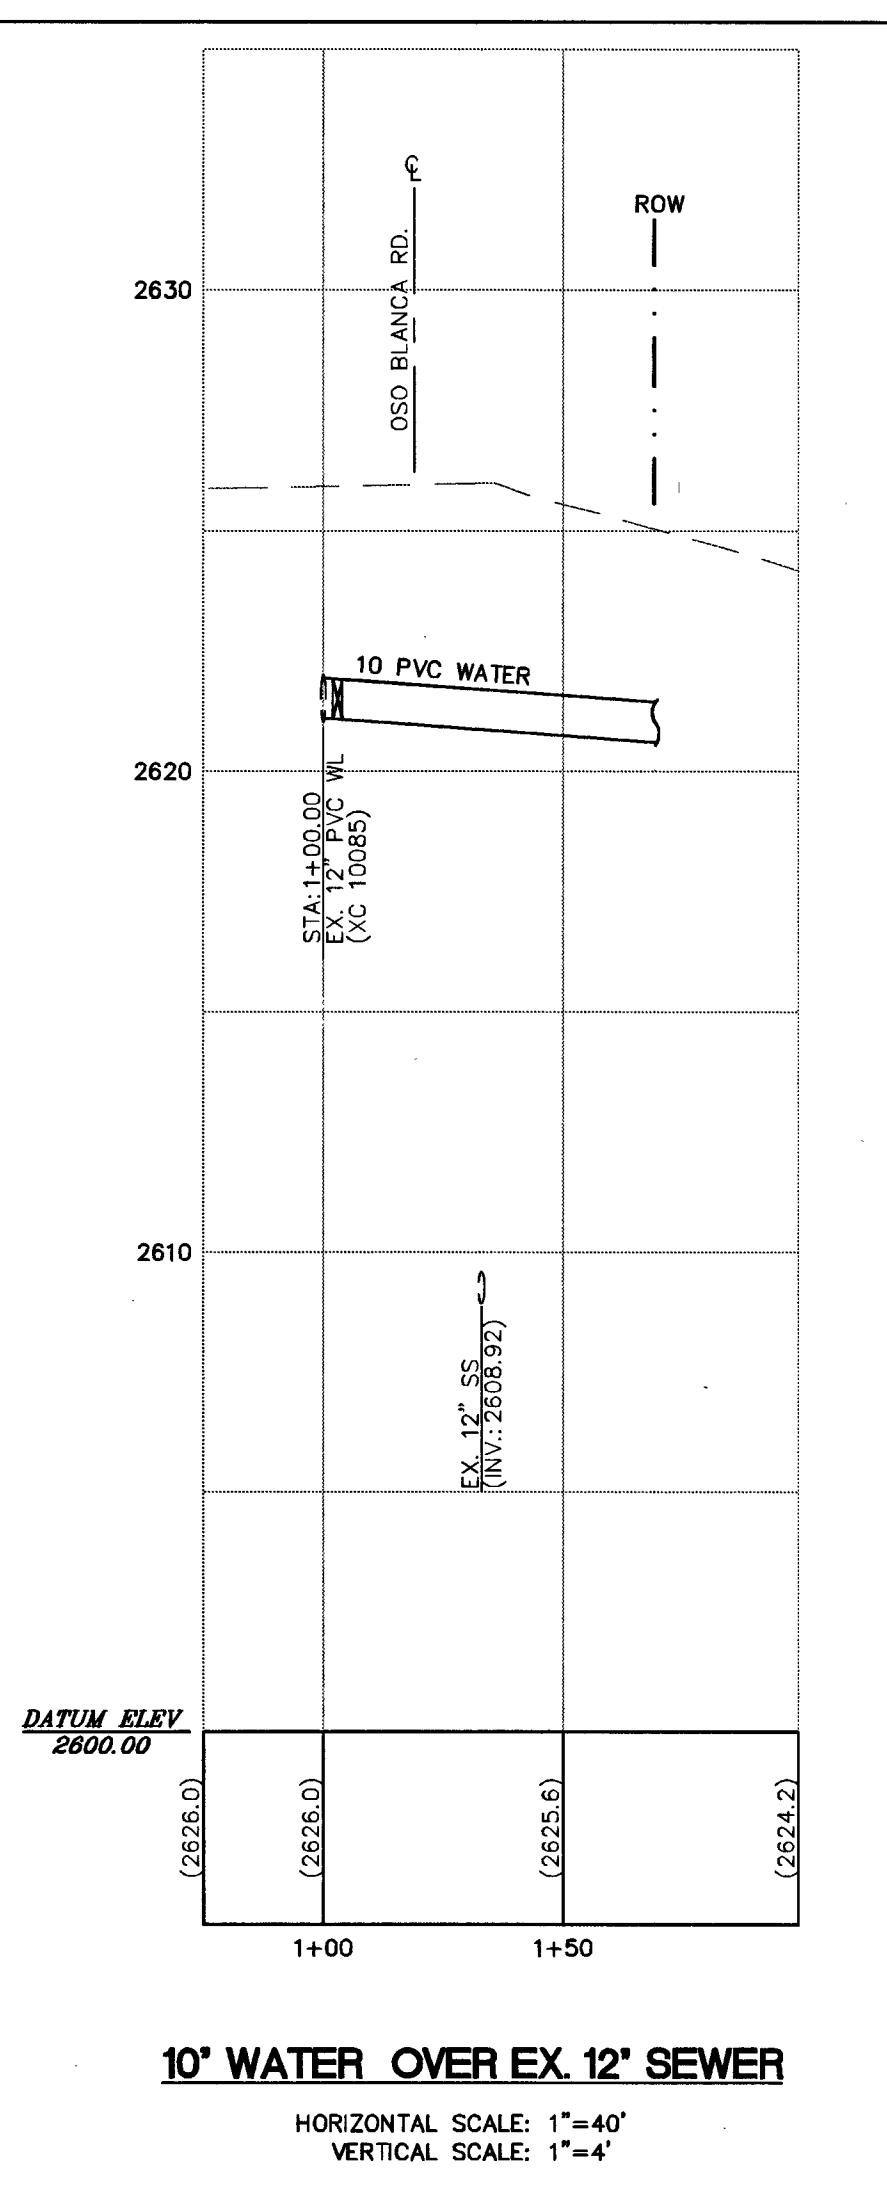
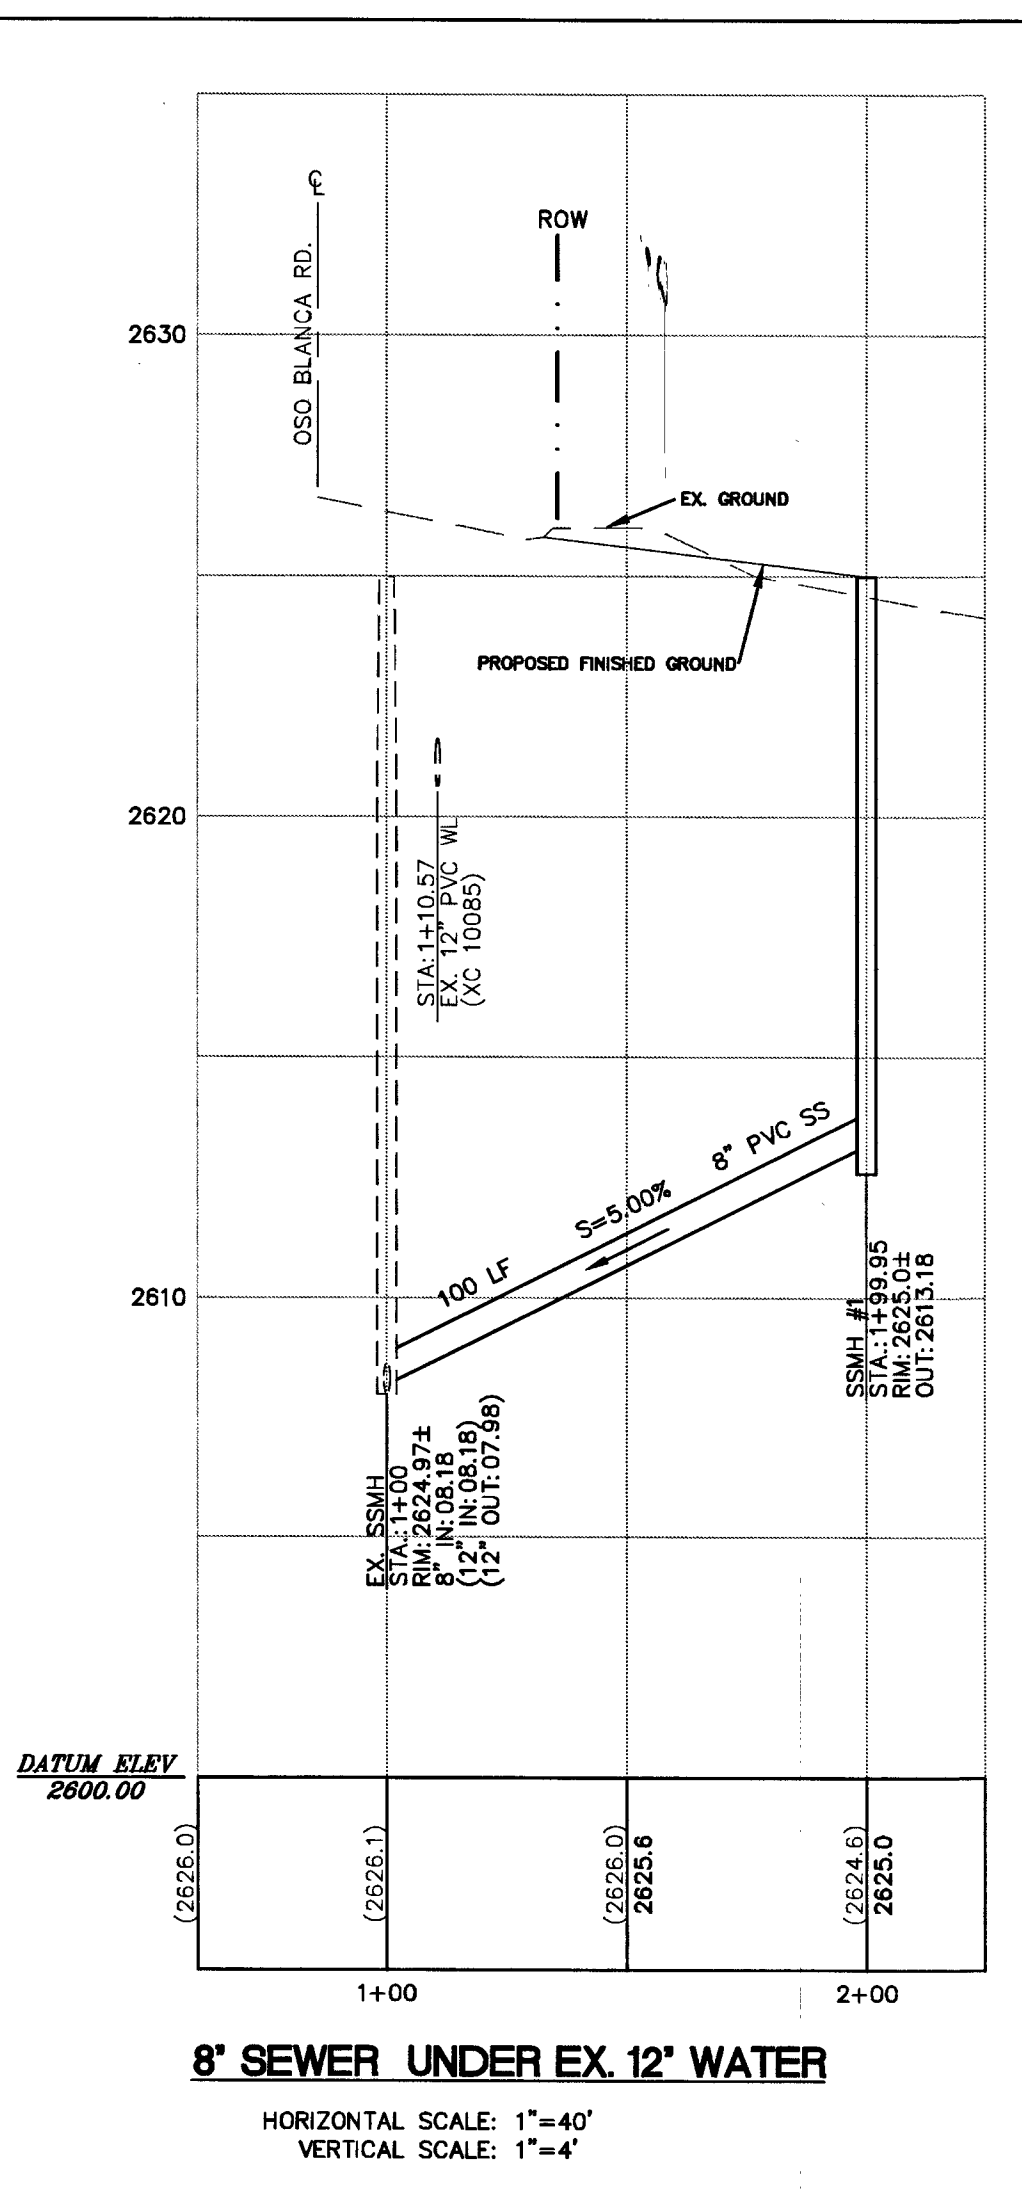
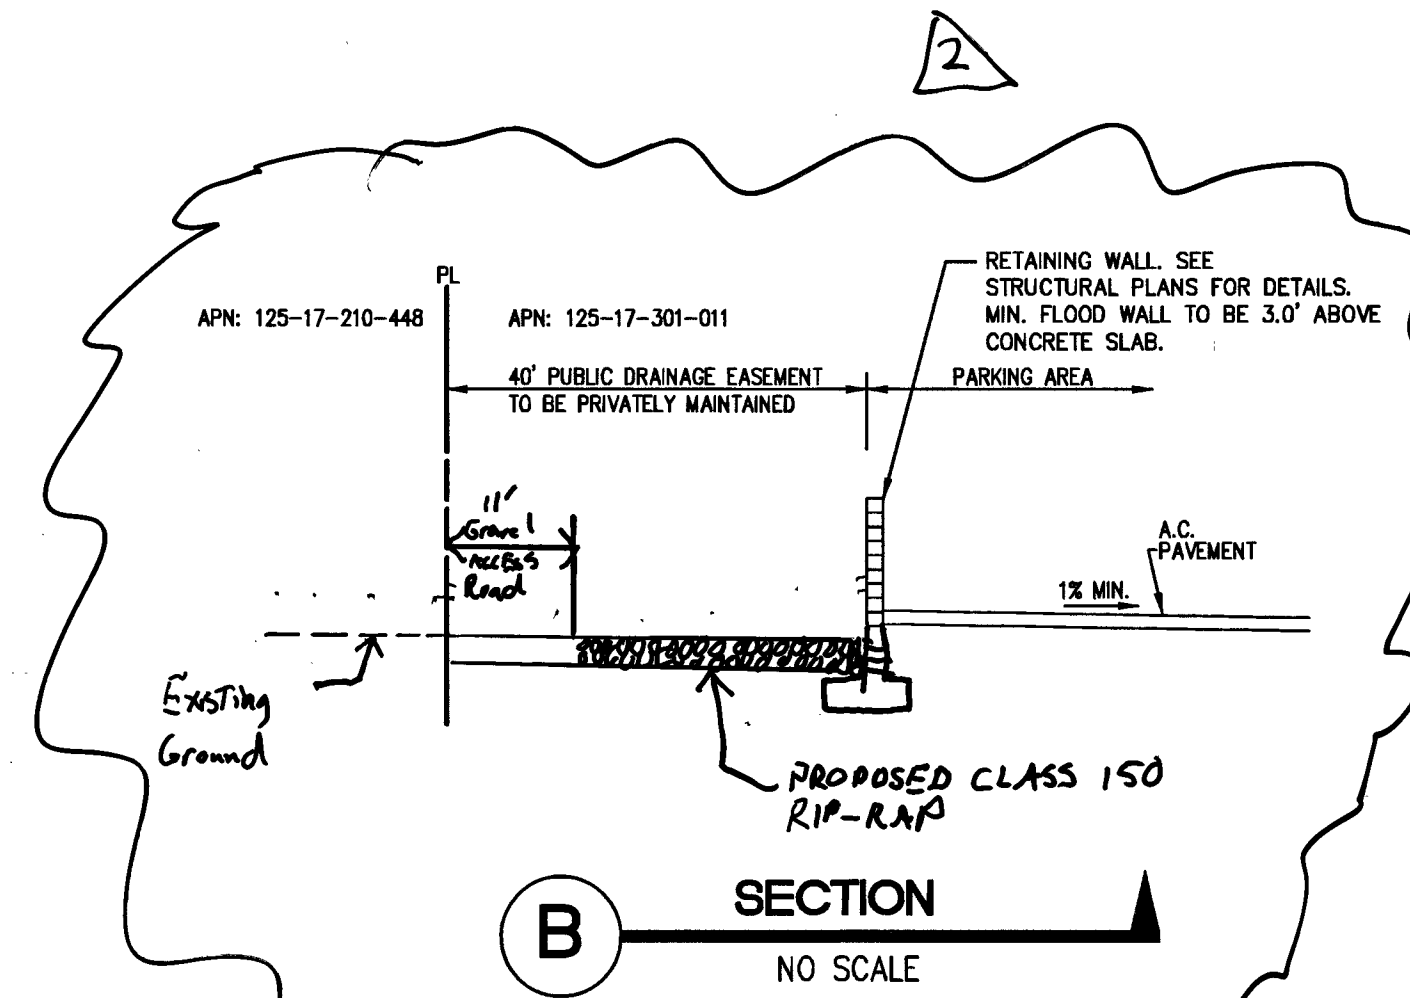
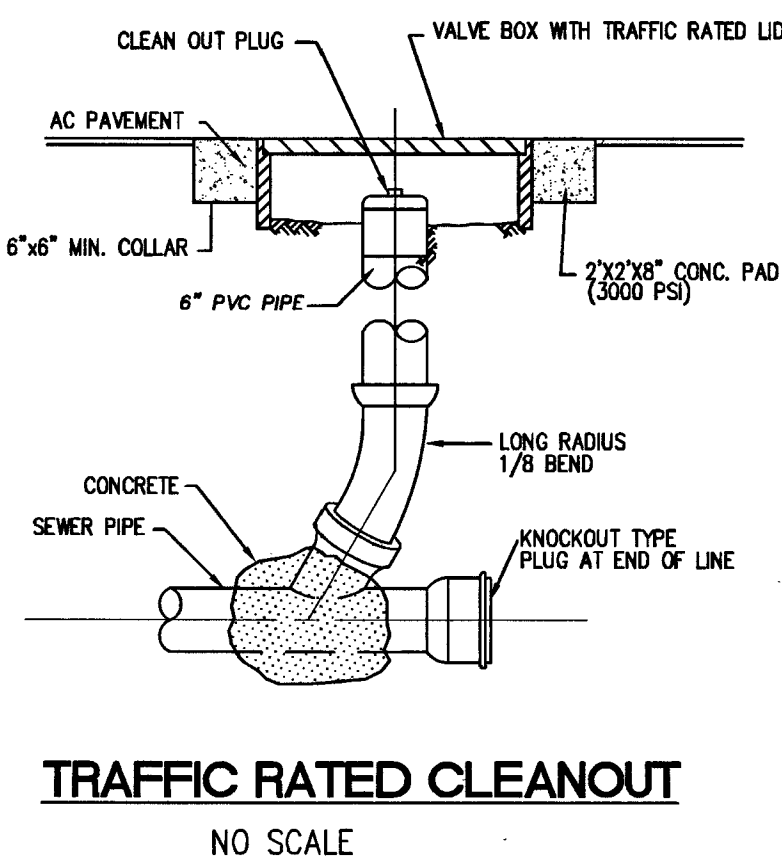
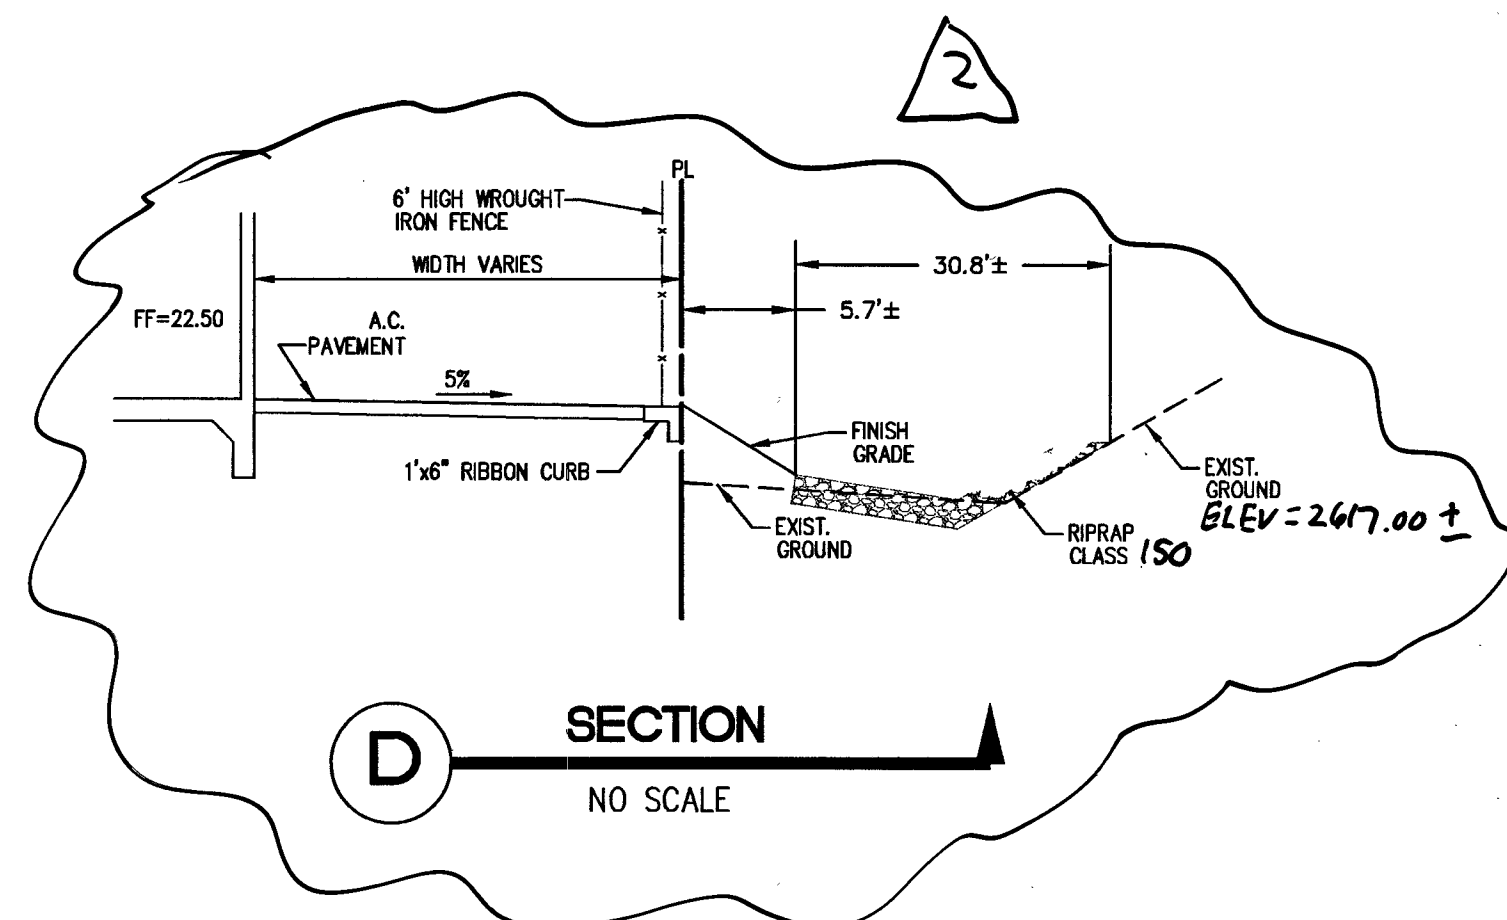
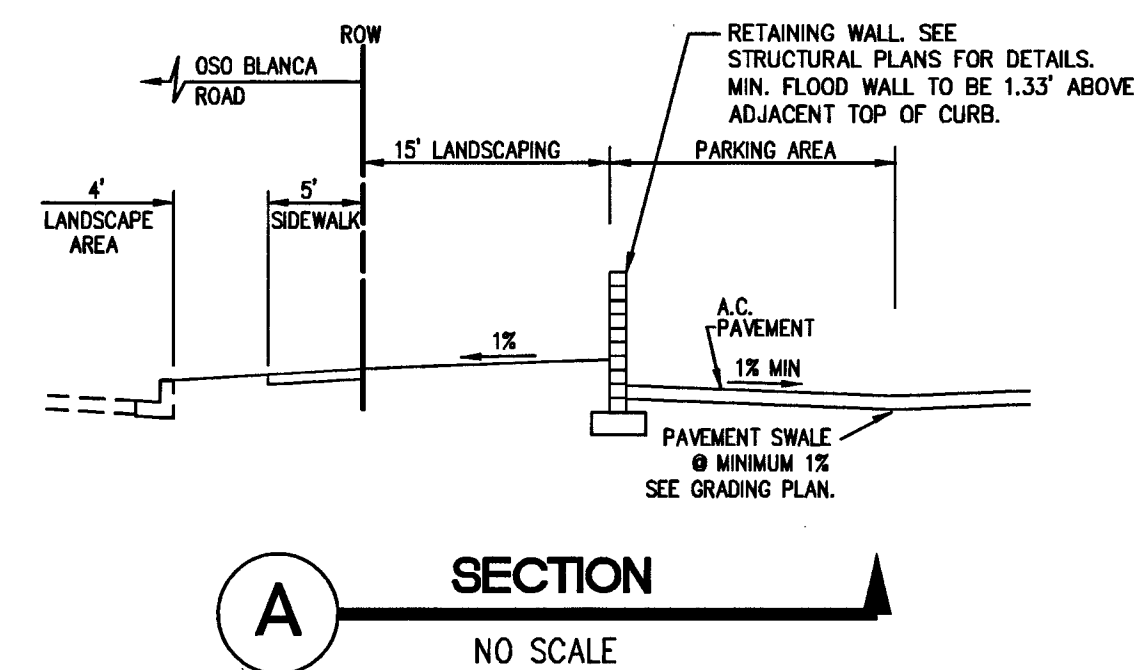
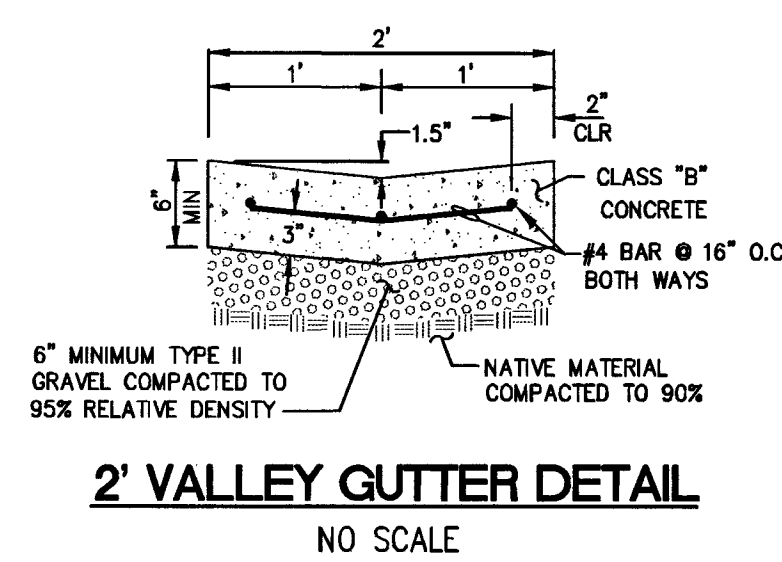
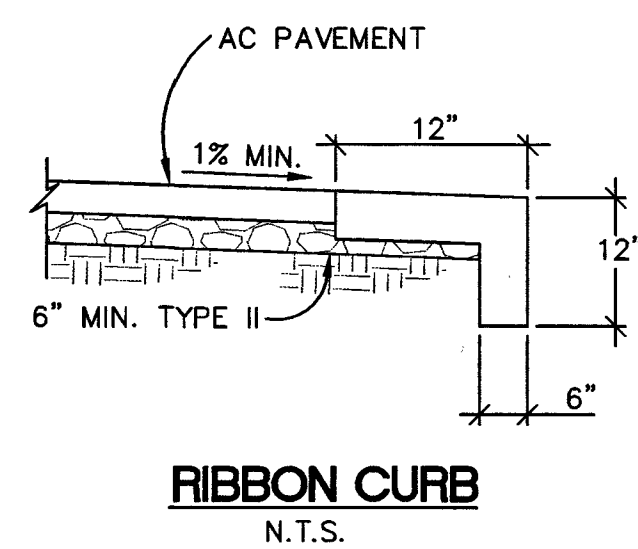


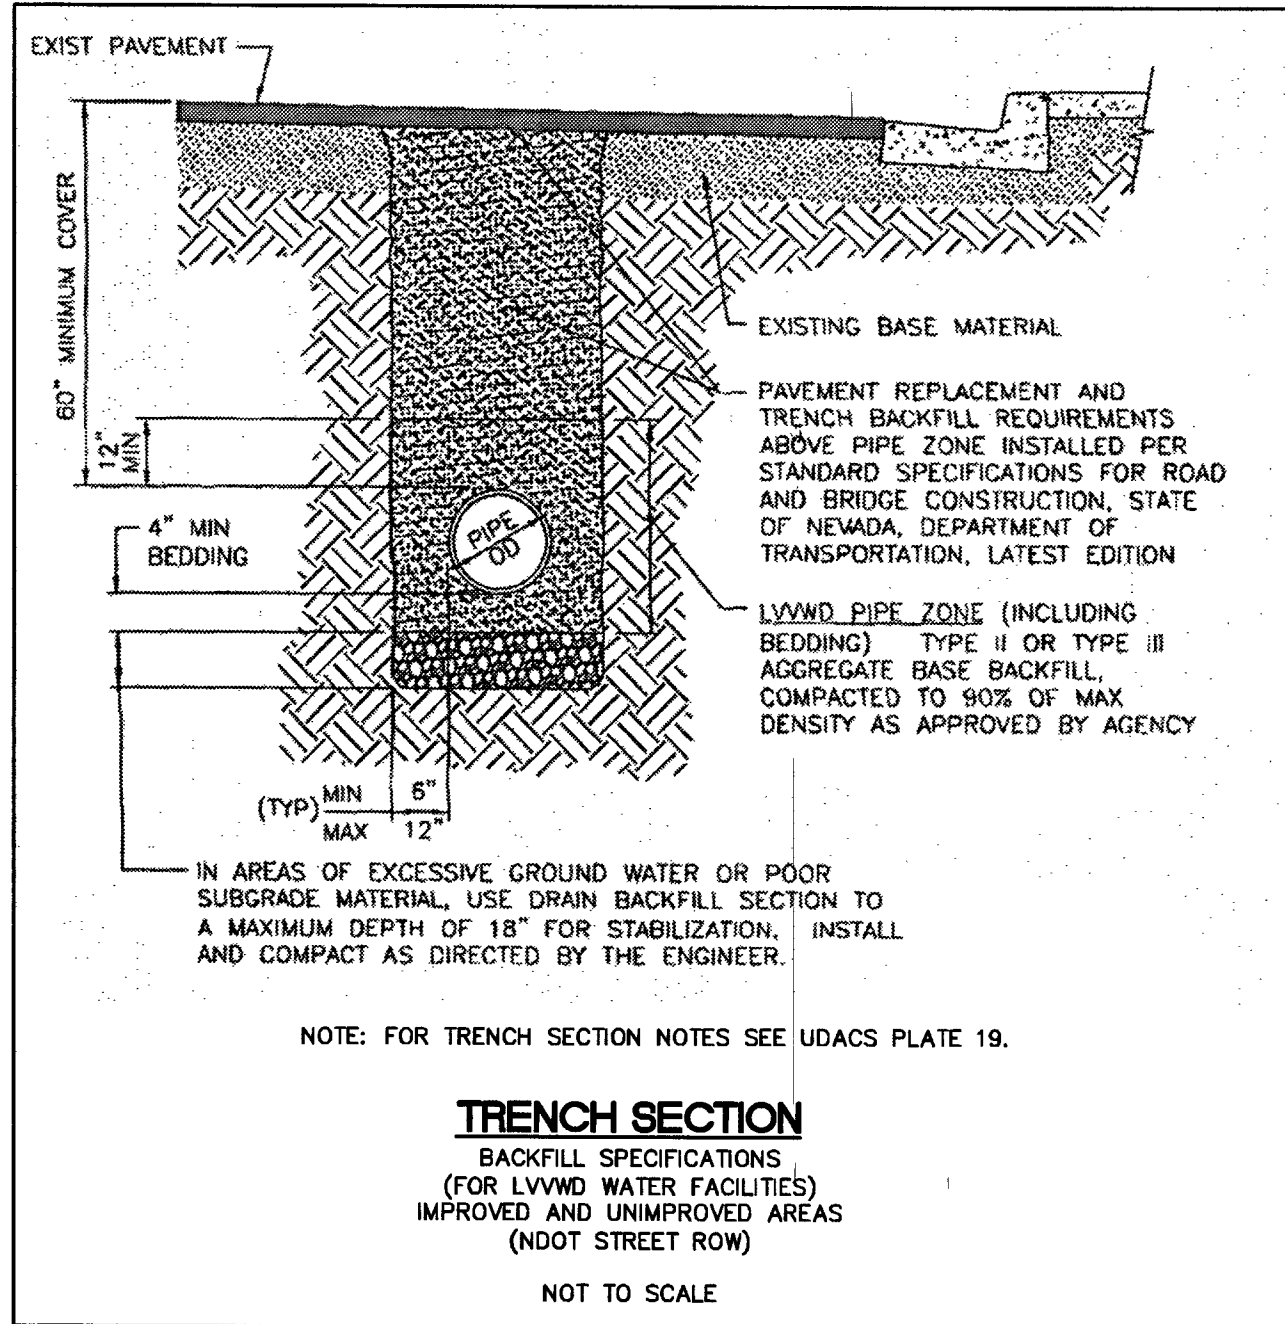

APPROVED FOR CONSTRUCTION
1st Approved 10/17/15
LAS VEGAS VALLEY WATER DISTRICT
ENGINEERING SERVICES MANAGER
LVWD PROJECT #123587 SHEETS C1, C2, C6, C8
LVWD APPROVED FIRE FLOW 2.250 GPM AT 20 PSI RESIDUAL

THIS DRAWING IS AN INSTRUMENT OF SERVICE BETWEEN THE ARCHITECT AND HIS CLIENT, BUT REMAINS THE PROPERTY OF THE ARCHITECT.
ALL RIGHTS RESERVED 2014

planning/interior design
AA ARCHITECTS, PC
(702) 876-0668
professional corp. / certified n.c.a.b.
architecture/engineering/site
GARY GUY WILSON
4945 West Patrick Lane
Las Vegas, Nevada 89118
CONSULTANTS:
civilworks inc.
4945 W. Patrick Lane, Las Vegas, NV 89118
OFFICE: (702) 344-7555 FAX: (702) 344-8255

STORAGE ONE
@ 7422 OSO BLANCA ROAD
NEW COMMERCIAL CONSTRUCTION
FOR: WESTAR/STORAGE ONE
LAS VEGAS, NEVADA

PROJ. NO.	14981320.00
PRIN. ARCH.	G.G. WILSON, AIA
PROJ. ARCH.	-
JOB CAPT.	MML
DESIGNER	TND
ENGINEER	PDW
PH-2/3	-
PH-4	-
PH-5	-

REVISIONS
2. REVISED RIP-RAP FROM CLASS 300 TO CLASS 150 AND ADDED MAX ELEV. AND TYPE IIIA BARRICADE DETAIL

PRINTS REQUIRE ARCHITECT'S SEAL & SIGN FOR PROOF OF VALIDITY
JODI E. JORJORIAN
Exp. 6/30/15
CIVIL
No. 13816
10/17/15
107V6538
SHEET NO. C8
SHEET 8 OF 10