
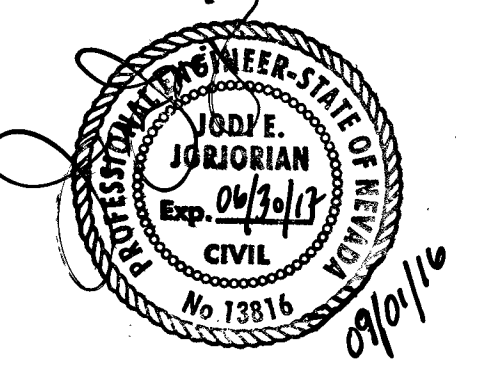
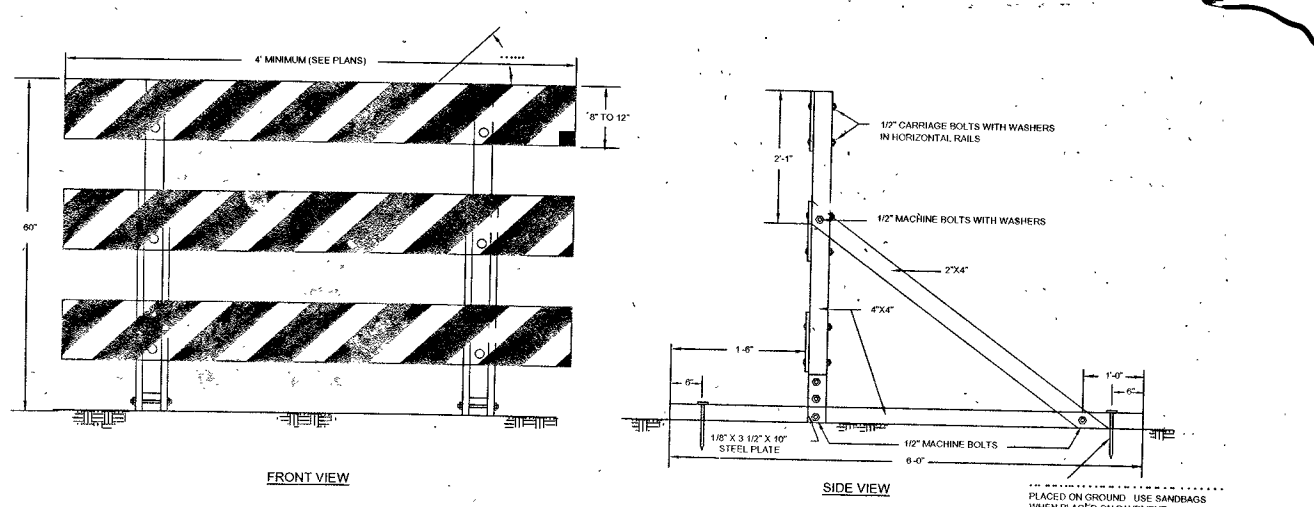
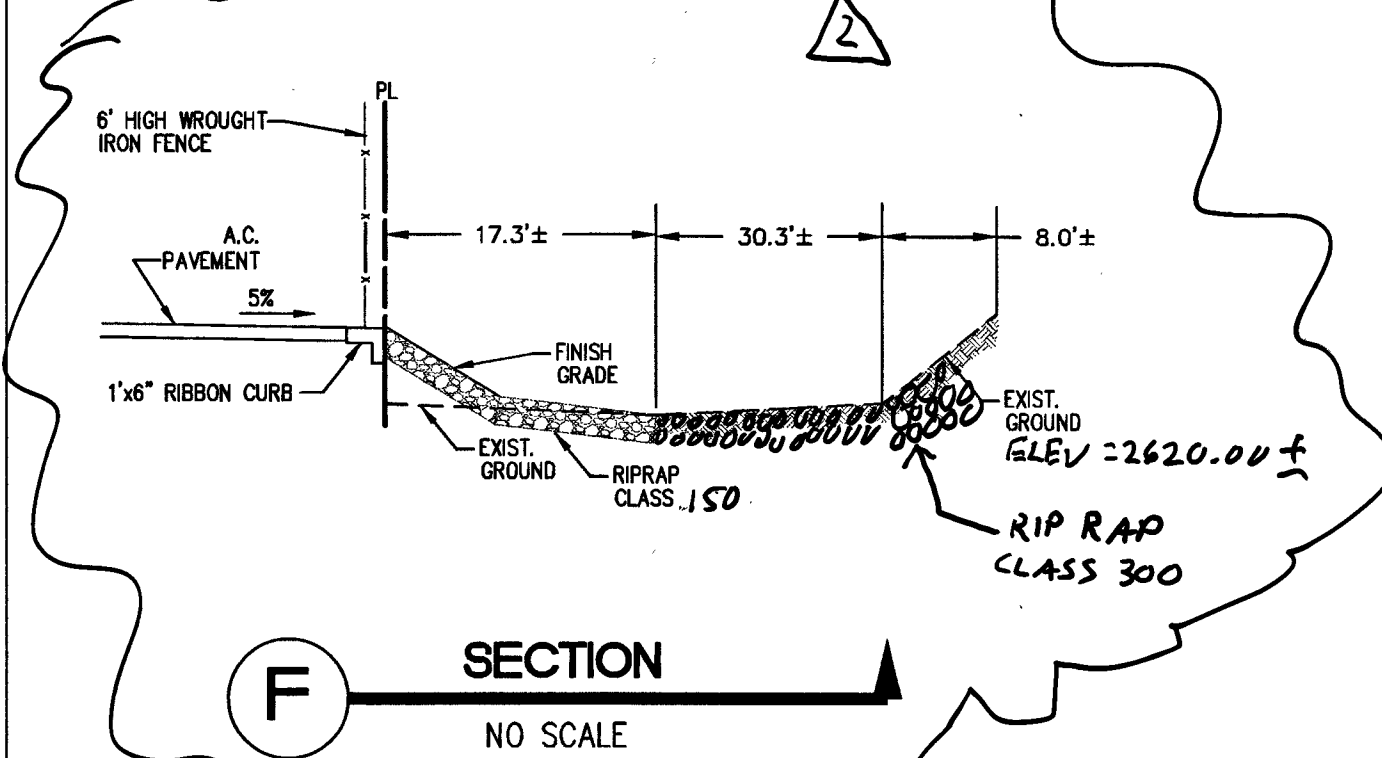
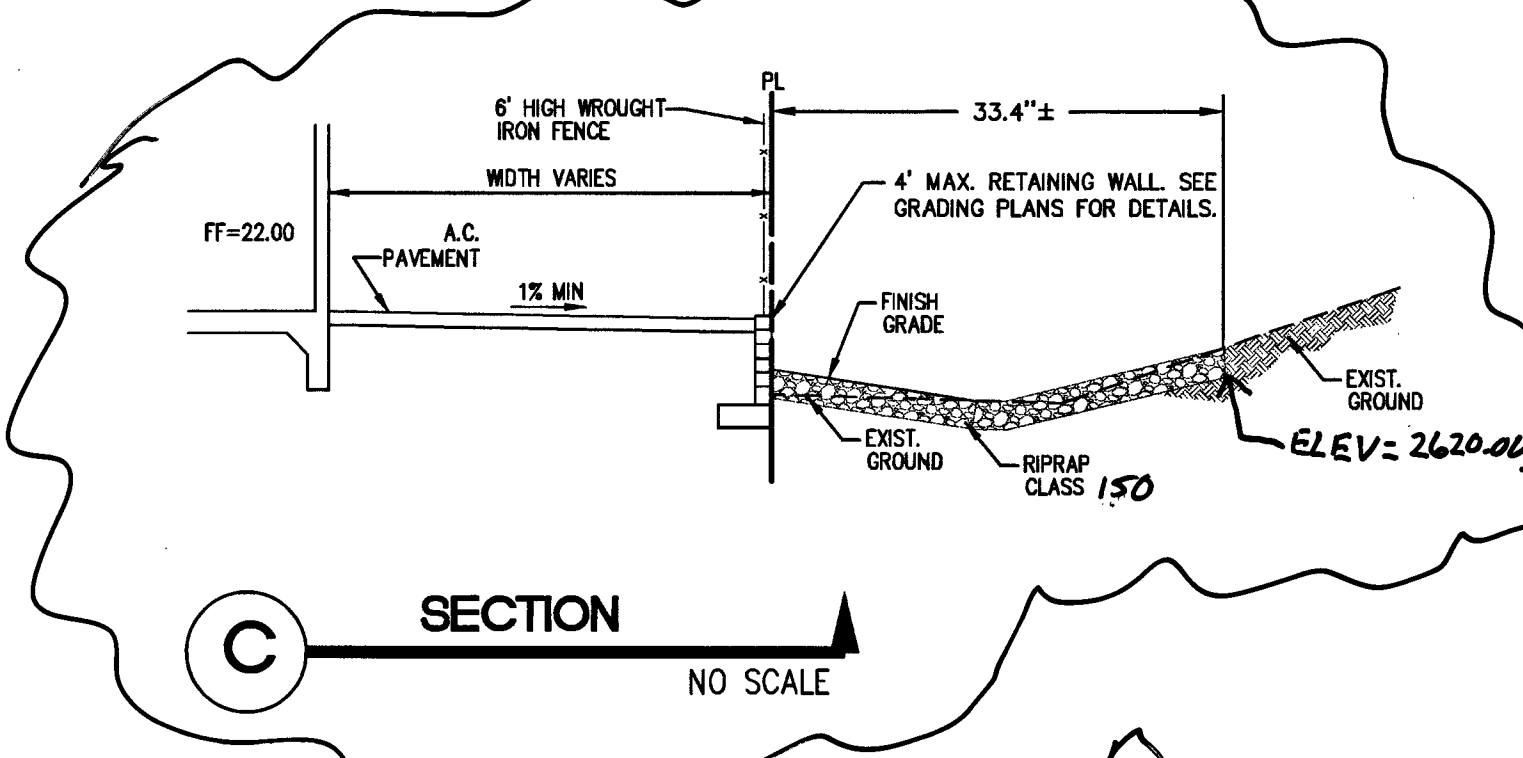
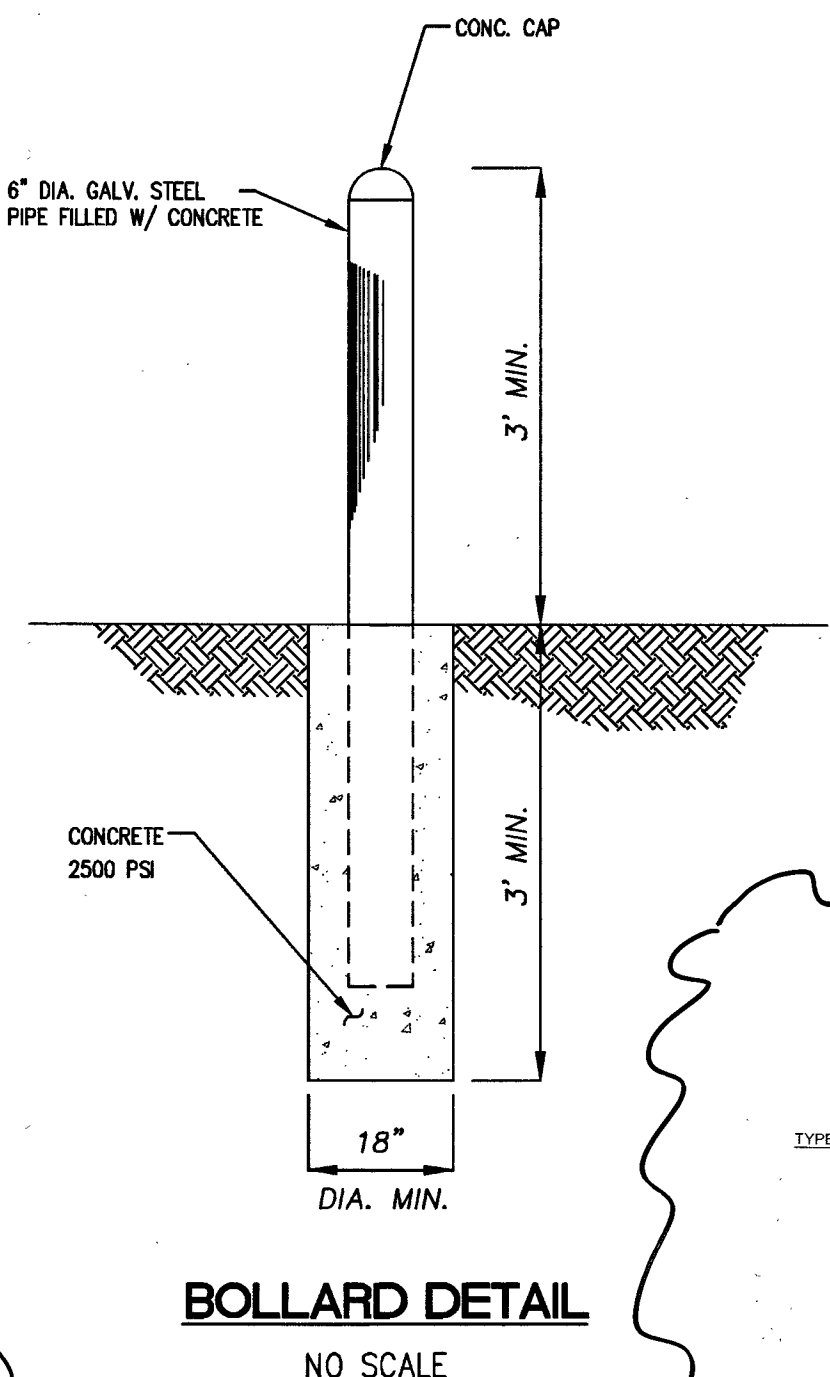
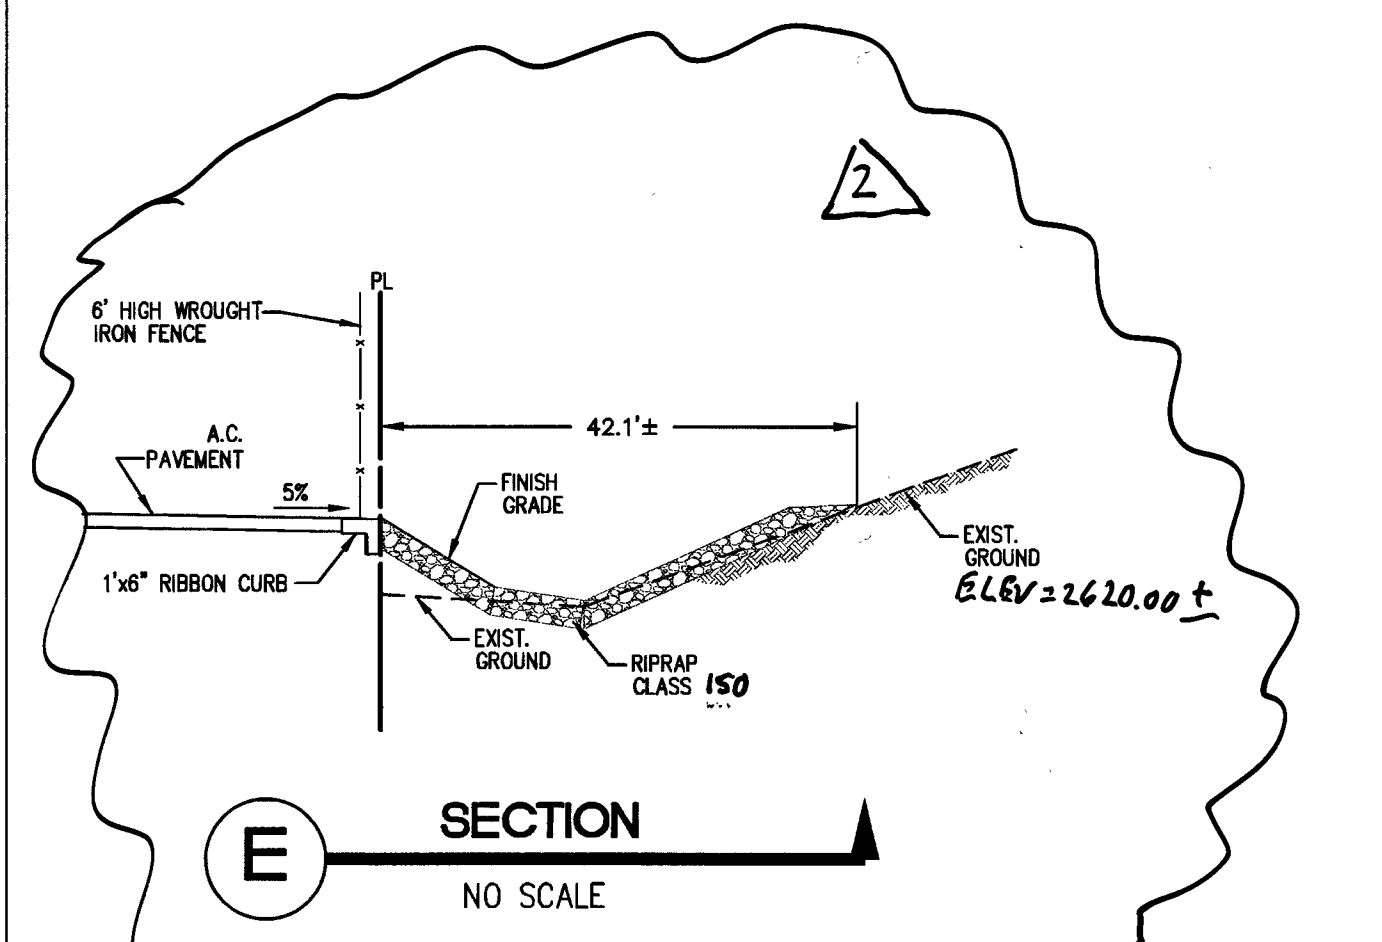
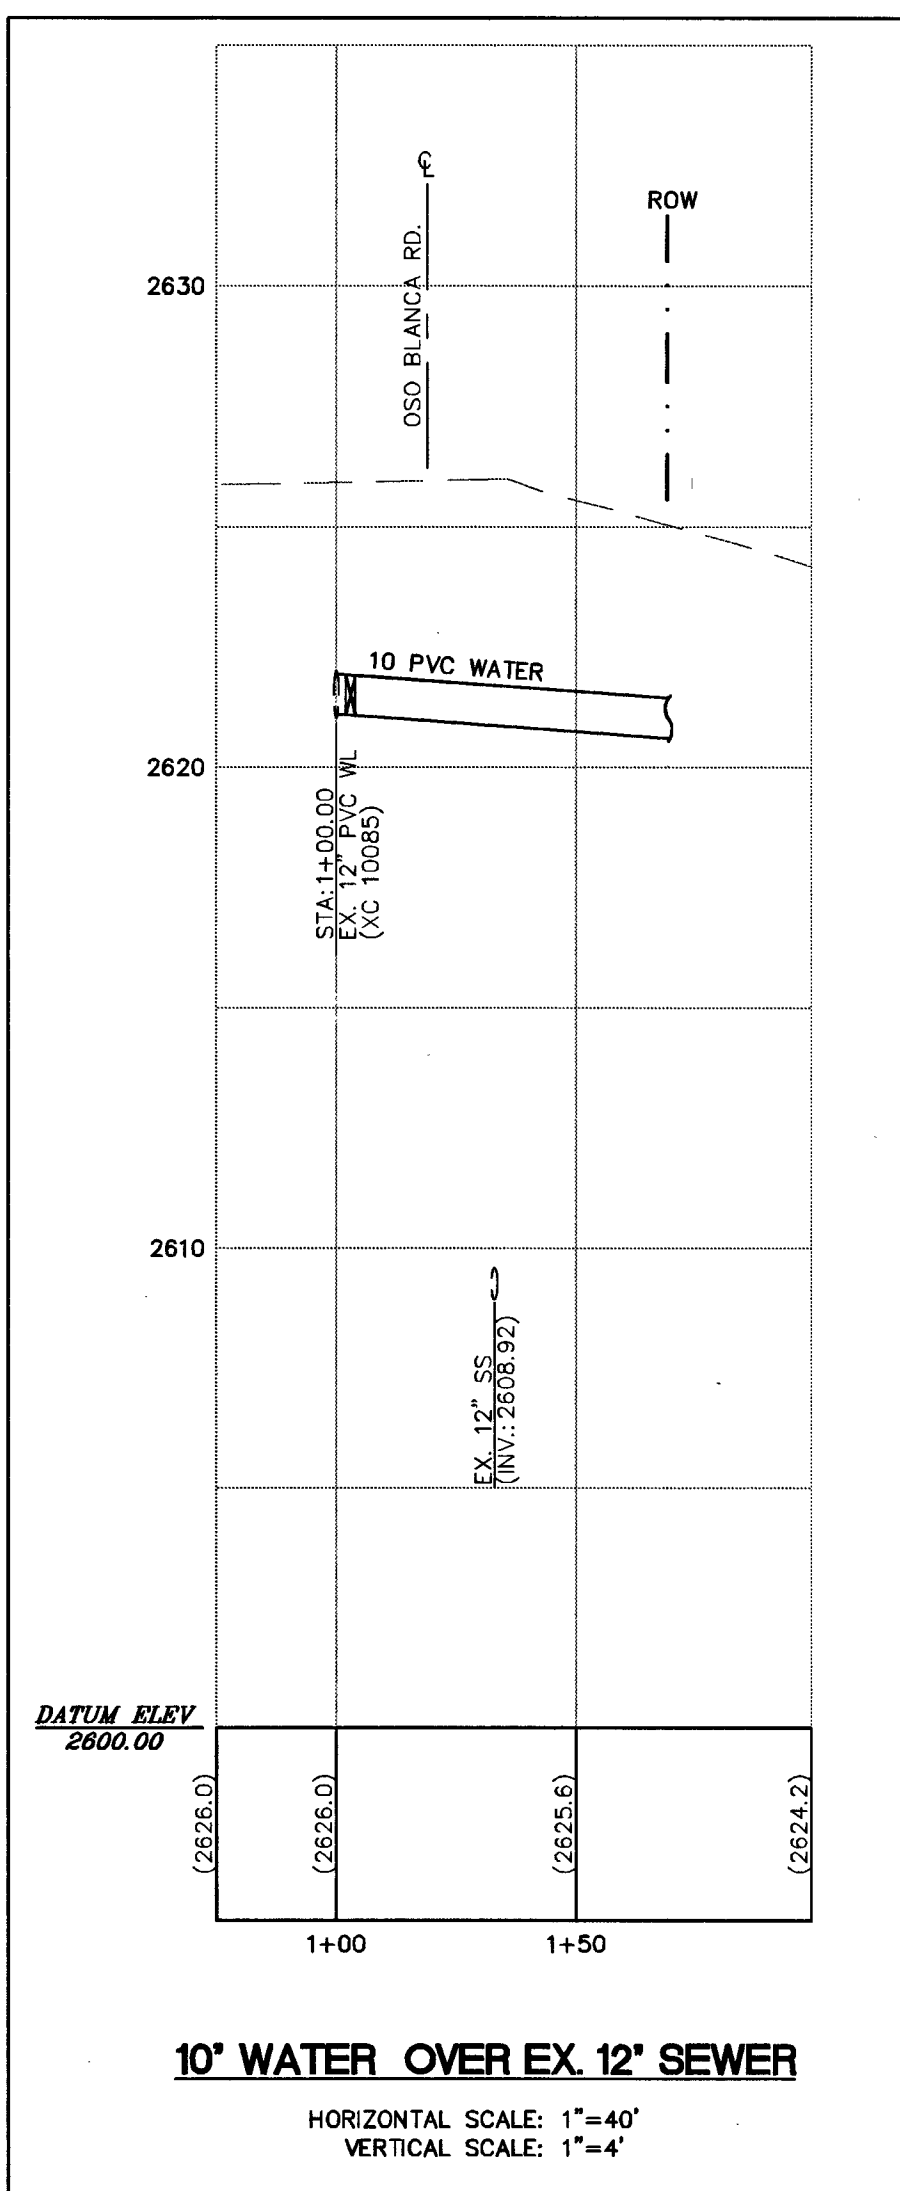
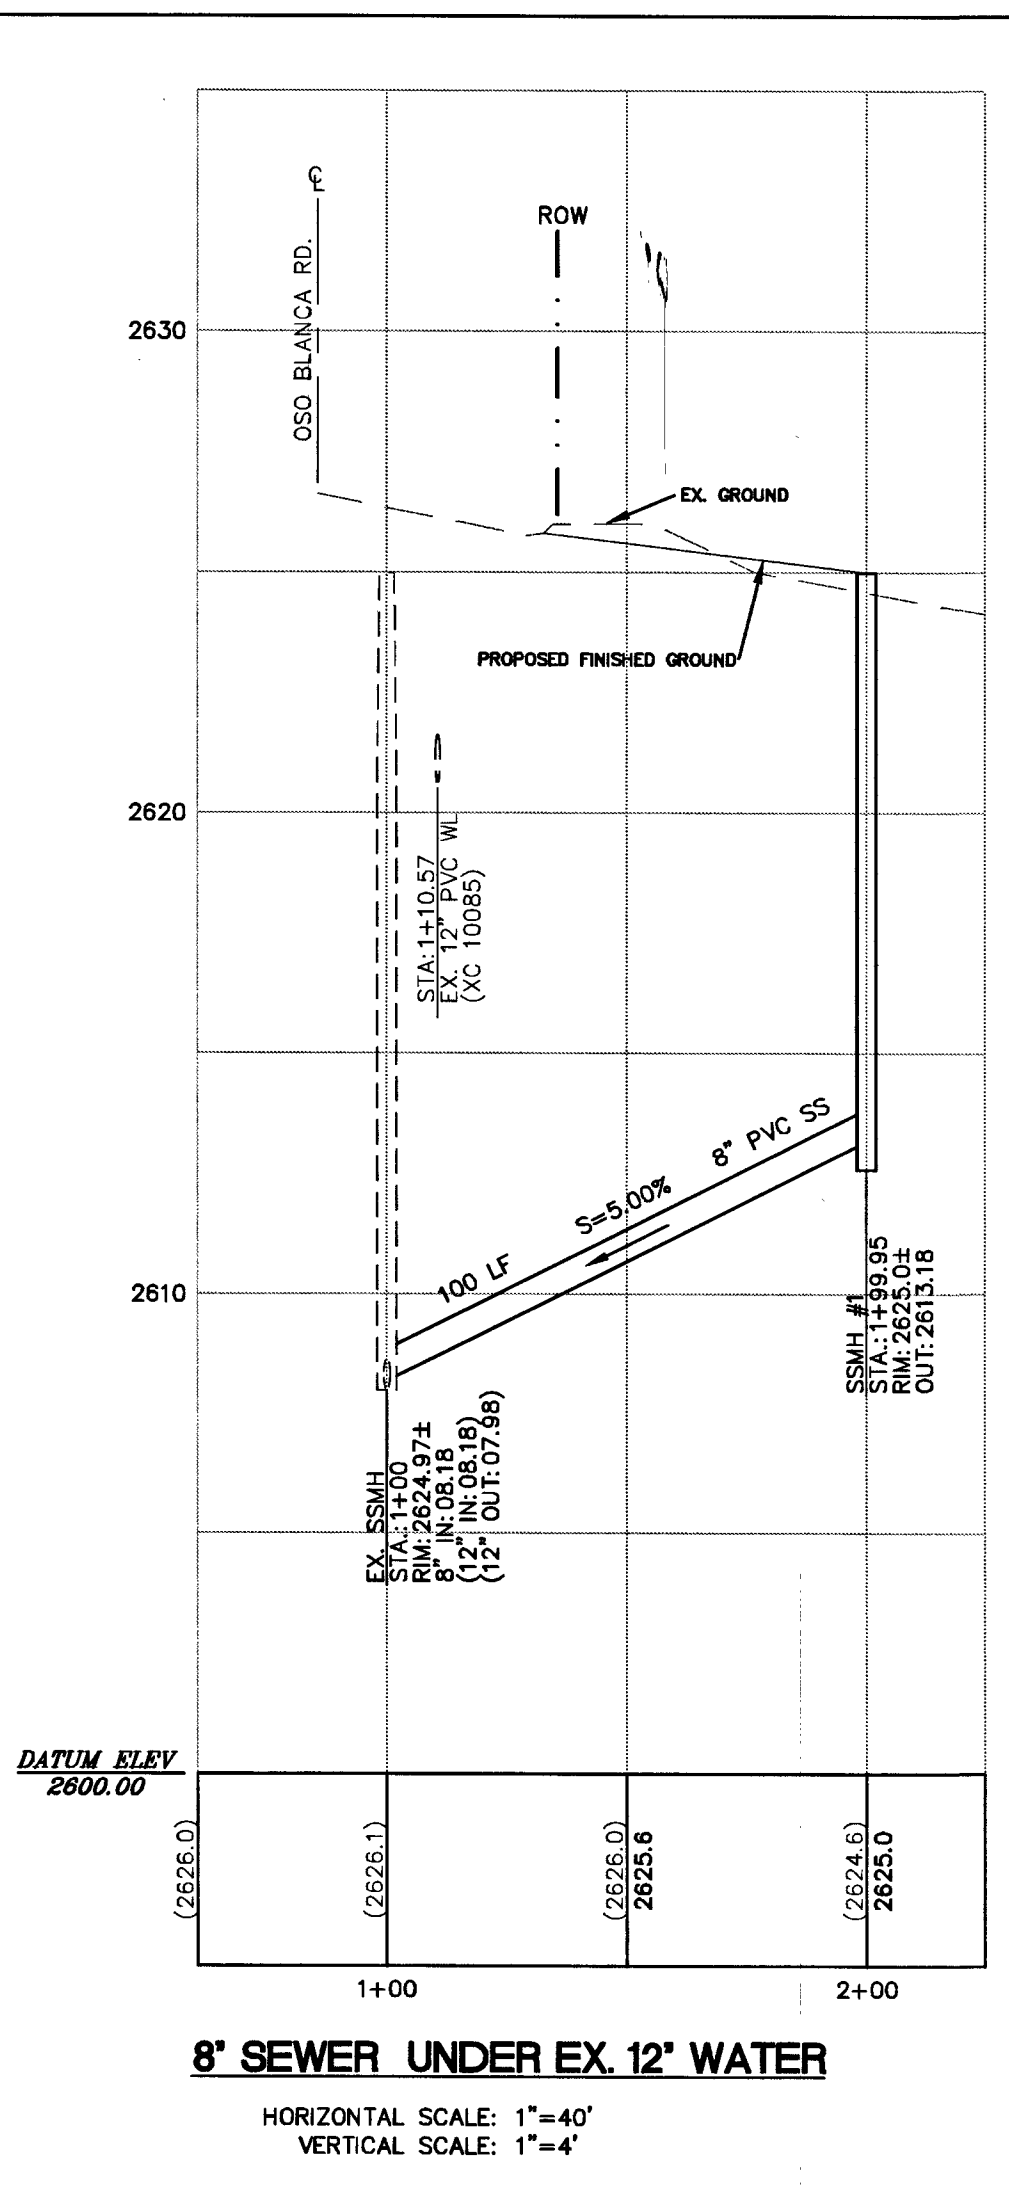
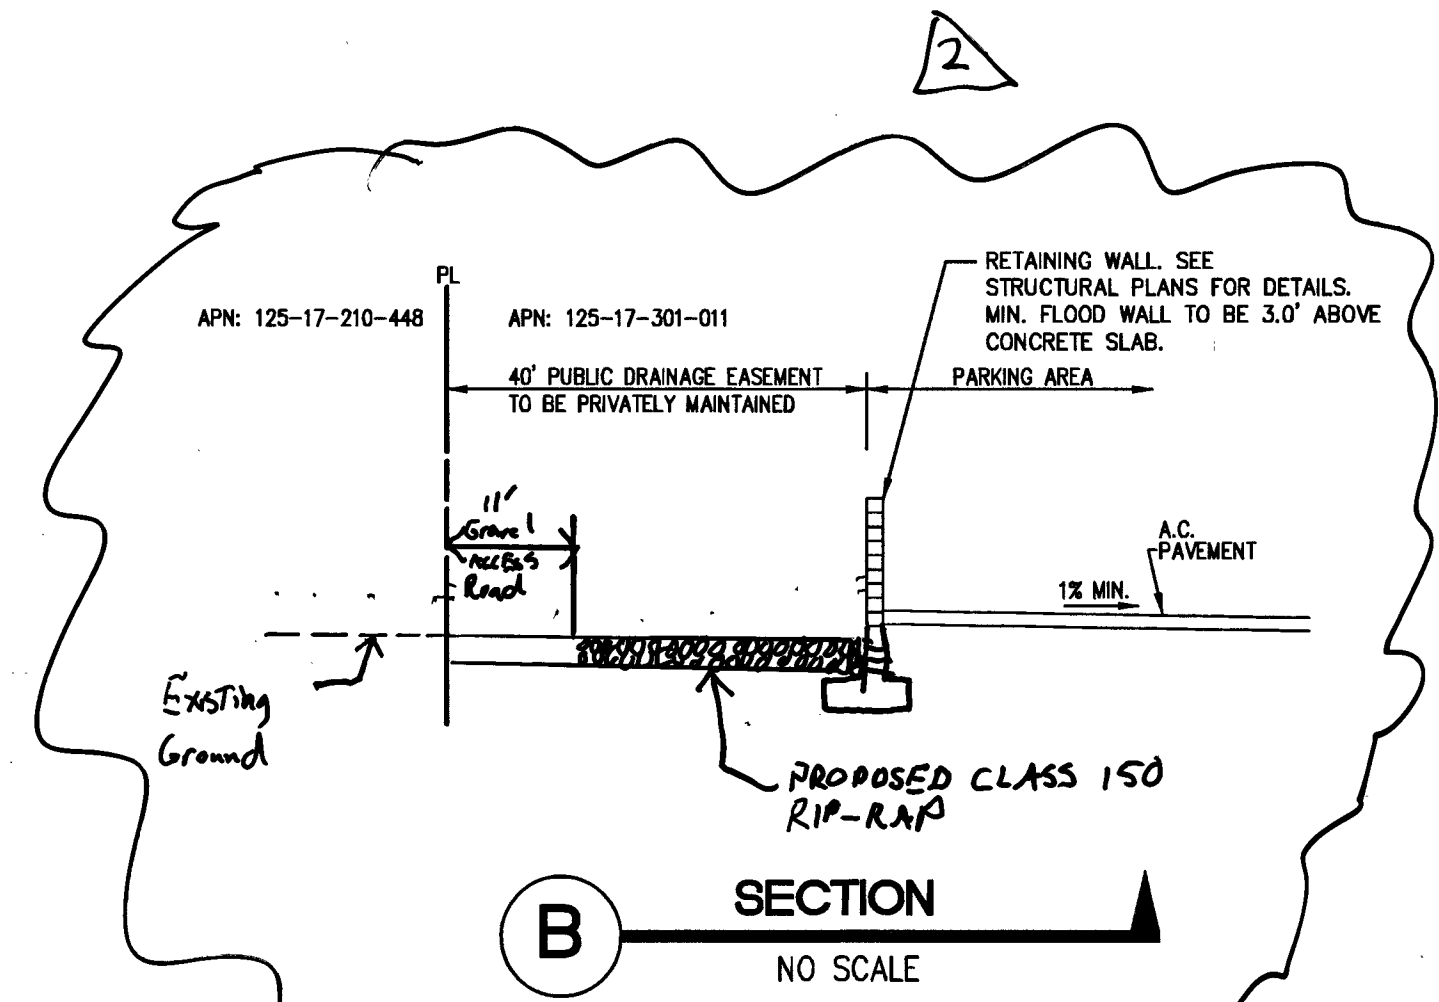
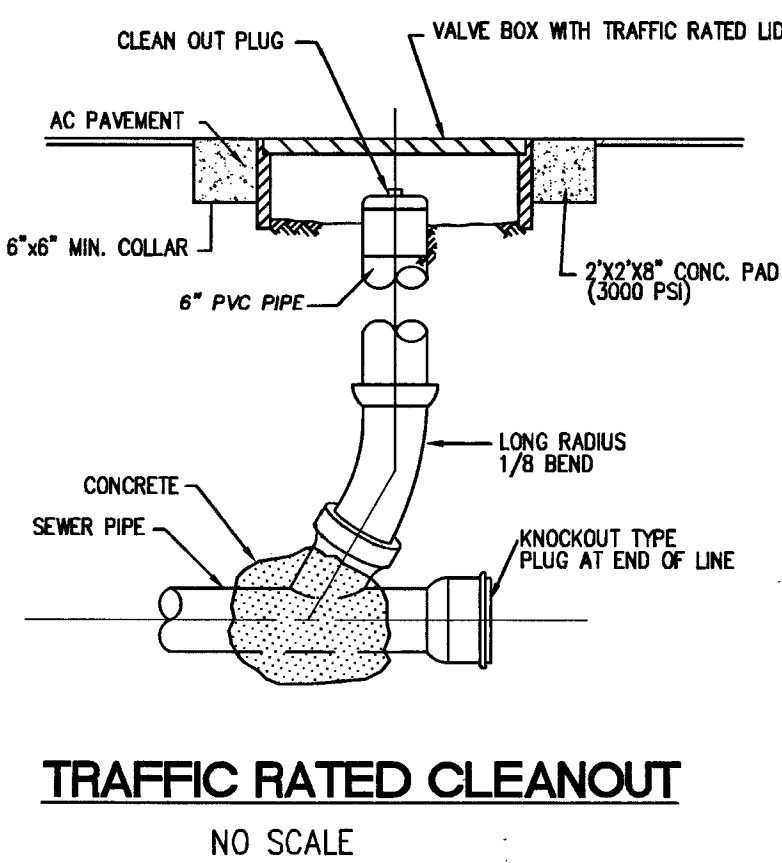
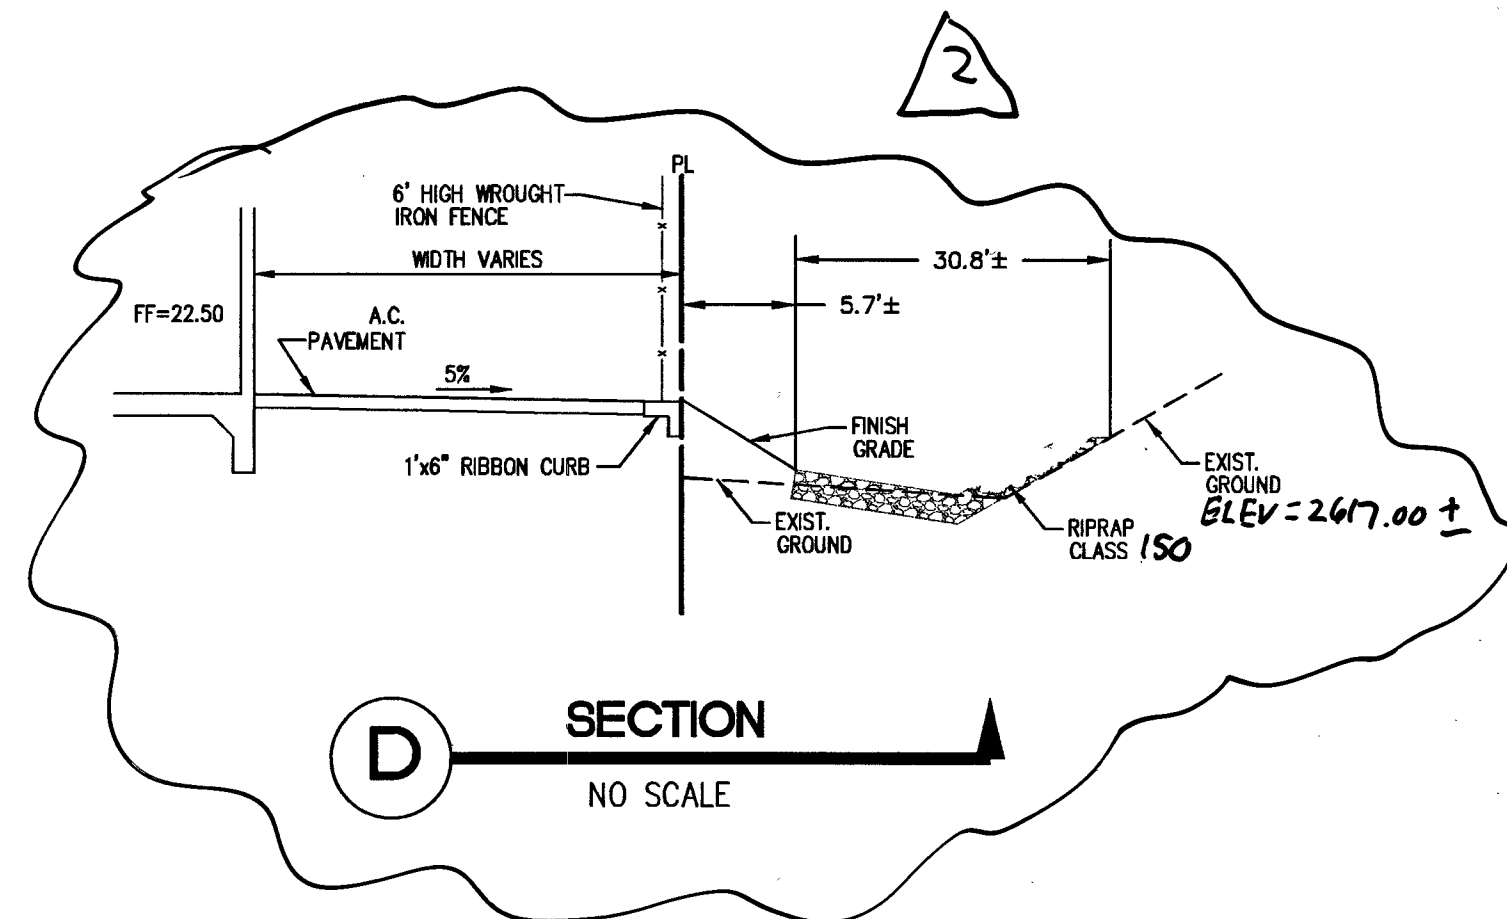
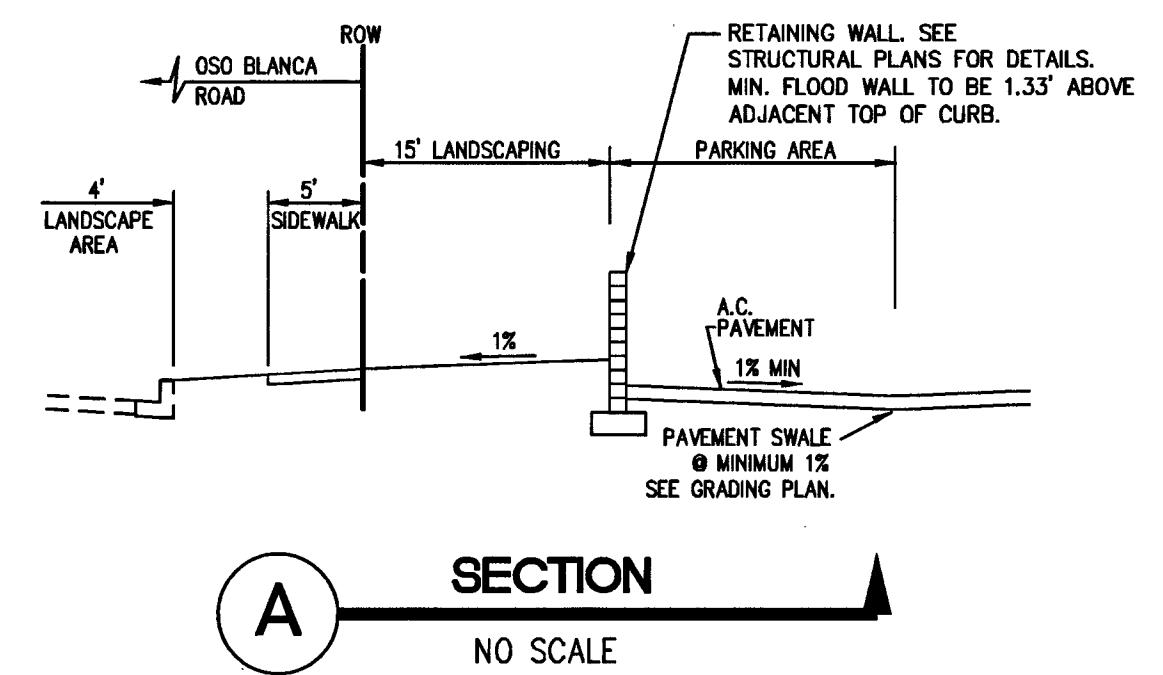
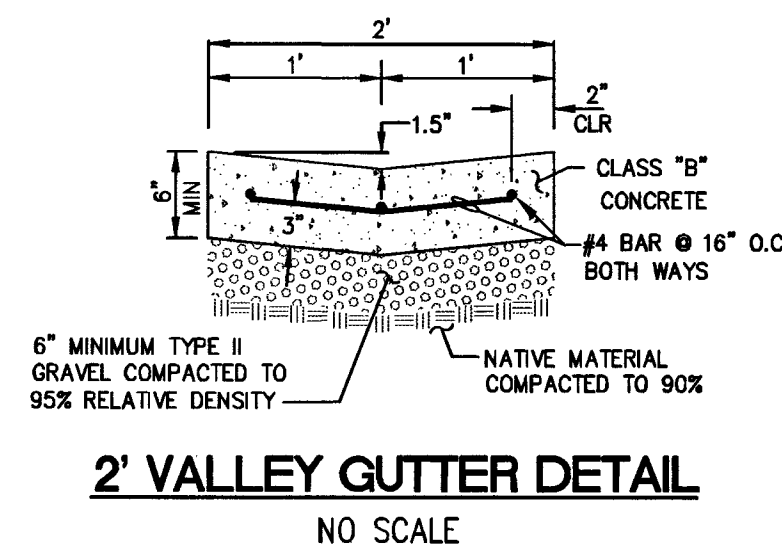
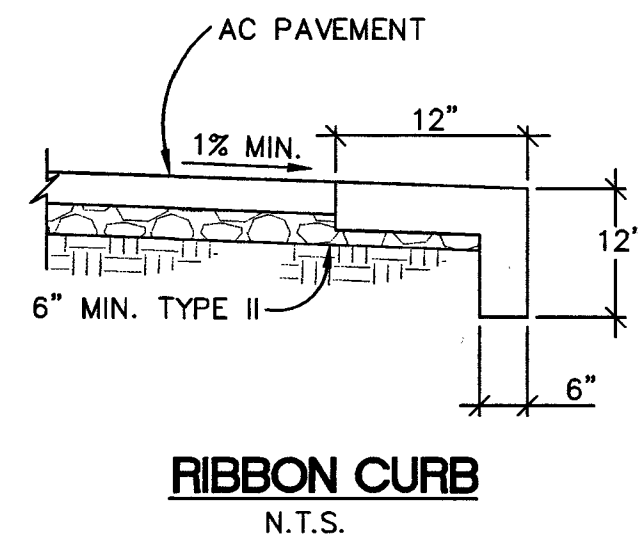


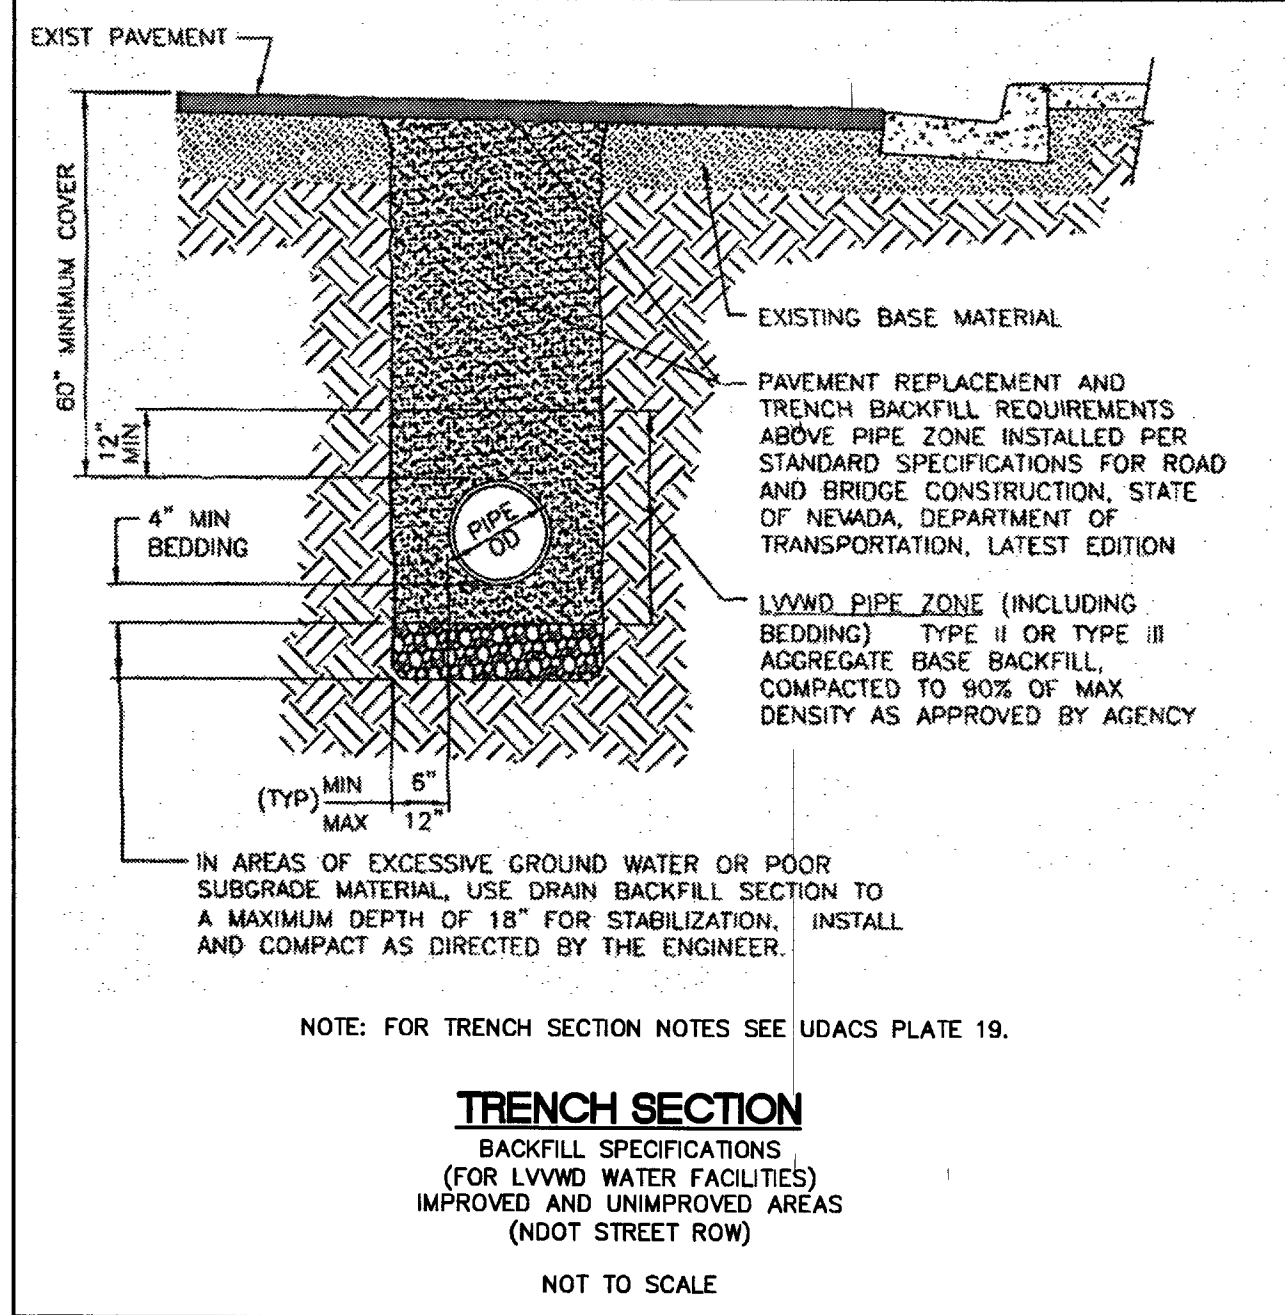

APPROVED FOR CONSTRUCTION
 1st Approved 10/17/15
 Jodi E. Jorjorian
 Las Vegas Valley Water District
 Engineering Services Manager
 DATE: 10/17/15
 LVWD PROJECT #123587 SHEETS C1, C2, C6, C8
 LVWD APPROVED FIRE FLOW 2.250 GPM AT 20 PSI RESIDUAL

THIS DRAWING IS AN INSTRUMENT OF SERVICE BETWEEN THE ARCHITECT AND HIS CLIENT, BUT REMAINS THE PROPERTY OF THE ARCHITECT.
 ALL RIGHTS RESERVED
 2014

planning/interior design
AA ARCHITECTS, PC
 (702) 876-0668
 professional corp. / certified n.c.a.b.

STORAGE ONE
 @ 7422 OSO BLANCA ROAD
 NEW COMMERCIAL CONSTRUCTION
 FOR: WESTAR/STORAGE ONE
 LAS VEGAS, NEVADA

PROJ. NO.	14981320.00
PRIN. ARCH.	G.G. WILSON, AIA
PROJ. ARCH.	-
JOB CAPT.	MML
DESIGNER	TND
ENGINEER	PDW
PH-2/3	-
PH-4	-
PH-5	-

REVISIONS
 1. REVISED RIP-RAP FROM CLASS 150 TO CLASS 300 AND ADDED MAX ELEV. AND TYPE IIIA BARRICADE DETAIL

PRINTS REQUIRE ARCHITECT'S SEAL & SIGN FOR PROOF OF VALIDITY
 Jodi E. Jorjorian
 State of Nevada
 License No. 13816
 CIVIL
 Exp. 6/30/15
 10/17/15
 107V6538
 SHEET C8 OF 10