Avoid cutting underground utility lines. It's costly.

Call before you Dig

1-800-227-2600

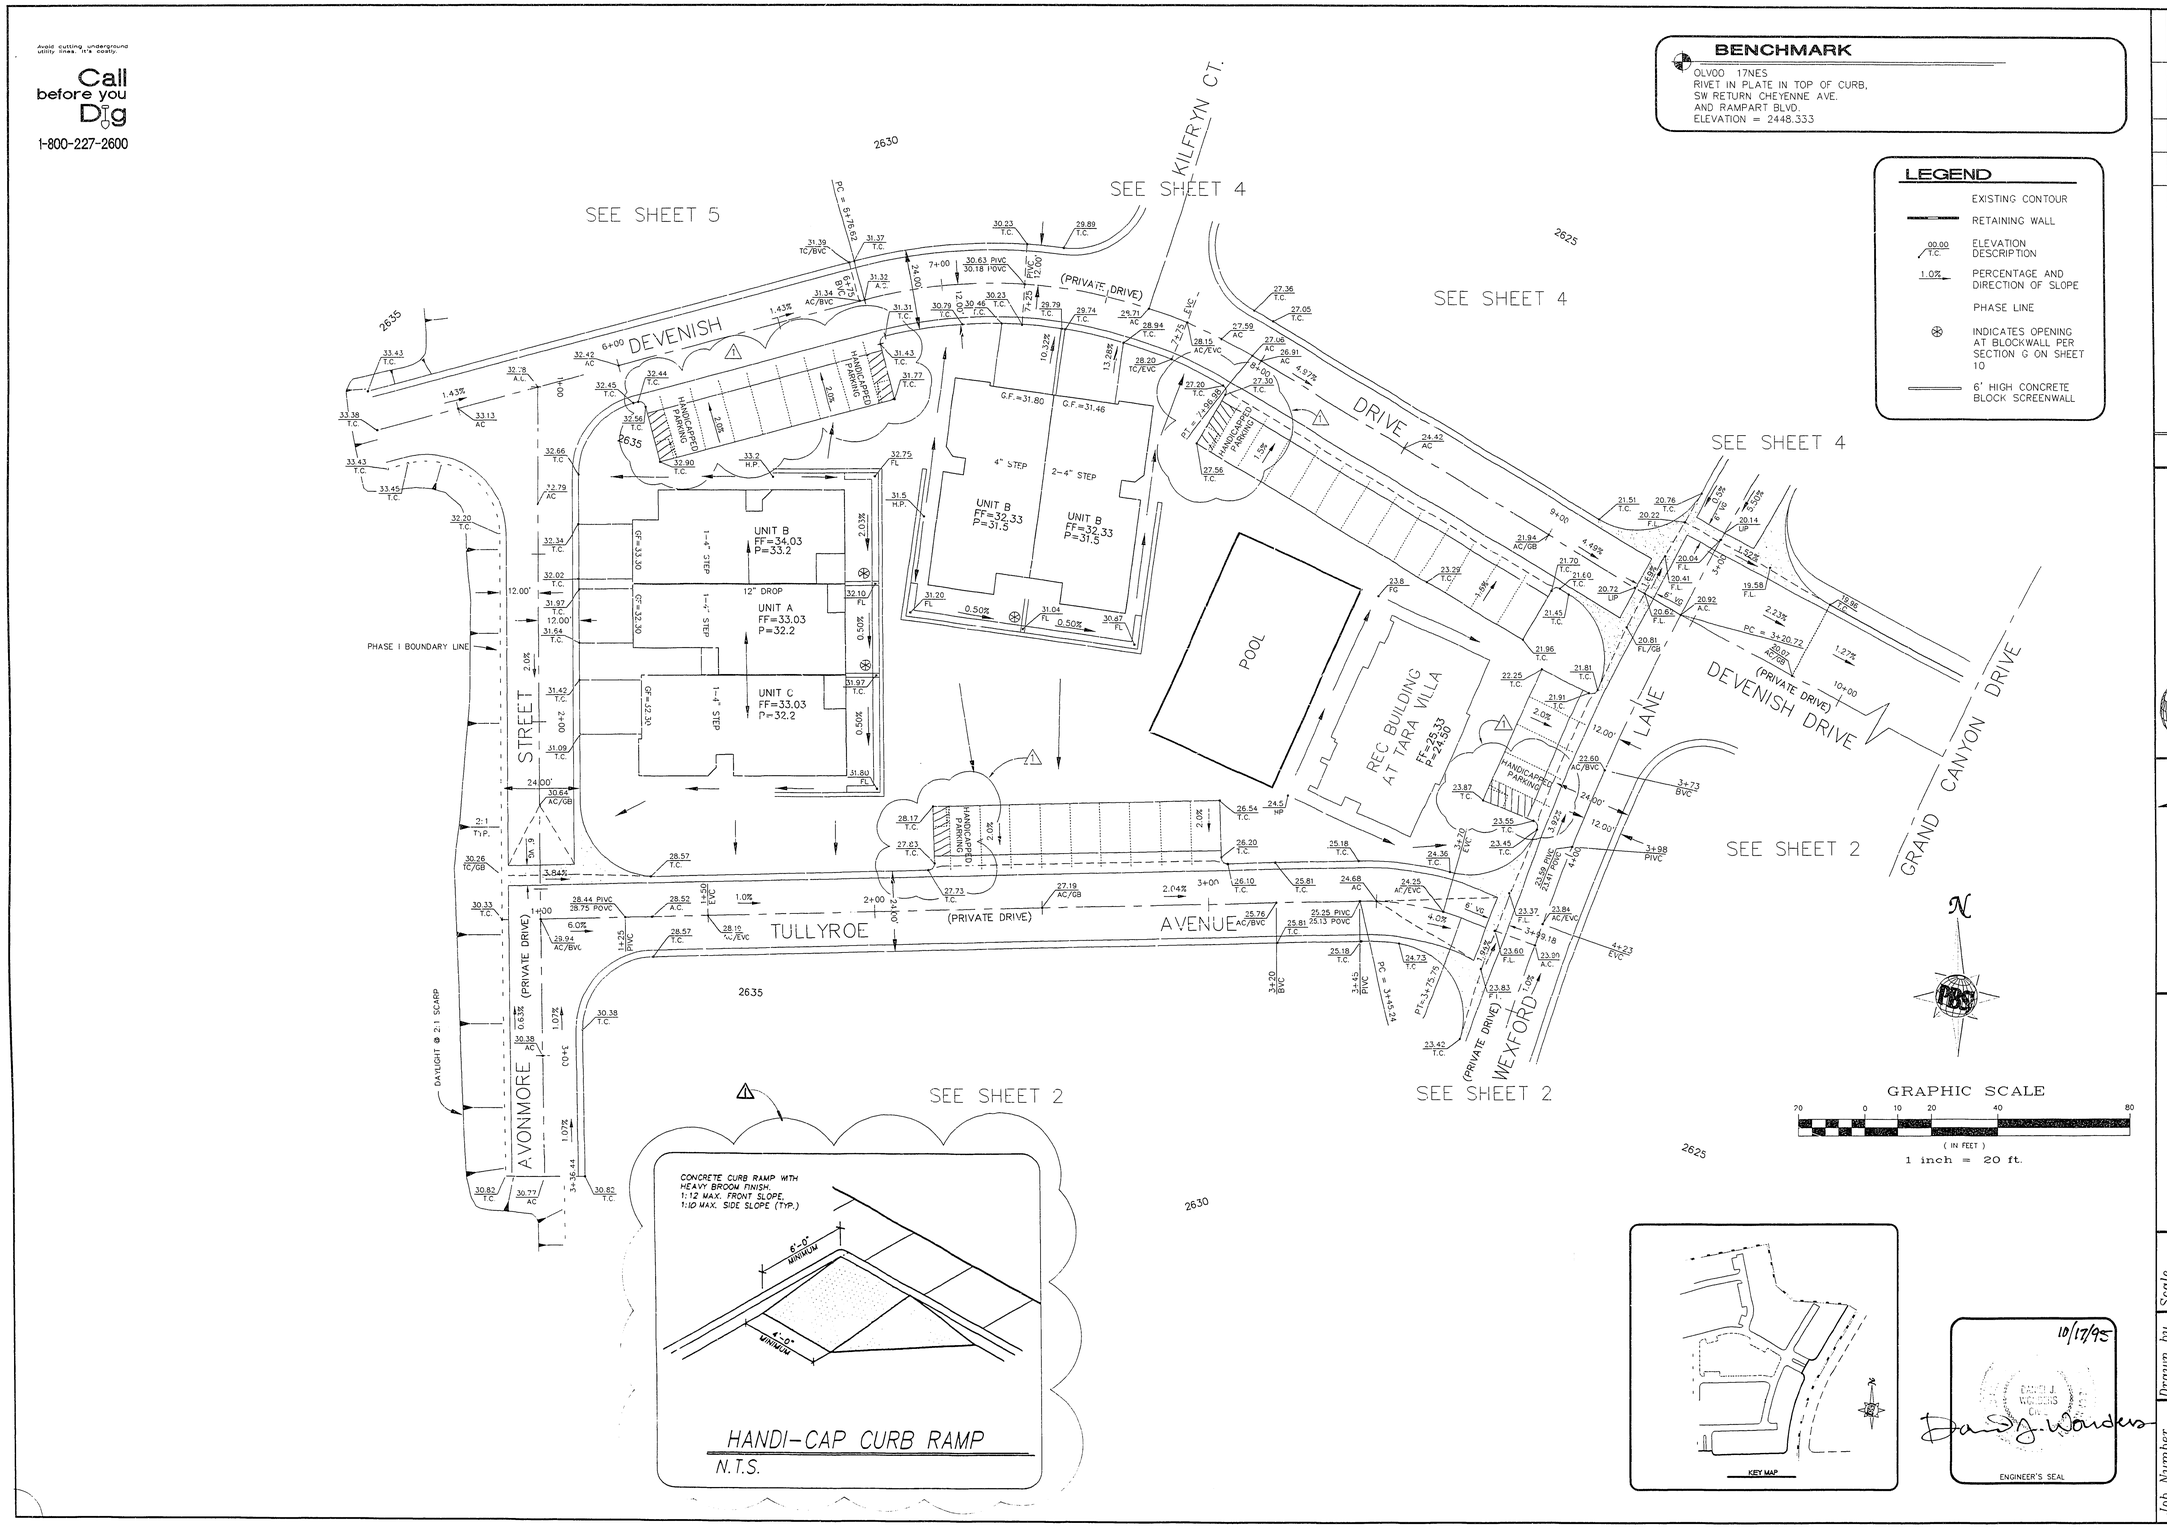

No.	REVISIONS	Date	Init.	Appr.	Date
1	REVISE H.C. PARKING AND RAMPS	10/3/95	T.L.K.	[signature]	11/10/95

POST, BUCKLEY, SCHUH & JERNIGAN
6600 West Charleston Blvd. Suite 140 Las Vegas, Nevada 89102 Telephone: 702/878-6244 Fax: 702/878-7758
ENGINEERING · PLANNING · SURVEYING · CONSTRUCTION SERVICES

CHEYENNE RIDGE CONDOMINIUMS
Falcon Development Corporation
FALCON

PHASE 1
GRADING PLAN

Job Number 7225.696	Drawn by J.T.L./JAH	Scale 1" = 20'	
Sheet Number 3 OF 14	Checked by ARZ	File No. 696IMP	
	Date OCTOBER 3, 1995		

DRAWING: 696-03 PLOT DATE: 10-03-95

11-22-58

107Y-4400-1