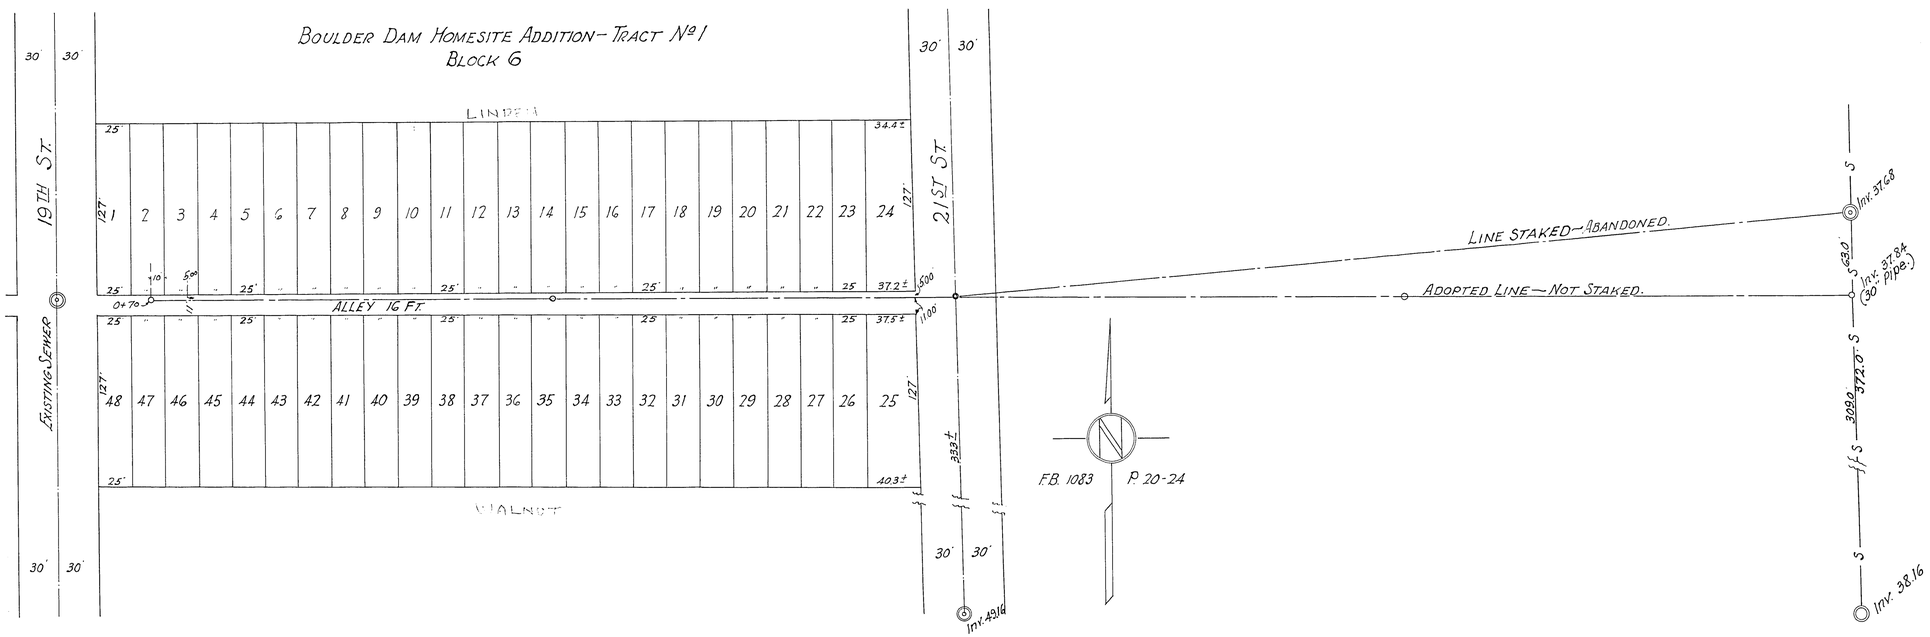

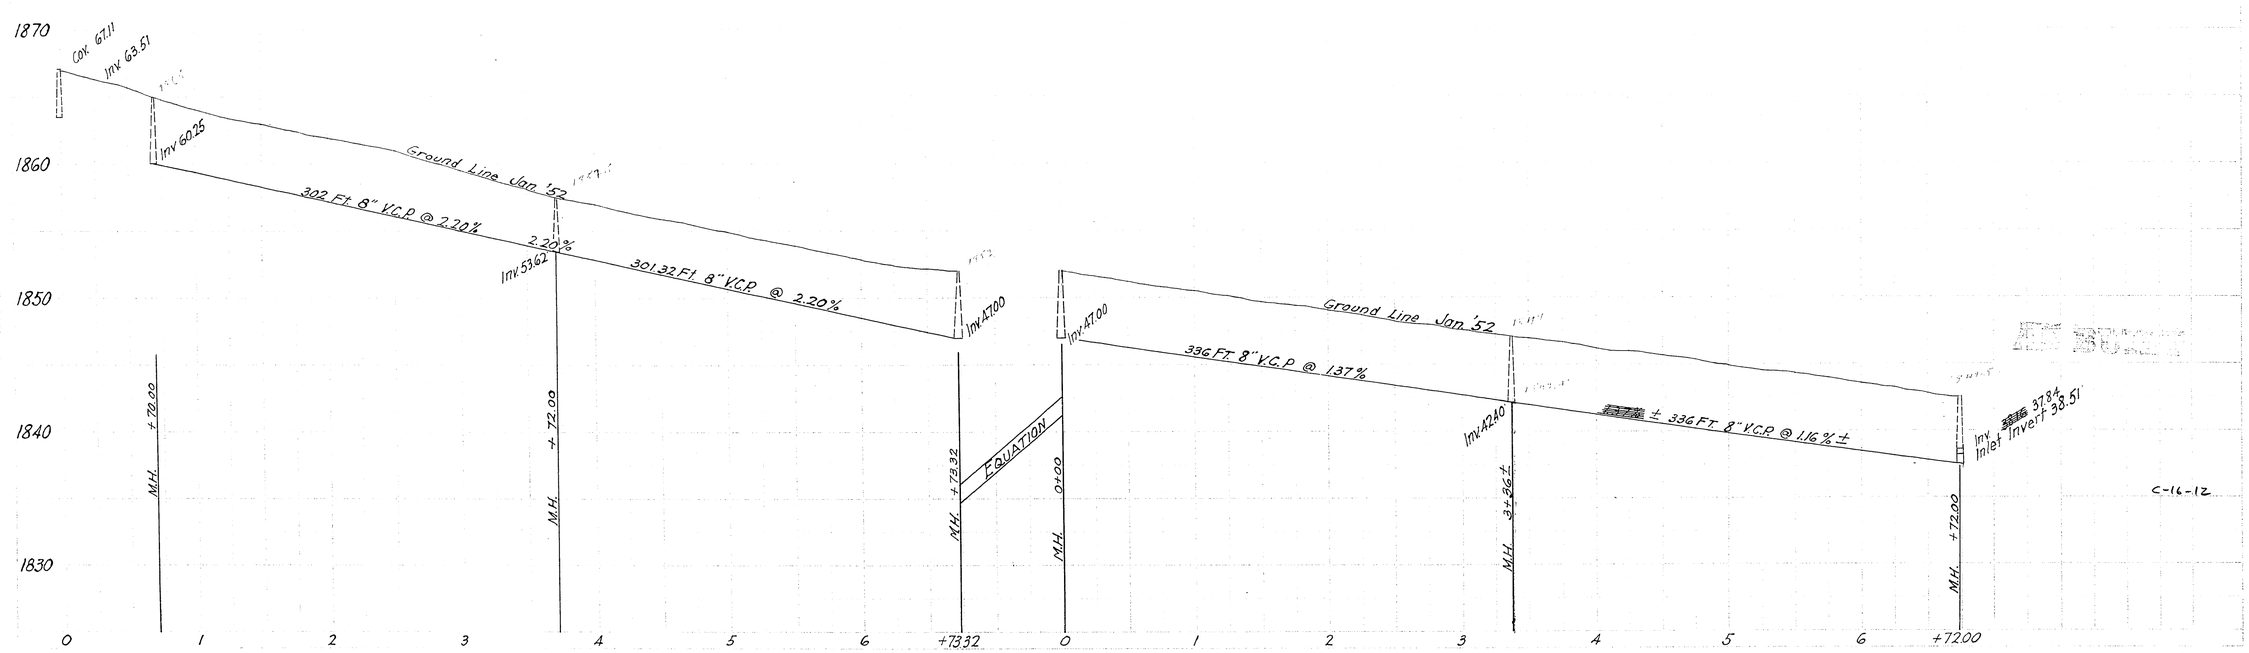

C-16-12

ALLEY BET. LINDEN & WALNUT, 19TH TO 21ST

307-W61