


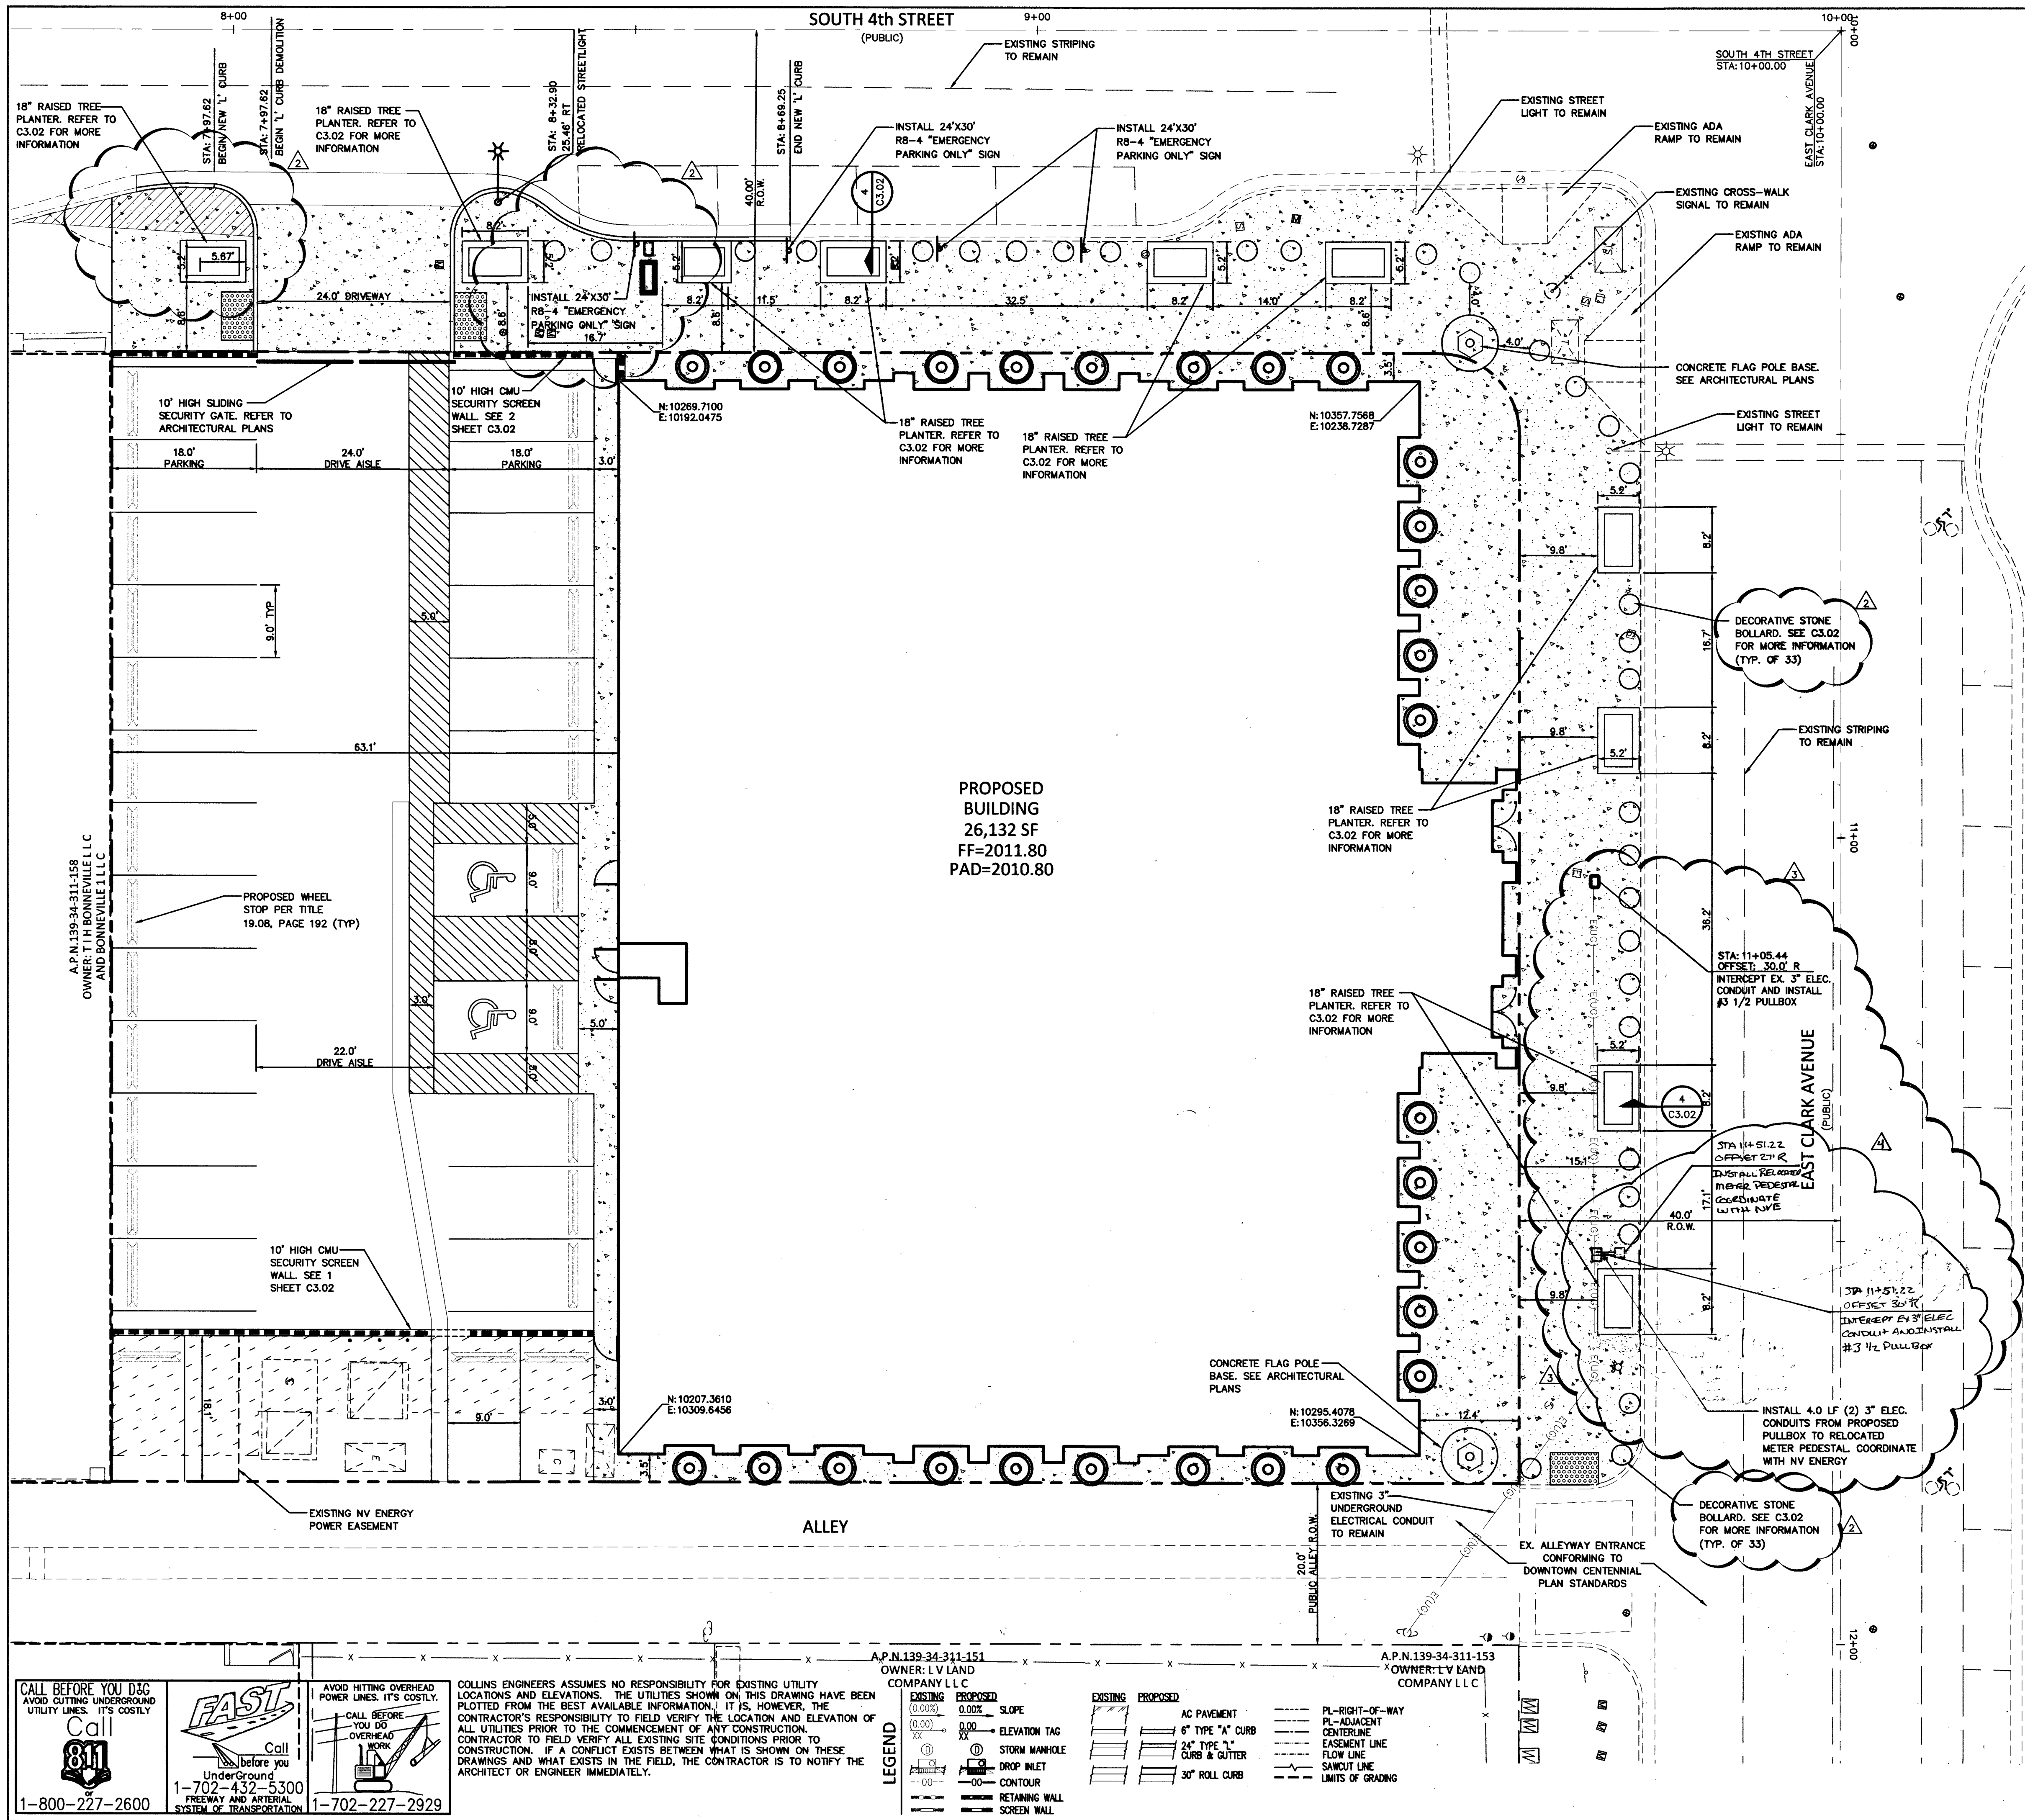

GRAPHIC SCALE
SCALE: 1"=10'

VICINITY MAP
NTS

BASIS OF BEARINGS
SOUTH 27°34'34" WEST, BEING THE CENTERLINE OF FOURTH STREET, BETWEEN BONNEVILLE AVENUE AND CLARK AVENUE, AS SHOWN IN FILE 67, PAGE 79 OF SURVEYS ON FILE AT THE CLARK COUNTY NEVADA RECORDERS OFFICE.

BENCHMARK
CITY OF LAS VEGAS BENCH MARK # 14LV013458
FOUND RIVET AND PLATE TOP CURB NW CORNER OF BONNEVILLE AND LAS VEGAS BOULEVARD.
ELEVATION - 612.205 (METERS) / 2008.54 (U.S. SURVEY FEET)
NORTH AMERICAN VERTICAL DATUM OF 1988

SIGHT VISIBILITY ZONE LEGEND

SIGHT VISIBILITY ZONE

SIGHT VISIBILITY ZONE NOTE:
NO WALLS, FENCES, TREES, SHRUBS, UTILITY APPURTENANCES OR ANY OTHER OBJECT, OTHER THAN TRAFFIC CONTROL DEVICES AND STREETLIGHT POLES, MAY BE CONSTRUCTED OR INSTALLED WITHIN THE SIGHT VISIBILITY ZONE UNLESS SAID OBJECT IS MAINTAINED AT LESS THAN 24 INCHES IN HEIGHT.

GENERAL NOTE:
IT IS THE CONTRACTOR'S RESPONSIBILITY TO FILE A NOTICE OF INTENT/REQUEST TO BE INCLUDED IN THE STORM WATER GENERAL PERMIT, AND SUBMIT THE ASSOCIATED STORM WATER POLLUTION PREVENTION PLAN (SWPPP) AS REQUIRED BY FEDERAL, AND MONITORED BY THE NEVADA DIVISION OF ENVIRONMENTAL PROTECTION.

NOTE:
PROPERTY OWNER IS RESPONSIBLE TO MAINTAIN THE BEST MANAGEMENT PRACTICES SUCH AS BUT NOT LIMITED TO THE REMOVAL OF ACCUMULATED SEDIMENT AND DEBRIS AND CARE OF THE VEGETATION.

EMERGENCY PARKING ONLY

R8-4 SIGN
24"x30"

COLLINS ENGINEERS
3130 S. DURANGO DR., SUITE 404
LAS VEGAS, NV 89117
Phone: 702-248-8000
Fax: 702-248-8070

PROFESSIONAL ENGINEER - STATE OF NEVADA
KENNETH T. YAMADA
EXP. 06-30-15
CIVIL
NO. 014664

NO.	DATE	APPROVAL	DESCRIPTION OF REVISIONS
1	10/15/15		OWNER REVISIONS
2	10/15/15		RELOCATE METER PEDESTAL

4TH & CLARK OFFICE COMPLEX
APN: 139-34-303-002
HORIZONTAL CONTROL PLAN

DATE:	10/15/15
JOB NUMBER:	9040
DESIGNED:	B. BALANIS
DRAWN:	J. SALDIVAR
CHECKED:	K. YAMADA
SHEET NUMBER	C3.01
	SHEET 4 OF 8

1-800-227-2600