
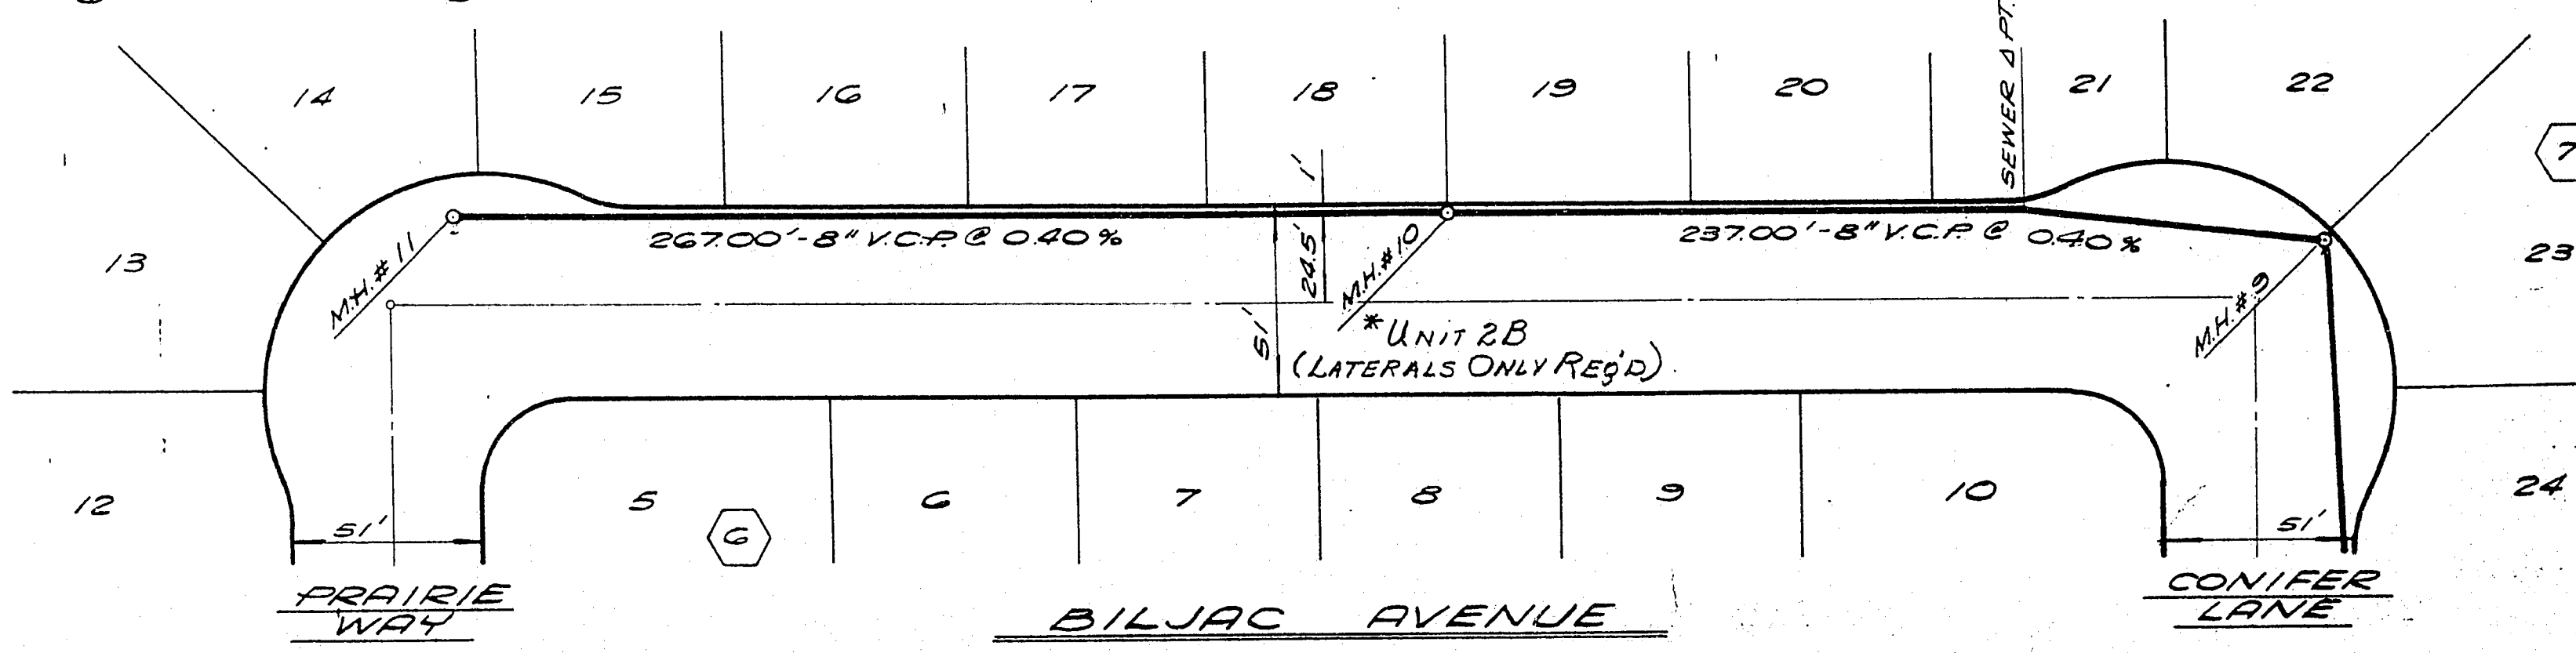


SUPERIMPOSED ON RECORD DOCUMENT:
 ALL TRUNK & MAIN LINES AND MANHOLES
 SHOWN THIS SHEET WERE CONSTRUCTED
 WITH PARCEL A.

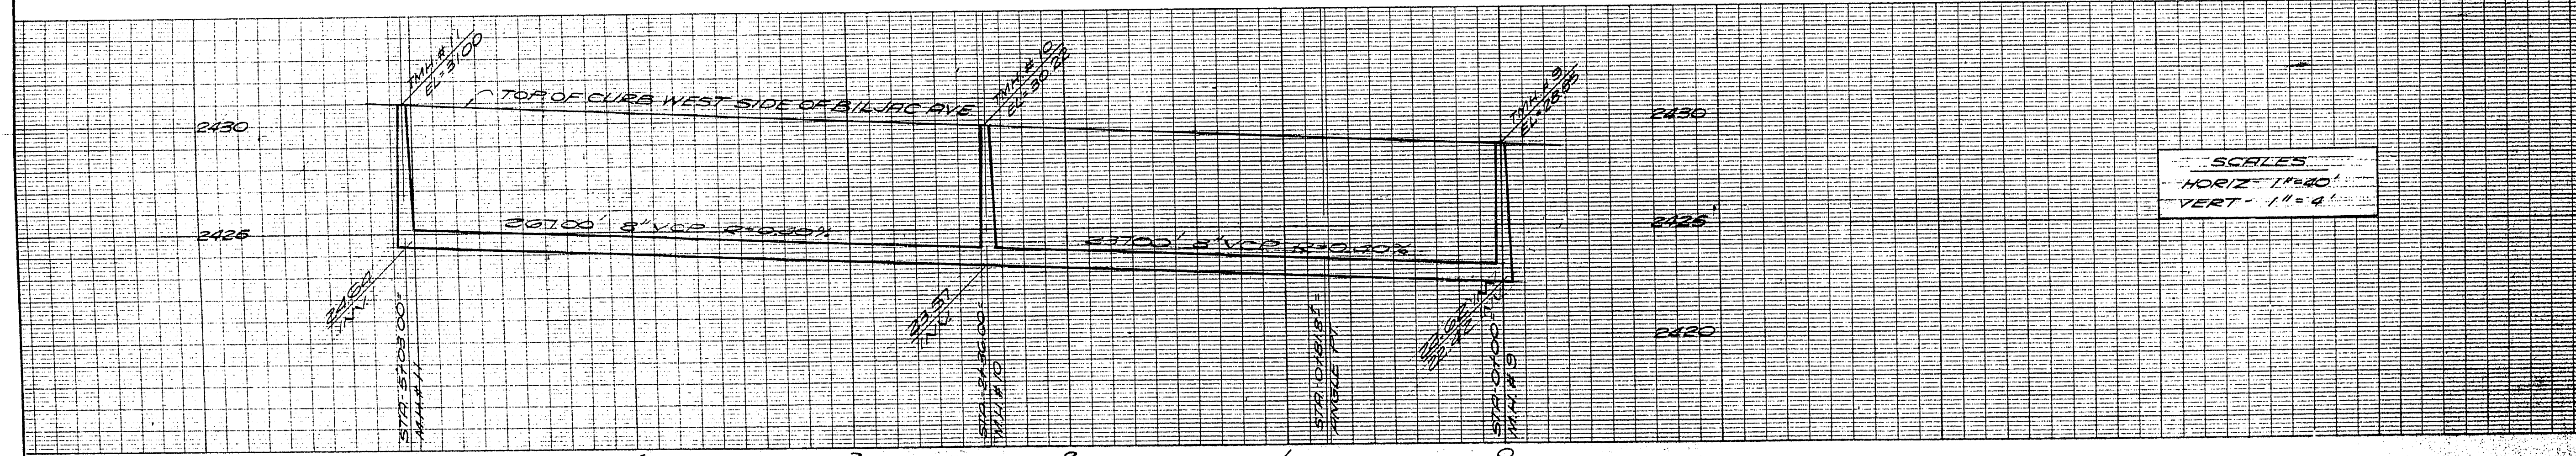

SCALES
 VERT. 1"=4'

Approvals -

[Signature]
 City Engineer

[Signature]
 Date

Sanitation Sup't.

Date

Divided into Units 2-A & 2-B 11-18-66

[Signature]
 Sanit. Sub't
 City Engr.

CHARLESTON RAINBOW
 UNIT NO. 2
 SEWER PLAN & PROFILES
 CONIFER AVENUE &
 BILJAC AVENUE