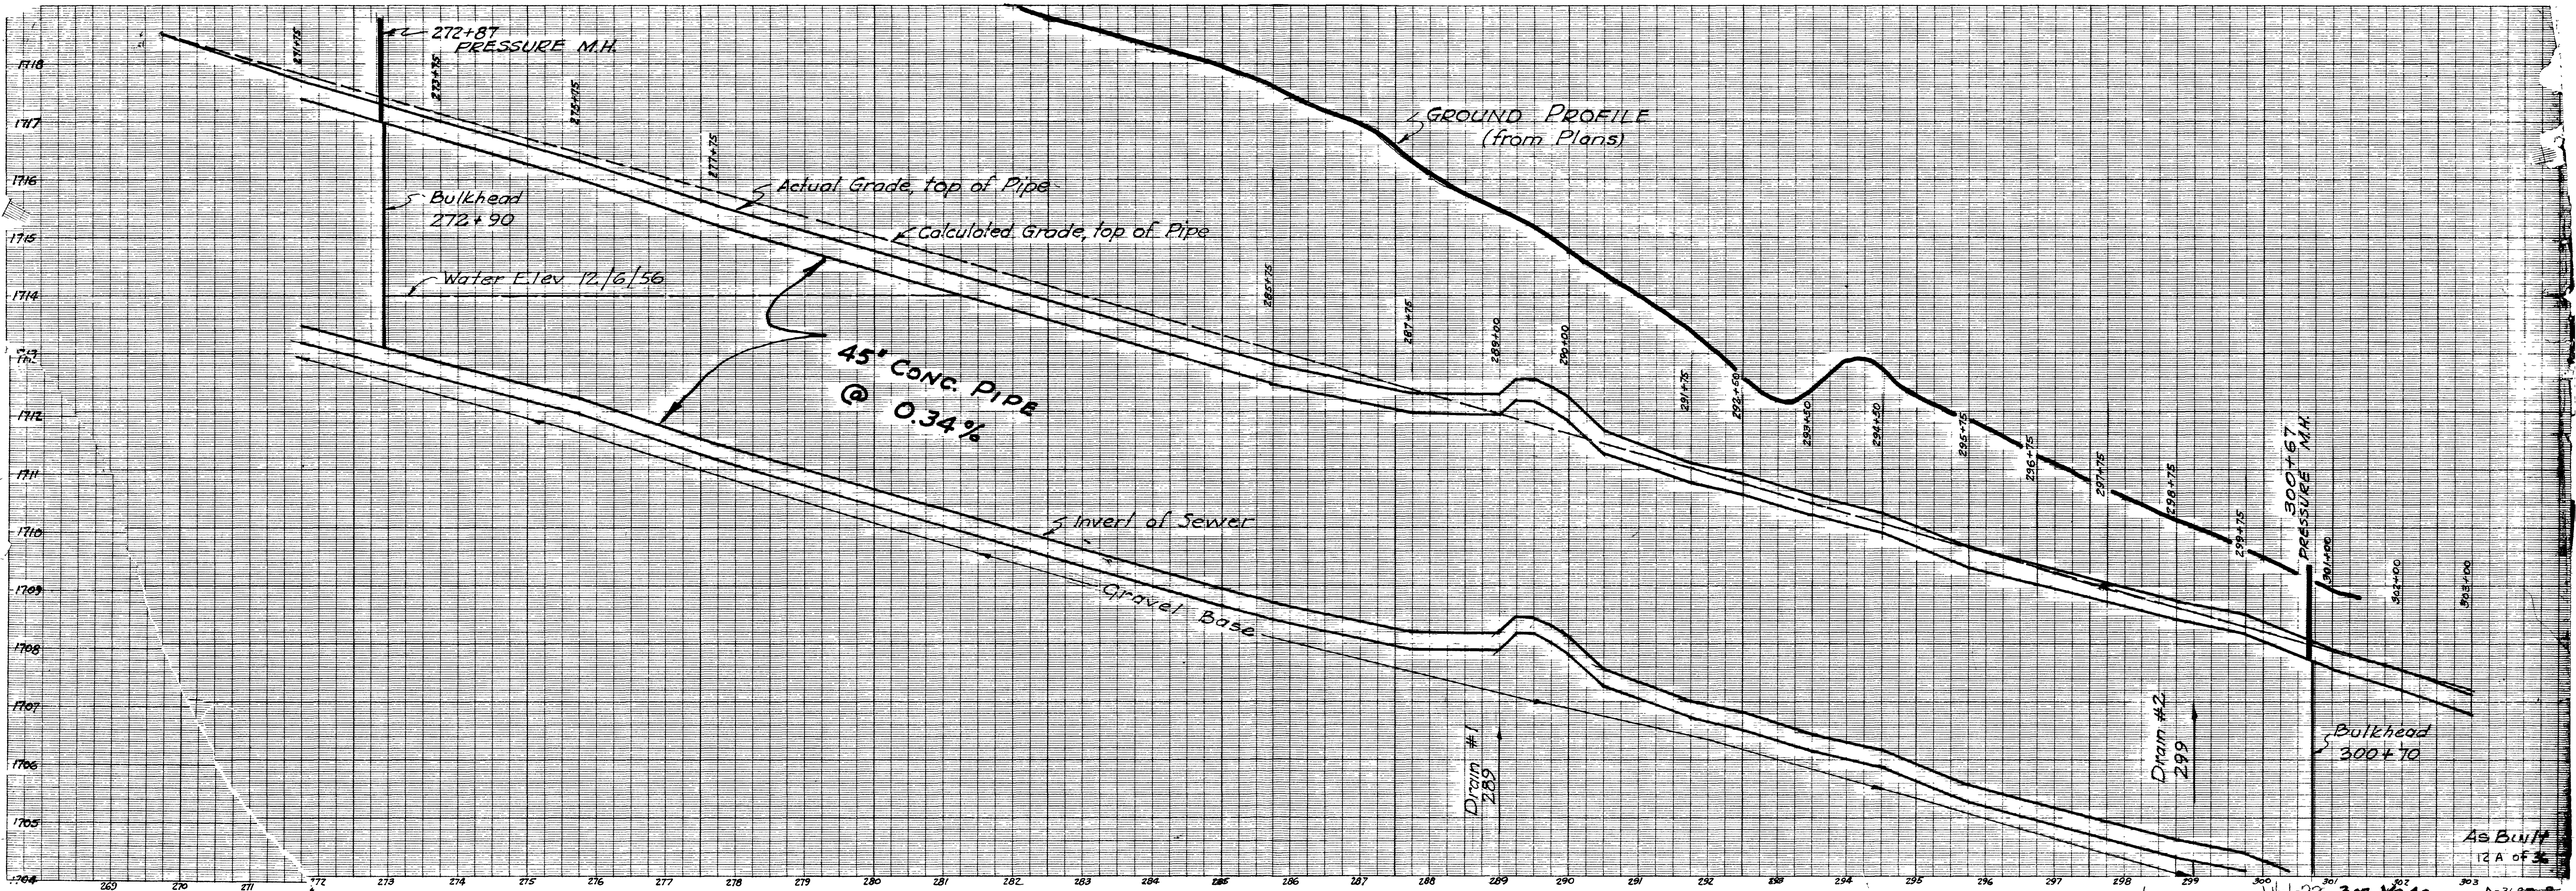

As Built
12 A of 3

4-1-38 307-1242 A-3685-B