
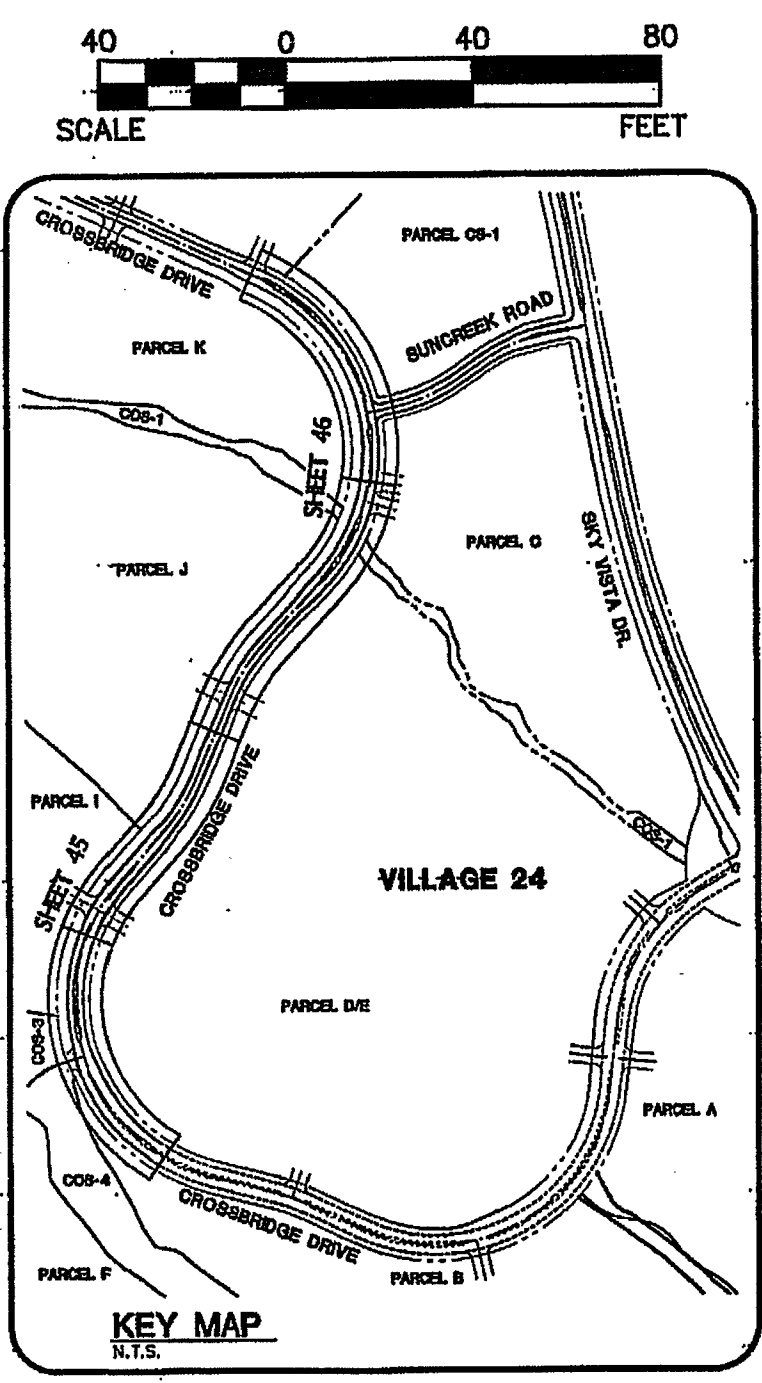


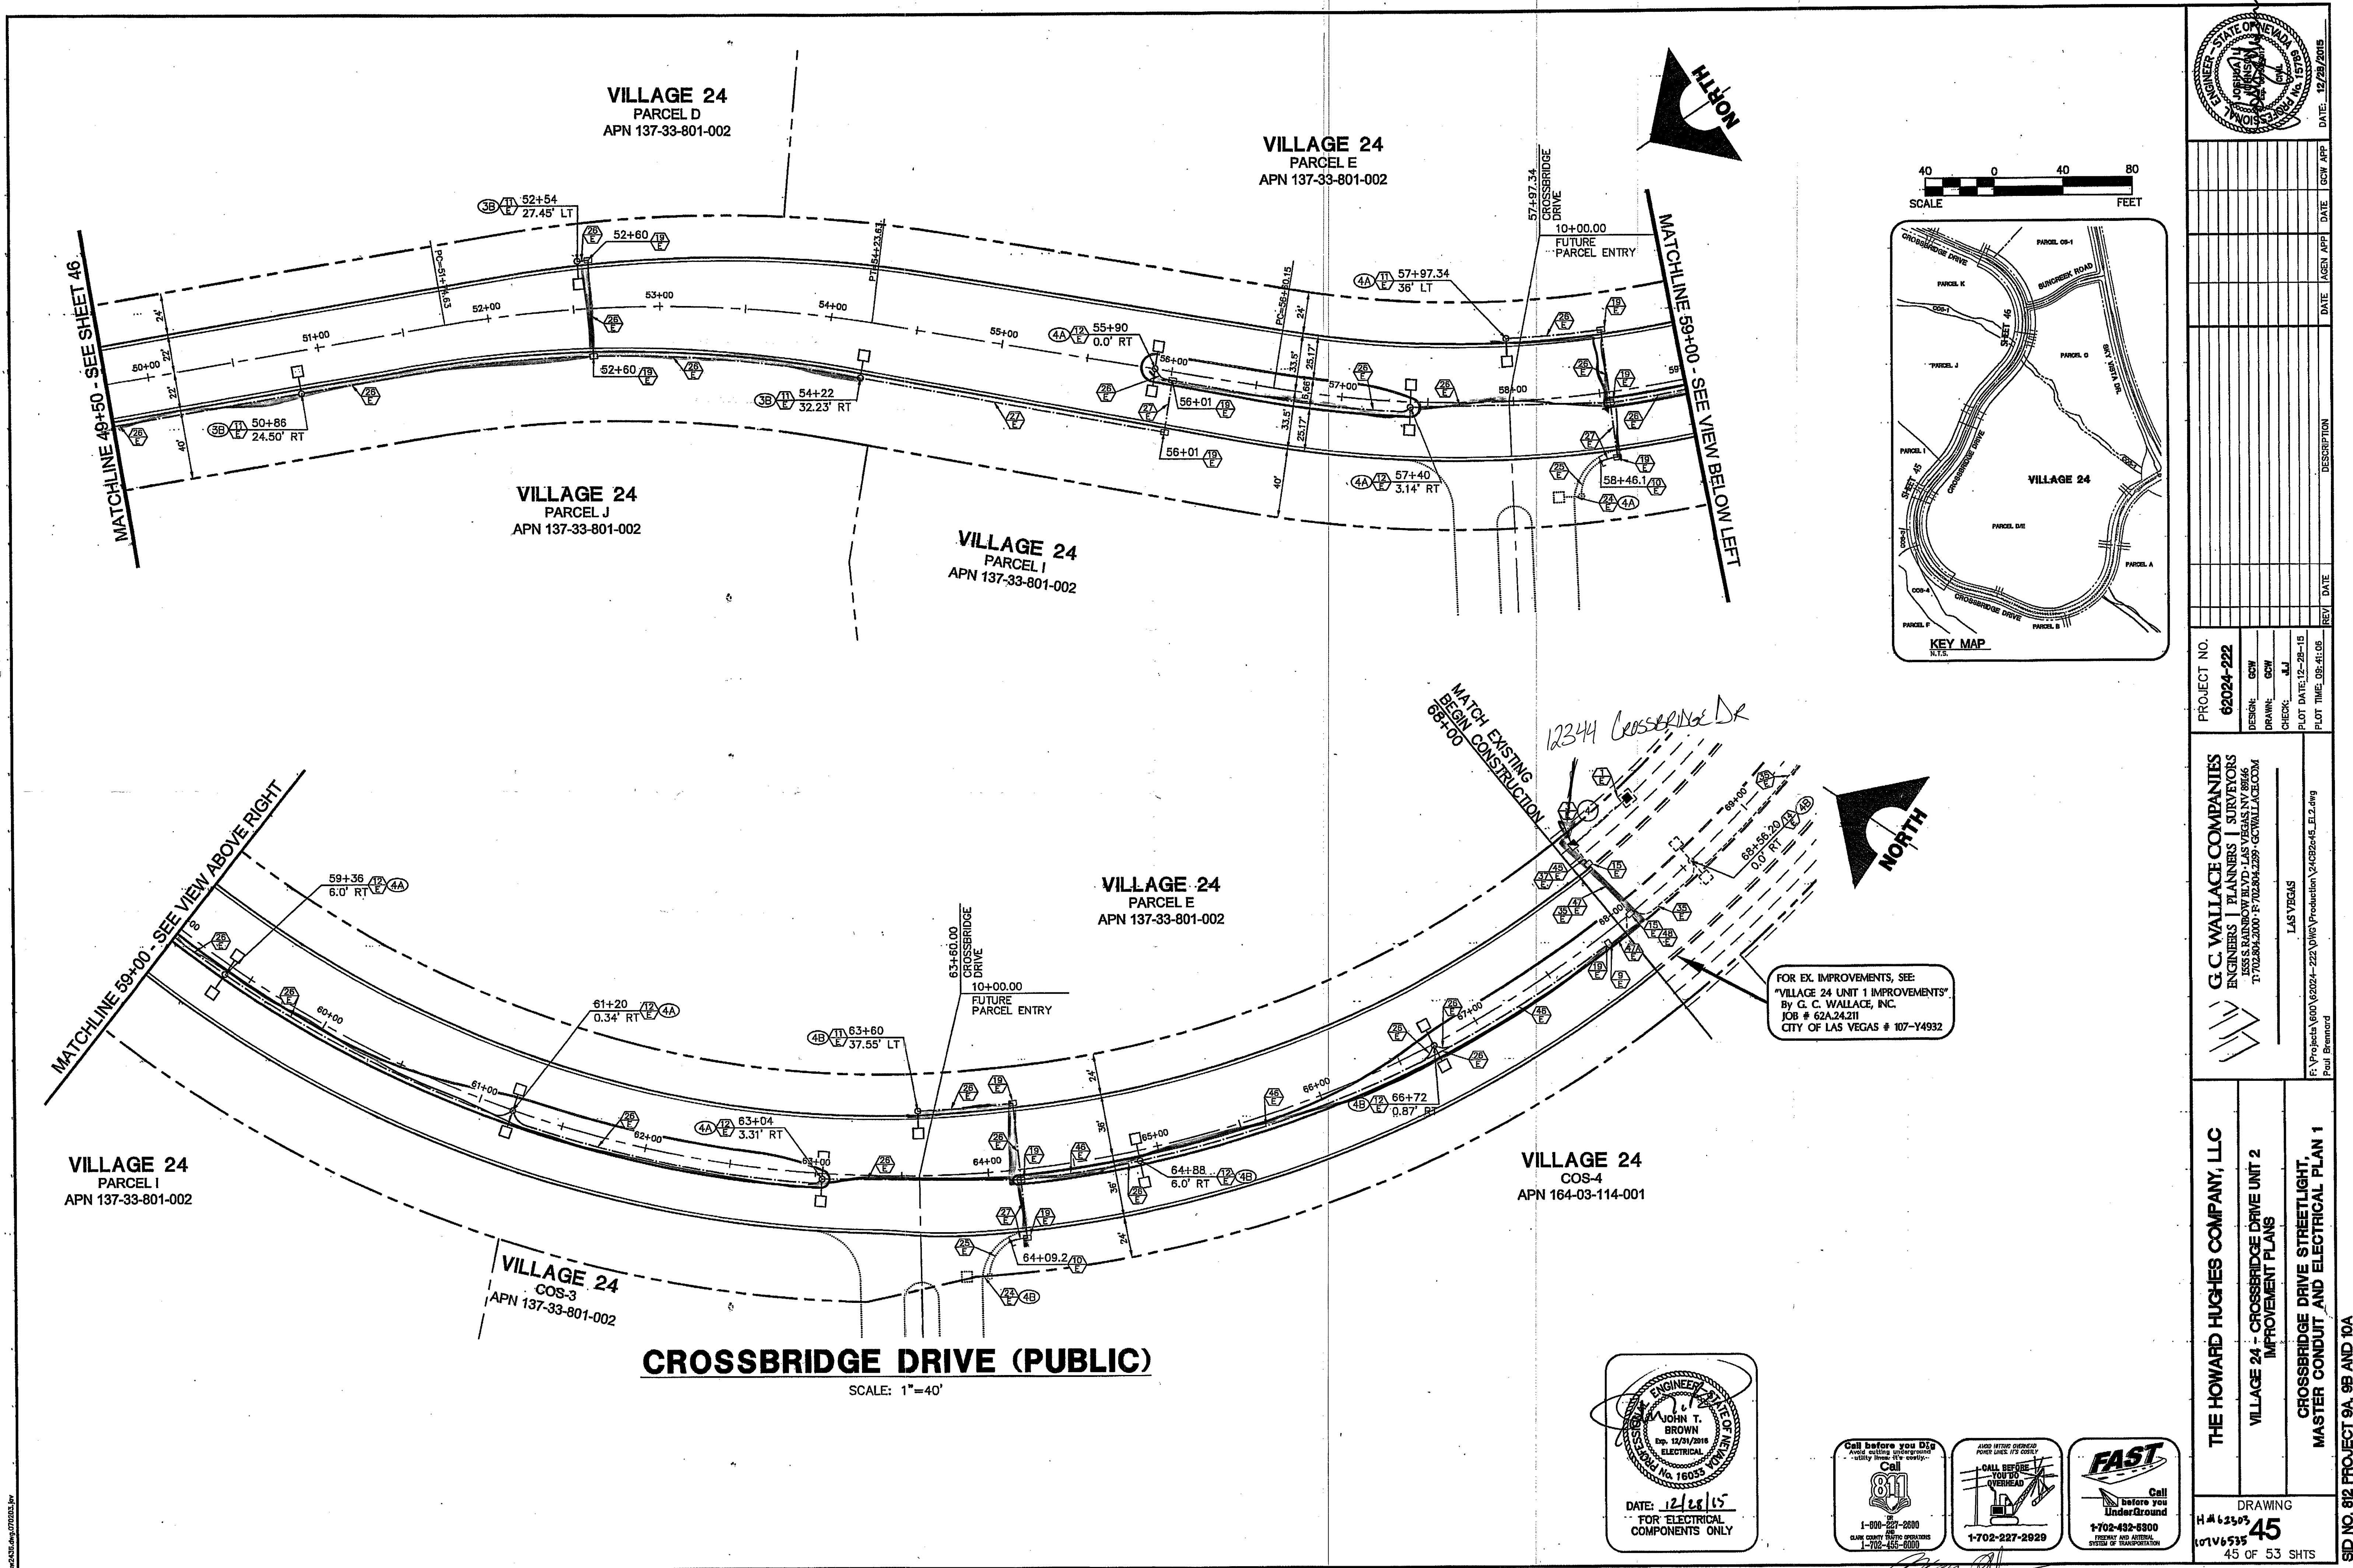

DATE: 12/18/15
FOR ELECTRICAL COMPONENTS ONLY

Call before you Dig

Call before you Dig
1-702-227-2929

FAST
Call before you Dig
1-702-432-6300
SYSTEMS OF TRANSPORTATION

PROJECT NO.	DESIGN	DRAWN	CHECK	DATE	REVISION
62024-222	GCW	GCW	GCW	12-28-15	
PLOT TIME: 08-41:06					

G.C. WALLACE COMPANIES
ENGINEERS | PLANNERS | SURVEYORS
1555 S. RAINBOW BLVD. • LAS VEGAS, NV 89146
T: 702.804.2000 • F: 702.804.2299 • GOWALLACE.COM

THE HOWARD HUGHES COMPANY, LLC
VILLAGE 24 - CROSSBRIDGE DRIVE UNIT 2
IMPROVEMENT PLANS
CROSSBRIDGE DRIVE STREETLIGHT,
MASTER CONDUIT AND ELECTRICAL PLAN 1

DRAWING
H.A. 62303
45
45 OF 53 SHTS

SID NO. 812 PROJECT 9A, 9B AND 10A

AS-BUILT PAUL BRENNARD 702.257.7475 06-15-17