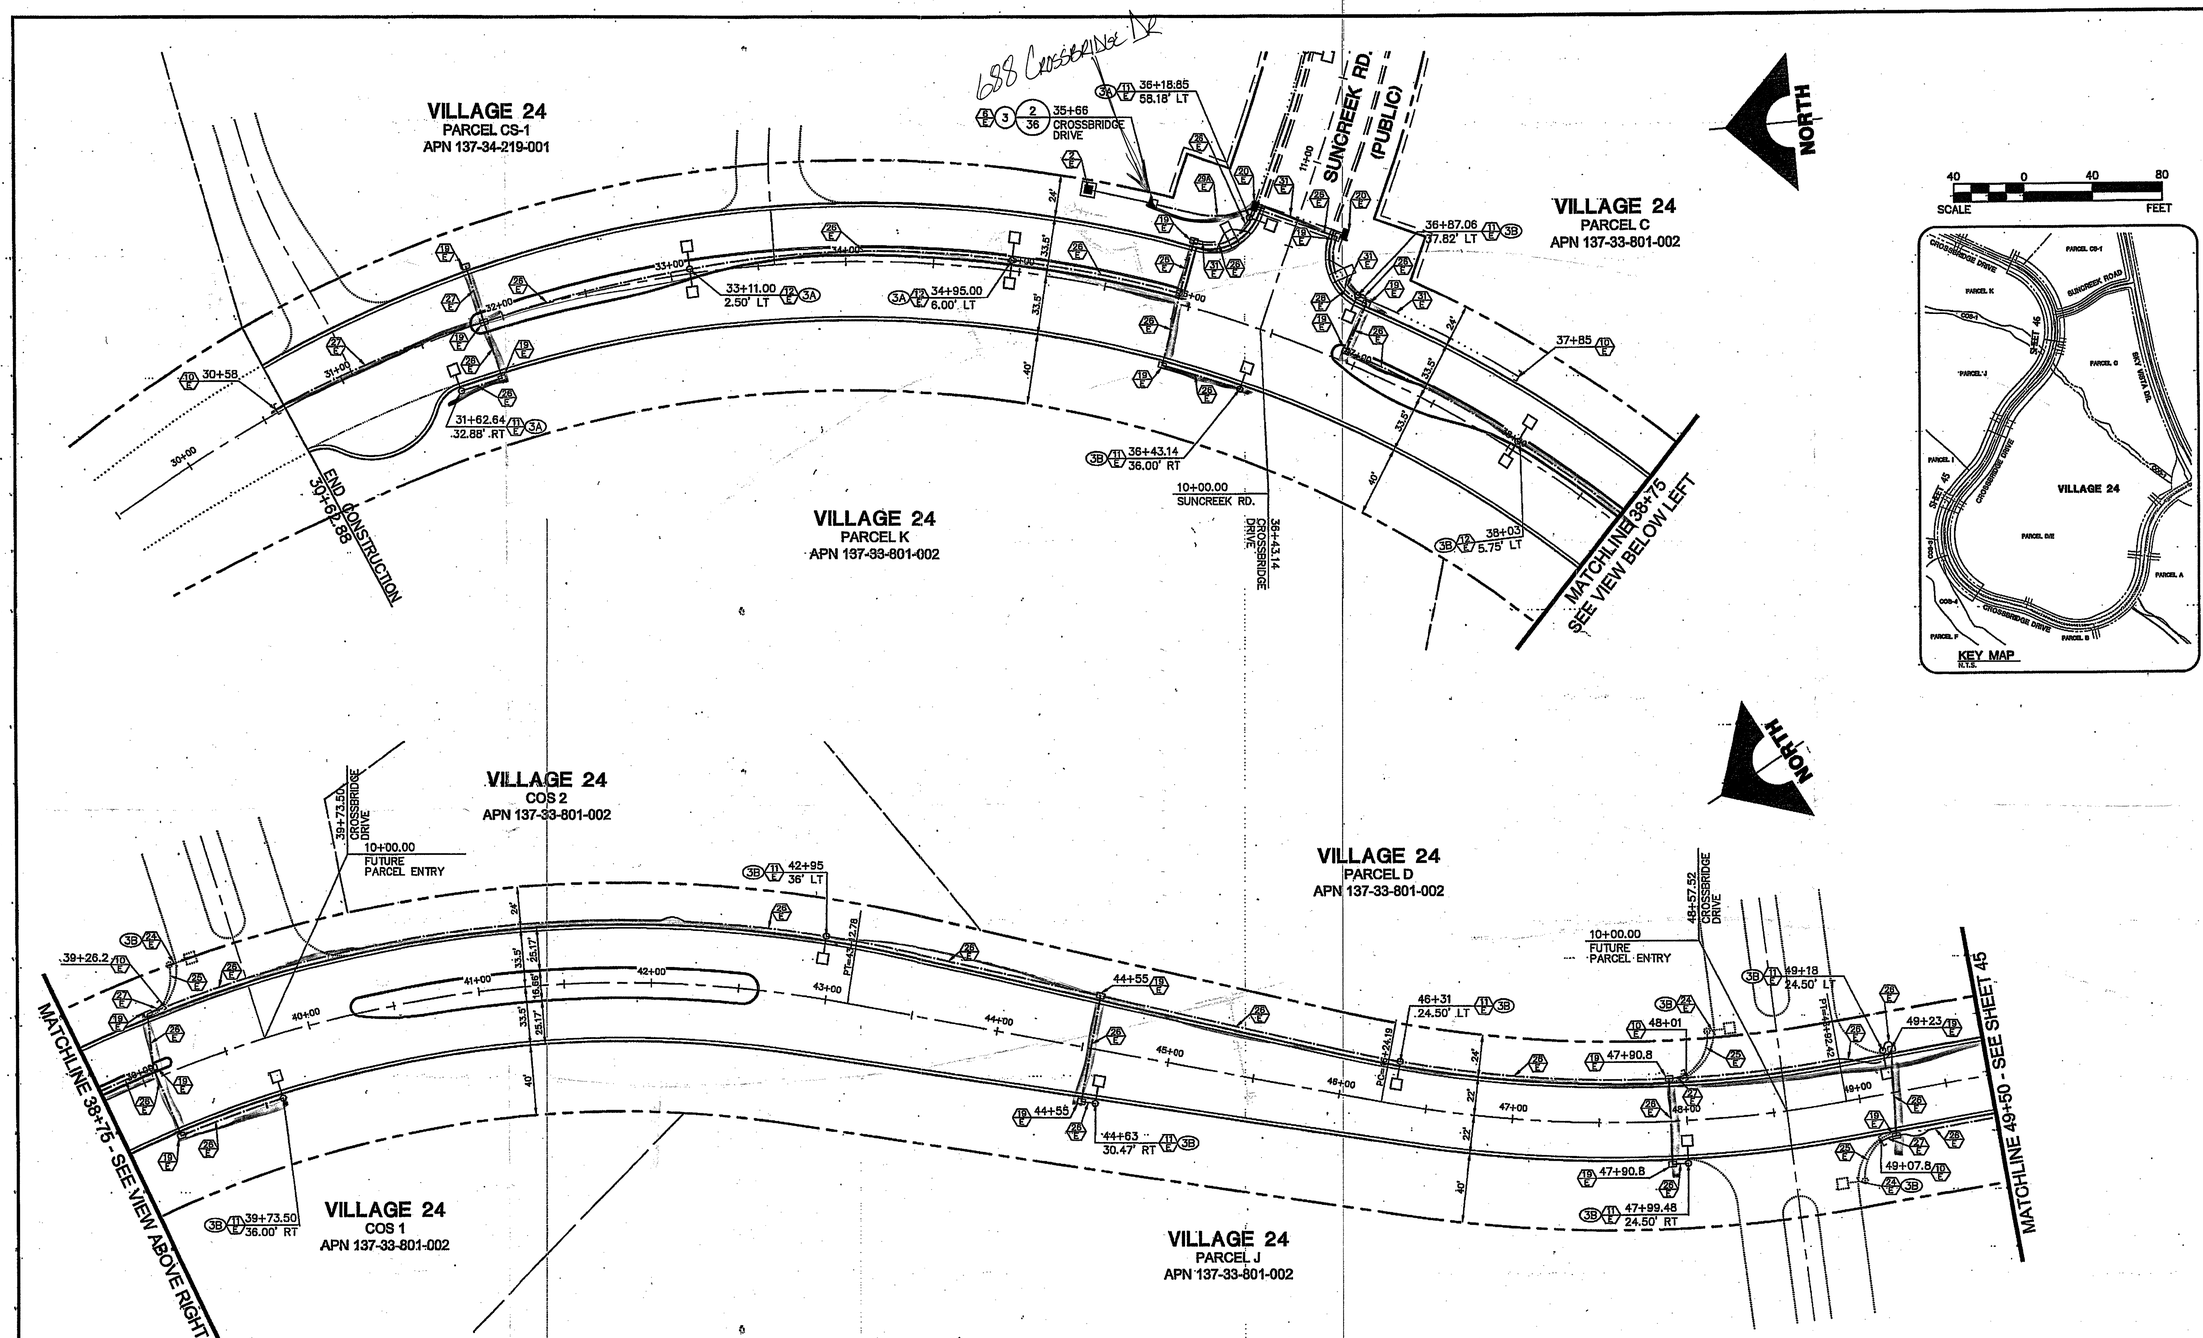

CROSSBRIDGE DRIVE (PUBLIC)

SCALE: 1"=40'

ENGINEER - STATE OF NEVADA
JOHN T. BROWN
Exp. 12/31/2016
ELECTRICAL
No. 16033
DATE: 12/28/15
FOR ELECTRICAL COMPONENTS ONLY

Call before you Dig
Avoid cutting underground utility lines. It's costly.
Call 811
1-800-227-2600
CLARK COUNTY BUYER DEPARTMENT 1-702-455-6000

AVOID HITTING OVERHEAD POWER LINES. IT'S COSTLY
CALL BEFORE YOU DO OVERHEAD
1-702-227-2929

FAST
Call before you UnderGround
1-702-432-5300
FREEWAY AND ARTERIAL SYSTEM OF TRANSPORTATION

ENGINEER - STATE OF NEVADA
JOHN T. BROWN
No. 15713
DATE: 12/28/2015

REV	DATE	DESCRIPTION	DATE	AGEN APP	DATE	GCW APP

PROJECT NO. 62024-222
DESIGN: GCW
DRAWN: GCW
CHECK: JJJ
PLOT DATE: 12-28-15
PLOT TIME: 09:42:35

G.C. WALLACE COMPANIES
ENGINEERS | PLANNERS | SURVEYORS
3555 S. RAINBOW BLVD - LAS VEGAS, NV 89146
T: 702.804.2000 - F: 702.804.2299 - GCWALLACE.COM
LAS VEGAS
F:\Projects\600\62024-222\DWG\Production\24232-46_EL3.dwg
Paul Brennord

THE HOWARD HUGHES COMPANY, LLC

VILLAGE 24 - CROSSBRIDGE DRIVE UNIT 2 IMPROVEMENT PLANS

CROSSBRIDGE DRIVE STREETLIGHT, MASTER CONDUIT AND ELECTRICAL PLAN 2

SID NO. 812 PROJECT 9A, 9B AND 10A

DRAWING 46
46 OF 53 SHTS

AS-BUILT PALMER ELECTRIC 702 257 7475 06-15-17