


SCALE: 1" = 40'  
 FILE: B263C-SUBG PP C205 XR 263C SITE PLAN - 5,263.PLOT

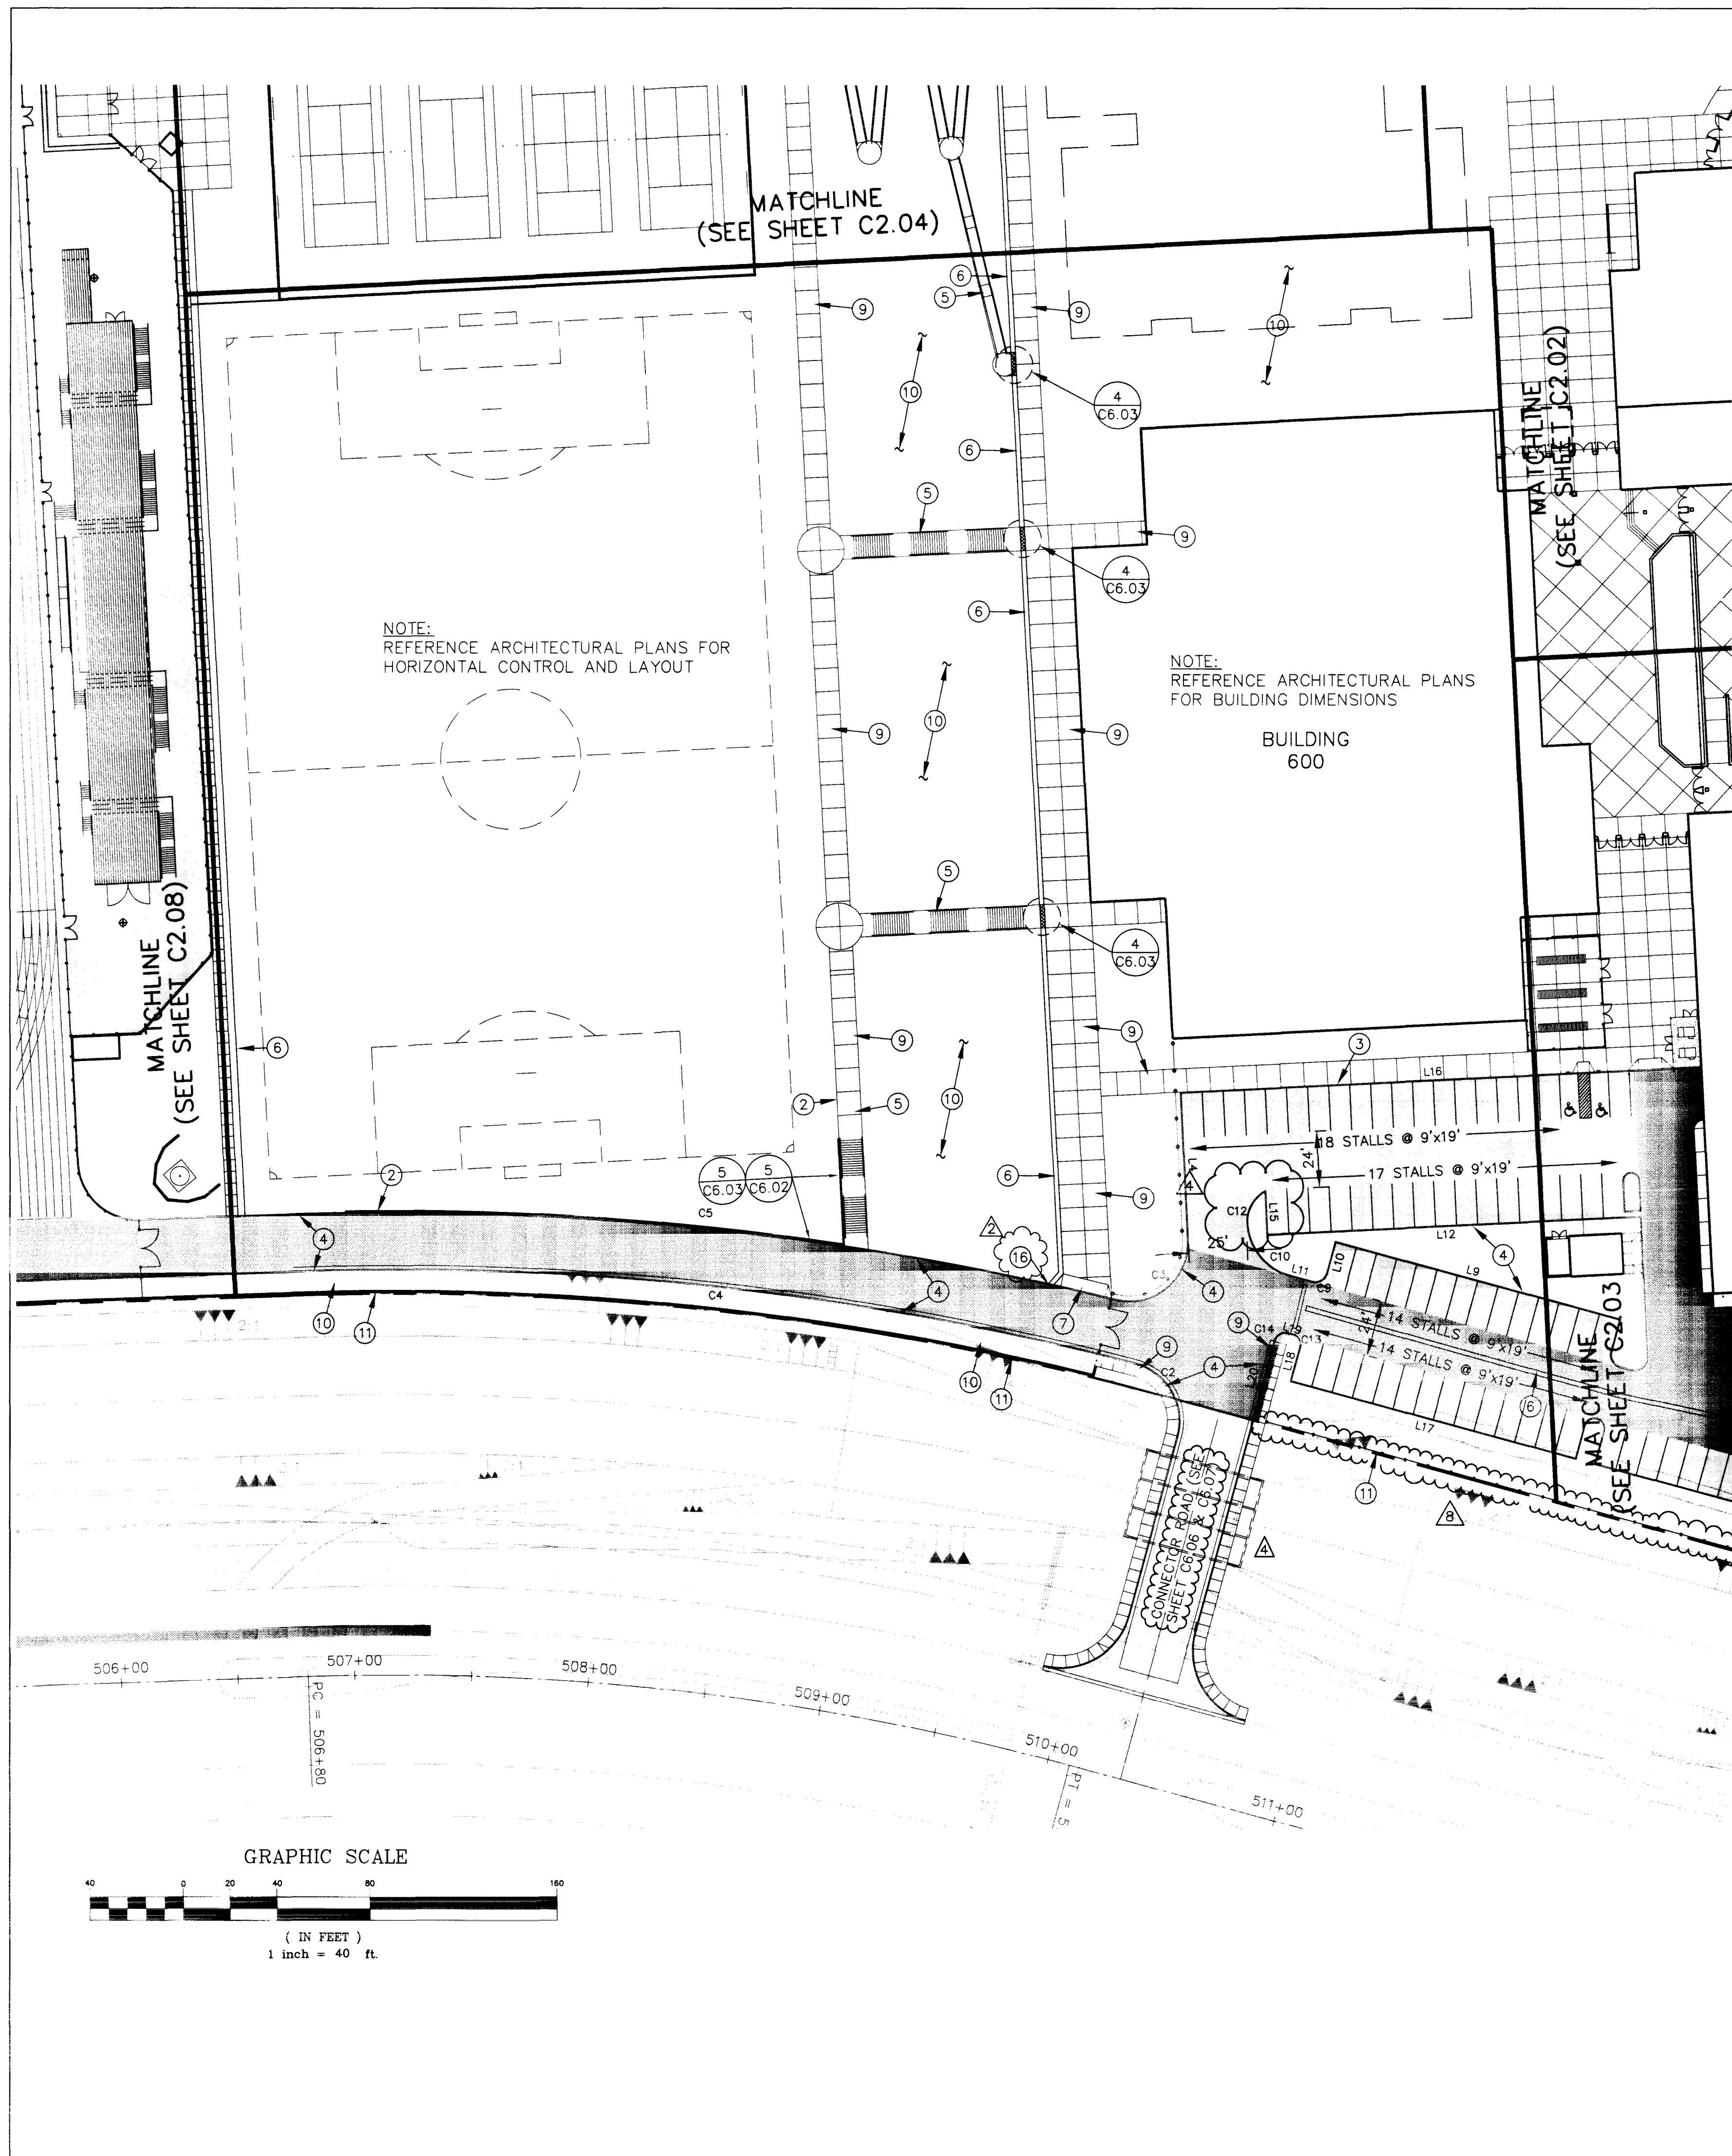

**BACK OF CURB CURVE TABLE**


CURVE	RADIUS	LENGTH	TANGENT	DELTA
C1	25.00'	38.82'	24.58'	88°58'00"
C2	25.00'	39.61'	25.35'	90°47'26"
C3	4.00'	44.48'	31.50'	106°31'55"
C4	1245.75'	362.53'	182.56'	16°40'26"
C5	1298.00'	355.45'	178.84'	15°41'24"
C6	5.00'	7.85'	5.00'	90°00'00"
C7	5.00'	9.40'	5.88'	107°45'54"
C8	3.08'	9.67'	<infinite>	180°00'00"
C9	5.00'	7.85'	5.00'	90°00'00"
C10	24.50'	32.71'	19.31'	76°29'04"
C11	4.00'	4.00'	4.00'	90°00'00"
C12	15.00'	13.69'	7.36'	52°17'33"
C13	4.00'	6.28'	4.00'	90°00'00"
C14	4.00'	6.28'	4.00'	90°00'00"
C15	4.00'	12.57'	<infinite>	180°00'00"
C16	4.00'	12.57'	<infinite>	180°00'00"
C17	5.00'	6.27'	3.62'	71°49'00"
C18	5.00'	7.85'	5.00'	90°00'00"
C19	1375.00'	103.28'	51.66'	04°18'13"
C20	5.00'	7.84'	4.98'	89°49'00"
C21	1416.00'	26.00'	16.00'	09°48'35"
C22	20.00'	33.80'	22.54'	96°50'29"
C23	19.50'	28.31'	17.31'	83°10'37"
C24	1416.00'	26.00'	16.00'	09°48'35"
C25	20.00'	30.05'	18.88'	86°05'17"
C26	19.50'	31.87'	20.88'	83°36'02"
C27	4.00'	6.26'	3.98'	89°40'18"
C28	4.50'	8.55'	6.29'	108°49'08"
C29	5.00'	7.85'	5.00'	90°00'00"
C30	4.50'	12.72'	28.41'	182°00'00"
C31	3.50'	5.50'	3.50'	89°59'58"
C32	3.50'	5.50'	3.50'	90°00'02"
C33	5.00'	7.86'	5.00'	90°00'54"
C34	3.50'	5.50'	3.50'	90°00'02"
C35	3.50'	5.50'	3.50'	89°59'58"
C36	5.00'	7.85'	5.00'	89°59'06"
C37	5.00'	6.31'	3.63'	72°21'22"
C38	22.31'	25.02'	14.01'	64°15'27"
C39	5.00'	7.85'	5.00'	90°00'00"
C40	1338.00'	501.28'	253.61'	21°27'56"
C41	1375.00'	33.80'	22.54'	96°50'29"
C42	25.00'	48.30'	36.17'	110°41'45"
C43	1416.00'	26.00'	16.00'	09°48'35"
C44	1416.00'	26.00'	16.00'	09°48'35"
C45	20.00'	25.92'	14.68'	72°12'48"
C46	19.50'	36.58'	26.55'	107°28'51"
C47	5.00'	8.18'	5.34'	93°46'55"
C48	508.83'	37.88'	23.68'	04°11'53"
C49	5.00'	5.53'	3.09'	63°22'39"
C50	25.50'	3.32'	1.66'	07°27'58"
C51	25.00'	39.27'	25.00'	90°00'00"
C52	5.00'	7.85'	5.00'	90°00'00"
C53	5.00'	7.85'	5.00'	90°00'00"
C54	5.00'	8.51'	5.70'	97°27'58"
C55	1376.50'	119.14'	59.61'	04°57'32"
C56	5.00'	7.84'	4.79'	87°34'24"
C57	11.50'	18.42'	11.86'	91°45'48"
C58	15.00'	10.55'	5.50'	40°16'50"
C59	50.50'	136.83'	230.06'	155°14'19"
C60	5.00'	4.50'	2.41'	51°31'35"
C61	3.50'	4.50'	3.50'	90°00'00"
C62	25.00'	31.58'	18.29'	72°22'57"

**BACK OF CURB LINE TABLE**

LINE	DIRECTION	DISTANCE
L1	N88°01'31"E	65.79'
L2	N88°01'31"E	124.48'
L3	N03°00'00"W	26.50'
L4	N02°49'00"W	82.91'
L5	N15°11'00"E	14.50'
L6	N74°49'00"W	4.98'
L7	N02°34'58"W	75.99'
L8	N02°49'00"W	15.78'
L9	N74°49'00"W	127.00'
L10	N15°11'00"E	14.00'
L11	N74°49'00"W	9.58'
L12	N87°11'00"E	153.97'
L13	N02°49'00"W	9.46'
L14	N02°49'00"W	18.62'
L15	N02°49'00"W	18.62'
L16	N87°11'00"E	23.36'
L17	N74°49'00"W	127.00'
L18	N15°11'00"E	15.00'
L19	N74°49'00"W	5.00'
L20	N15°11'00"E	35.00'
L21	N74°49'00"W	145.00'
L22	N15°11'00"E	15.00'
L23	N15°11'00"E	15.00'
L24	N74°49'00"W	145.00'
L25	N15°11'00"E	15.00'
L26	N15°11'00"E	15.00'
L27	N03°00'00"W	16.58'
L28	N74°49'00"W	1.69'
L29	N15°11'00"E	14.00'
L30	N87°00'00"E	234.00'
L31	N87°00'00"E	25.90'
L32	N02°49'00"W	14.03'
L33	N87°11'00"E	4.50'
L34	N02°49'00"W	69.78'
L35	N74°55'10"W	87.04'
L36	N03°44'18"W	12.33'
L37	N87°04'50"E	54.03'
L38	N02°43'06"W	14.00'
L39	N87°04'50"E	28.12'
L40	N87°00'00"E	178.82'
L41	N02°59'58"W	15.00'
L42	N87°00'00"E	1.79'
L43	N02°59'58"W	15.00'
L44	N86°59'06"E	8.22'
L45	N03°00'00"W	15.78'
L46	N02°59'58"W	15.00'
L47	N86°46'06"E	1.05'
L48	N02°59'58"W	15.00'
L49	N86°59'06"E	8.23'
L50	N03°00'00"W	19.26'
L51	N87°00'00"E	182.00'
L52	N48°00'00"W	11.63'
L53	N03°00'59"W	14.00'
L54	N87°12'21"E	7.29'
L55	N65°32'36"E	15.95'
L56	N87°12'21"E	15.83'
L57	N88°03'58"E	0.79'
L58	N60°36'00"E	10.90'
L59	N29°24'00"W	20.00'
L60	N60°36'00"E	14.00'
L61	N60°36'00"E	14.00'
L62	N29°24'00"W	2.59'
L63	N88°03'58"E	3.46'
L64	N29°24'00"W	351.32'
L65	N60°36'00"E	14.00'
L66	N60°36'00"E	6.83'
L67	N29°24'00"W	331.07'
L68	N29°24'00"W	10.11'
L69	N60°36'00"E	15.50'
L70	N87°10'06"E	193.90'

REVISIONS

REV	DESCRIPTION	DATE	BY
1	SHEET UPDATE	05-10-96	RP
2	PER CLV PW FLOOD - CONTROL	05-14-96	DRF
3	GENERAL SHEET REVISION AND REVISIONS		DRF
4	PER LVWD COMMENTS	08-01-96	
5	PER CLV COMMENTS	09-18-96	CRW

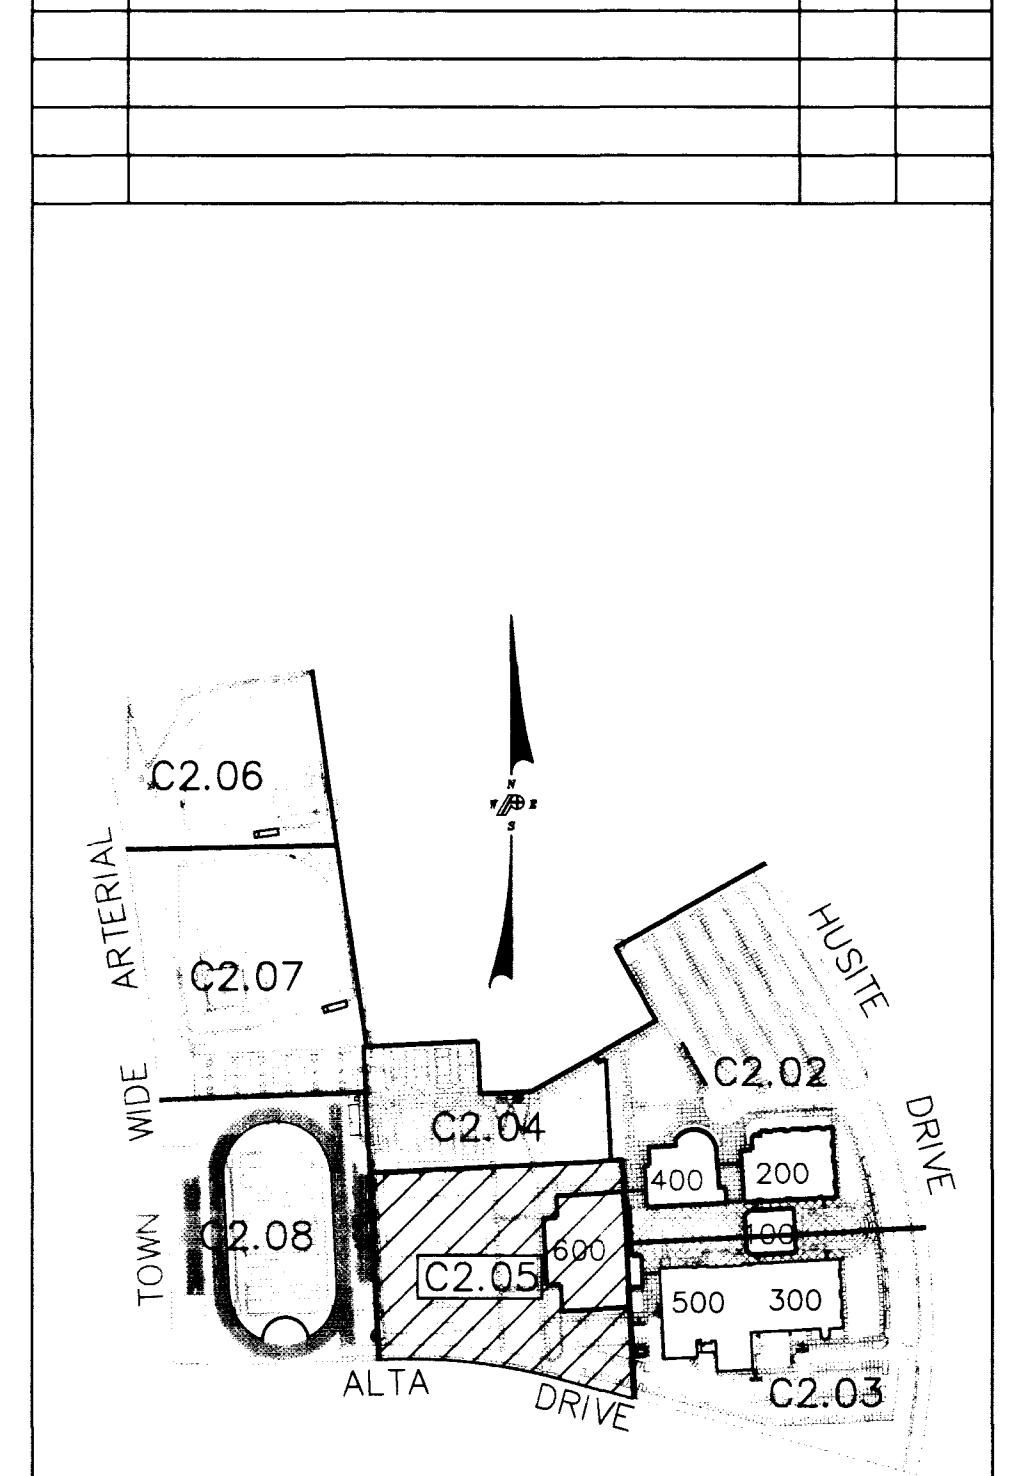

**DISCLAIMER**

- CIVIL PLAN SHOWS ONLY BUILDING 600. ALL OTHER BUILDINGS AND SPORT FACILITIES ARE TIED IN ACCORDANCE WITH ARCHITECTURAL PLANS. ENGINEER ASSUMES NO RESPONSIBILITY FOR ARCHITECTURAL HORIZONTAL CONTROLS.
- ALL OFF-SITE IMPROVEMENTS THAT ARE NOT NOTED OR DEFINED ON THE CIVIL DWGS. INCLUDING OFF-SITE IMPROVEMENTS TO HUSITE DRIVE, LANDSCAPE PARKWAY ALTA DRIVE, ETC. ARE NOT IN THIS CONTRACT AND ARE BY OTHERS.

**CONSTRUCTION NOTES**

- LEGAL DESCRIPTION ON SHEET C1.01
- ALL EXISTING MONUMENTS MUST BE MAINTAINED OR RESTORED IF DISTURBED.
- DIMENSIONS ON SITE PLAN ARE SHOWN FROM BACK OF CURB, UNLESS NOTED OTHERWISE.

**KEY NOTES**

- CONSTRUCT SIDEWALK RAMP REF: C6.01
- CONCRETE RETAINING WALL REF: C6.02, C6.03
- CONSTRUCT ON-SITE "A" TYPE ISLAND CURB REF: C6.01 ISLAND TYPES NOTED THUS [X]. SEE SHEET C6.03
- CONSTRUCT ON-SITE "L" TYPE CURB AND GUTTER REF: C6.01
- CONCRETE STAIRS AND RAMPS, SEE ARCHITECTURAL DWGS.
- PROVIDE 3' WIDE VALLEY GUTTER REF: C6.02
- CONSTRUCT 16' WIDE CURB RAMP REF: C6.01
- CONSTRUCT OFF-SITE "L" TYPE CURB AND GUTTER REF: C6.01
- CONCRETE ON-SITE SIDEWALK. SEE ARCHITECTURAL DWGS FOR PATTERN AND LOCATION OF JOINTING. REF: C6.01
- LANDSCAPING - SEE LANDSCAPE DRAWINGS.
- CONCRETE CURB WITH CHAIN LINK FENCE. SEE ARCHITECTURAL DWGS.
- ON-SITE PAVING. REF: C6.02
- CONCRETE OFF-SITE DRIVEWAY. SEE CLARK COUNTY AREA DWG NO 228.
- FOR ON-SITE SPEED BUMP. REF: C6.02
- PRECAST CONCRETE STOPS - SEE SPECIFICATION.
- RECESS CURB AND GUTTER AT VALLEY GUTTER.

Call before you Dig.  
 1-800-227-2600

ENGINEER SEAL: CHAG MARRAS CIVIL ENGINEER, LICENSE NO. 8777, STATE OF NEVADA

PROJECT NO: 0846  
 DATE: 4.16.96  
 DRAWN BY: BKP  
 CHECKED BY: CLM  
 SUBMITTED: BID SET  
 PROJECT NO: 95263C

**TATE & SNYDER ARCHITECTS**  
 709 VALLE VERDE COURT  
 HENDERSON NEVADA 89014  
 (702) 456.3000


**POGGEMEYER DESIGN GROUP**  
 ENGINEERS PLANNERS SURVEYORS  
 2801 NORTH DENVER WAY LAS VEGAS, NEVADA 89128 (702) 296-8100

**CLARK COUNTY SCHOOL DISTRICT**  
 CONSTRUCTION MANAGEMENT DEPARTMENT 4828 S. PEARL STREET 799-7600 LAS VEGAS, NEVADA 89121


**ALTA/HUALAPAI HIGH SCHOOL**  
 LAS VEGAS

**SITE PLAN - AREA D**

SHEET NO: **C2.05**

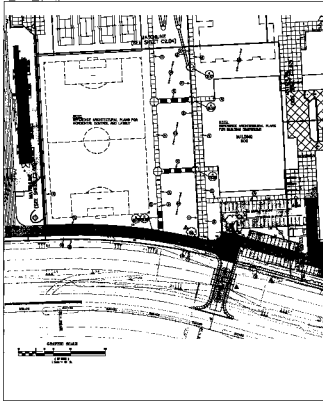

BACK OF CURB CURVE TABLE

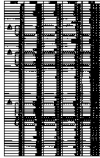

BACK OF CURB LINE TABLE
















**SITE PLAN - AREA D**