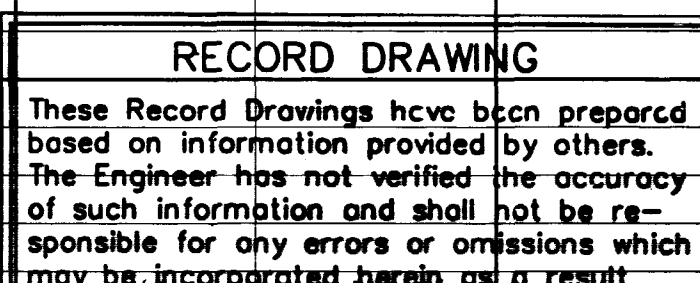


[illegible]



731-54C

1055 EAST TROPICANA  
SUITE 800  
LAS VEGAS, NEVADA 89119  
(702) 798-1007

NEA

 $D-5^T$

MAIN LINE - STA. 101+00  
SEE SHEET D-4

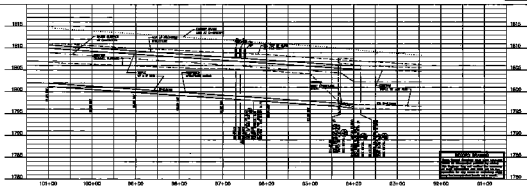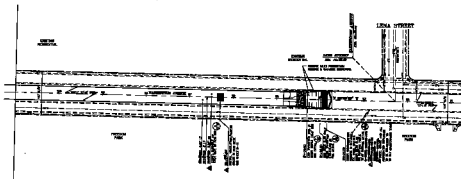

**MANHOLE STRUCTURE PLAN and PROFILE**  
 STA. 101+00 to 01+00

**D-5**  
