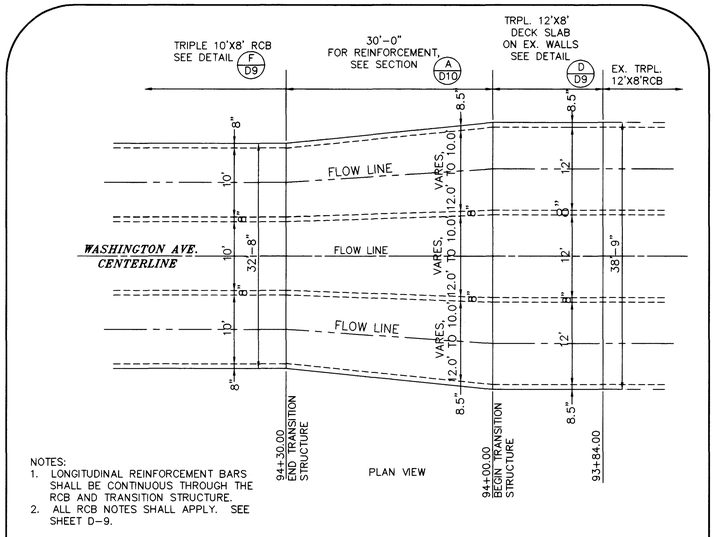

NOTES:
1. LONGITUDINAL REINFORCEMENT BARS SHALL BE CONTINUOUS THROUGH THE RCB AND TRANSITION STRUCTURE.
2. ALL RCB NOTES SHALL APPLY. SEE SHEET D-9.

TRANSITION STRUCTURE #1 (B)

SCALE: 1"= 10'

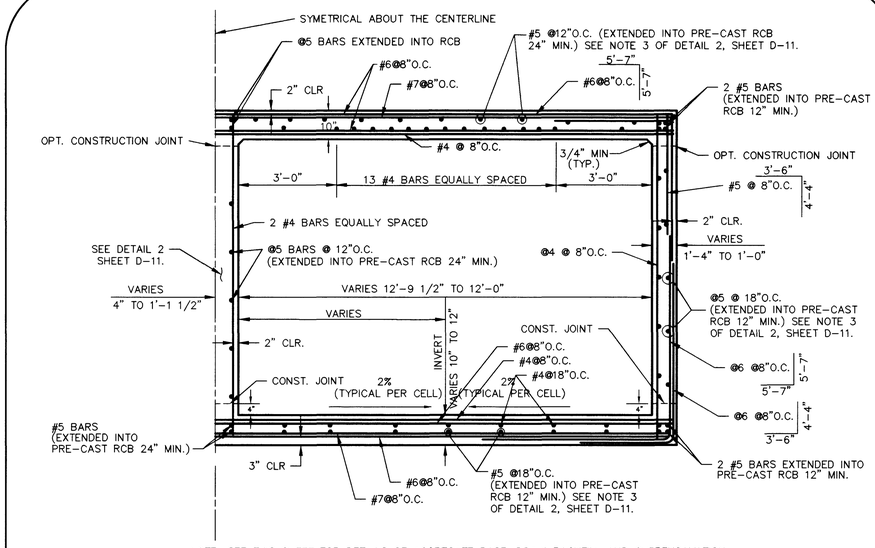

NOTE: SEE THIS SHEET FOR DETAILS OF AGGREGATE BASE, DRAIN BACKFILL AND OVEREXCAVATION.

DOUBLE 12'x 8' RCB (C)

STA. 131+57.50 TO STA. 131+64.50

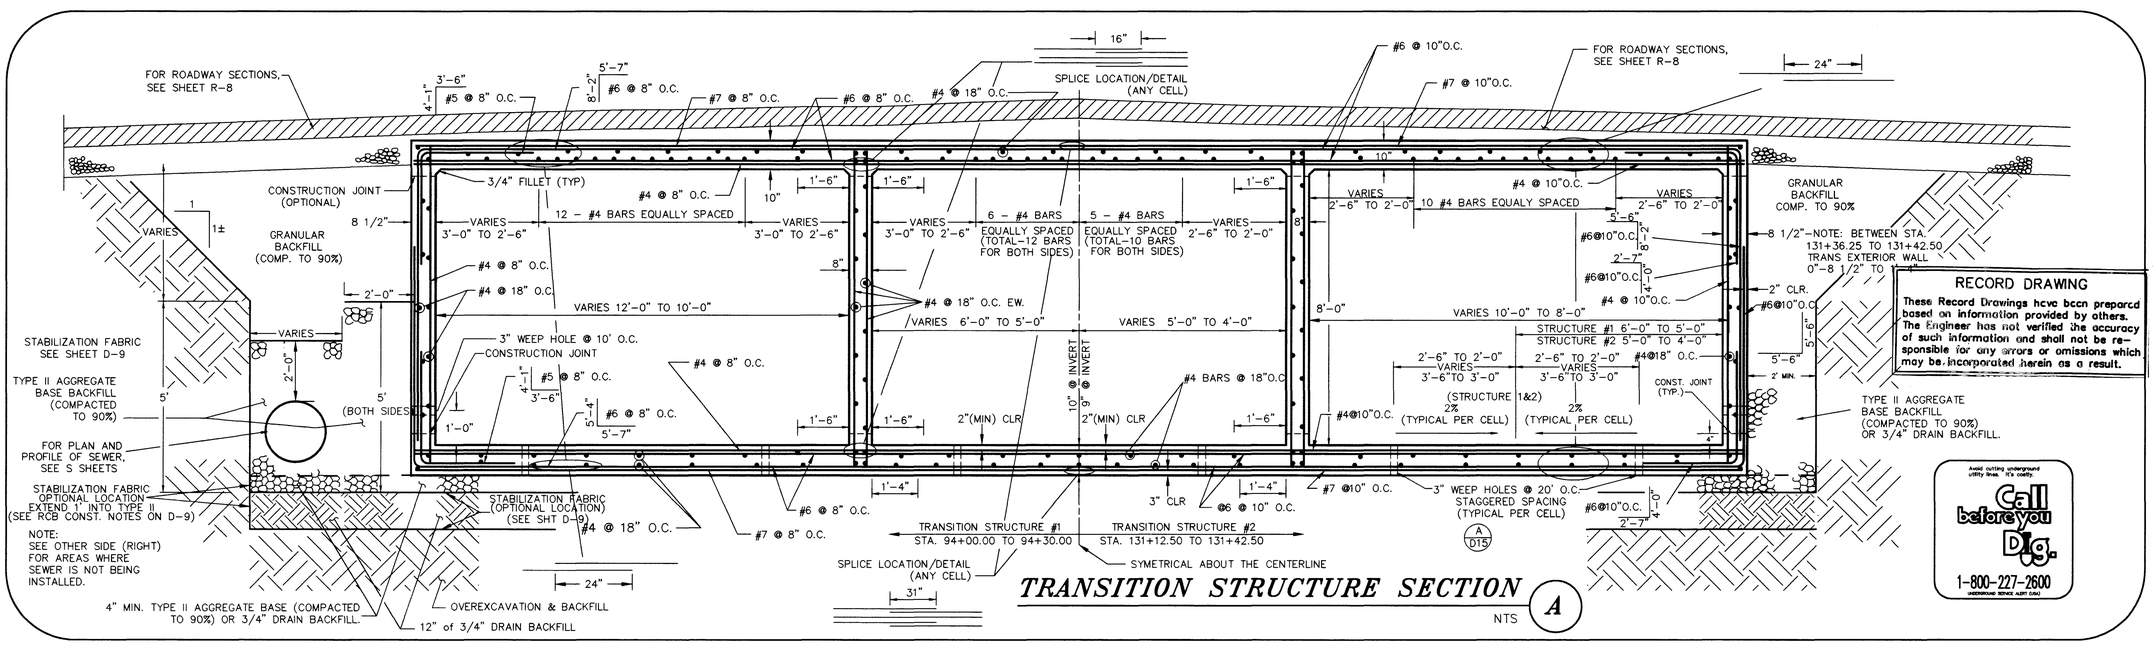

TRANSITION STRUCTURE SECTION (A)

NTS

REVISIONS

No.	Date		CHKD	APPD

DESIGNED: BB
DRAWN: BB/JH
CHECKED: BB
JOB NO. 393-3-91
SCALE: AS
HORIZ. NOTED
VERT.

1055 EAST TROPICANA SUITE 800 LAS VEGAS, NEVADA 89119 (702)798-1007
CONSULTING ENGINEERS

PROJECT: CITY OF LAS VEGAS WASHINGTON AVENUE CONVEYANCE SYSTEM

DESCRIPTION: TRANSITION STRUCTURES and DETAILS

SHEET D-10

13 OF 39

LENA STREET TO EASTERN AVENUE 731-54C

3191

M:\393-91\EASTRN-3\FINAL\393ED10 Tue Dec 6 10:05:33 1994

 

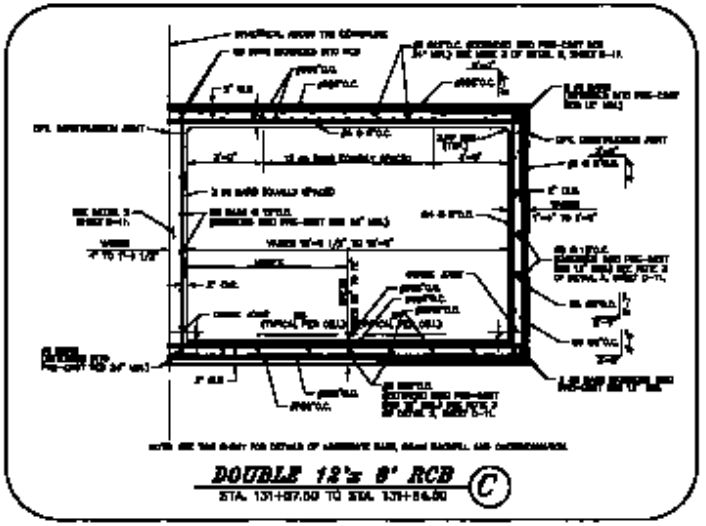

 

CITY OF LAS VEGAS

TRANSITION STRUCTURES
STRUCTURE DETAILS

D-10