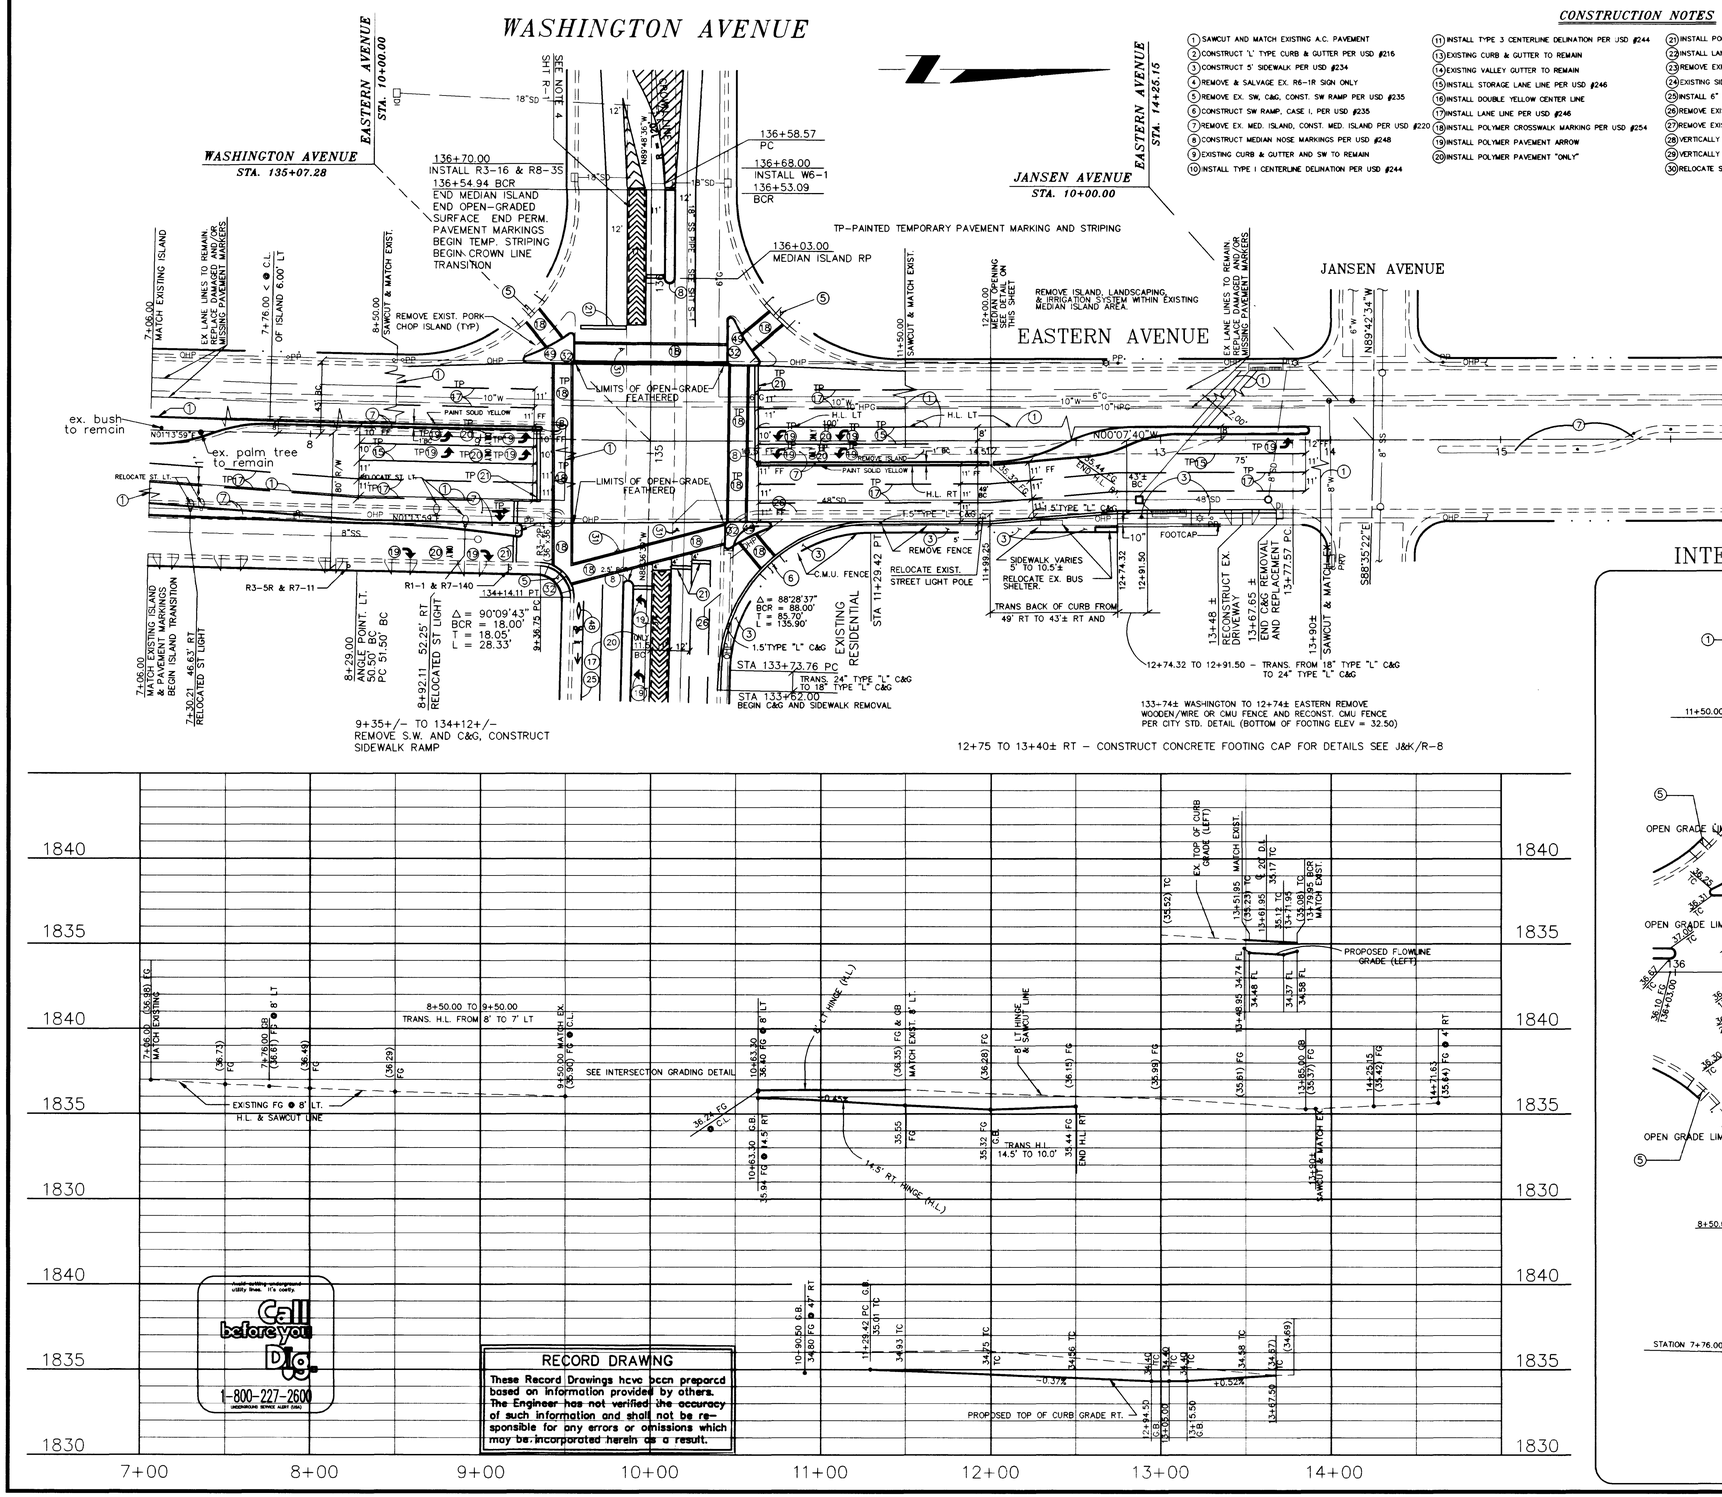

CONSTRUCTION NOTES

1. SAWCUT AND MATCH EXISTING A.C. PAVEMENT
2. CONSTRUCT 'L' TYPE CURB & GUTTER PER USD #216
3. CONSTRUCT 5' SIDEWALK PER USD #234
4. REMOVE & SALVAGE EX. R6-1R SIGN ONLY
5. REMOVE EX. SW, C&G, CONST. SW RAMP PER USD #235
6. CONSTRUCT SW RAMP, CASE I, PER USD #235
7. REMOVE EX. MED. ISLAND, CONST. MED. ISLAND PER USD #220
8. CONSTRUCT MEDIAN NOSE MARKINGS PER USD #248
9. EXISTING CURB & GUTTER AND SW TO REMAIN
10. INSTALL TYPE I CENTERLINE DELINATION PER USD #244
11. INSTALL TYPE 3 CENTERLINE DELINATION PER USD #244
13. EXISTING CURB & GUTTER TO REMAIN
14. EXISTING VALLEY GUTTER TO REMAIN
15. INSTALL STORAGE LANE LINE PER USD #246
16. INSTALL DOUBLE YELLOW CENTER LINE
17. INSTALL LANE LINE PER USD #246
18. INSTALL POLYMER CROSSWALK MARKING PER USD #254
19. INSTALL POLYMER PAVEMENT ARROW
20. INSTALL POLYMER PAVEMENT "ONLY"
21. INSTALL POLYMER PAVEMENT STOP BAR (24")
22. INSTALL LANE DELINATION TRANSITION PER USD #245
23. REMOVE EXISTING VALLEY GUTTER AS SHOWN
24. EXISTING SIDEWALK RAMP TO REMAIN
25. INSTALL 6" PAINTED WHITE BIKE LANE LINE
26. REMOVE EXISTING CURB & GUTTER
27. REMOVE EXISTING SIDEWALK
28. VERTICALLY ADJUST WATER VALVE BOX
29. VERTICALLY ADJUST MANHOLE COVER
30. RELOCATE SIGN
31. REMOVE & SALVAGE EX. SIGN
32. TRAFFIC SIGNAL IMPROVEMENTS (SEE ELECTRICAL PLANS)
33. INSTALL DOTTED LANE LINE PER DETAIL
34. REMOVE AND SALVAGE EXISTING CONCRETE BARRIER RAIL
35. INSTALL TEMPORARY STRIPING AS SHOWN
36. CONSTRUCT PLANTMIX BITUMINOUS SURFACE PER DETAIL
47. REMOVE TACK-ON CURB
48. INSTALL POLYMER BIKE LANE MARKERS PER DETAIL
49. CONST. CONCRETE PORK CHOP ISLAND PER DETAIL IN APPENDIX IN THE SUPPLEMENTAL CONSTRUCTION DETAILS

REVISIONS			
No.	Date	CHKD	APPD

DESIGNED: JM/JH/BB
DRAWN: JM/JH/BB
CHECKED: RB
JOB NO. 393-3-91
SCALE: AS NOTED
HORIZ. AS NOTED
VERT. AS NOTED

1055 EAST TROPICANA
SUITE 800
LAS VEGAS, NEVADA 89119
(702)798-1007
CONSULTING ENGINEERS

PROJECT: CITY OF LAS VEGAS
WASHINGTON AVENUE CONVEYANCE SYSTEM

DESCRIPTION: ROADWAY PLAN and PROFILE
EASTERN AVENUE

SHEET (REVISED) #2
April 5, 1996
R-7
30 OF 39

3174

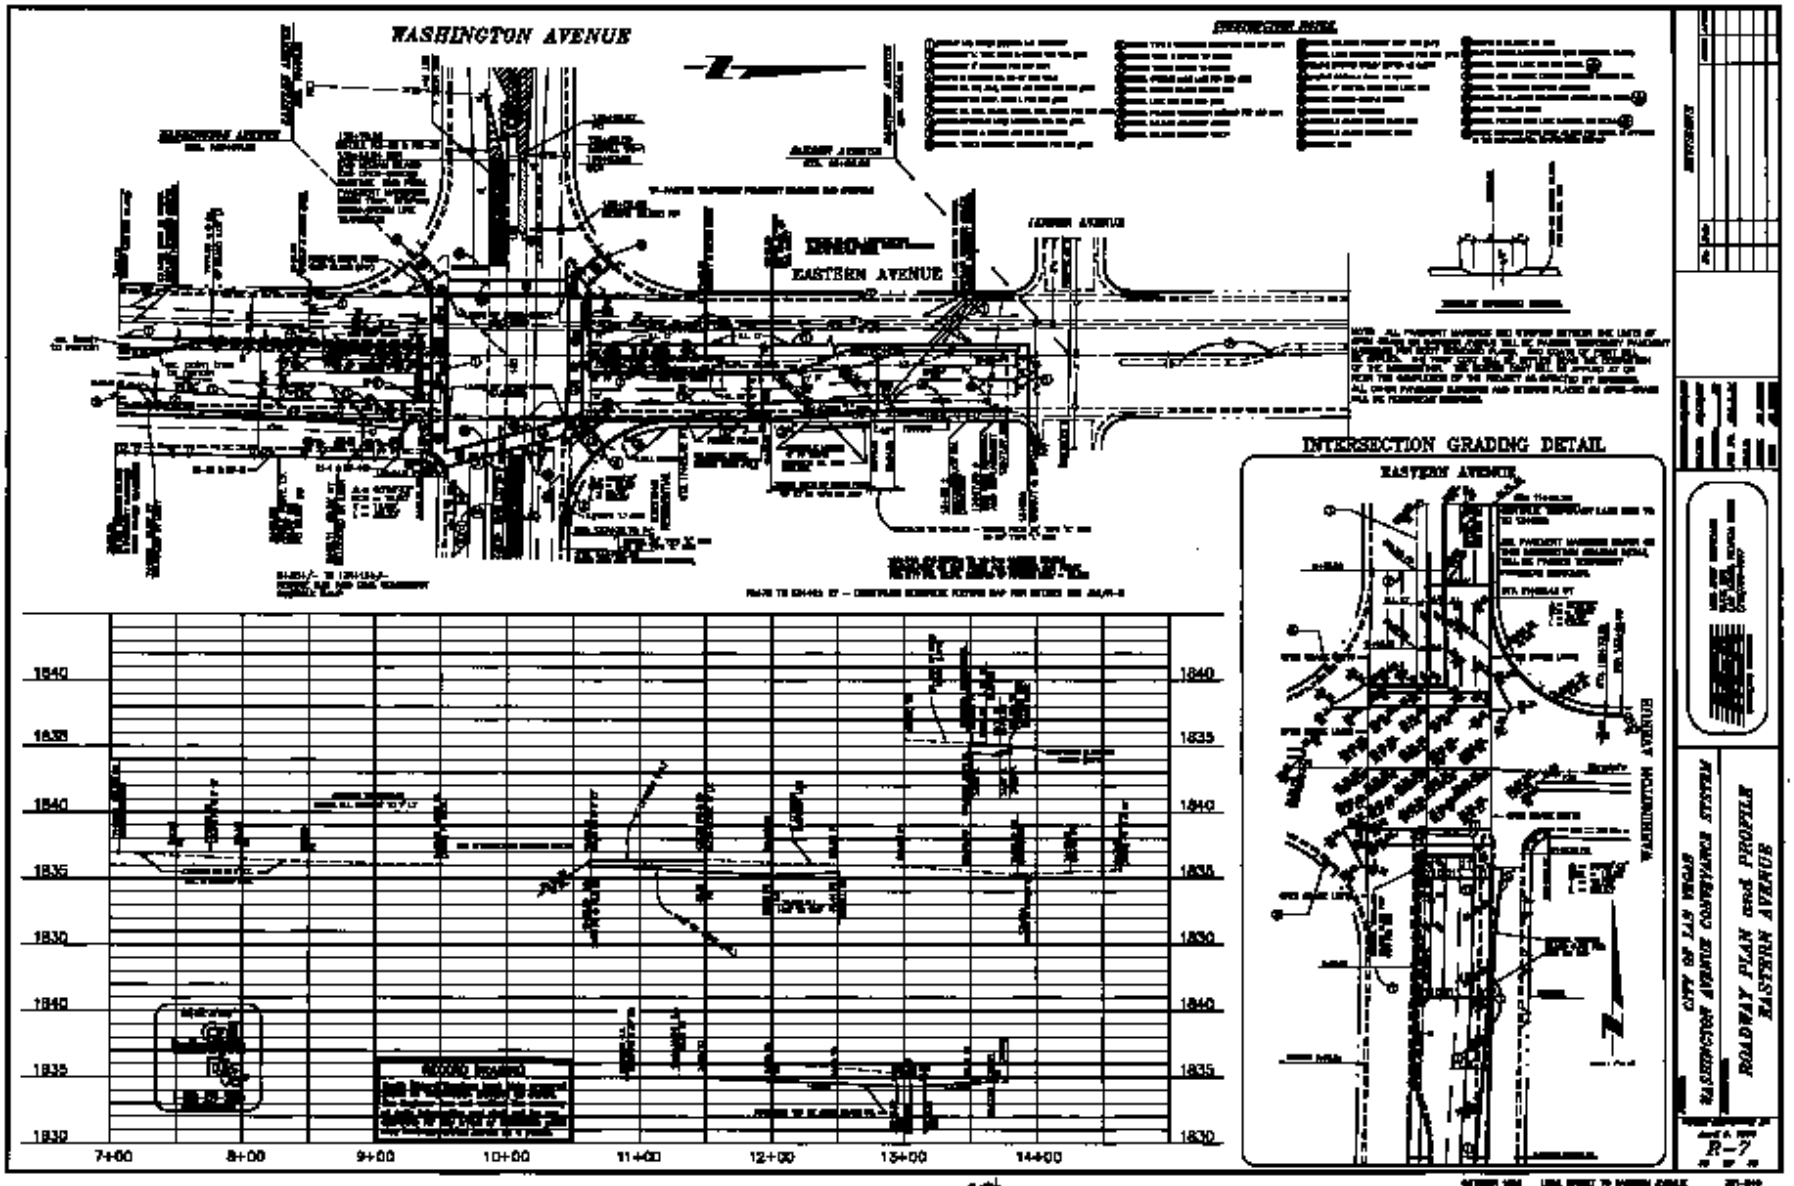
WASHINGTON AVENUE
EASTERN AVENUE
INTERSECTION GRADING DETAIL
EASTERN AVENUE
WASHINGTON AVENUE
1840
1835
1830
7+00
8+00
9+00
10+00
11+00
12+00
13+00
14+00
CITY OF LAS VEGAS
WASHINGTON AVENUE CONVEYANCE SYSTEM
ROADWAY PLAN and PROFILE
EASTERN AVENUE
R-7