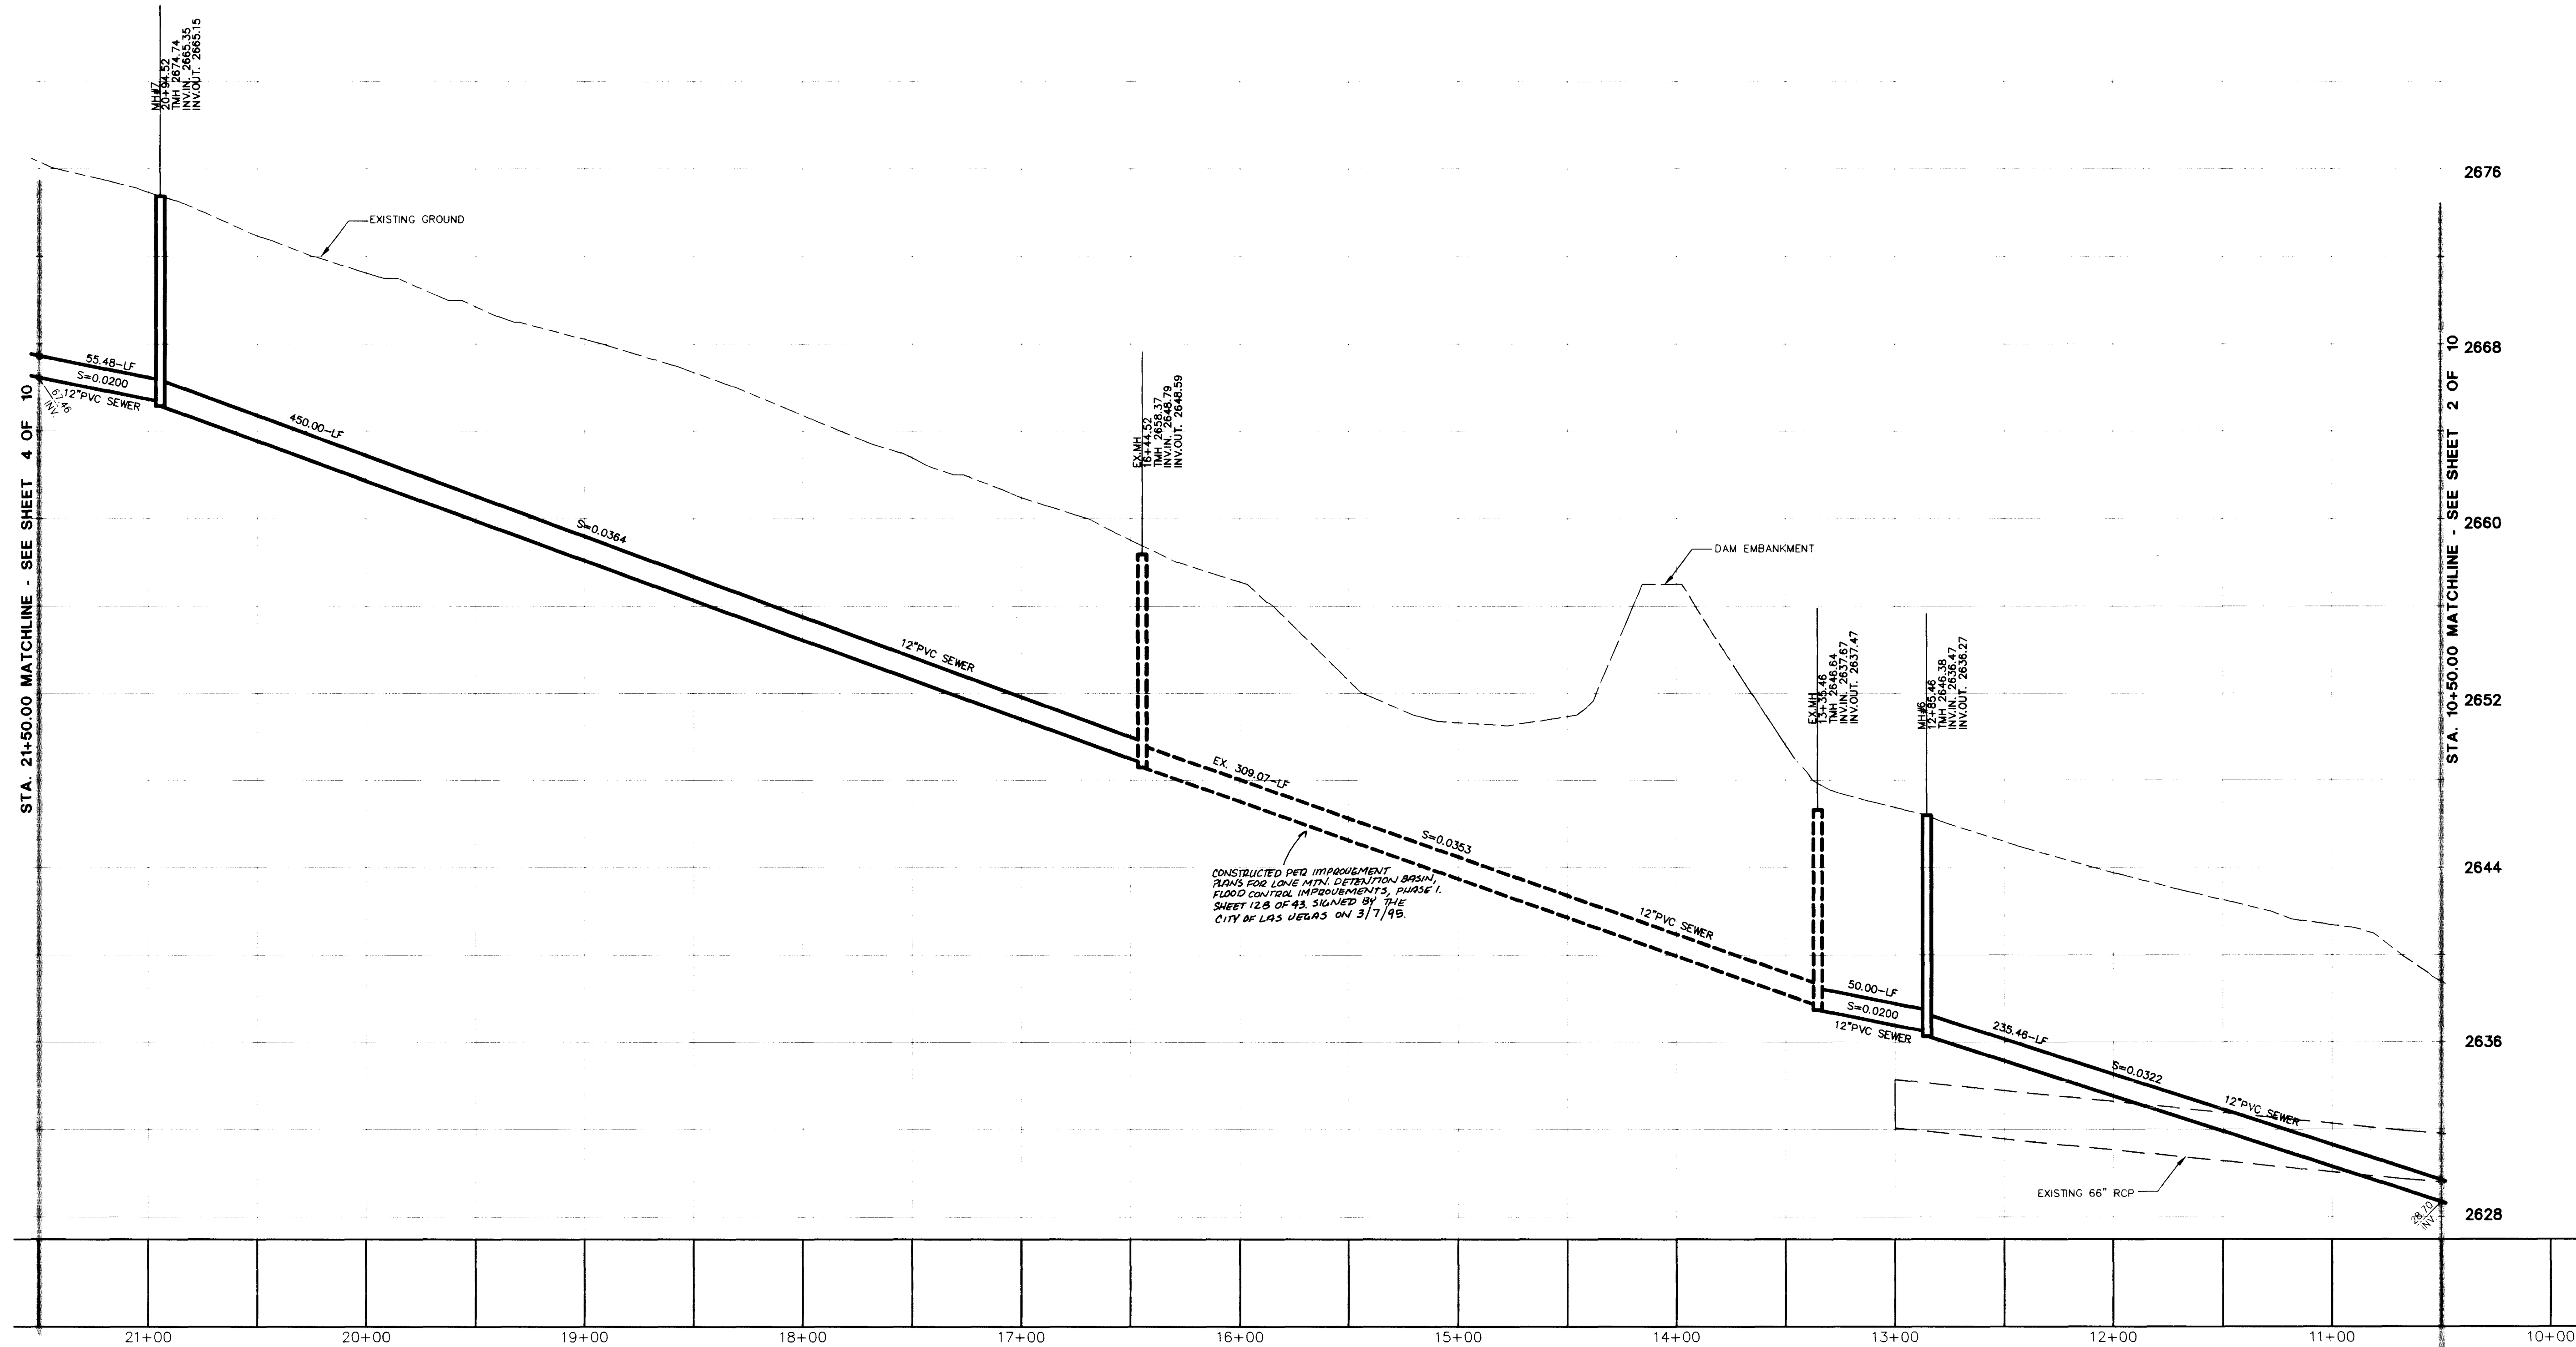


BENCHMARK

CLARK COUNTY BENCHMARK: 1000654
RIMT & SQUARE PLATE IN A CONCRETE MONUMENT 50'
NORTH AND 25' WEST OF GRAND CANYON DRIVE AND
ALEXANDER ROAD.
ELEVATION=792.992 METERS (NAVD 88)
ELEVATION=2601.67 FEET (NAVD 88 DATUM)


Call before you Dig
1-800-227-2600

Call before you OVERHEAD
1-702-593-6111

BASIS OF BEARING

NORTH 89°32'44" WEST, BEING THE SOUTH LINE OF THE SOUTHEAST QUARTER
(SE 1/4) OF SECTION 12, TOWNSHIP 20 SOUTH, RANGE 59 EAST, M.D.M., CITY
OF LAS VEGAS, CLARK COUNTY, NEVADA, AS SHOWN ON THAT CERTAIN MAP ON
FILE IN THE OFFICE OF THE COUNTY RECORDER, CLARK COUNTY, NEVADA, IN
FILE 81 OF SURVEYS, AT PAGE 44.

GRAPHIC SCALE

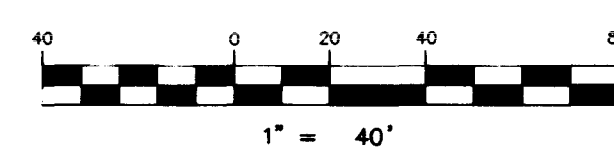


NOTE:
ALL STATIONING IS BASED ON SEWER
LENGTHS FROM MANHOLE TO MANHOLE

NOTE: CONTRACTOR SHALL VERIFY HORIZONTAL AND
VERTICAL LOCATION OF EXISTING UTILITIES AND
NOTIFY THE DESIGN ENGINEER IMMEDIATELY OF
ANY DISCREPANCIES PRIOR TO CONSTRUCTION.

PERMA-BILT
CITY OF LAS VEGAS, NEVADA
CONSULTING ENGINEERS • PLANNERS • LAND SURVEYORS
2727 SOUTH RAINBOW BOULEVARD
LAS VEGAS, NEVADA 89102-5148 PHONE (702) 873-7550 FAX (702) 362-2597

OFFSITE SEWER PLAN & PROFILE
GOWAN ROAD-ALTERNATE "A"
STA: 10+50.00-STA: 21+50.00
CHEYENNE/HUALAPAI I
OFFSITE SEWER

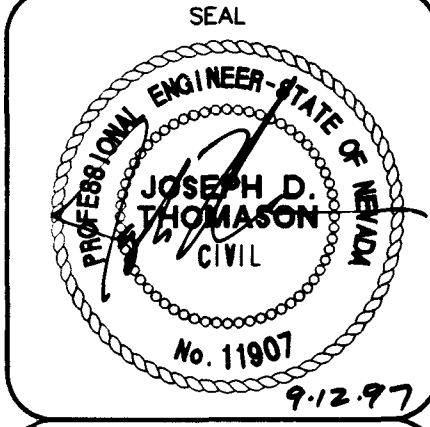

WO NO. 5016
BY BF/DLG
DATE MAY, 1997
SCALE: HORIZ. 1"=40'
VERT. 1"=4'
SHEET 3 OF 10 SHEETS

