


Avoid cutting underground utility lines. It's costly.

Call
before you
Dig.


1-800-227-2600

UNDERGROUND SERVICE ALERT (USA)

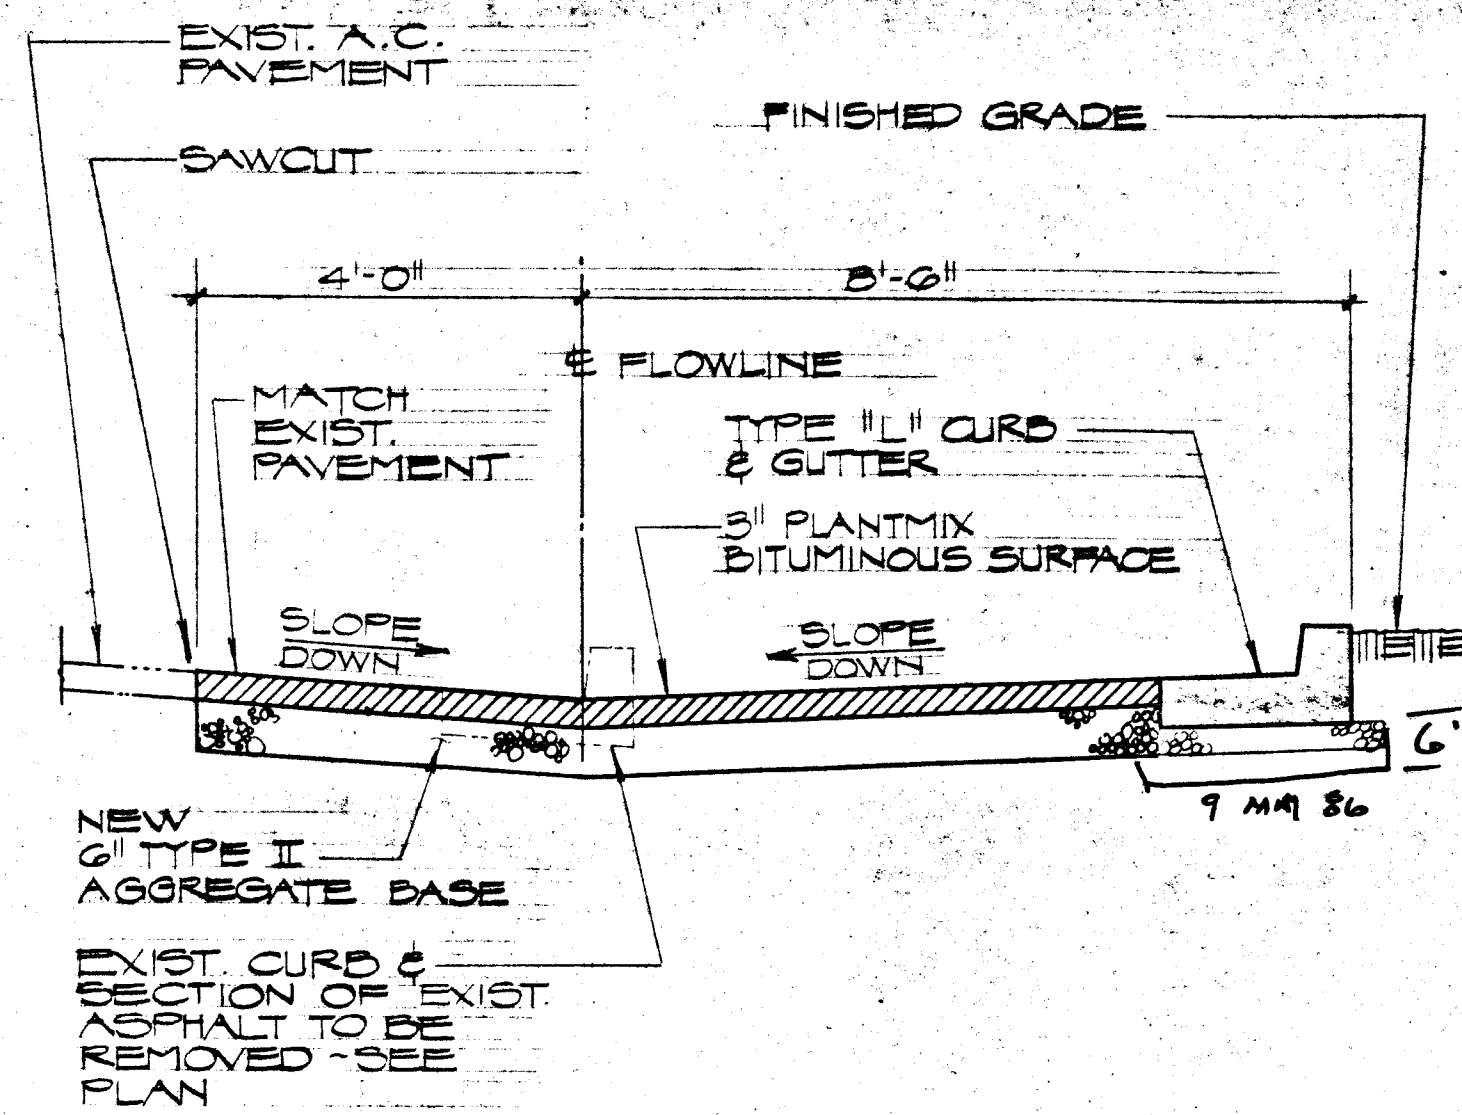


SECTION C

1/2" = 1'-0"

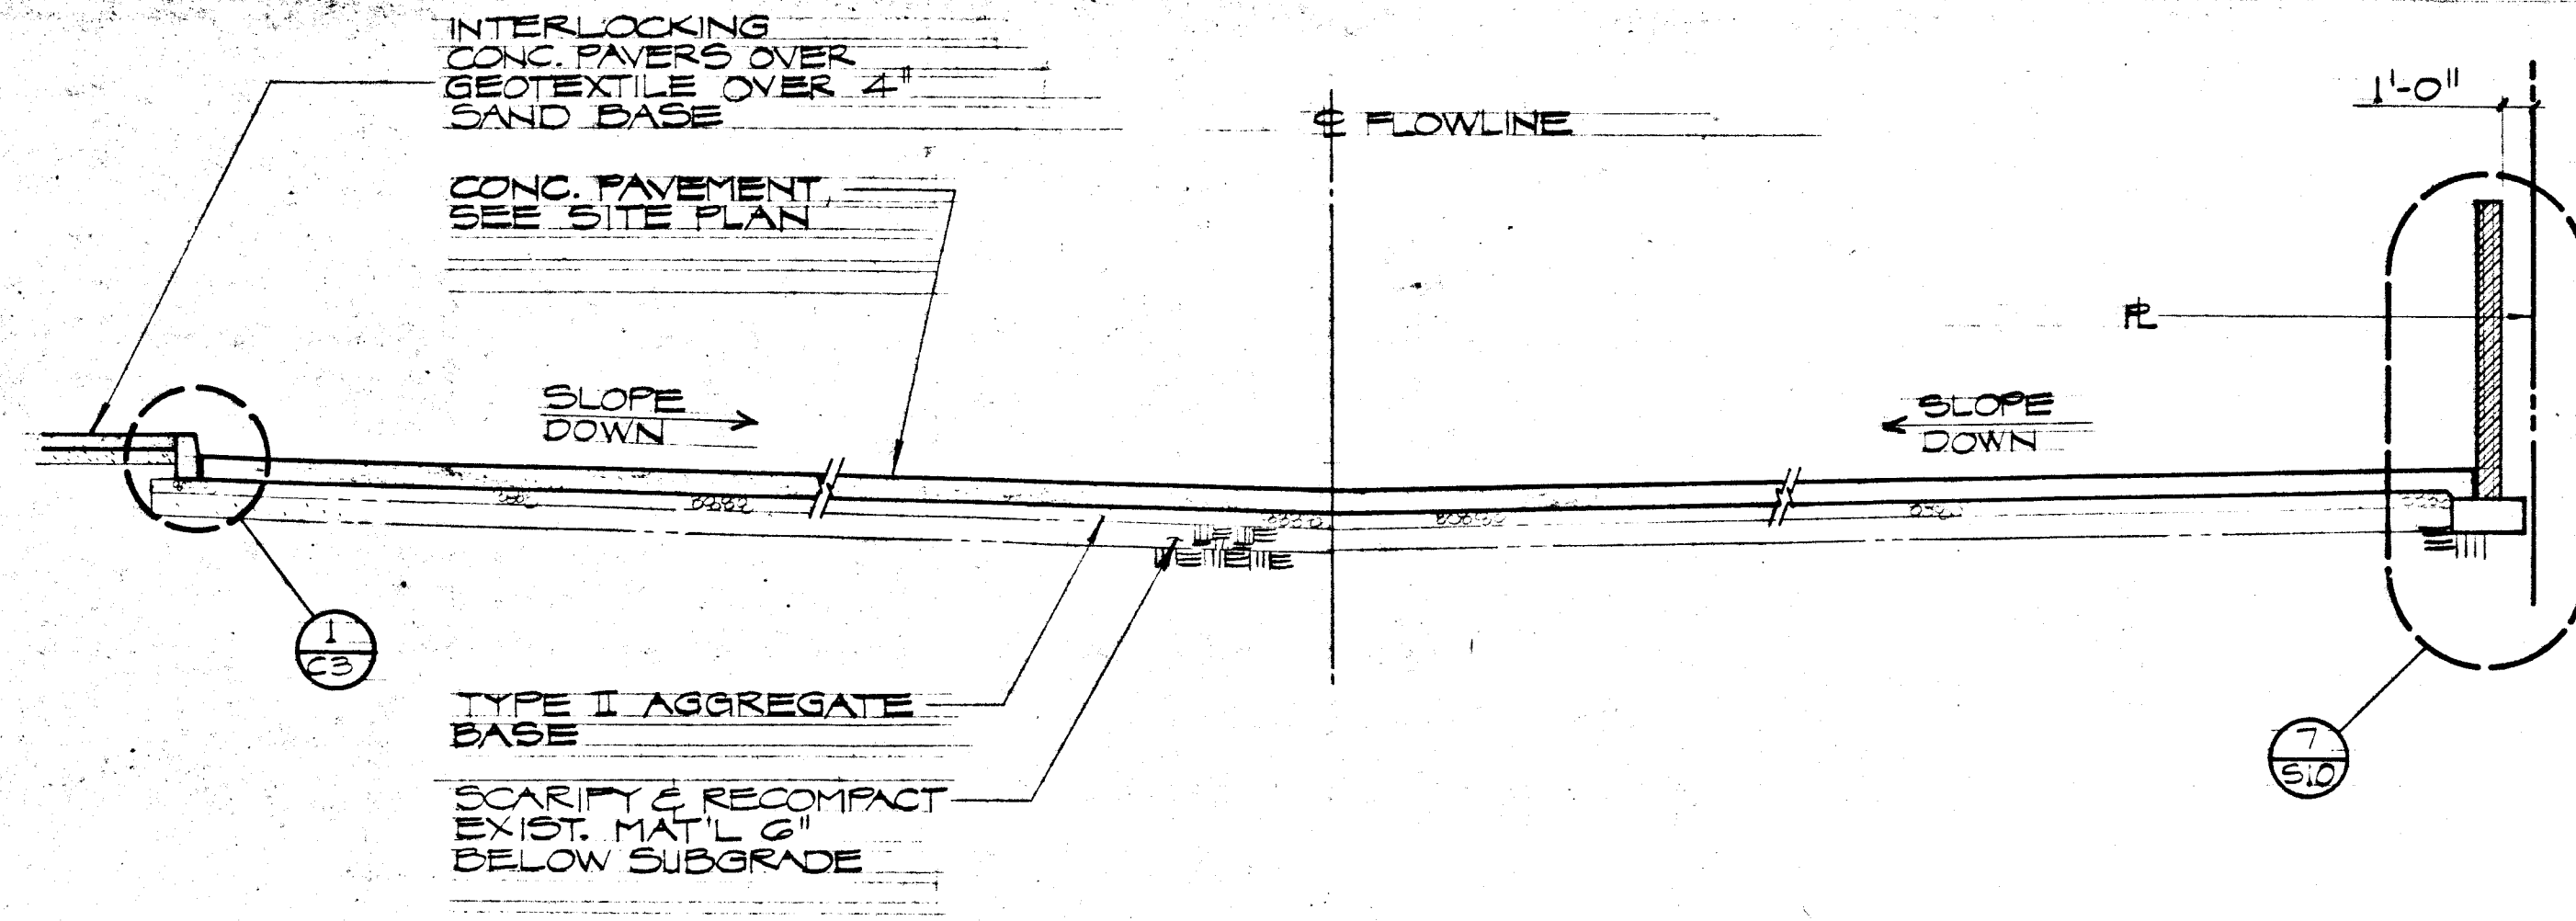


SECTION A

1/4" = 1'-0"

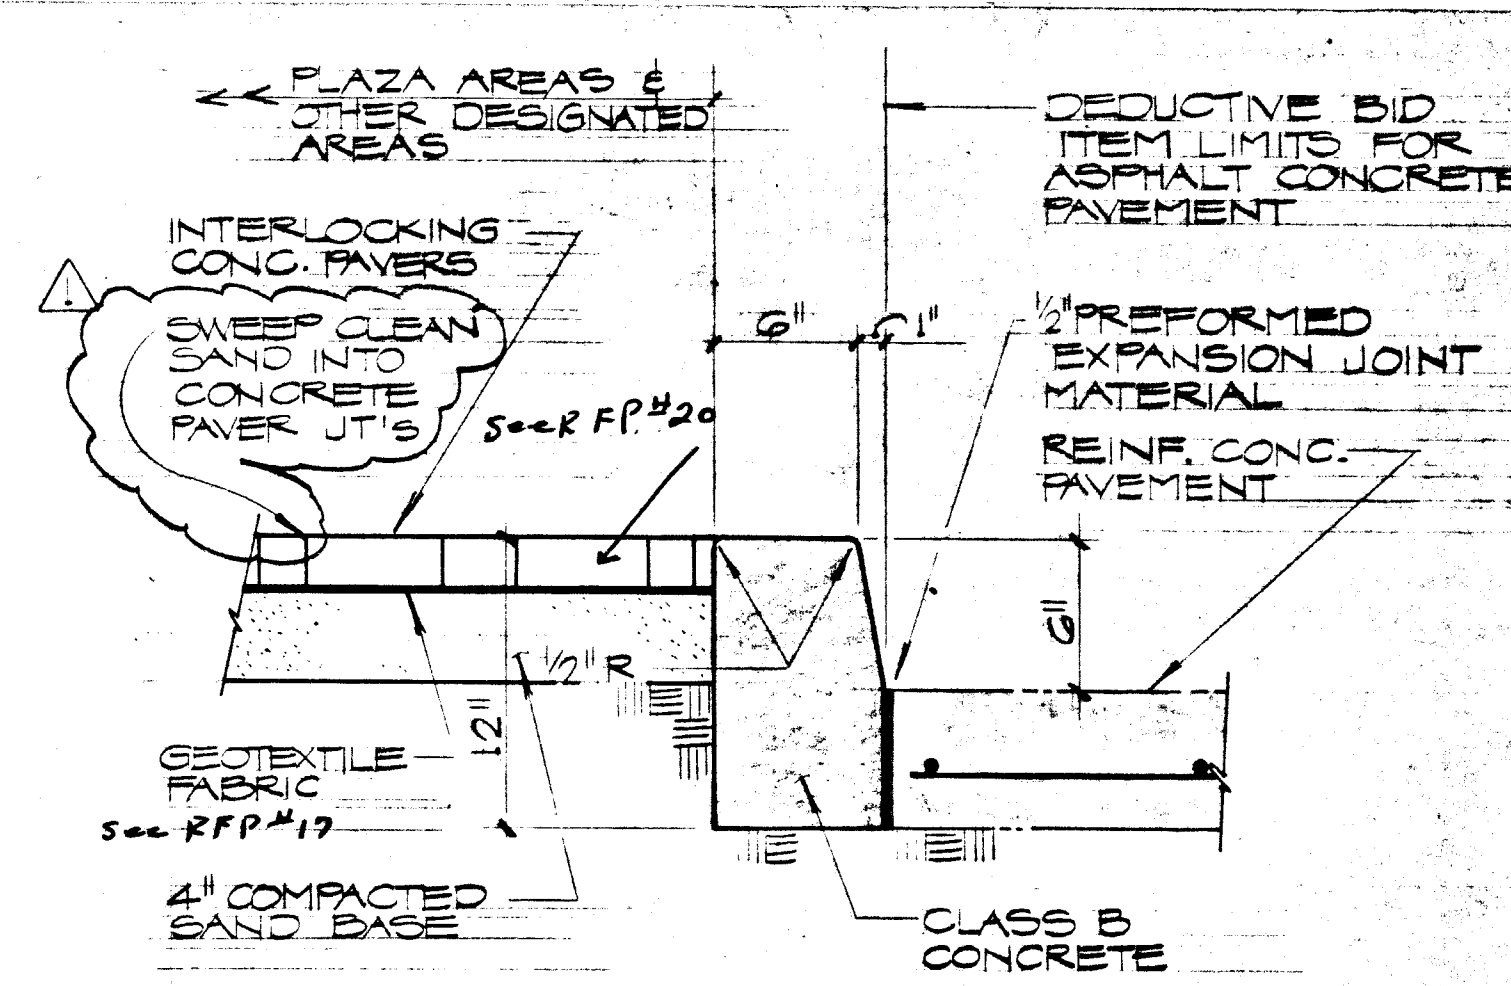


SECTION @ 'A' CURB

1-1/2" = 1'-0"

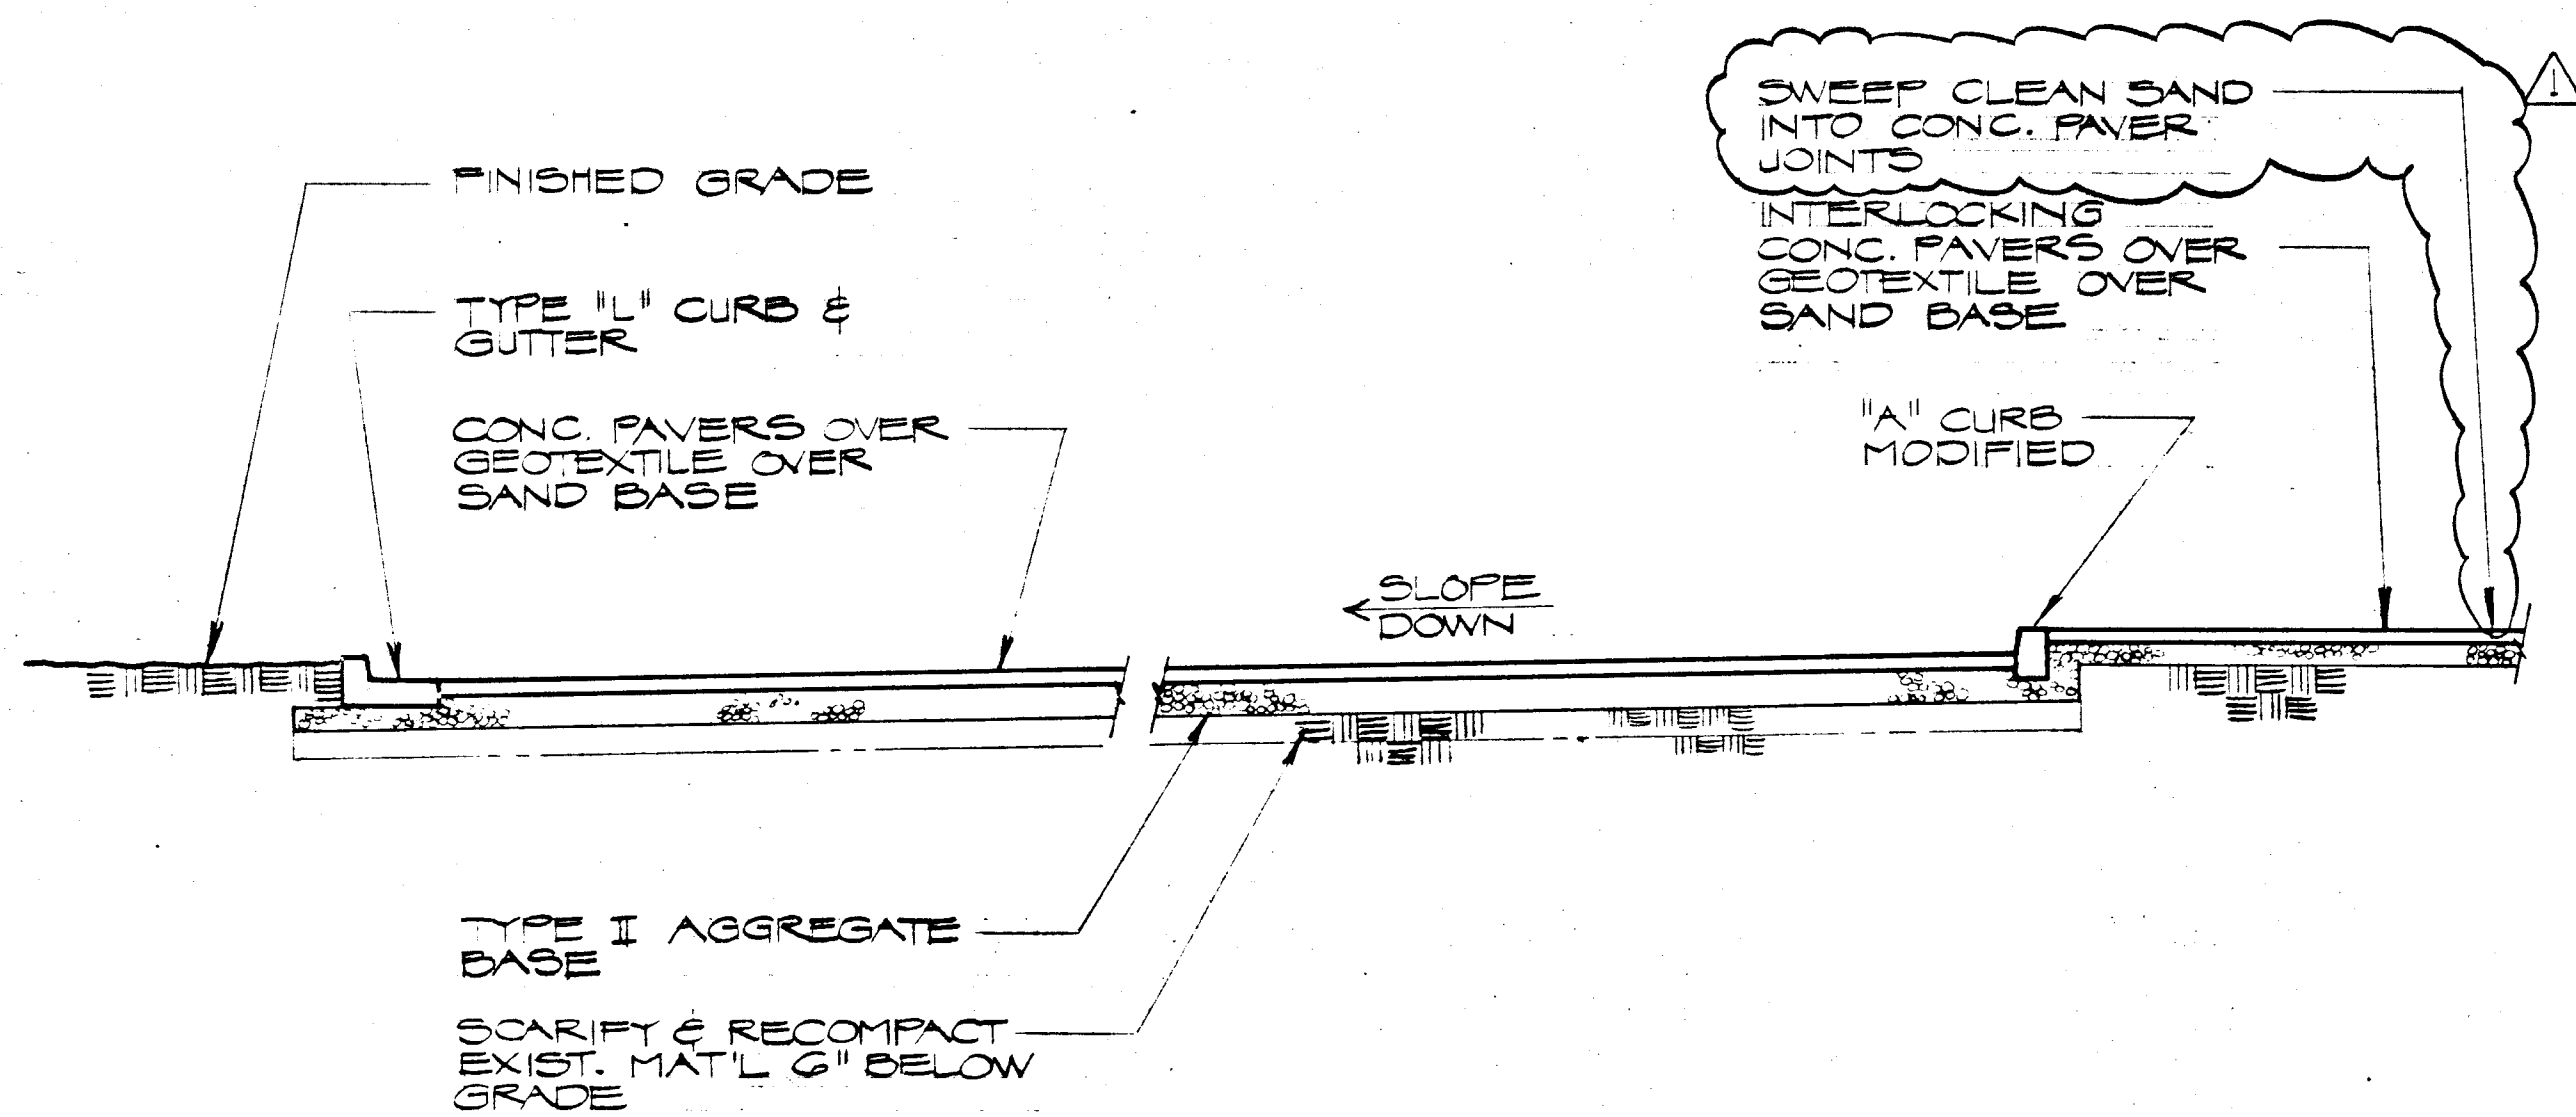


SECTION D

1/4" = 1'-0"

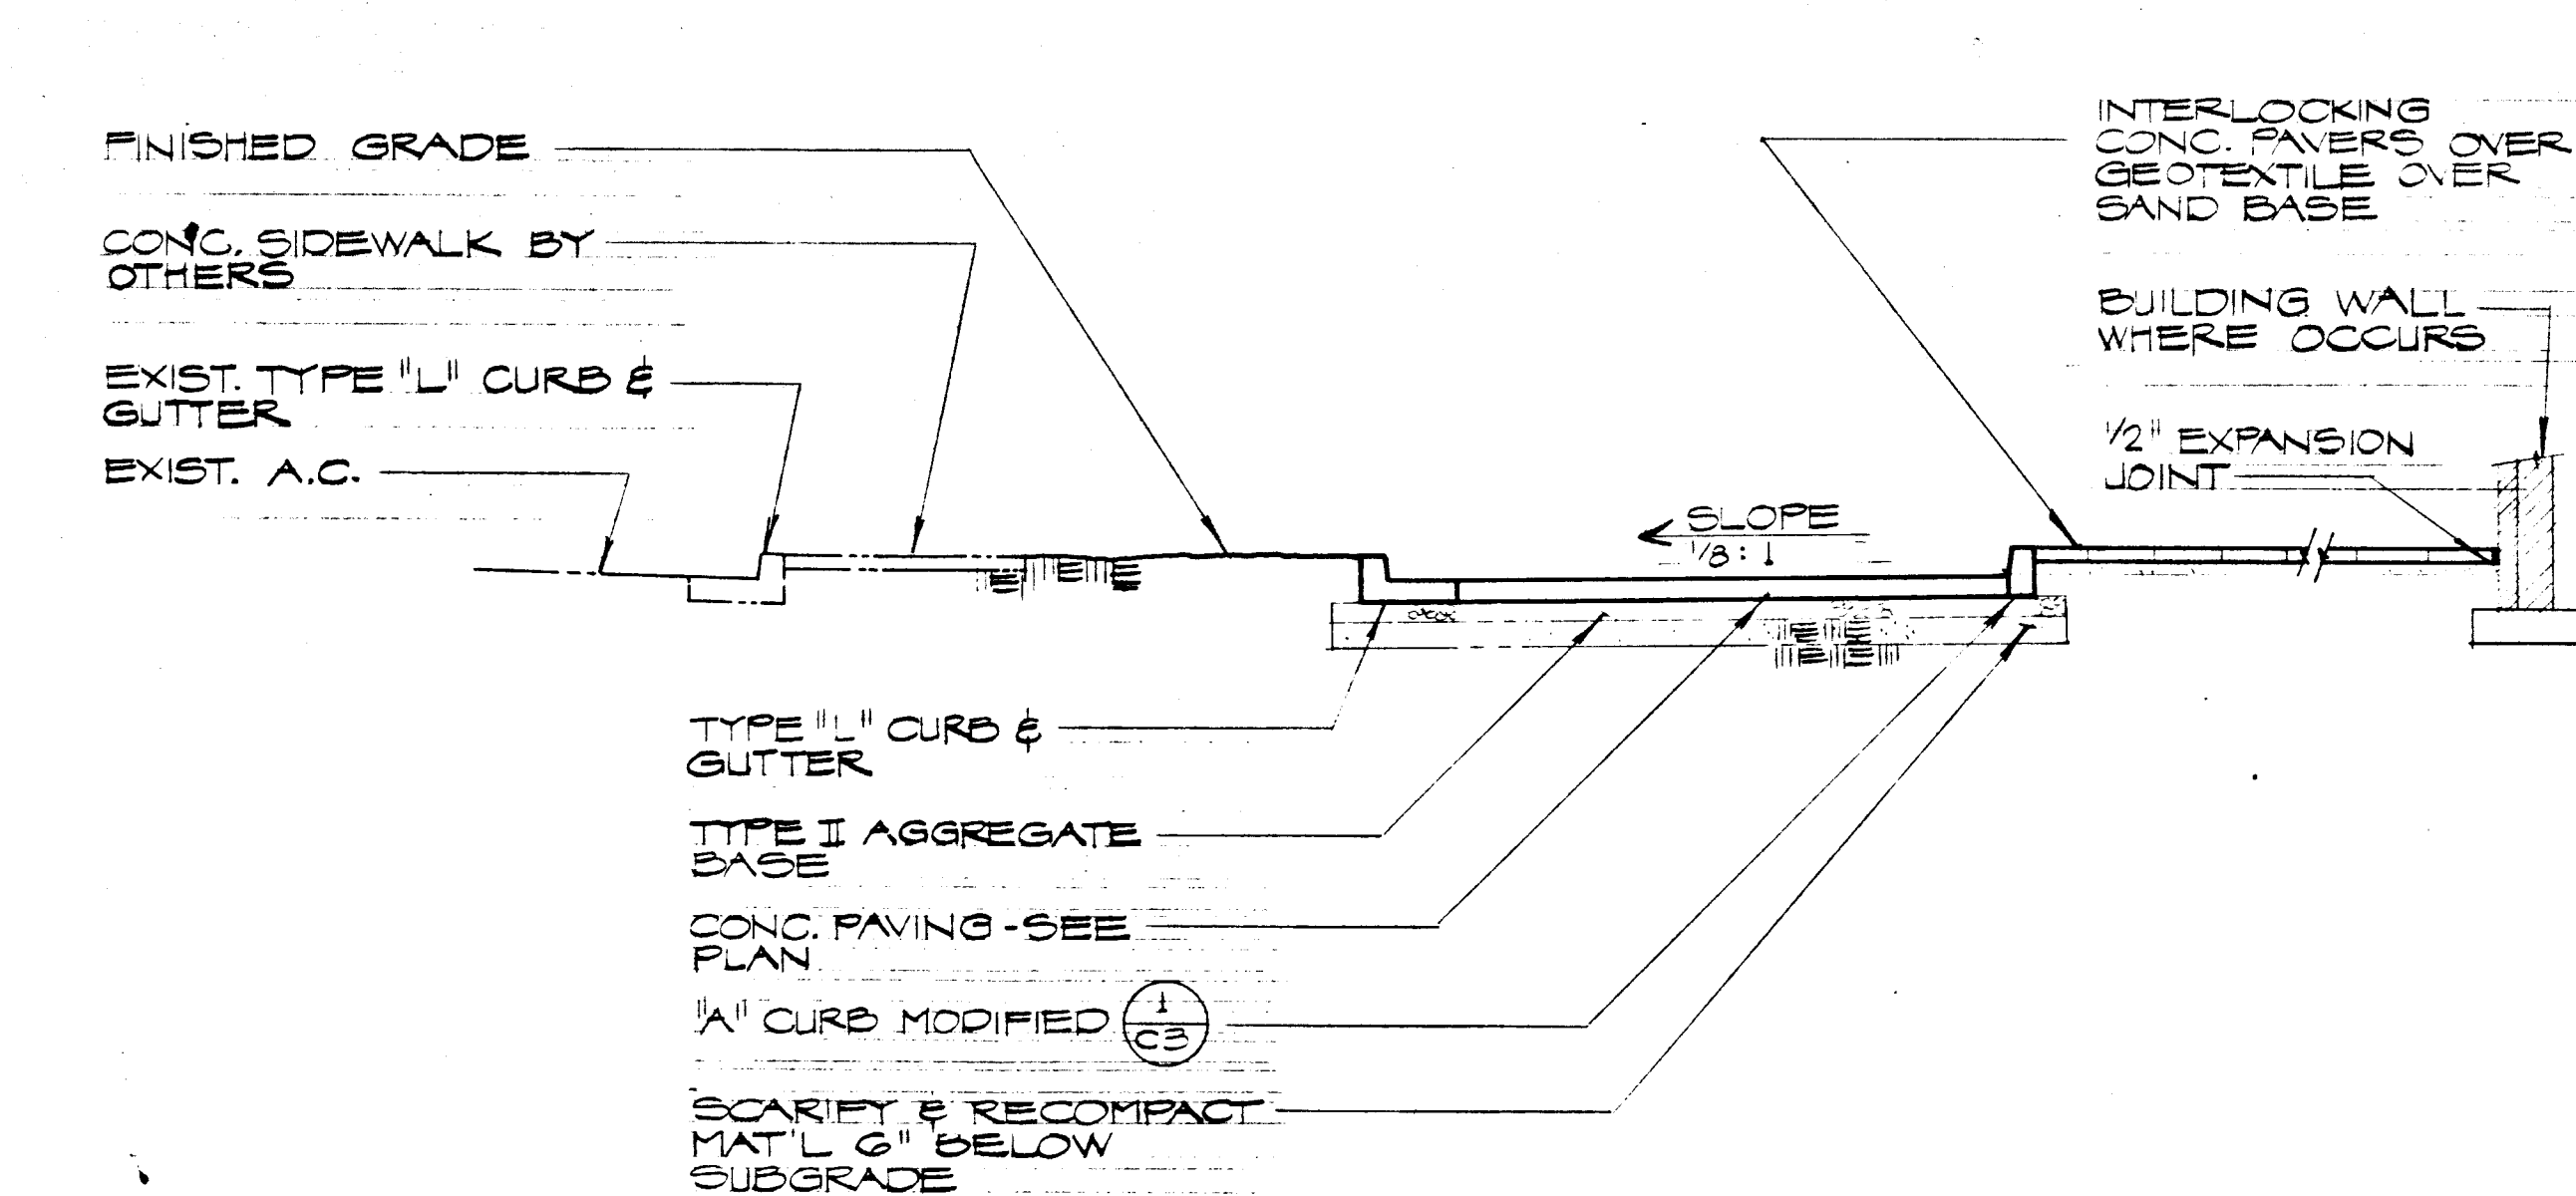


SECTION B

1/4" = 1'-0"

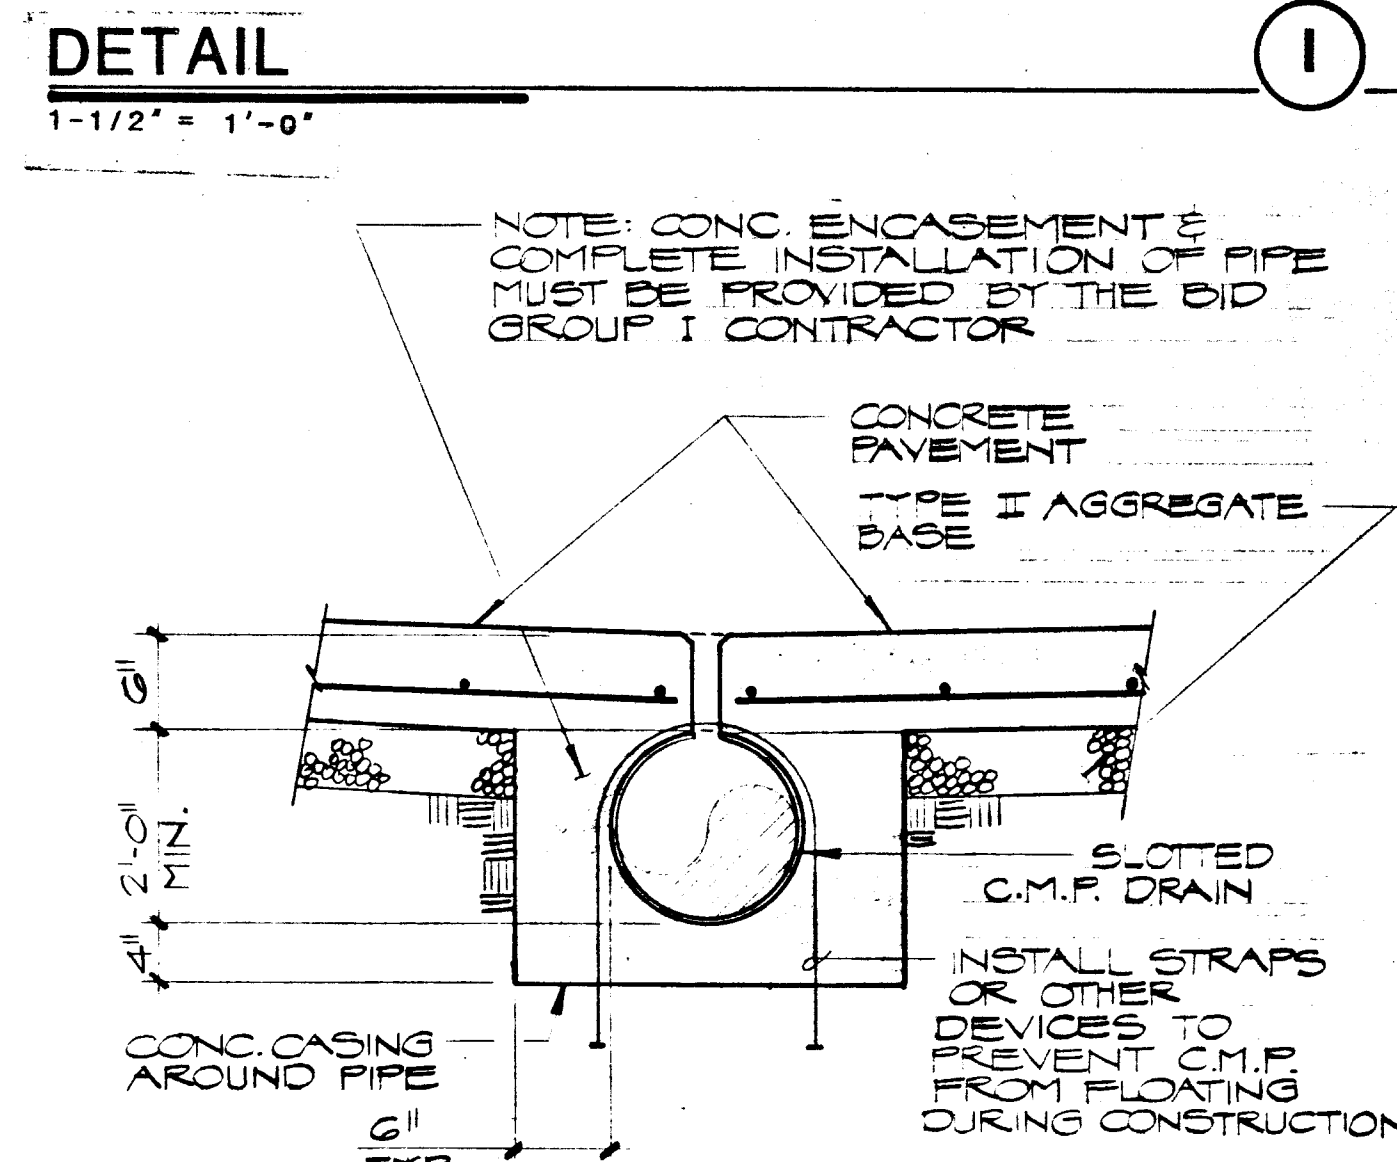


DETAIL 1

1-1/2" = 1'-0"

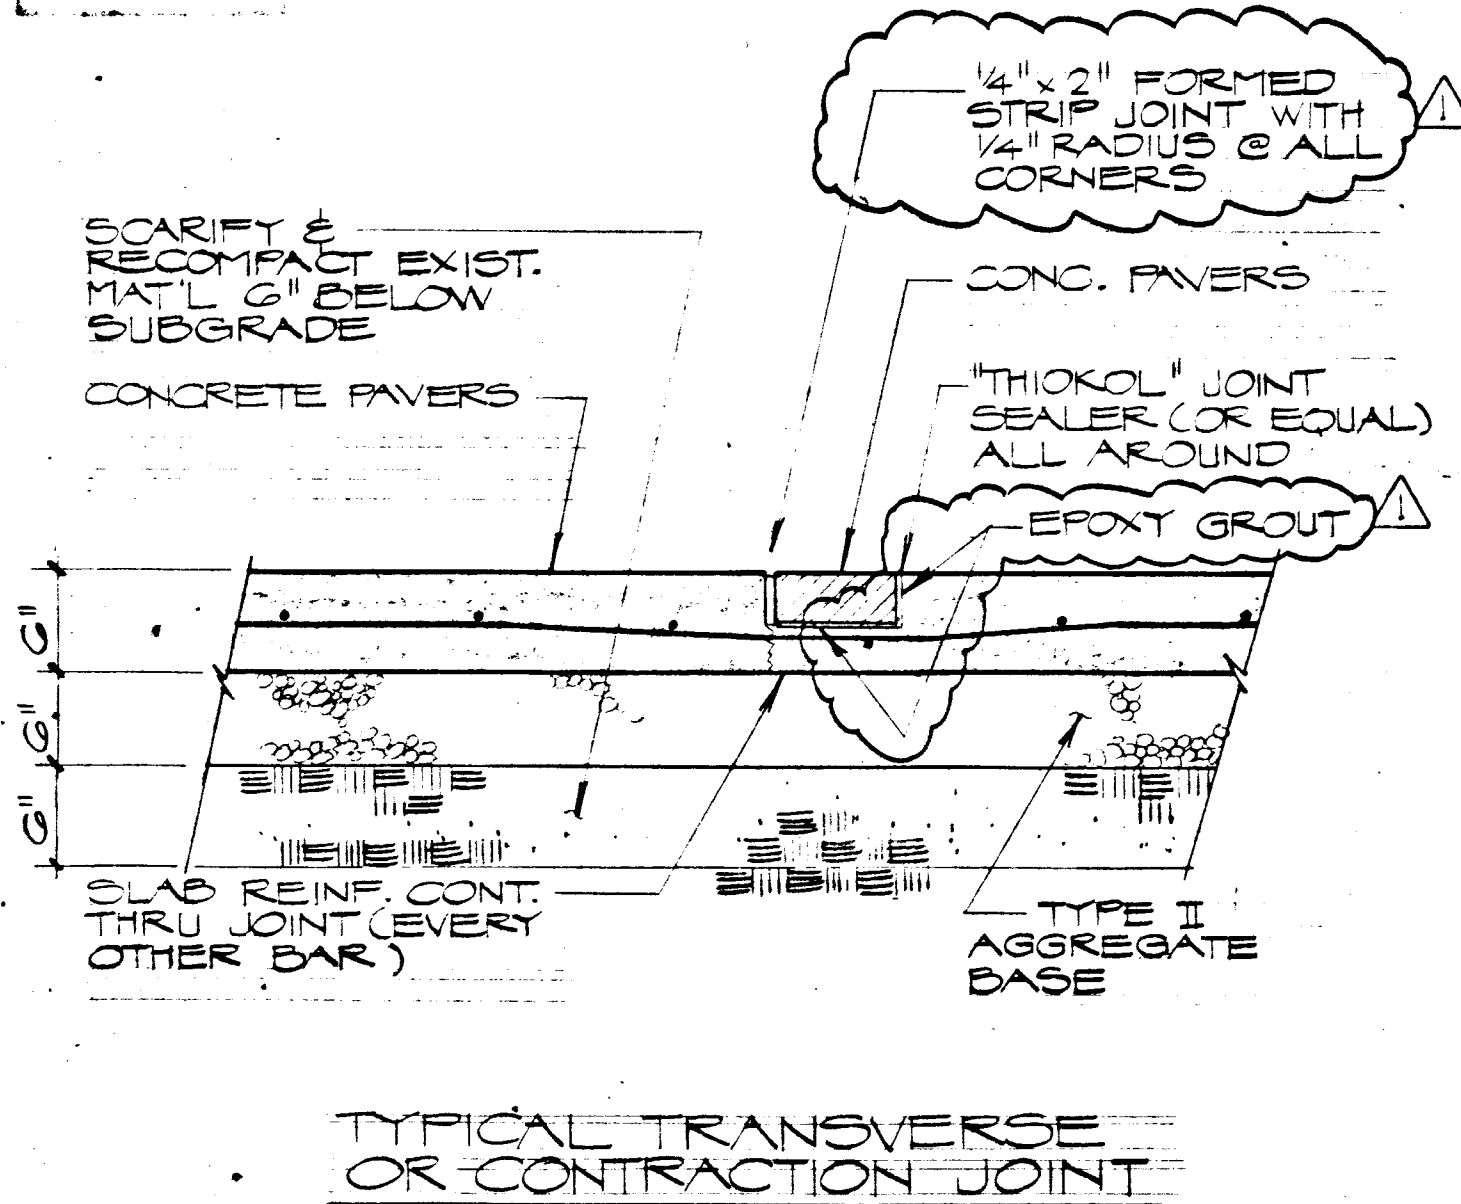


DETAIL 7

1" = 1'-0"

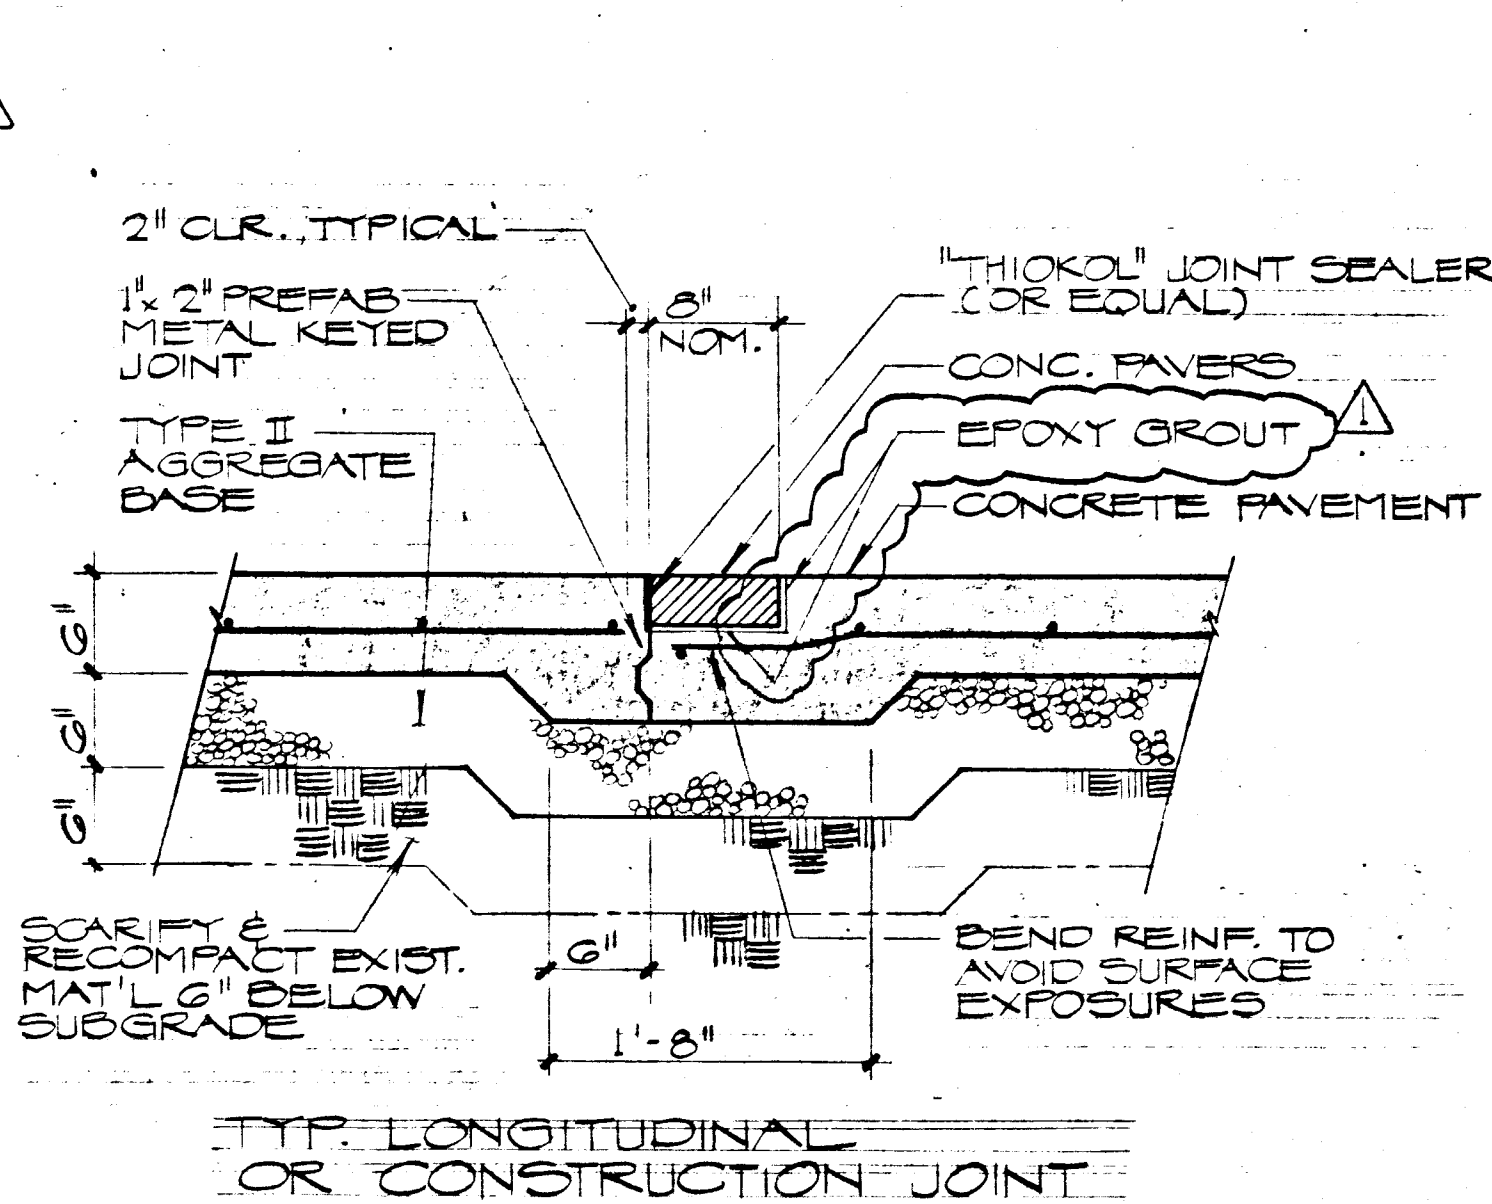


DETAIL 6

1" = 1'-0"

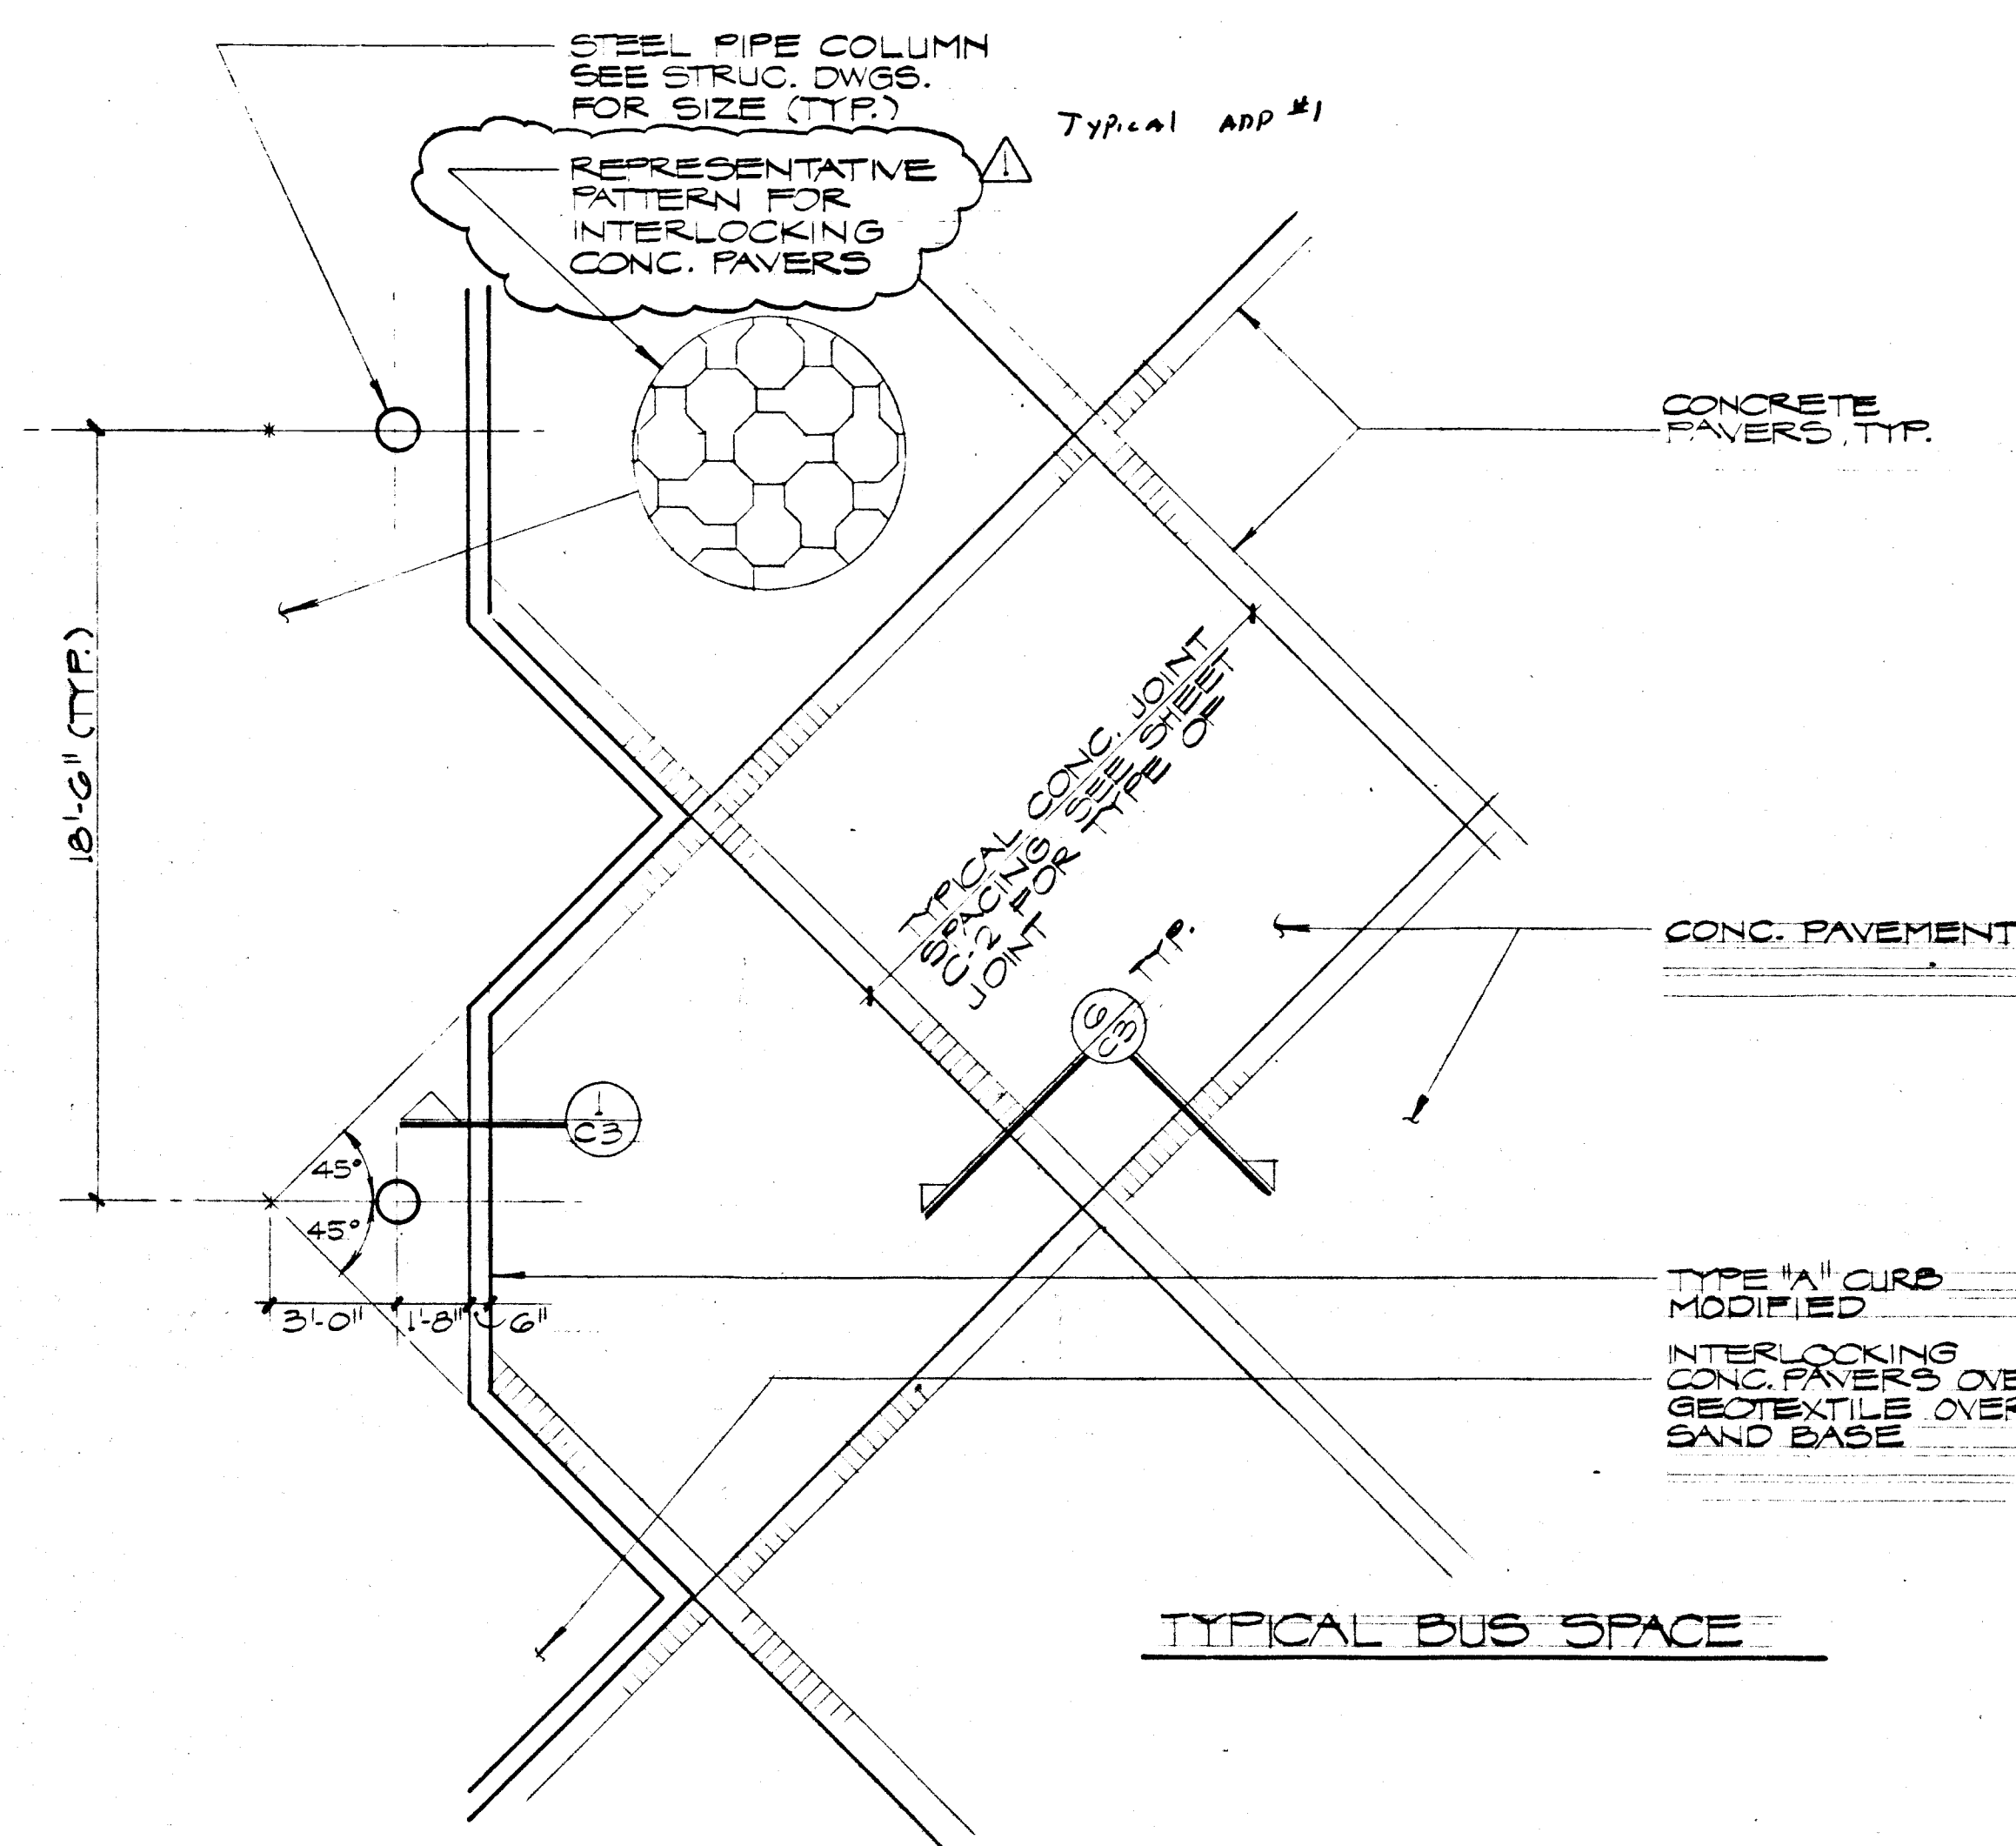

DETAIL 5

1/4" = 1'-0"

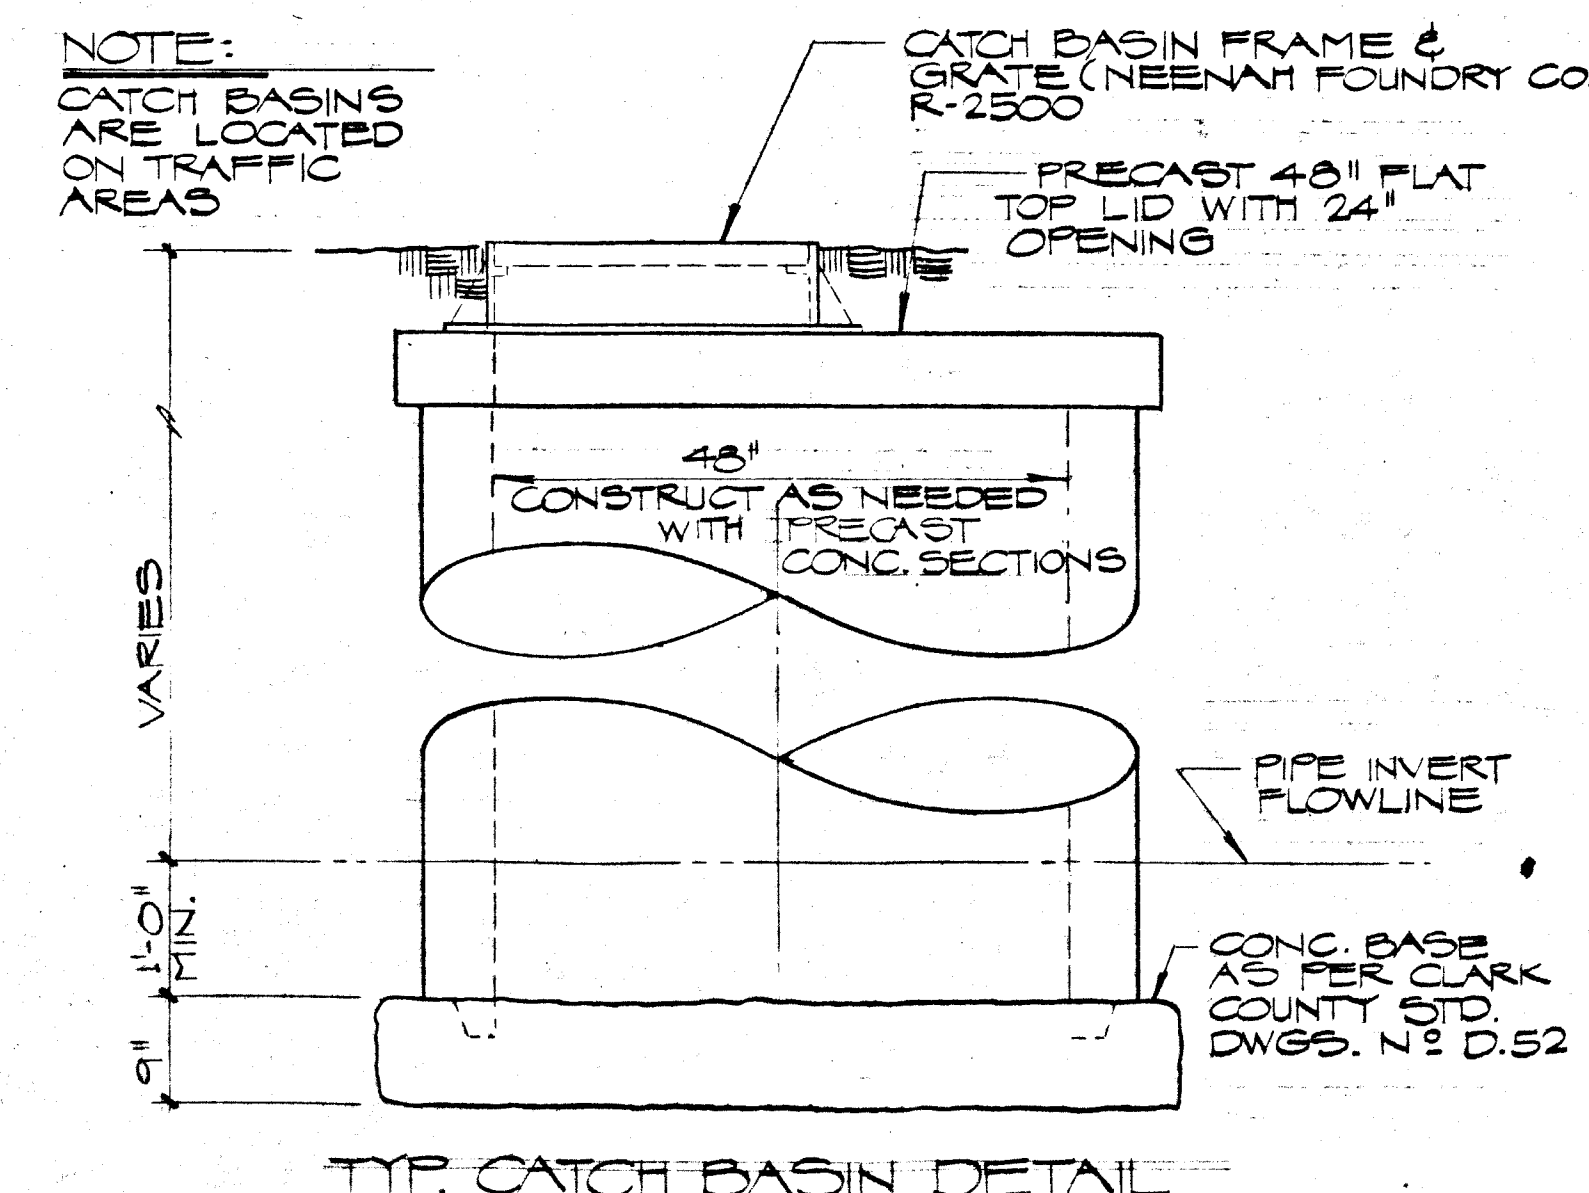

DETAIL 8

1/4" = 1'-0"

11-15-95 - ISSUED FOR ADDENDUM #1

GUNNY, BRIZENDINE & POGGEMEYER
ENGINEERS
PLANNERS
1004 EAST SONORA AVENUE
SUITE 200
LAS VEGAS, NEVADA 89104
(702) 735-1100
(702) 735-1101
(702) 735-1102

DOBROSKY KITTRELL GARLOCK
Architects
3800 CARLISLE ST. LAS VEGAS, NEVADA 89169
(702) 735-0488

City of Las Vegas
Downtown Transportation Center
Las Vegas, Nevada

SHEET
C-3
DATE
11-15-95
BY
JLG
CHECKED
JLG
APPROVED
JLG